


AD-A136 129


AMISTAD POWER PLANT(U) ARMY ENGINEER DISTRICT FORT
WORTH TX A J MARR OCT 83

1/1

UNCLASSIFIED

F/G 13/13 NL

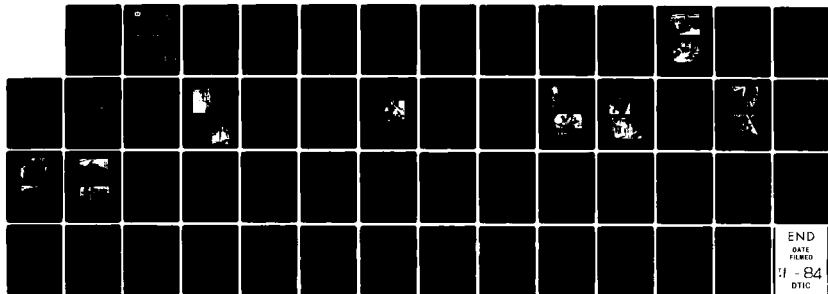

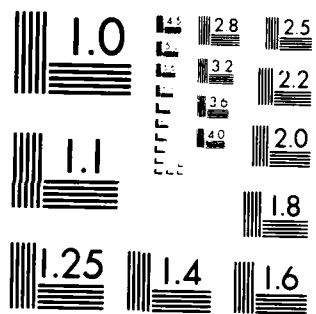

MICROCOPY RESOLUTION TEST CHART
NATIONAL BUREAU OF STANDARDS-1963-A

12

**FINAL
FOUNDATION
REPORT**



**US Army Corps
of Engineers**
Fort Worth District

AD-A136129

**AMISTAD POWERPLANT
DEL RIO, TEXAS**

DTIC FILE COPY

DTIC
ELECTE
DEC 21 1983
S D

OCTOBER 1983

88 11 28 197

DISTRIBUTION STATEMENT A
Approved for public release;
Distribution Unlimited

12

CORPS OF ENGINEERS

FORT WORTH DISTRICT, TEXAS

FINAL

FOUNDATION REPORT

AMISTAD POWER PLANT

Accession For	
NTIS GR & I	<input checked="" type="checkbox"/>
DTIC TAB	<input type="checkbox"/>
Unannounced	<input type="checkbox"/>
Justification	
By <u>Per Ltr. on file</u>	
Distribution	
Availability Codes	
Dist	Availability/or Special
<u>All</u>	

DTIC
 ELECTE
 DEC 21 1983
 S D

BY

ALAN J. MARR

GEOLOGIST

OCTOBER 1983

DTIC
 COPY
 INSPECTED
 2

DISTRIBUTION STATEMENT A
 Approved for public release;
 Distribution Unlimited

PREFACE

This report was prepared by the Geotechnical Branch, Engineering Division, Fort Worth District, Corps of Engineers. The report was written by Staff Geologist, Alan J. Marr, under the supervision of the Chief of the Geology Section, Melvin G. Green, and the Chief of the Geotechnical Branch, Wayne E. McIntosh.

Colonel Donald Palladino and Colonel Theodore Stroup served as District Engineers during construction of the Amistad Power Plant. Chief of Engineering Division, SWF, was Mr. Shigeru Fujiwara. Mr. Ronald Zunker served as Resident Engineer during construction.

TABLE OF CONTENTS

<u>Para No.</u>	<u>Paragraph Title</u>	<u>Page No.</u>
I INTRODUCTION		
1	Project Location and Description	1
2	Construction Authority	1
3	Purpose of Report	1
4	Project History	1
5	Location of the Powerhouse	2
6	The Contract	2
7	Quality Control	2
8	Contract Supervision	2
II FOUNDATION EXPLORATIONS		
1	Investigations Prior to Construction	4
2	Investigations During Construction	4
III GEOLOGY		
1	Physiography and Regional Geology	5
2	Geology of the Powerhouse Site	5
	a. General	5
	b. Description of the Overburden	5
	c. Bedrock Stratigraphy	5
	d. Bedrock Lithology	7
	e. Bedrock Structure	7
	f. Bedrock Weathering	7
	g. Ground Water	7
3	Engineering Characteristics of the Primary Materials	9
IV EXCAVATION PROCEDURES		
1	Excavation Grades	10
2	Dewatering Provisions	10
3	Rock Excavation	10
4	Foundation Preparation	12
5	Safety	12
V FOUNDATION ANCHORS		
1	General	13
2	Equipment	13
3	Procedures	13
	a. Powerhouse Foundation Anchors	13
	b. Retaining Wall Anchors	16

TABLE OF CONTENTS (cont'd)

<u>Para No.</u>	<u>Paragraph Title</u>	<u>Page No.</u>
4	Pull-Out Tests	16
VI CHARACTER OF THE FOUNDATION		
1	General	18
2	Foundation Surface	18
3	Condition of the Foundation	18
4	Water	18
VII RECORD OF FOUNDATION APPROVAL		
1	General	21
2	Record of Approval	
	a. Erection Bay Area	21
	b. Erection Bay Area	21
	c. Generator Bay Area	21
	d. Sump	21
	e. Erection Bay Area	21
	f. Elevation 906 "Bench" and Above	22
	g. The Retaining Wall Between Powerhouse Stations 13+65 and 17+60	22
VIII CONTRACT MODIFICATIONS		
		23

TABLE OF CONTENTS (cont'd)

<u>Para No.</u>	<u>Paragraph Title</u>	<u>Page No.</u>
4	Pull-Out Tests	16
VI CHARACTER OF THE FOUNDATION		
1	General	18
2	Foundation Surface	18
3	Condition of the Foundation	18
4	Water	18
VII RECORD OF FOUNDATION APPROVAL		
1	General	21
2	Record of Approval	
	a. Erection Bay Area	21
	b. Erection Bay Area	21
	c. Generator Bay Area	21
	d. Sump	21
	e. Erection Bay Area	21
	f. Elevation 906 "Bench" and Above	22
	g. The Retaining Wall Between Powerhouse Stations 13+65 and 17+60	22
VIII CONTRACT MODIFICATIONS		
		23

PLATES

Plate No.

- | | |
|---|---------------------------------------|
| 1 | Project Location Map |
| 2 | Site Plan |
| 3 | Plan of Borings |
| 4 | As-Built Excavation Plan - Geology |
| 5 | As-Built Excavation Plan - Elevations |
| 6 | Geologic Sections A-A, B-B, C-C |
| 7 | Retaining Wall Geologic Profile |
| 8 | Logs of Borings |

ILLUSTRATIONS

<u>Figure No.</u>	<u>Title</u>	<u>Page No.</u>
1	Work area and cofferdam viewed from observation deck atop Amistad Dam	3
2	Powerhouse excavation	3
3	Powerhouse excavation	6
4	Vertical jointing in Georgetown Limestone	8
5	Seepage emitting from fault	8
6	Rock excavation using jackhammer	11
7	Rock anchor drill	14
8	Loading epoxy cartridges in anchor hole	14
9	DYWIDAG threadbar entry	15
10	Stressing rock anchor	15
11	Void space around threadbar	17
12	Void space around threadbar and beneath bearing plate	17
13	Typical limestone foundation surface prior to concrete placement (erection bay area at elevation 906±)	19
14	Typical limestone foundation surface prior to concrete placement (erection bay area at elevation 865±)	19
15	Typical limestone foundation surface prior to concrete placement (generator bay area at elevation 845±)	20
16	Typical limestone foundation surface prior to concrete placement (generator bay area at elevation 845±)	20

I INTRODUCTION

1. Project Location and Description. Amistad Dam is located at approximate river mile 567 on the Rio Grande about 12 miles upstream from Del Rio, Texas. The location of the project is shown on plate 1.

The dam consists of a 950-foot long concrete spillway section in the main river channel flanked by non-overflow concrete sections and earth embankments on each side of the spillway section, and an earth dike extending about 2.2 miles east of the United States end of the main dam. The non-overflow concrete sections of the dam include a 225 foot long power intake section on the United States side and a 223-foot long power intake section on the Mexico side. Maximum height of the dam is 254 feet with crest elevation of the spillway section at elevation 1086.4 feet above mean sea level.

2. Construction Authority. Construction of the Amistad project was authorized by Public Law 286, 74th Congress, approved 19 August 1935, and the 1944 water treaty (Treaty Series 994) between the United States of America and Mexico, effective on 8 November 1945 (Articles 5, 7, and 24), and the Public Law 605, 86th Congress, 2d Session, approved 7 July 1960.

3. Purpose of Report. This report has been prepared in accordance with requirements as set forth by the Office, Chief of Engineers, in ER 1110-1-1801. This report provides a complete record of foundation conditions encountered during construction of the Amistad Power Plant. Information contained in this report will be valuable when evaluating (1) necessary remedial action required to prevent or repair any failures resulting from foundation deficiencies, (2) contractor claims related to foundation conditions or alleged change of conditions, and (3) planning and design of future comparable construction projects.

A copy of this report will be included in the permanent records maintained at the project office.

4. Project History. Construction of Amistad Dam began in 1963 and was completed in November 1969. The purposes of the dam were flood control and irrigation, with the generation of hydroelectric power as a future capability. Therefore, the basic design determinations for immediate and ultimate hydroelectric power plant installation were made before construction of the dam.

Construction of the dam included a 225-foot long United States power intake section in the left abutment of the main river channel. The power intake section included five intake monoliths having a 14.5-foot diameter penstock at the center of each monolith. Total length of the

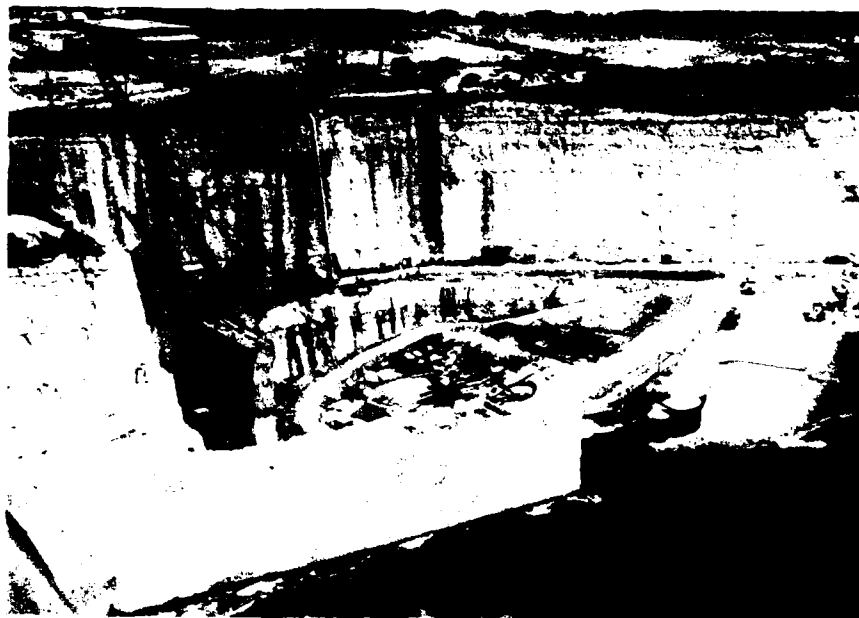


Figure 1 Work area and cofferdam viewed from observation deck at Amistad Dam



Figure 2 Powerhouse excavation - October 1981

II FOUNDATION EXPLORATIONS

1. Investigations Prior to Construction. Foundation investigations for the design and construction of the Amistad Power Plant were conducted simultaneously with investigations for design and construction of Amistad Dam. The drilling program, which included investigations of the powerhouse site, began in 1960 and was concluded in May 1962. The Plan of Borings is shown on plate 3 and logs of the borings located within the powerhouse site are presented on plate 8.

2. Investigations During Construction. No unanticipated foundation conditions or problems were encountered during construction that required additional subsurface investigations.

II FOUNDATION EXPLORATIONS

1. Investigations Prior to Construction. Foundation investigations for the design and construction of the Amistad Power Plant were conducted simultaneously with investigations for design and construction of Amistad Dam. The drilling program, which included investigations of the powerhouse site, began in 1960 and was concluded in May 1962. The Plan of Borings is shown on plate 3 and logs of the borings located within the powerhouse site are presented on plate 8.

2. Investigations During Construction. No unanticipated foundation conditions or problems were encountered during construction that required additional subsurface investigations.

III GEOLOGY

1. Physiography and Regional Geology. Amistad Dam is located on the southern edge of the Edwards Plateau section of the Great Plains physiographic province. The dam crosses a relatively steep-walled, 1100-foot wide canyon carved by the Rio Grande River through thick-bedded limestone. In the vicinity of Amistad Dam, the Rio Grande River flows near the axis of a wide, southeast trending synclinal trough which has gently dipping limbs. The flanks of this broad syncline are occasionally modified by minor flexures and faults whose origins are structurally attributed to a westward extension of the Balcones Fault Zone.

Amistad Dam is founded on strata belonging to the Cretaceous age Georgetown Limestone Formation. The Georgetown Limestone Formation outcrops at the surface, supports the concrete portion of the dam, and also forms the abutment through which the five power intake monoliths and penstocks were tunneled. At Amistad Dam the formation reaches a total thickness of about 500 feet and consists of thick-bedded to massive, fine-grained, stylolitic limestone. Correlation of persistent marker beds within the Georgetown Limestone Formation in the vicinity of Amistad Dam indicate a strike of N 48° W and a dip to the southwest at approximately 50 feet per mile.

2. Geology of the Powerhouse Site.

a. General. The Amistad Power Plant is founded in a manmade notch incised in the left abutment of Amistad Dam. Excavation for the power plant foundation was accomplished during construction of the main dam using the pre-split method of rock excavation. The powerhouse facility is founded on strata belonging exclusively to the Georgetown Limestone Formation.

b. Description of the Overburden. All overburden was removed from the powerhouse site during the construction for the main dam. Logs of borings indicate that overburden in the powerhouse site consisted of a very thin cover of residual soil capping the limestone abutment. About 6 feet of silt, which had accumulated in the powerhouse stilling basin site, was removed after construction of the cofferdam and dewatering of the stilling basin.

c. Bedrock Stratigraphy. The Georgetown Limestone Formation at Amistad Dam reaches a total thickness of about 500 feet with approximately 30 to 45 feet of transitional, argillaceous limestone and marl capping the section and grading upward into the Del Rio Formation. Boring 6C2C-R-43, located near dam centerline station 170+00, encountered the contact between the Georgetown Formation and the underlying Kiamichi Formation at elevation 605.2, approximately 240 feet below the base of the power plant.



Figure 3. Powerhouse excavation. Note 48" dipping "Still" Basin Vault" partially erected at top of excavation.

d. Bedrock Lithology. The Georgetown Limestone Formation consists of thick-bedded to massive, light gray to bluish-gray, moderately hard to hard, very fine-grained, slightly fossiliferous, occasionally pyritic limestone. Tight, hairline stylolites are common. In the powerhouse area the limestone beds are separated occasionally by horizontal, soft to hard, variably calcareous shale laminations and bands up to 0.2 feet thick. The persistency of these shale bands in the powerhouse area makes them useful as stratigraphic markers for correlation.

e. Bedrock Structure. Strata comprising the Amistad powerhouse foundation are very nearly horizontal. The dip of the limestone beds beneath the structure, is variable in direction, and always less than 5° from horizontal. Two minor faults occur in the limestone foundation rock within the limits of the powerhouse structure (see plate 4). Both are normal faults striking in a NW-SE orientation and dipping toward the south-east. Displacement across both faults is minor (less than 0.3 ft) resulting in only a slight change in bedding dip. Jointing and fracturing associated with the faults are generally oriented parallel to the faults. Joints and cracks are tightly sealed, and tend to dissipate abruptly both horizontally and vertically.

A major fault, locally known as the "stilling basin fault" passes across the powerhouse stilling basin floor, up the rock face behind the stilling basin retaining wall, across the powerhouse access road and up the rock face on the east side of the powerhouse (figure 3). The fault strikes NE-SW and dips southeastward at an angle of 48°. Displacement across the fault was 12.0 feet in the rock face behind the stilling basin retaining wall. The location of the fault is shown on plate 4.

For safety purposes the brecciated zone along the fault plane overlooking the powerhouse site was cleaned of loose material and sealed with shotcrete during or shortly after the main dam construction. Weepholes were constructed through the shotcrete to drain the fault zone (see figure 3).

Zones of tight, closely spaced, parallel, vertical joints were exposed in the floor of the sump area excavation and in the floor of the generator bay area excavation. The joint zones were unrelated, occurring at different levels of the excavation. Other more isolated, random joints were exposed in the powerhouse foundation. Bedrock structure is shown on plate 4.

f. Bedrock Weathering. The Amistad Powerhouse foundation is below the base of bedrock weathering by about 50 feet. Orange staining noted in the powerhouse foundation bedrock was caused by silt which accumulated in the stilling basin immediately downstream of the five unused penstocks. Cleaning of the bedrock with compressed air and water failed to completely remove the orange stain. However, all components of the powerhouse facility were founded on competent, unweathered rock.

g. Ground Water. The occurrence and movement of ground water within the strata supporting the Amistad Powerhouse is restricted to openings caused by fracturing and/or faulting networks within the rock, or where



Figure 4 Vertical jointing in exposed vertical Georgetown Limestone cut



Figure 5 Seepage emitting from fault is caught in collection box and carried to excavation sump

solutionized joints or bedding planes occur, i.e., secondary permeability. The limestone itself, where unbroken, is highly impermeable.

A small flow of water, estimated at 2 to 3 gallons per minute, emitted from the fault exposed in the rock face behind the stilling basin retaining wall (see figure 5). This flow continued at a nearly constant rate throughout the construction period. Based upon a number of factors, i.e., low rainfall, constant seepage rate and the northwest orientation of the fault into the left abutment toward the reservoir, the source of the seepage is believed to be the reservoir. Upon a recommendation from SWFED-F two additional weep holes were constructed through the concrete retaining wall at the seepage emission point to specifically care for the water emitting from the fault. One weep hole was constructed exactly at the point where the seepage emitted, and another was constructed in the fault plane about 1 foot higher than the first weep hole. Other minor intermittent seeps emitted from joints and bedding planes in the pre-split rock face. A build-up of algae growth usually accompanied these seeps.

3. Engineering Characteristics of the Primary Materials. Materials testing prior to design and construction of the Amistad Power Plant was conducted simultaneously with testing for the design and construction of Amistad Dam. Results of all testing are presented in Section III of the Amistad Dam Design Memorandum No. 1 (Revised), March 1965. The following shows the range of values and the average values obtained from tests on the Georgetown Formation:

	<u>Average</u>	<u>Maximum</u>	<u>Minimum</u>
Dry Density (pcf)	158.0	164.1	153.6
Unconfined Compressive Strength (psi)	7,756	12,803	3,660
Modulus of Elasticity (10^6 psi)	5.78	9.90	2.60

The limited thickness of the shale seams within the Georgetown Limestone Formation made it difficult to obtain shale specimens which would yield reliable test results. The seams are composed of highly compressed clay of high plasticity which would lose considerable strength should variations in moisture content occur. Therefore, it was recommended that the shale seams not be permitted to remain beneath any concrete structure at shallow depths with a low degree of confinement.

IV EXCAVATION PROCEDURES

1. Excavation Grades. The majority of the excavation for the Amistad Power Plant was accomplished concurrent with construction of the main dam. As a result, excavation under the current contract was limited to fine-cutting to final design grade using jackhammers. Actual foundation conditions encountered during excavation for the Amistad Powerhouse were essentially as described in the contract plans and specifications. The designed slopes in the Georgetown Limestone Formation were achieved and maintained without difficulty. Some minor variations (overexcavation) from the designed grade lines occurred. Final sections across the rock foundation and geological mapping were accomplished by a government survey team supervised by the project geologist. Final excavation grades and slopes in the powerhouse foundation are presented on plate 5. Geologic sections are presented on plate 6.

2. Dewatering Provisions. A contract was awarded to Reece Albert, Inc. of San Angelo, Texas to construct a cofferdam and dewater the powerhouse site. Work began in April 1980. A 24 feet high by 365 feet long cofferdam was constructed from the left training wall of the main dam concrete spillway section across the powerhouse stilling basin and connected to the limestone abutment which formed the left side of the stilling basin. The cofferdam was completed and dewatering began in September 1980 using two 10-inch diameter and two 6-inch diameter electric pumps.

During construction a 6-inch diameter electric pump removed water that entered into the work area. Project personnel estimated the inflow to be approximately 200 gpm. The main sources of the inflow were seepage through and around the cofferdam, leakage through penstock No. 4 in the main dam, the spring emitting from the fault described in Section III-2(f) of this report and weepholes in the training wall of the main dam concrete spillway section. All seepage was collected in a sump located just outside the limits of powerhouse structure and eventually pumped out of the work area. All concrete placements were on surfaces free of water.

3. Rock Excavation. As previously noted, the excavation of all overburden and the majority of the foundation rock for the powerhouse foundation was accomplished concurrent with the construction of the main dam using the pre-split method of rock excavation. During the pre-splitting the Contractor was required to leave the rock below the excavation grade undamaged. As a result, the rock surfaces comprising the foundation were left somewhat rounded and irregular. Final cutting and shaping of these irregular areas were accomplished during the powerhouse construction contract using pneumatic tools either operated by hand or mounted on a rubber-tired CASE 580C front-end loader/backhoe as shown in figure 6.

The amount of overexcavation which occurred in the limestone foundation was minor, generally the result of two conditions. The first condition was the occurrence of one of the horizontal shaly laminations immediately below designed grade. The Contractor was directed to remove the shaly zone where it occurred near grade. The second condition where overexcavation occurred



Figure 6 Rock excavation using jack-hammer mounted on back hoe

was in areas of faulting or severe jointing and fracturing. The Contractor was required to remove all loose or drummy rock from the surface before concrete encasement. Plate 4 shows the locations of faults and joints within the powerhouse foundation.

4. Foundation Preparation. The Georgetown Limestone Formation which comprised the Amistad Power Plant foundation was not sensitive to exposure to atmospheric conditions, therefore, no restrictions were placed on the length of exposure time of the foundation rock. The final foundation surfaces were shaped using hand tools such as jackhammers, picks, and shovels. All loose or drummy rock was removed and the surfaces were cleaned with a high pressure air-water jet. Structural concrete was placed directly against or on the rock surfaces.

5. Safety. The limestone rock faces of the powerhouse excavation were sufficiently competent to stand on the designed slopes. The slopes generally showed no significant deterioration since their initial exposure over 15 years earlier. All rock faces within the excavation were scaled of loose material prior to the start of construction in the powerhouse site and no difficulty was encountered from slides or rockfalls during construction.

An extensive area of vertical jointing associated with the "stilling basin fault" described in III-2(d) of this report was exposed by the pre-splitting excavations on the upstream end of the rock face to be encased by the retaining wall (see figure 4). Immediately after completion of pre-splitting operations, rock bolts were installed to insure the stability of the jointed rocks. All of the rock bolts appeared intact and undisturbed, indicating the jointed zone has remained in a stable condition since its initial exposure. The jointed zone does not occur within the limits of the powerhouse foundation.

V FOUNDATION ANCHORS

1. General. Foundation anchors were installed in the powerhouse foundation and in the rock face behind the concrete retaining wall. Permanent foundation anchors were installed to a depth of 30 feet below the generator bay, erection bay, and sump areas. The locations of these anchors are shown on plate 5. Behind the retaining wall the anchors were spaced on 10-ft centers and installed to a depth of 10 feet. No pull-out tests were performed.

2. Equipment. All holes for the rock anchors were drilled using the AT3100B track-mounted pneumatic drill shown in figure 7. Anchors installed in the powerhouse foundation consisted of No. 11 Dywidag threadbars anchored with cartridge packaged polyester resin manufactured by Celtite, Inc., Cleveland, Ohio. Rock anchors in the limestone face behind the concrete retaining wall consisted of No. 11 rebar grouted by the Slit Perfo method of grout distribution. The water-cement ratio of the grout was 0.28.

3. Procedures.

a. Powerhouse Foundation Anchors. Rock anchor holes in the powerhouse foundation were drilled to a depth of 30 feet using a pneumatic percussion drill with a 1-7/8-inch diameter button bit. Each hole was sealed with a wooden plug after completion of drilling; installation of anchor bars commenced after all holes had been drilled. After cleaning the holes with air, Celtite polyester resin cartridges consisting of heat sealed polyester tubes (sausages) containing both the resin and the catalyst, separated by a barrier which prevents chemical interaction until installation of the bar, were placed in the anchor holes (see figure 8). Three cartridges of fast setting (Type MV 90) resin for point anchorage were dropped in the hole first, followed by approximately 25 (the number required to fill the hole) slow setting (TYPE MV 1530) resin cartridges for corrosion protection. One-inch Dywidag threadbars were then screwed into the resin-filled holes as shown on figure 9. The threadbar entry, which normally took 4 or 5 minutes, penetrated the resin cartridges, mixed the resin and catalyst, and initiated the hardening of the resin. Immediately after completing the threadbar entry, a hydraulic jack was attached to the bar and it was tension stressed to 80 K or 133 K as specified (see figure 10). Bar tension was applied after the fast-setting resin had cured, but before the slow-setting resin had cured, thereby distributing the stress over the entire length of the anchor. Stress was applied at the surface against a 12" x 12" x 2-1/2" steel bearing plate set on a flat grout pad. After stressing, a hex nut was screwed down on the threaded bar against the bearing plate to permanently retain the stress.

Shortly after completing the installation of the 64 rock anchors in the generator bay area, project personnel observed water flowing from beneath the bearing plates on some of the anchors. Since water under varying amounts of pressure was encountered during the drilling of most of the

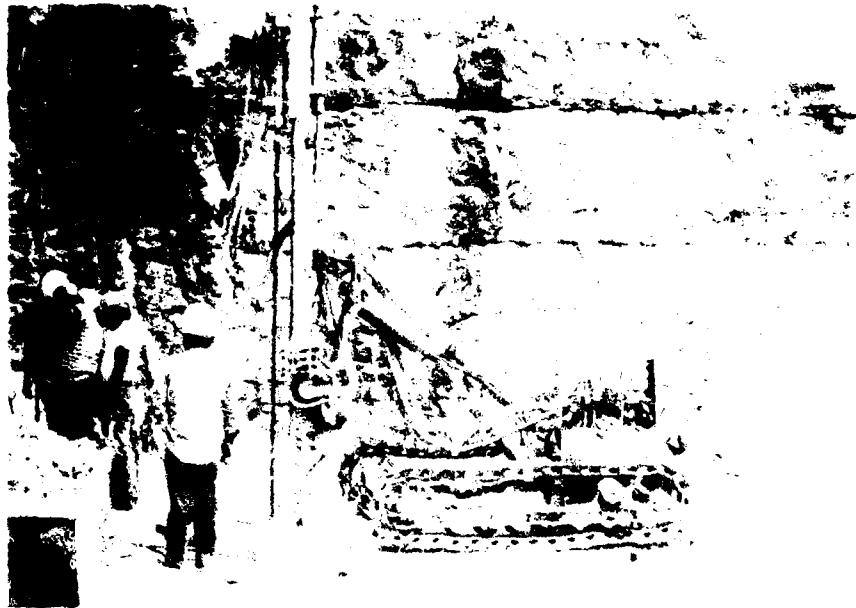



Figure 7 Drilling rock anchor holes with AT 3100B track-mounted pneumatic drill



Figure 8 Loading epoxy cartridges into anchor hole



Figure 9 Dywidag threadbar is screwed into anchor hole using electric drill

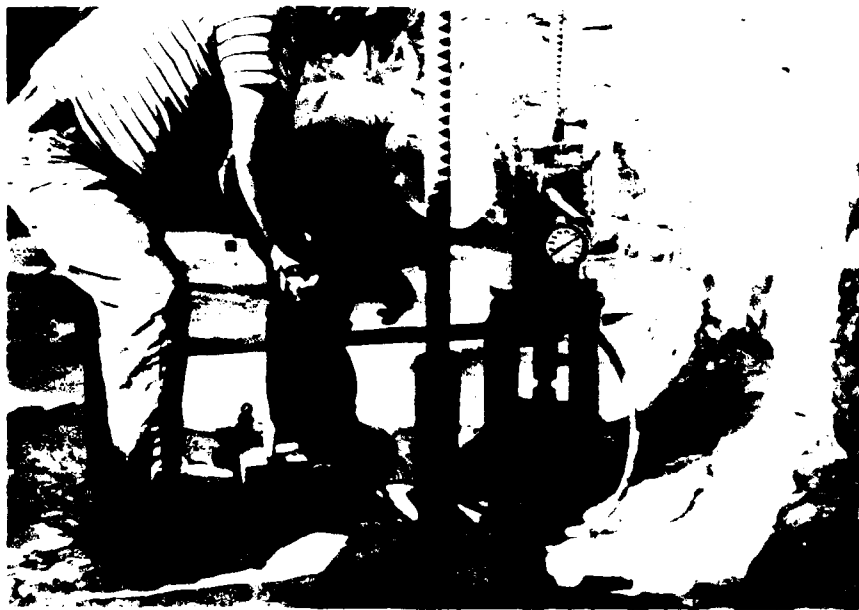

anchor holes, it was assumed that the water was flowing upward in the borehole, either between the limestone and the epoxy gel or between the epoxy gel and the threadbar. The latter case could shorten the effective life span of the foundation anchor due to oxidation of the threadbar. Geotechnical personnel from SWF and SWD visited the project and the decision was made to de-stress the anchors that were emitting water, remove the bearing plates, and inspect the threadbar anchorage. On 15 of the 17 anchors inspected, the epoxy gel surrounding the threadbar was below the surface (figures 11 and 12). The maximum depth of the void annular space was 6.1 feet. Based on these findings, the decision was made to de-stress all of the anchor bars and inspect for similar voids. Void annular space was found on 58 of the 64 anchors in place. The void annular space on each anchor was cleaned using jetted air and water, and filled to the surface with neat cement grout. All of the rock anchors were then re-stressed to their designed load of 80 K.

The cause of the voids was an improper hole diameter drilled by the Contractor. The Contractor used a 1-7/8-inch button bit to drill the anchor holes while Celtite, Inc., recommends a borehole diameter of 1-3/8 inches to 1-5/8 inches when using a nominal 1-inch diameter Dywadag threadbar.

b. Retaining Wall Anchors. Rock anchor holes in the limestone face behind the concrete retaining wall were drilled to a depth of 10 feet. In order to get to the anchor locations on the 4 V on 1 H rock face, the drill was mounted on a platform suspended by an overhead crane. Contract plans required 10-foot embedment of 1-3/8-inch diameter rebar spaced at 10 feet center-to-center each way in a 6-inch diameter hole. A contract modification was proposed by the Contractor, and approved by SWF, whereby the anchor hole size was changed from 6-inch diameter to 1-7/8-inch diameter, and the Slit-Perfo method of cement grout distribution was used for anchorage of the bars. With the Slit-Perfo method, perforated cannisters are filled with cement grout and inserted into the clean borehole. Rebar is then inserted through the cannisters, displacing the grout and forcing it out through the perforations into the annular space in the borehole.

The 10-foot center-to-center grid spacing of the wall anchors placed a few of the anchor locations directly over the horizontal, soft shale seams which separated the more massive, hard limestone layers. Where this occurred the Contractor was directed to move the anchor locations down 1 foot to insure anchor installations in firm rock.

4. Pull-Out Tests. The contract plans and specifications did not require pull-out tests on either the pre-stressed foundation anchors or the retaining wall anchors. Pull-out tests were, however, considered because of the experience with the foundation anchors. It was decided they were not necessary because each anchor installation had been closely inspected and the wall would receive additional permanent reinforcement from anchors that will be installed in the wall to support the concrete forms during placement.



Figure 11 Void space around threadbar



Figure 12 Void space around threadbar and beneath bearing plate

VI CHARACTER OF THE FOUNDATION

1. General. The Amistad Power Plant is founded on hard, unweathered limestone belonging to the Cretaceous age, Georgetown Limestone Formation. A detailed geologic map of the powerhouse foundation is presented on plate 4. Engineering characteristics of the primary strata are presented in Section III of this report.

2. Foundation Surface. After final shaping and cleanup, the limestone foundation surface exhibited varying degrees of unevenness. Where final grade occurred along one of the horizontal shaly seams within the formation, the soft shaly material within the seam was removed leaving the finished limestone surface relatively flat. This condition occurred in the generator bay foundation area at elevation 845. In most cases, however, the surface was uneven to a degree of ± 0.5 feet, due to the massive and hard nature of the limestone. In general, the characteristics of the limestone foundation surface are moderately hard to hard, gray to dark gray, very fine grained and massive. Typical limestone surfaces on which concrete was placed are shown on figures 13 through 16.

3. Condition of the Foundation. All limestone surfaces against which concrete was placed were unweathered. There was no evidence of large scale solutioning of the limestone, although some of the exposed joints and faults which emitted water could eventually develop into larger cavities. Faulting and jointing exposed in the limestone was minor and did not significantly alter the integrity of the rock. There were no large brecciated or fractured zones associated with the faults and all jointing was tightly healed with secondary mineralization.

4. Water. The occurrence and flow of water within the powerhouse foundation bedrock is through openings in the rock caused by faults, joints, or bedding planes. Several algae-choked wet areas are visible on the walls of the powerhouse excavation where flows ranging from a seep to as much as 2 to 3 gallons per minute are emitting. The smaller seeps are intermittent, flowing only after periods of rainfall. The 2-3 GPM flow emitting from the fault behind the concrete retaining wall is fairly consistent suggesting that its source may be the reservoir (see Section III-2(f) in this report). There are also isolated, trapped pockets of water under pressure within the limestone. When drilling the first foundation anchor hole in the generator bay area, one of these pockets was encountered and reportedly water initially gushed 16 feet into the air.



Figure 13 Typical limestone foundation surface prior to concrete placement (erection bay area at elevation 867)



Figure 14 Typical limestone foundation surface prior to concrete placement (erection bay area at elevation 865±)

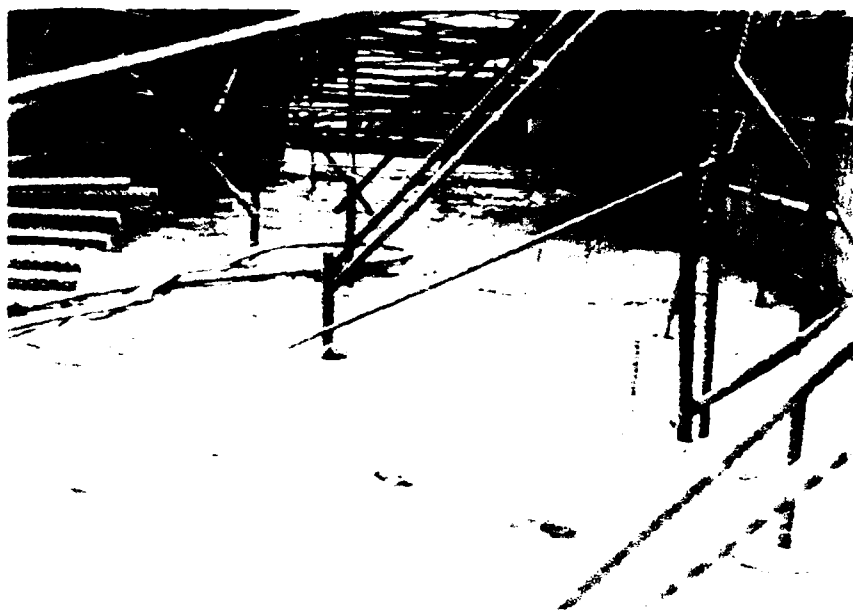


Figure 15 Typical limestone foundation surface prior to concrete placement (generator bay area at elevation 845±)

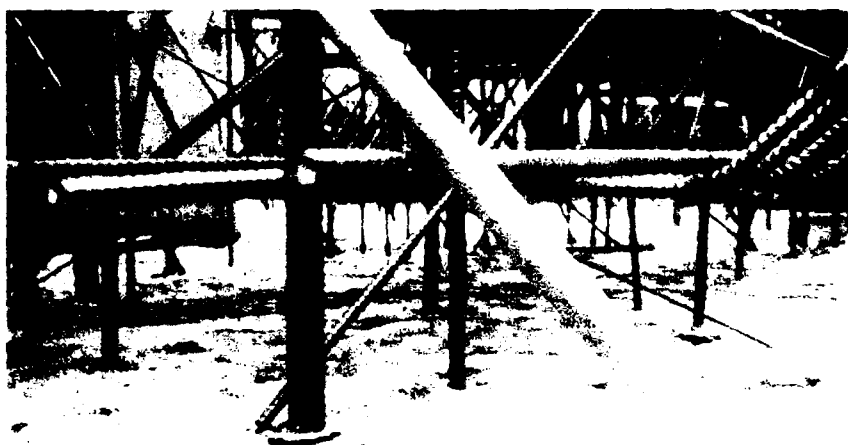


Figure 16 Typical limestone foundation surface prior to concrete placement (generator bay area at elevation 845±)

VII RECORD OF FOUNDATION APPROVAL.

1. General. All rock surfaces which became a part of the foundation of the Amistad Power Plant were inspected, mapped, and approved by a SWF geologist prior to encasement in concrete. In some cases, final approval relating to the cleanliness of the surface was given by project personnel immediately prior to concrete placement, whereas the geologist had inspected the rock at an earlier date. A record of foundation approval is provided, in chronological order as each section of the foundation was approved, in the following paragraphs. Final elevations and a geologic map of the excavation are shown on plates 4 and 5.

2. Record of Approval.

a. Erection Bay Area. The foundation bedrock between dam stations 157+40 and 157+56, and Powerhouse stations 12+87 and 13+65 was inspected and approved on 29 September 1981. The area had been overexcavated to as much as 30 inches below the design grade elevation of 906. It was the Contractor's intent to place concrete to elevation 906, and in the process, give his batch plant a trial run. Concrete was placed in the area on 30 September 1981. Final elevation shots were taken by the Contractor's survey crew. Final elevation shots in all other areas mapped were taken by a government-contracted survey crew supervised by the SWF geologist.

b. Erection Bay Area. The area between dam stations 157+67 and 157+90, and Powerhouse stations 12+87 and 13+09 was inspected and approved on 5 October 1981. The Contractor had also overexcavated in this area and wanted to fill with lean concrete to elevation 906. Concrete was placed in the area on 7 October 1981.

c. Generator Bay Area. The portion of this area outside of the limits of the draft tubes between dam stations 158+25 and 159+10, and Powerhouse stations 13+10 and 13+80 was mapped and inspected on 7 October 1981. Removal of some loose, drummy rock was required before approval. Concrete was placed in this area on 9 October 1981. The area beneath the draft tubes was mapped and inspected on 21 October 1981. Concrete placement in this area was delayed until 29-30 October 1981 due to the problem with foundation anchors as described in Section V.

d. Sump. The floor and walls of the sump were mapped and inspected on 12 October 1981. Subsequent approval and concrete placement occurred on 17 October 1981.

e. Erection Bay Area. The floor and walls in the area between dam stations 157+67 and 158+25, and Powerhouse stations 13+09 and 13+65 at approximate elevations 871 and 866 were mapped and inspected on 12 November 1981. The western edge of this area where it dropped down into the generator bay area contained a large amount of loose rock which was required to be removed. Removal of the loose material necessitated the relocation of two rock anchors. Final cleanup and approval of the area occurred immediately prior to concrete placement on 2 December 1981.

f. Elevation 906 "Bench" and Above. The floor and walls of this area between dam stations 158+90 and 159+10 and Powerhouse stations 12+85 and 13+10 were mapped and inspected on 5 February 1982. Final clean-up, approval, and concrete placement in the area occurred on 9 February 1982.

g. The Retaining Wall Between Powerhouse Stations 13+65 and 17+60. The exposed limestone face on the left side of the powerhouse stilling basin was inspected and mapped on 12 May 1982. The surface was mapped from the top of the nearly vertical cut at approximate elevation 920 to its base formed by the stilling basin floor and the edge of the earthen access ramp sloping off of the cofferdam. Some loose rock removal from the wall was required. Several small seep areas in the exposure had formed deposits of algae which also required removal. The surface was cleaned, approved, and encased in concrete in several small sections between 19 July 1982 and 26 May 1983.

VIII CONTRACT MODIFICATIONS

The Amistad Power Plant Plans and Specifications did not detail the equipment and procedures to be used for the prestressed anchors in the powerhouse foundation. On 25 June 1981 the Contractor proposed using DYWIDAG threadbar rock bolts set in a fast curing polyester resin grout. A description of the system was presented in Section V of this report. Literature published by DYWIDAG Svstems International and Celtite, Inc., was furnished. After SWF review, the proposal was approved on 10 July 1981.

On 18 August 1981, the Contractor submitted a proposal to use the Slit Perfo System in grouting the rock bolts in the limestone face behind the concrete retaining wall. The proposal was approved by SWF on 8 September 1981.


As a result of a recommendation by SWF Geotechnical Branch, two additional weep holes were installed in the concrete retaining wall to drain seepage from a fault. It was felt that without the weep holes, water could be trapped behind the wall possibly resulting in damage to the wall or the stability of the powerhouse access road subbase above.

VIII CONTRACT MODIFICATIONS

The Amistad Power Plant Plans and Specifications did not detail the equipment and procedures to be used for the prestressed anchors in the powerhouse foundation. On 25 June 1981 the Contractor proposed using DYWIDAG threadbar rock bolts set in a fast curing polyester resin grout. A description of the system was presented in Section V of this report. Literature published by DYWIDAG Systems International and Celtite, Inc., was furnished. After SWF review, the proposal was approved on 10 July 1981.

On 18 August 1981, the Contractor submitted a proposal to use the Slit Perfo System in grouting the rock bolts in the limestone face behind the concrete retaining wall. The proposal was approved by SWF on 8 September 1981.


As a result of a recommendation by SWF Geotechnical Branch, two additional weep holes were installed in the concrete retaining wall to drain seepage from a fault. It was felt that without the weep holes, water could be trapped behind the wall possibly resulting in damage to the wall or the stability of the powerhouse access road subbase above.

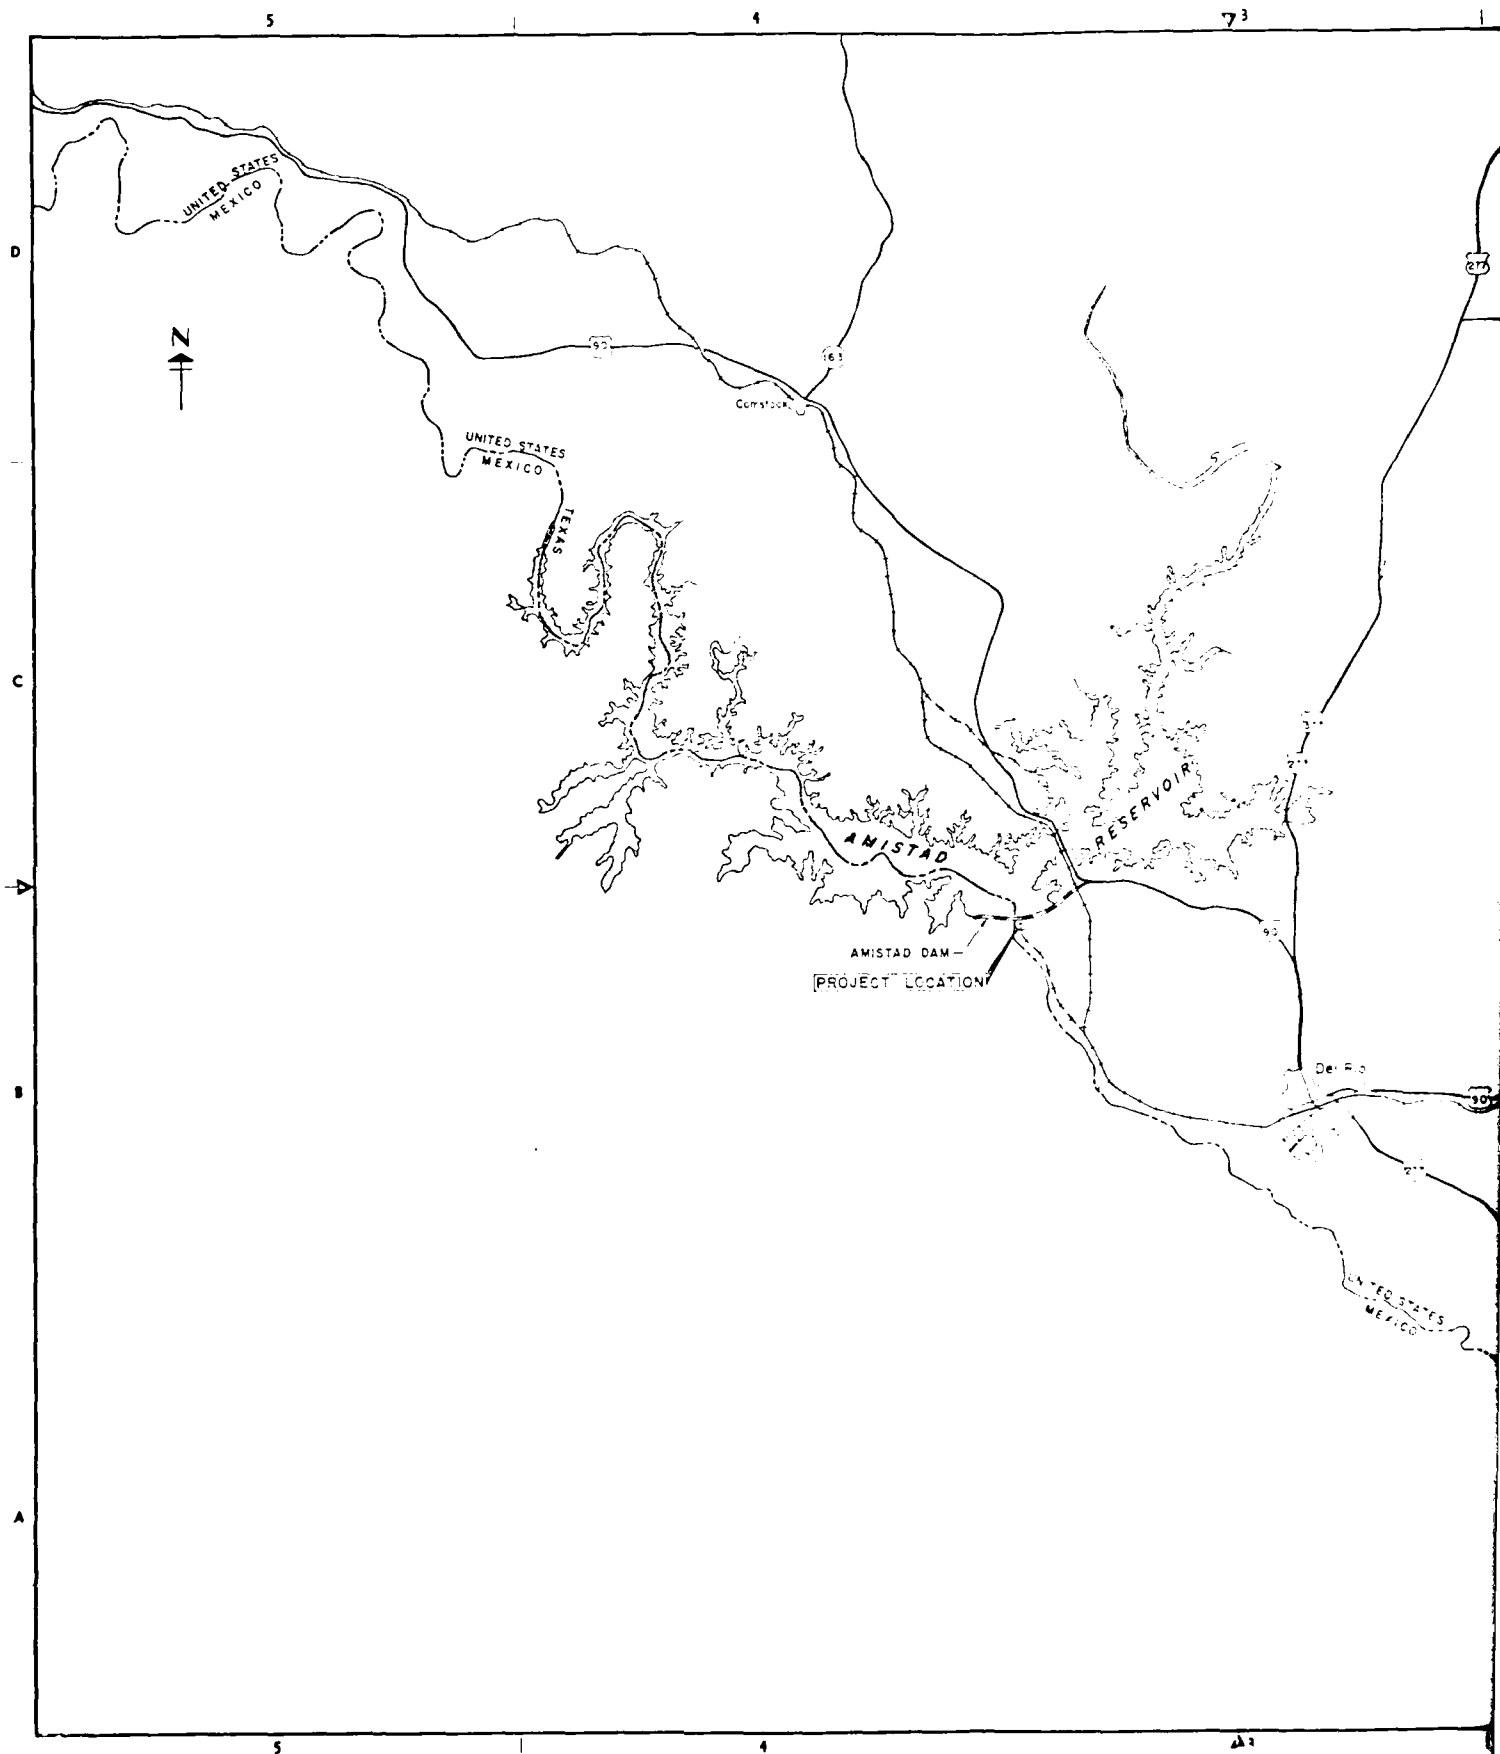



3

2

1

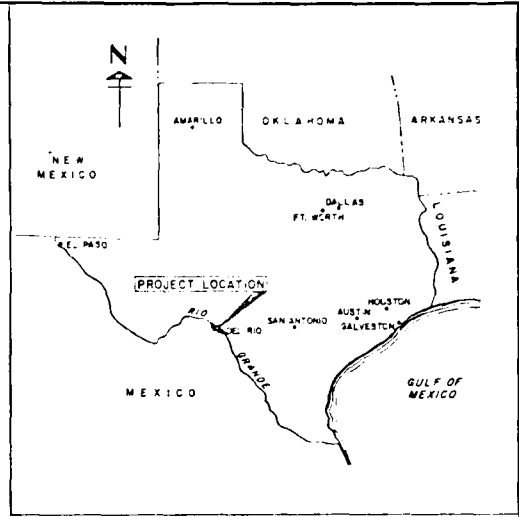

LOCATION MAP

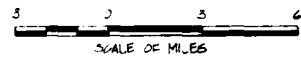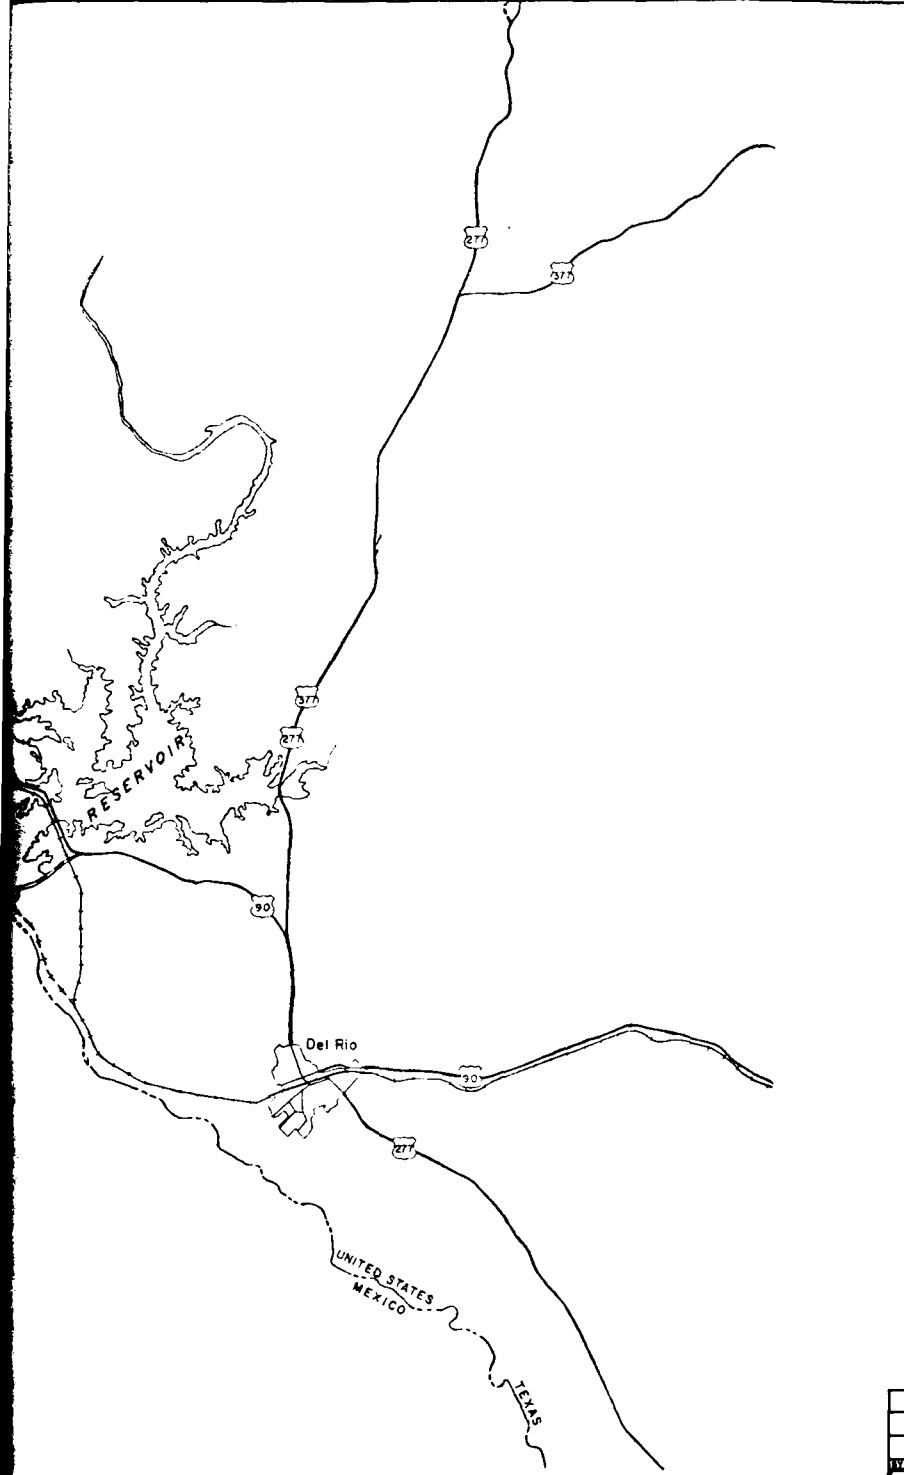

REVISION NO.	ACTION	DATE	DESCRIPTION OF REVISION
			U.S. ARMY ENGINEER DISTRICT, FORT WORTH CORPS OF ENGINEERS FORT WORTH, TEXAS
DESIGNED BY: A. MARK	AMISTAD DAM DEL RIO, TEXAS		
DRAWN BY: L. GOS			
REVIEWED BY: M. GREEN	AMISTAD POWER PLANT PROJECT LOCATION MAP		
SUBMITTED BY: MEL GREEN	INVESTIGATION NO.	DATE	
ENGINEER:	CONTRACT NO.		
	DRAWING NUMBER	SHEET NO.	Plate 1


4

2

1


TO ACCOMPANY FINAL FOUNDATION REPORT

1
2

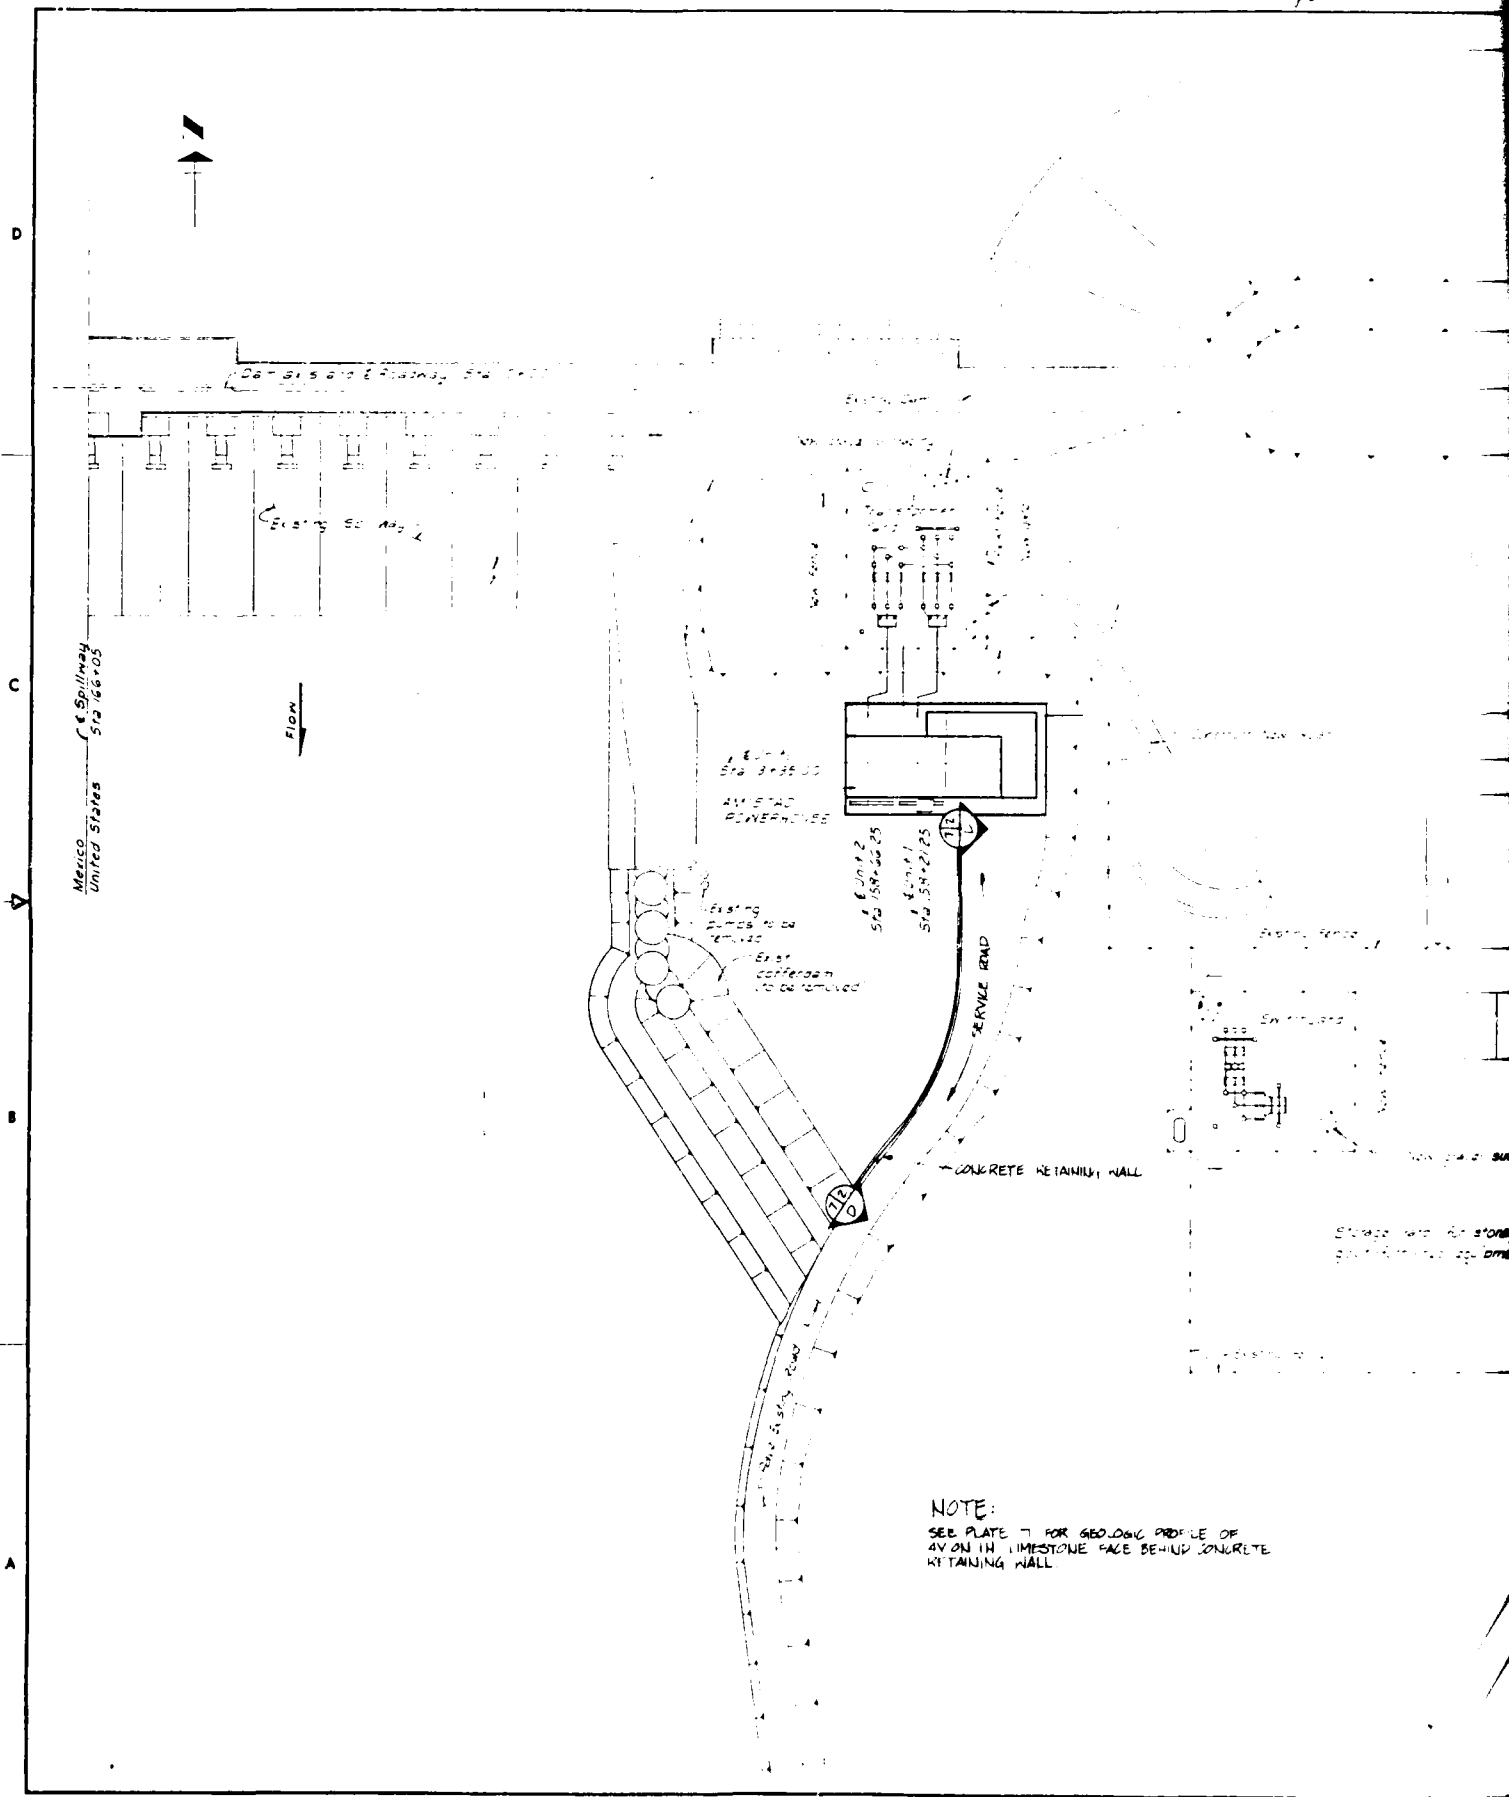


NOTE:
SEE PLATE 7 FOR GEOLOGIC PROFILE OF
4V ON THE LIMESTONE FACE BEHIND CONCRETE
RETAINING WALL

D
C
B
A

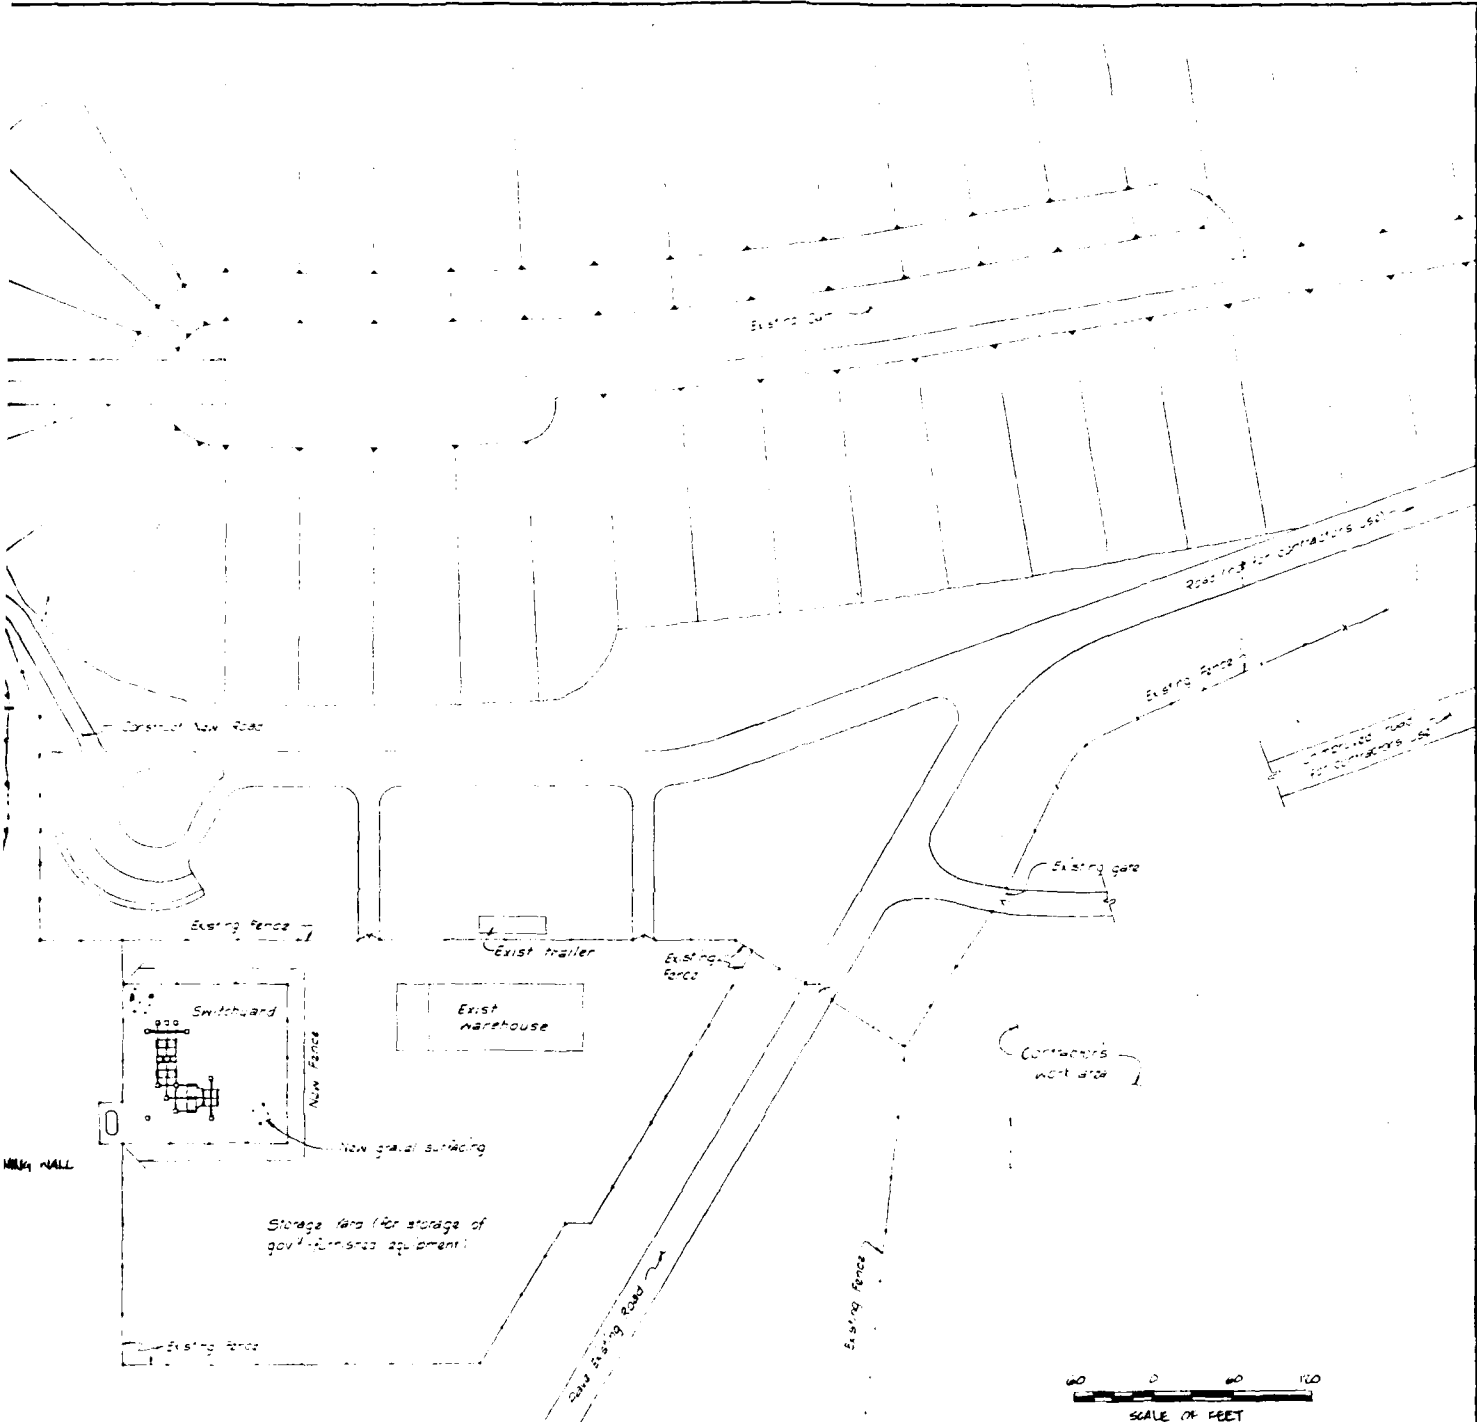



GEOLOGIC PROFILE OF NE FACE BEHIND CONCRETE

REVISION NO.	ACTION	DATE	DESCRIPTION OF REVISION
U.S. ARMY ENGINEER DISTRICT, FORT WORTH CORPS OF ENGINEERS FORT WORTH, TEXAS			
DESIGNED BY A. MARR	AMISTAD DAM DEL RIO, TEXAS AMISTAD POWER PLANT SITE PLAN		
DRAWN BY L. CROSS			
REVIEWED BY M. GREEN			
SUBMITTED BY MEL GREEN ENGINEER	INVITATION NO.	DATE	
	CONTRACT NO.		
			SHEET NO. 2

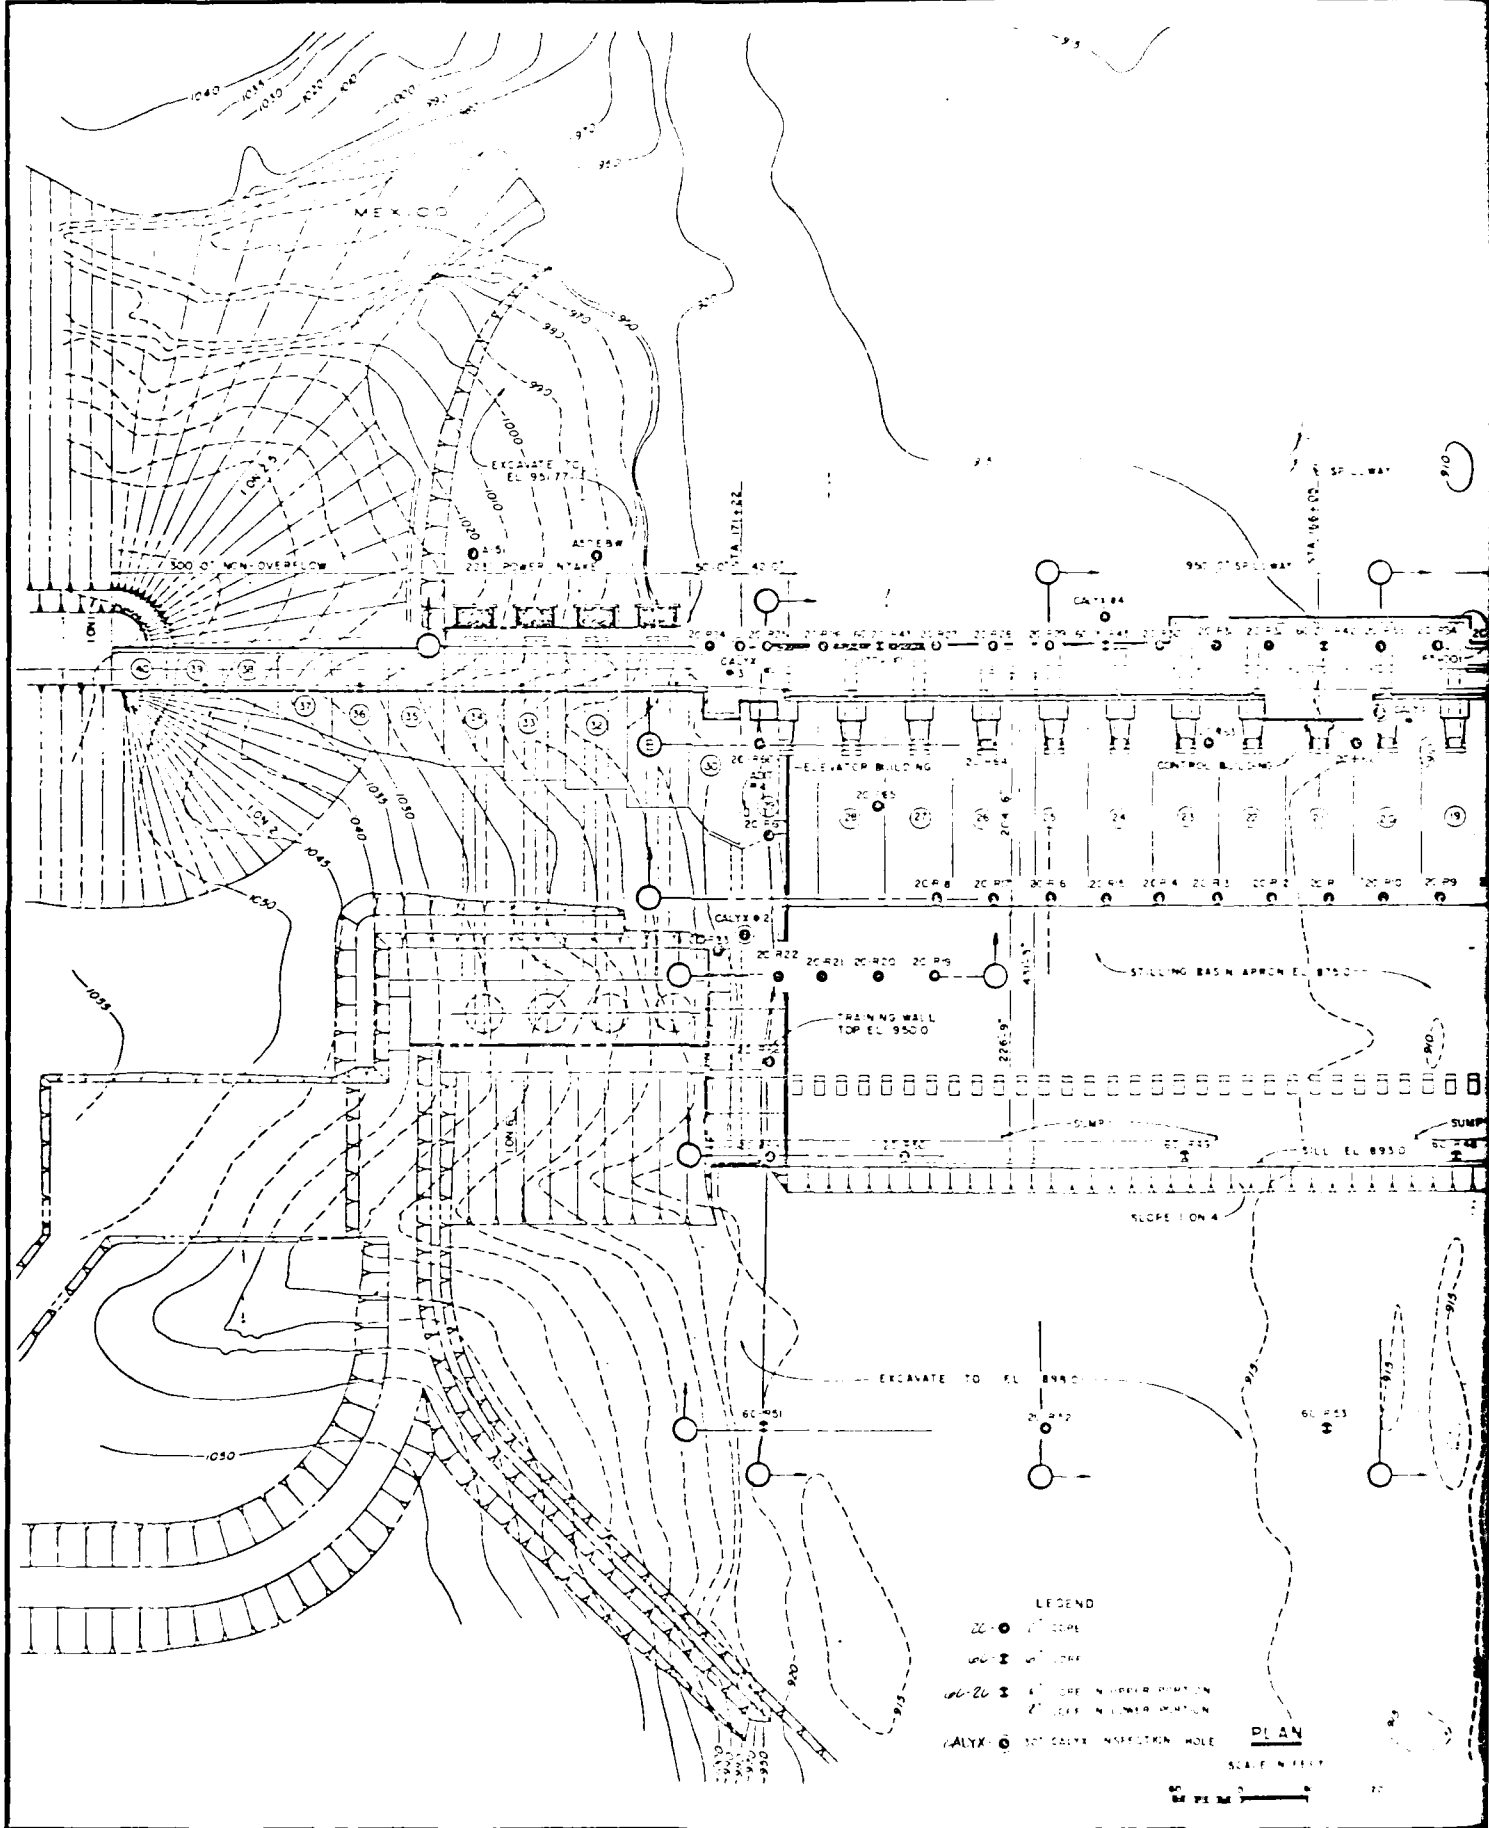

LEGEND
2C - CONCRETE
- - - - - GRADE
--- --- --- GRADE IN UPPER PORTION
--- --- --- GRADE IN LOWER PORTION
CALYX - INSPECTION HOLE

 PLAN
SCALE 1" = 100'

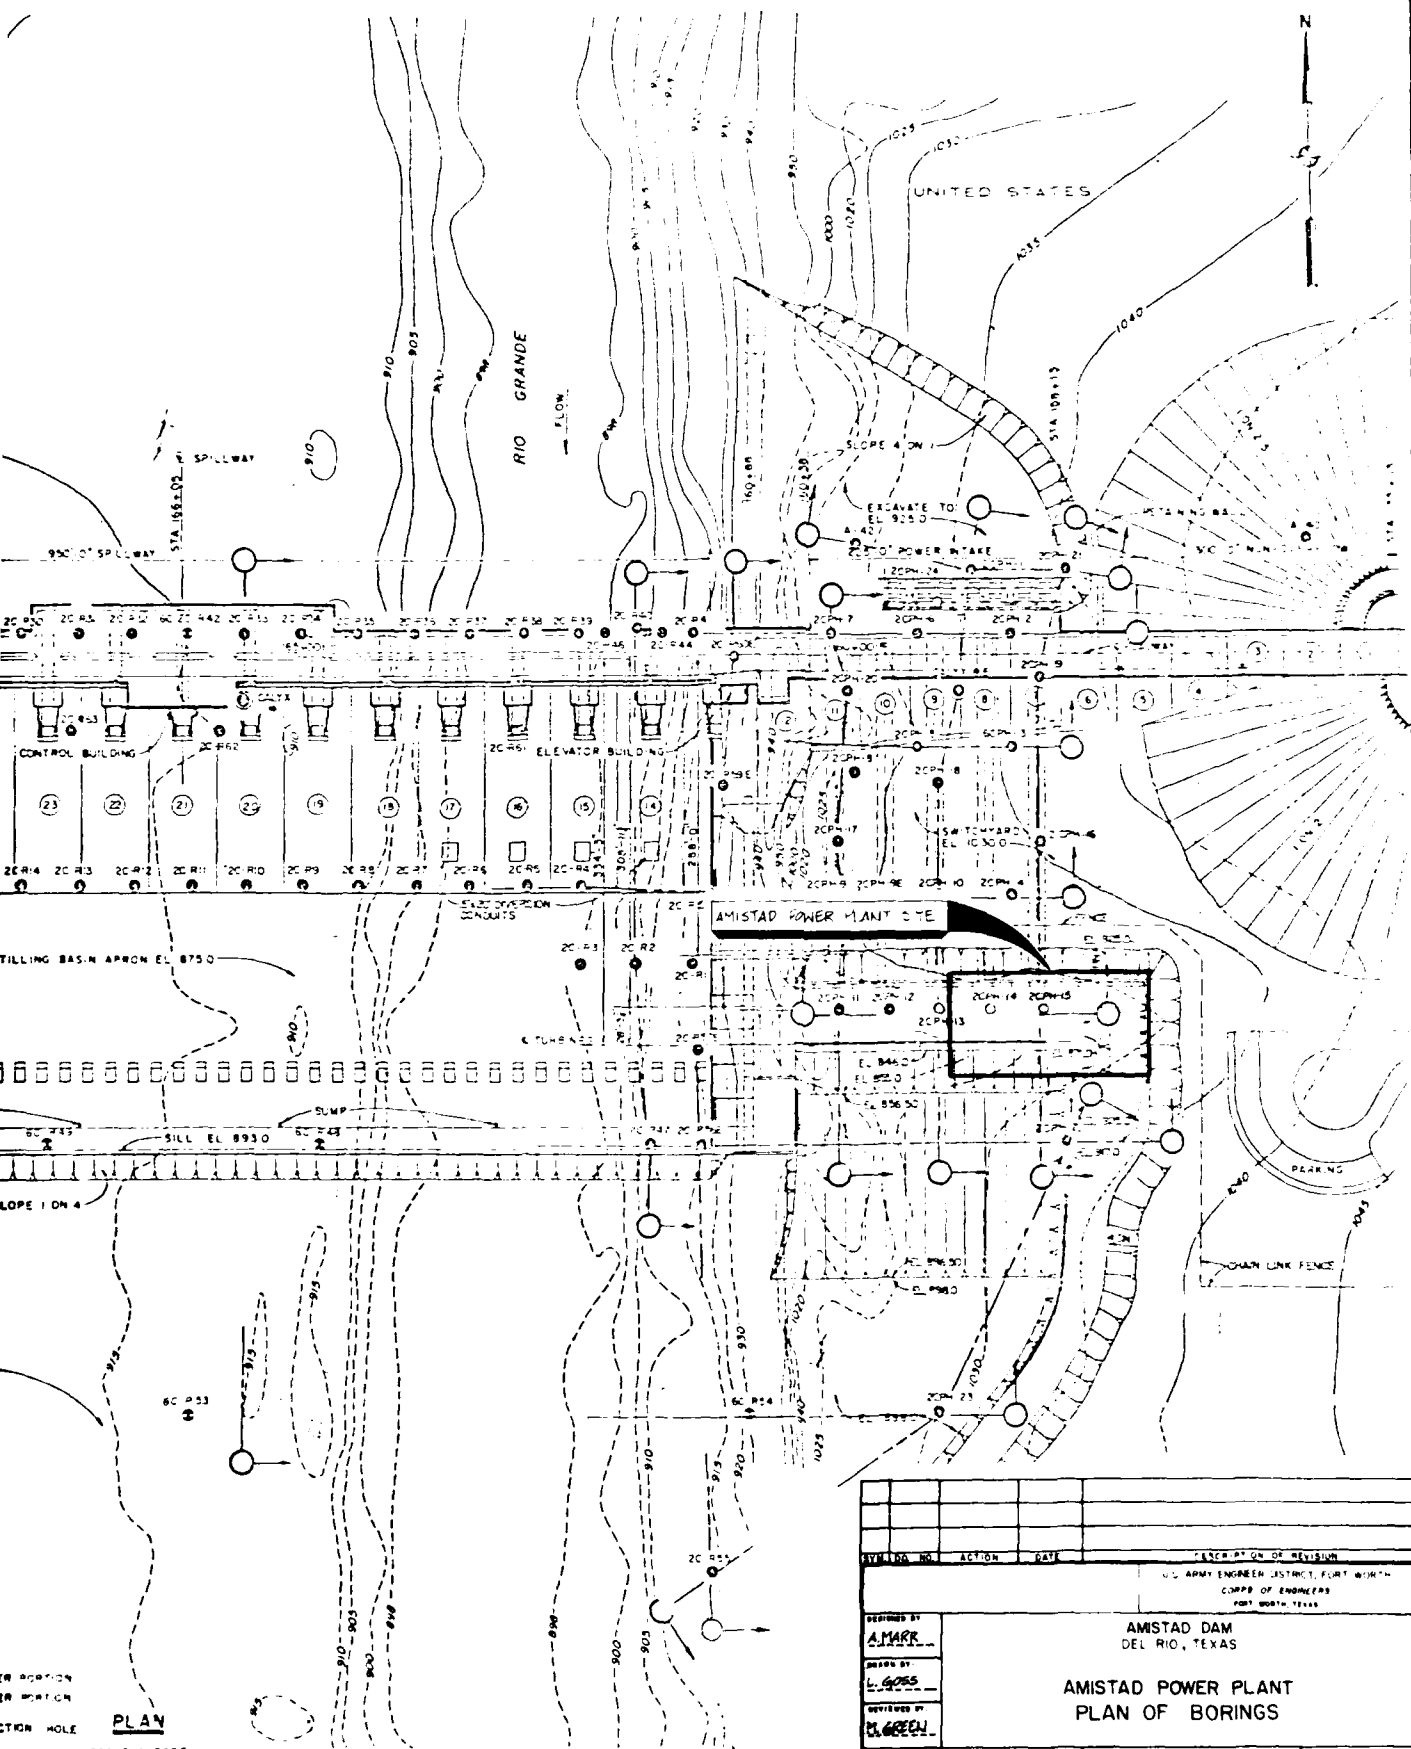

IN PORTION
IN PORTION
ITION HOLE

PLAN

SCALE IN FEET

0 20 40 60 80 100

TO ACCOMPANY FINAL FOUNDATION REPORT

SYMBOL NO.	ACTION	DATE	DESCRIPTION OF REVISION

DESIGNED BY
AMARR

DRAWN BY
L. GOES

REVIEWED BY
M. GREEN

SUBMITTED BY
MEL GREEN
ENGINEER


AMISTAD DAM
DEL RIO, TEXAS

**AMISTAD POWER PLANT
PLAN OF BORINGS**

U.S. ARMY ENGINEER DISTRICT, FORT WORTH
CORPS OF ENGINEERS
FORT WORTH, TEXAS

INVITATION NO. _____ DATE _____


CONTRACT NO. _____ DRAWING NUMBER _____ SHEET NO. _____ OF _____

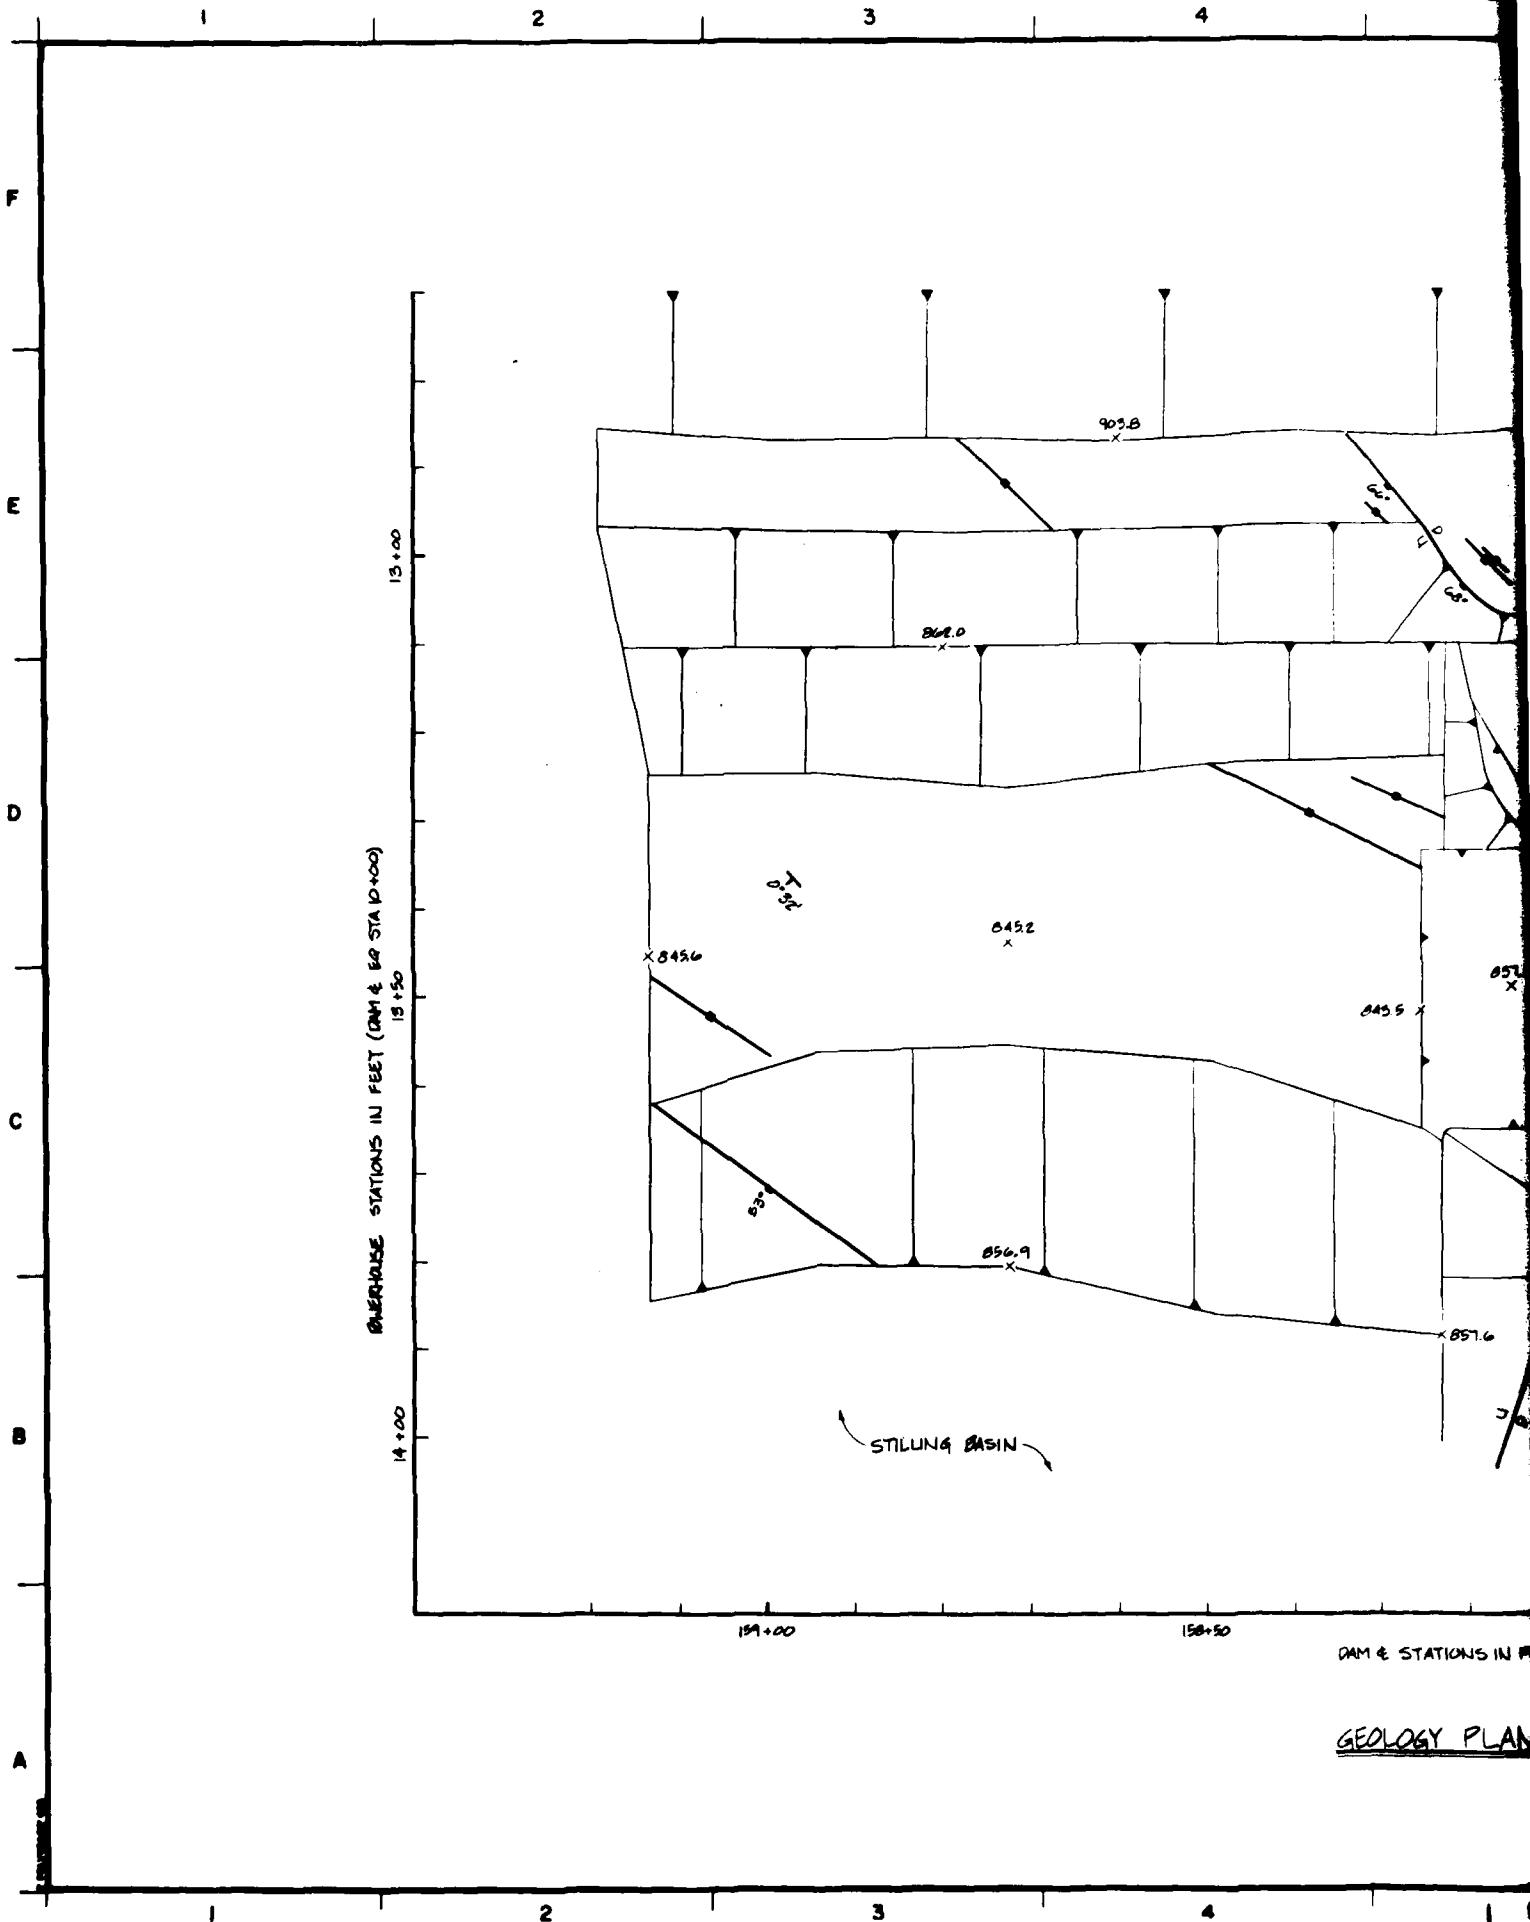

RAILROAD STATIONS IN FEET (D.M. & E.A. STA 10+00)

DAM & STATIONS IN FEET

GEOLOGY PLAN

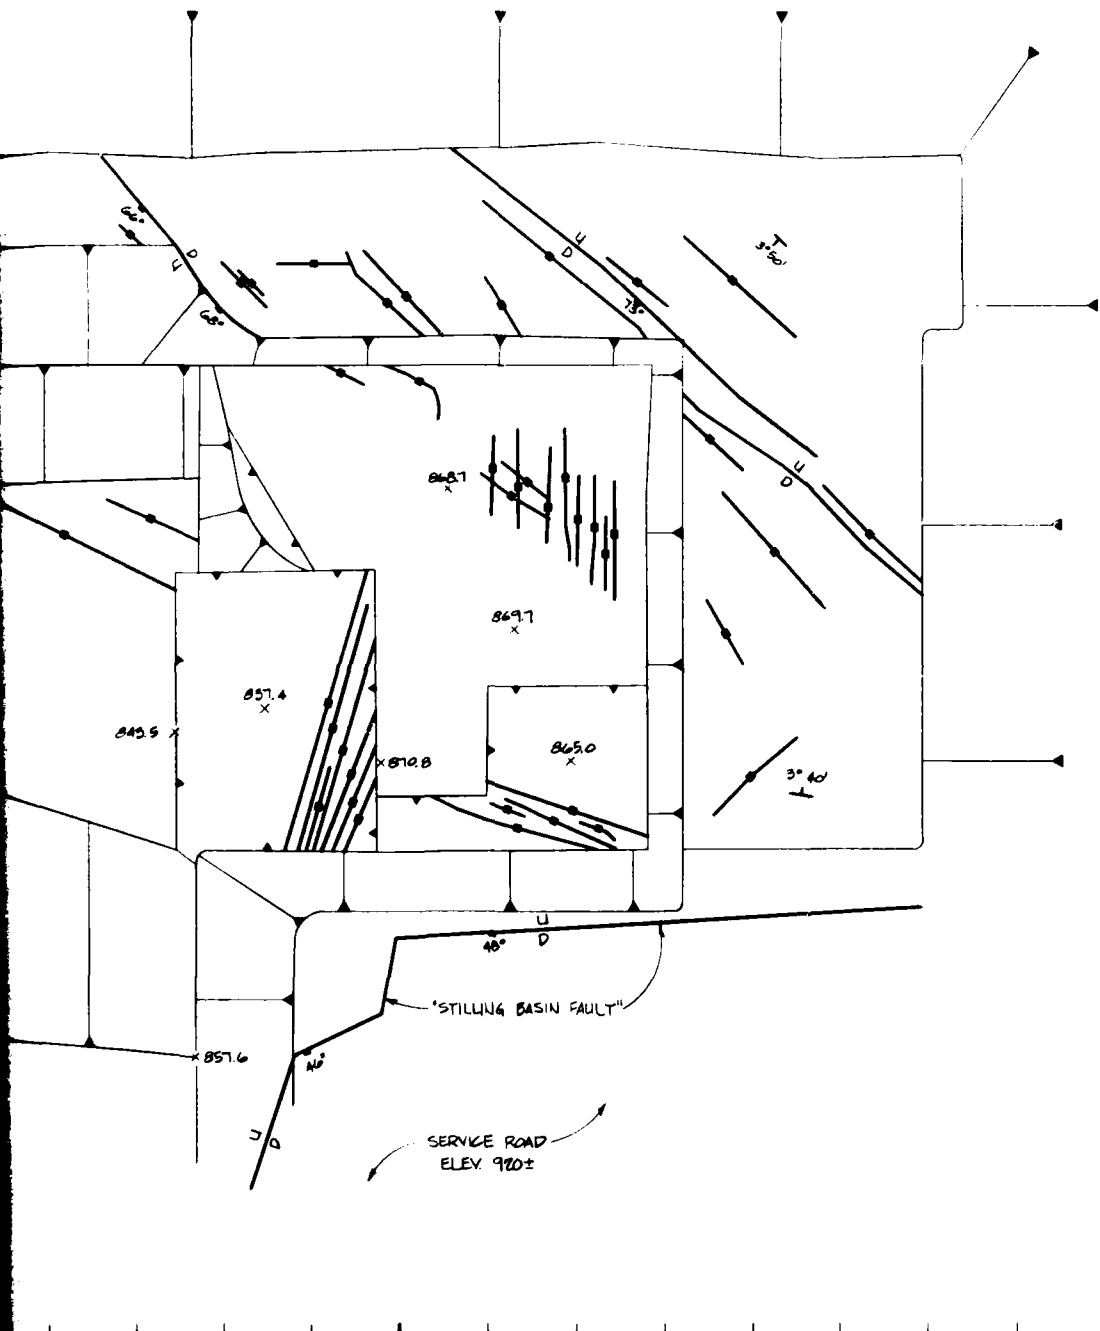

- BEDS 5°-40°
- VERTICAL JOINT
- JOINT 75°
- FAULT THROUGH
- SLOPE
- VERTICAL
- SPOT

DAM & STATIONS IN FEET

158+00

157+50

157+00

GEOLOGY PLAN

NOTES:


1. POWERHOUSE FOUNDATION IS COMPOSED OF GEORGETOWN LIMESTONE FORMATION.
2. FOR GEOLOGIC SECTIONS SEE PLATE 6.
3. SOME FIELD MEASUREMENTS SHOWN WERE OBTAINED DURING CONSTRUCTION OF THE DAM BY IBWC PERSONNEL.

DATE 1924	
DESIGNED BY A. MARR	
DRAWN BY L. A. JOSE	
REVIEWED BY M. GREEN	
SUBMITTED BY MEL GREEN ENGINEER	



LEGEND

- BEDS STRIKING NW-SE AND DIPPING 5°40' TO THE SOUTHWEST
- VERTICAL JOINT
- JOINT STRIKING NW-SE AND DIPPING 75° TO THE SOUTHWEST
- FAULT STRIKING NW-SE, DIPPING 55° TO THE SOUTHWEST, WITH THE DOWN-THROWN SIDE ON THE SOUTHWEST
- SLOPE
- VERTICAL SLOPE
- SPOT ELEVATION

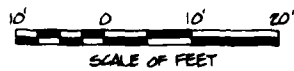

157+00

FORMATION IS COMPOSED OF LIMESTONE FORMATION. SECTION LOCATIONS SEE PLATE 6. MEASUREMENTS SHOWN WERE MADE DURING CONSTRUCTION OF THE BRONNIEEL.

NO.	DATE	ACTION	DESCRIPTION OF REVISION

U.S. ARMY ENGINEER DISTRICT, FORT WORTH
CORPS OF ENGINEERS
FORT WORTH, TEXAS

DESIGNED BY: A. MATR

GRADED BY: L. A. 7/20

CHECKED BY: M. GREEN

SUBMITTED BY: MEL GREEN
ENGINEER

AMISTAD DAM
DEL RIO, TEXAS


AMISTAD POWER PLANT
AS-BUILT EXCAVATION PLAN
GEOLOGY

INVITATION NO. _____ DATE _____

CONTRACT NO. _____ DRAWING NUMBER _____ SHEET NO. _____ OF _____

PLATE 4


3

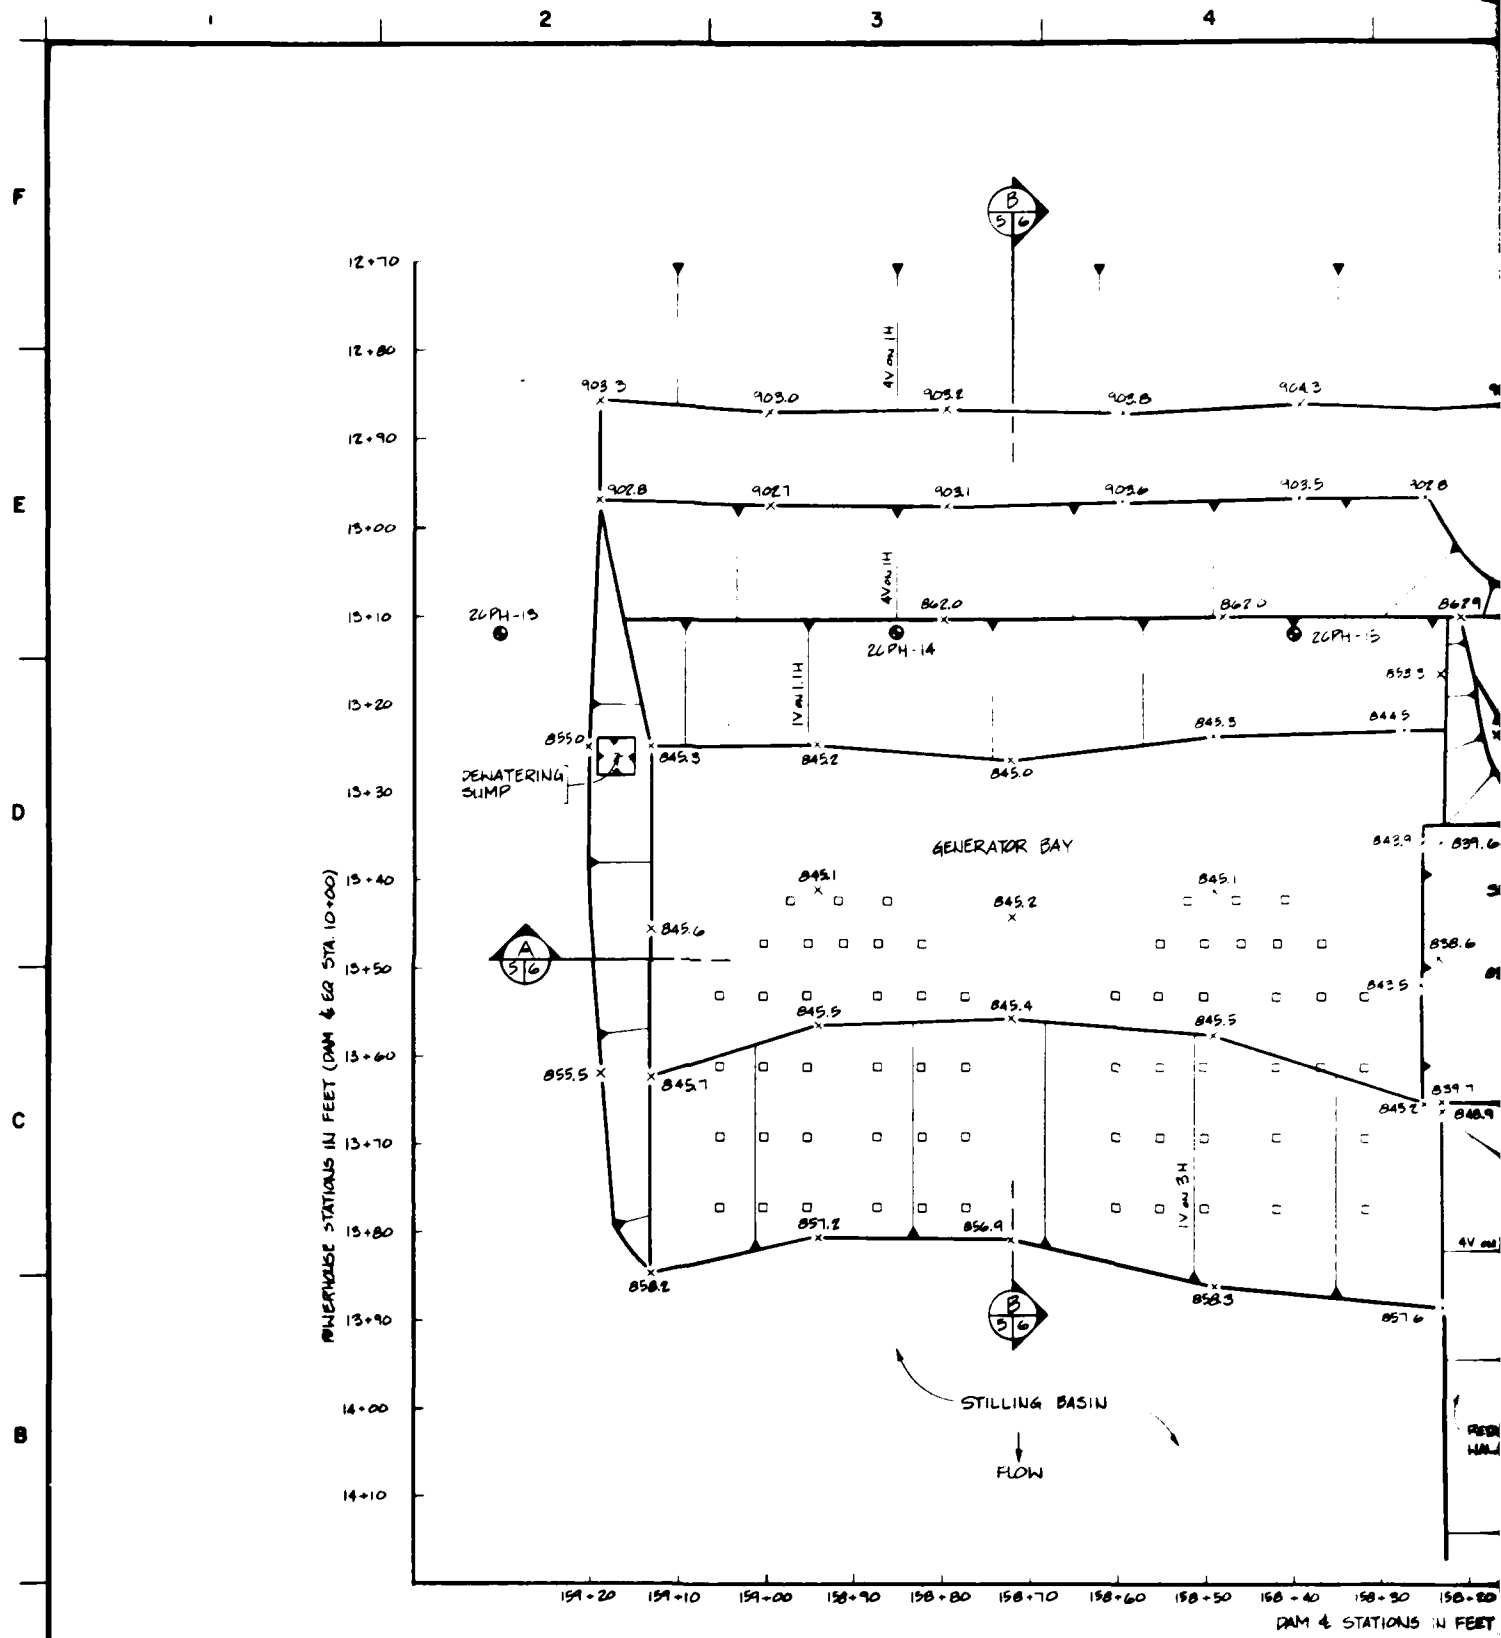


DAM & EQ STA. 10+00

DAM & STATIONS IN FEET

AS-BUILT EXCAVATION

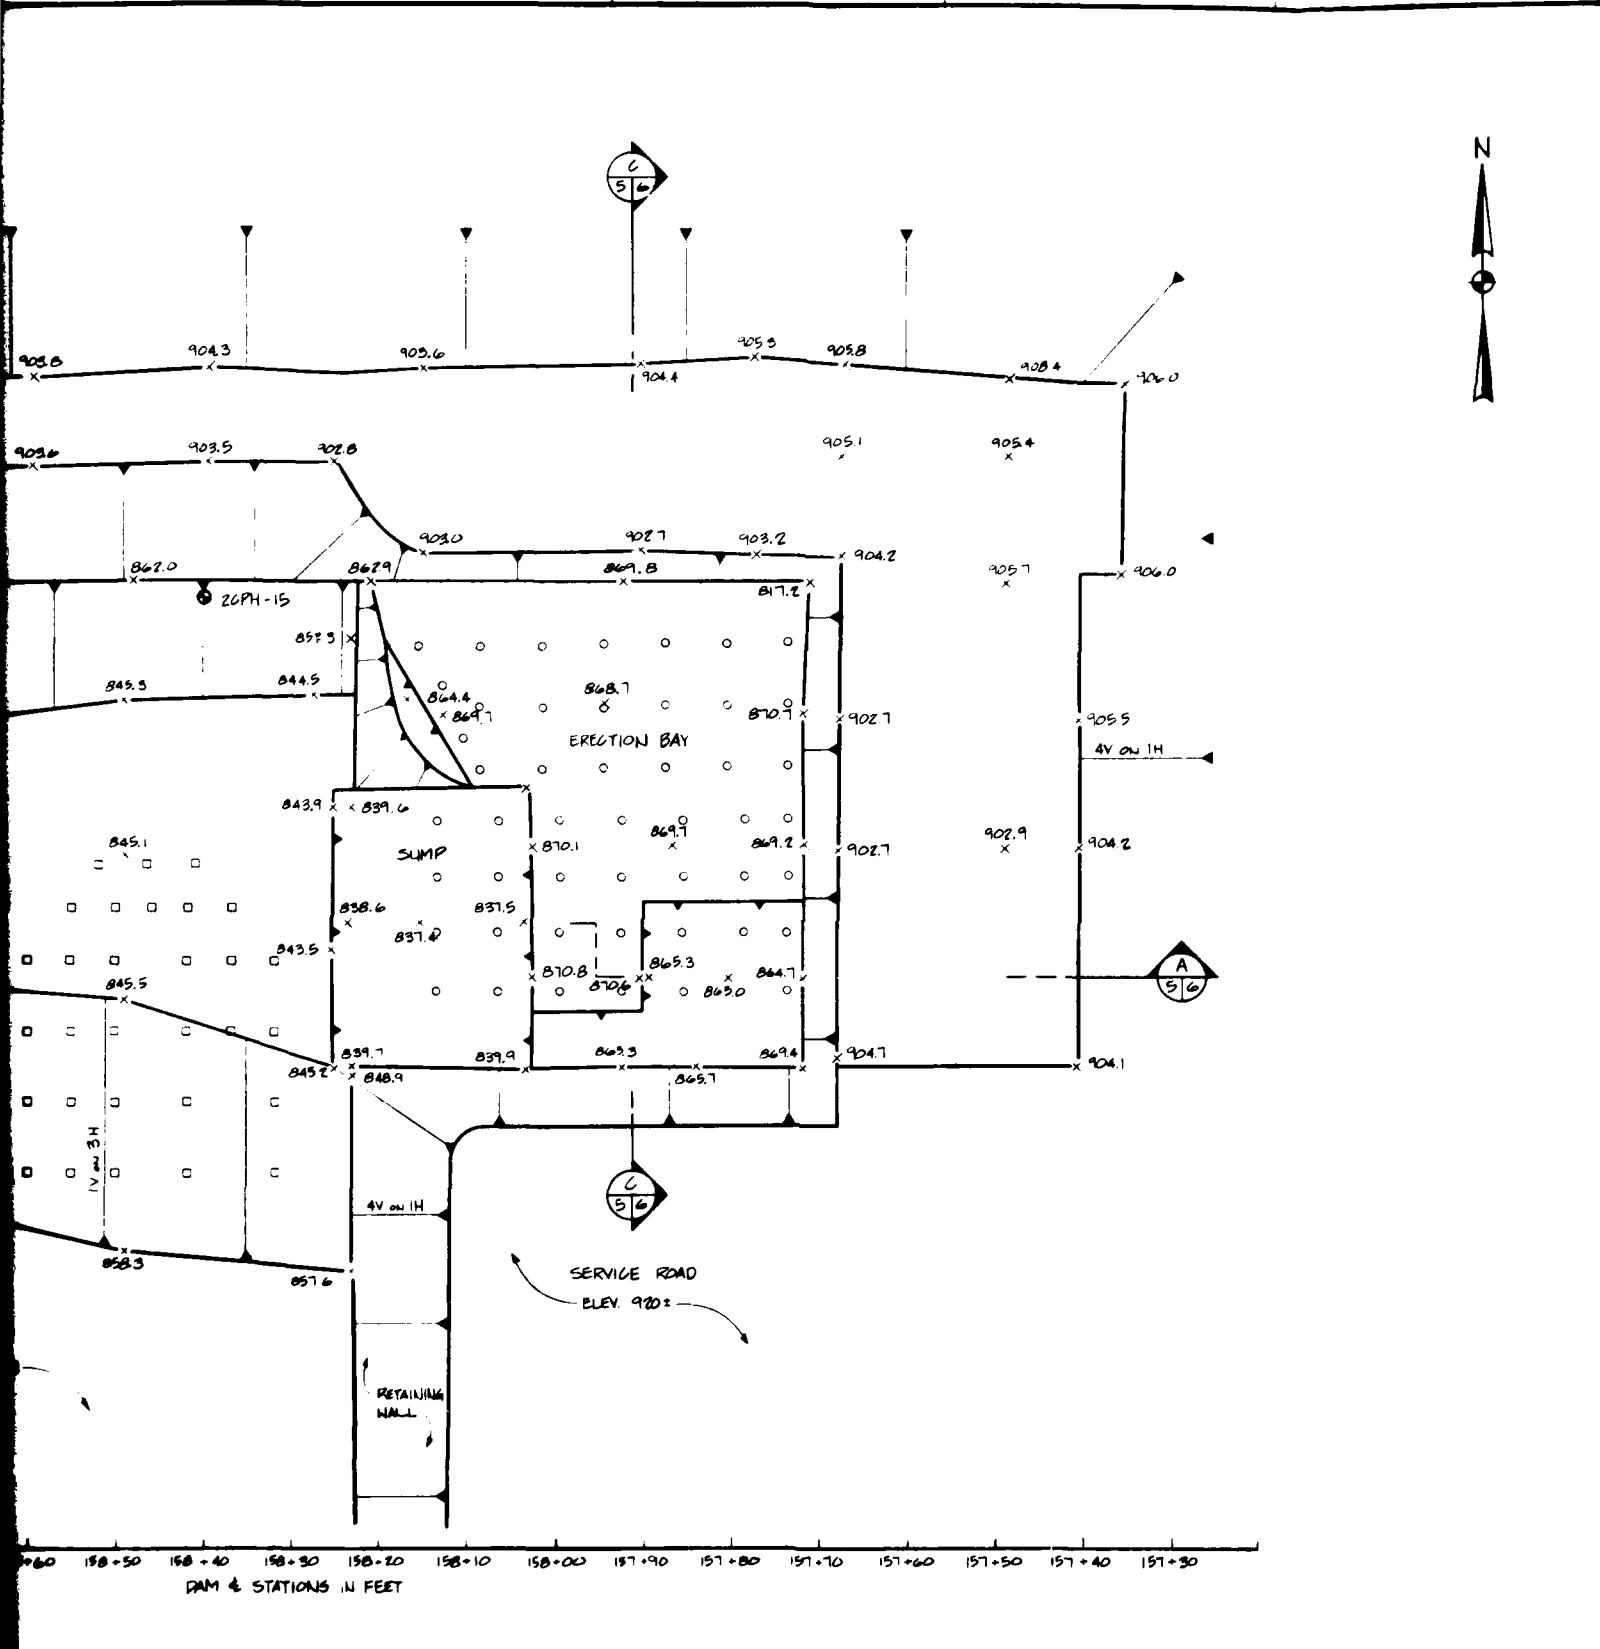

AS-BUILT EXCAVATION PLAN

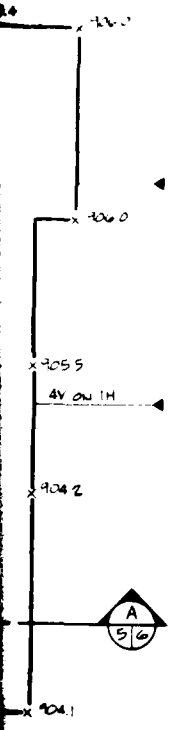


NOTES:



1. FOR CROSS SECTIONS, SEE PLATE 6.
2. FOR LOGS OF BORINGS, SEE PLATES 8.
3. ALL ROCK ANCHORS WERE SET TO A DEPTH OF 30' INTO ROCK.




LEGEND

- ROCK ANCHOR PRESTRESSED TO 80K
- ROCK ANCHOR PRESTRESSED TO 133K
- ZCPH - 2" Ø CORE HOLE LOCATED IN THE POWERHOUSE AREA
- x SPOT ELEVATION

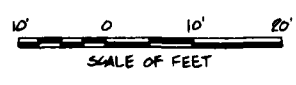

REVISION NO.		ACTION	DATE	DESCRIPTION OF REVISION
		U.S. ARMY ENGINEER DISTRICT, FORT WORTH CORPS OF ENGINEERS FORT WORTH, TEXAS		
DESIGNED BY A. MARR	AMISTAD DAM DEL RIO, TEXAS			
DRAWN BY L. GOSS	AMISTAD POWER PLANT AS-BUILT EXCAVATION PLAN ELEVATIONS			
CHECKED BY M. GREEN				
SUBMITTED BY MEL GREEN ENGINEER	INVITATION NO.	DATE		PLATE
	CONTRACT NO.	SHEET NO.		5
	DRAWING NUMBER	OF		

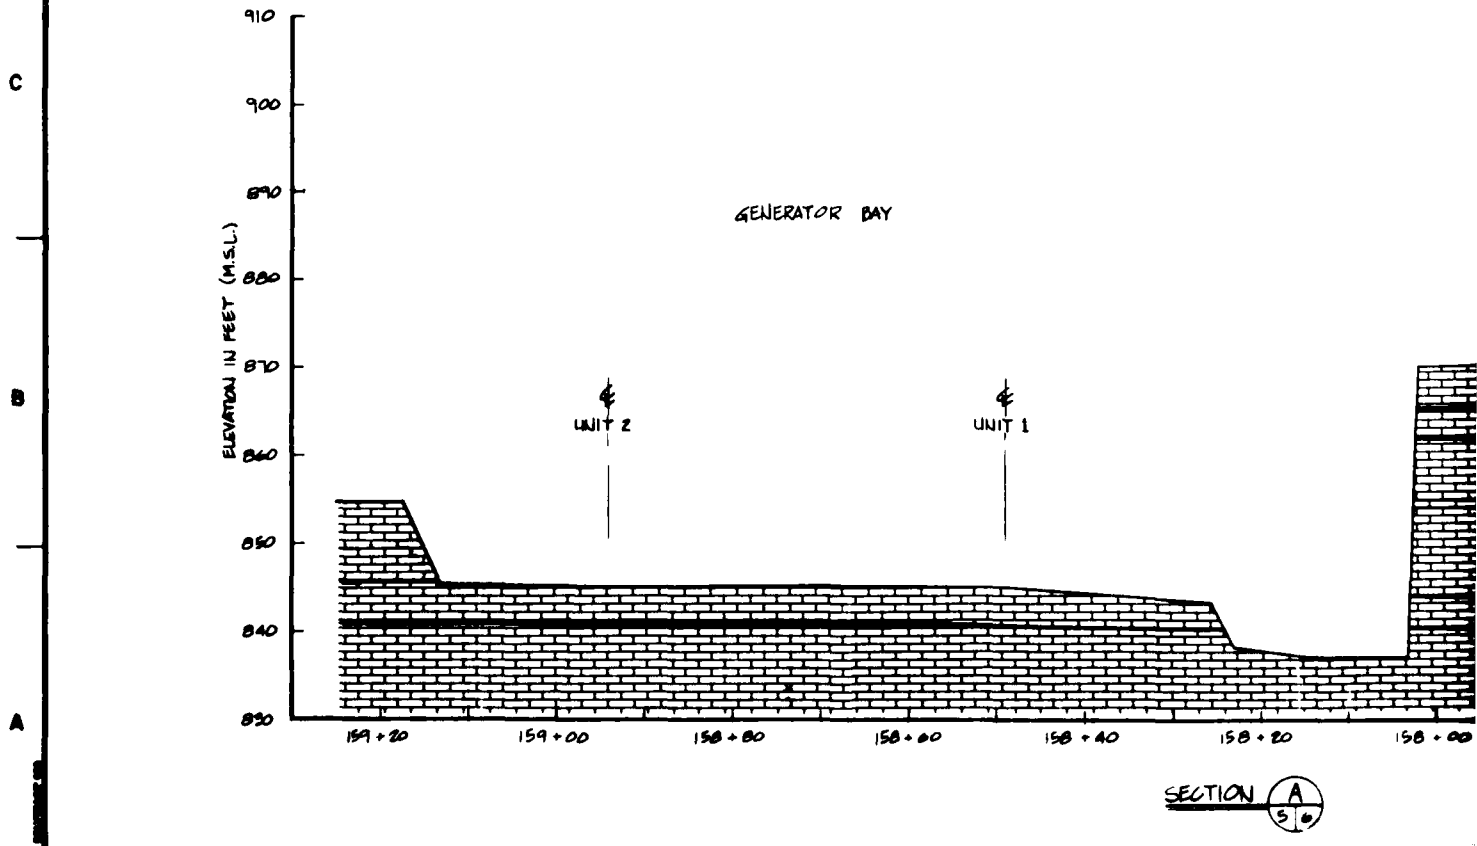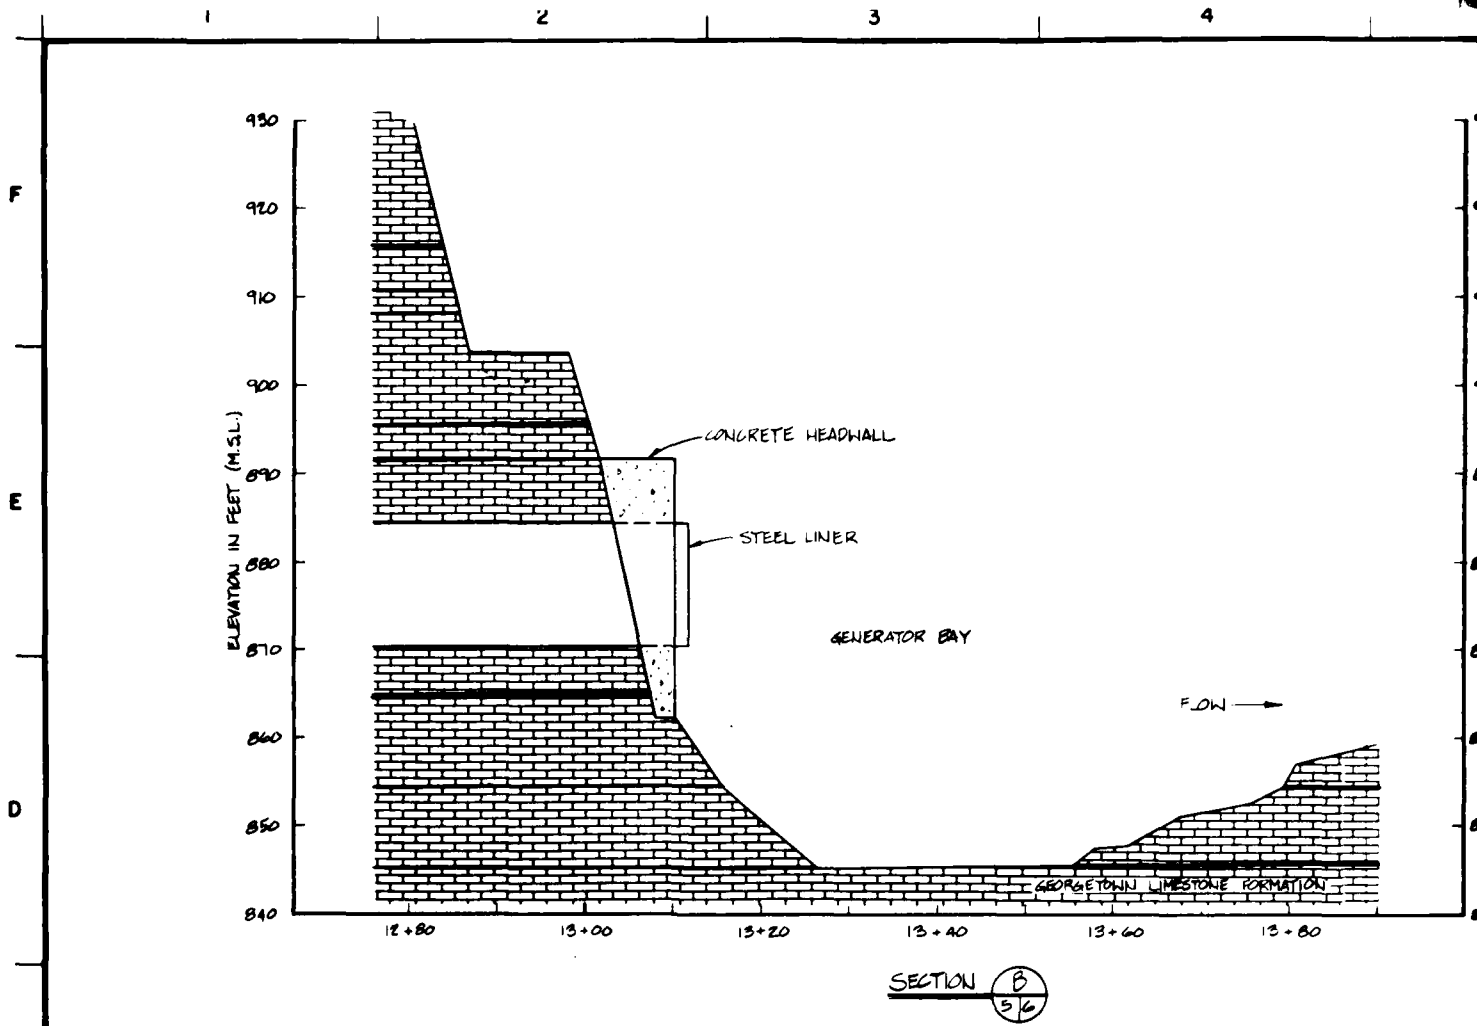


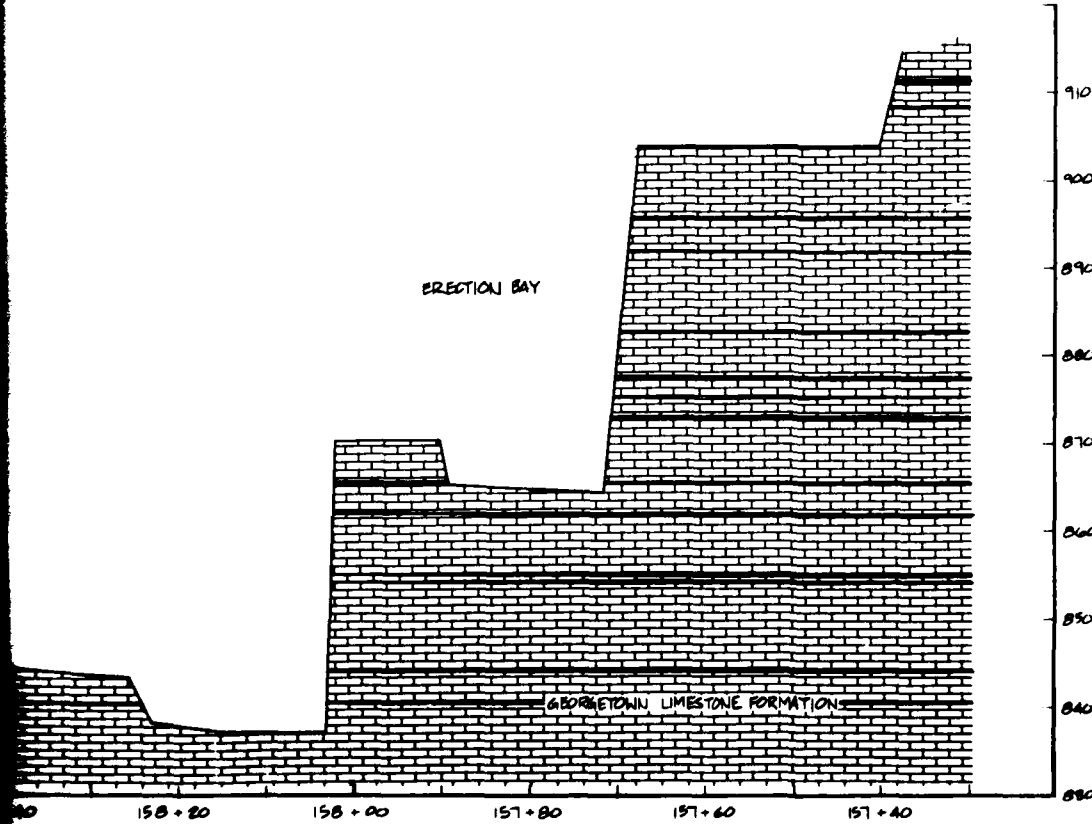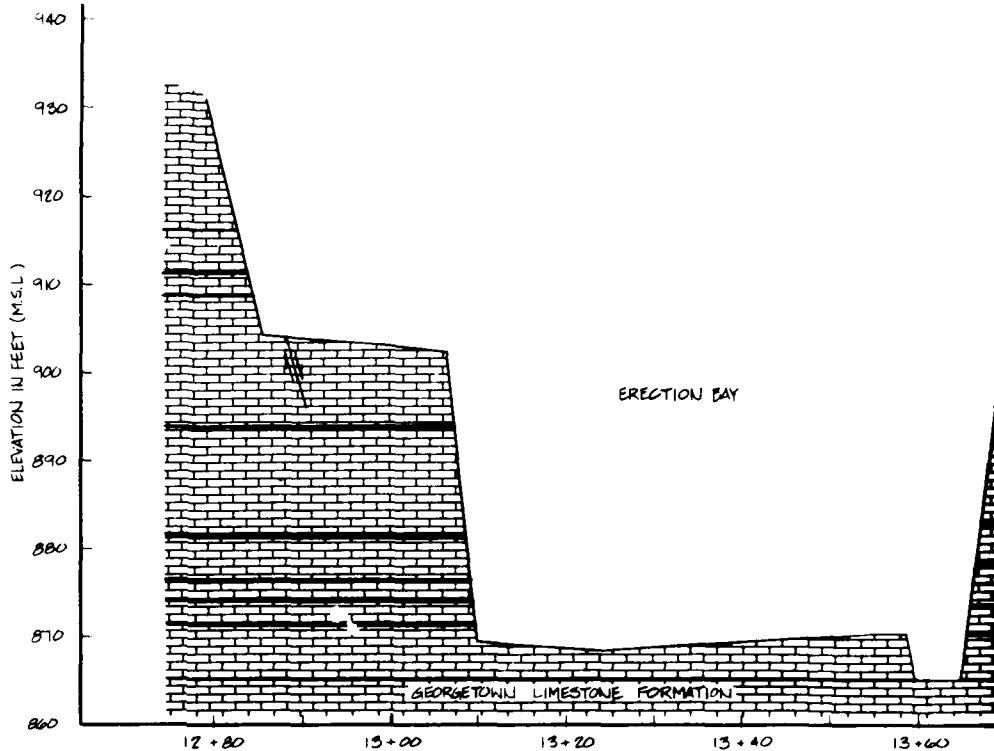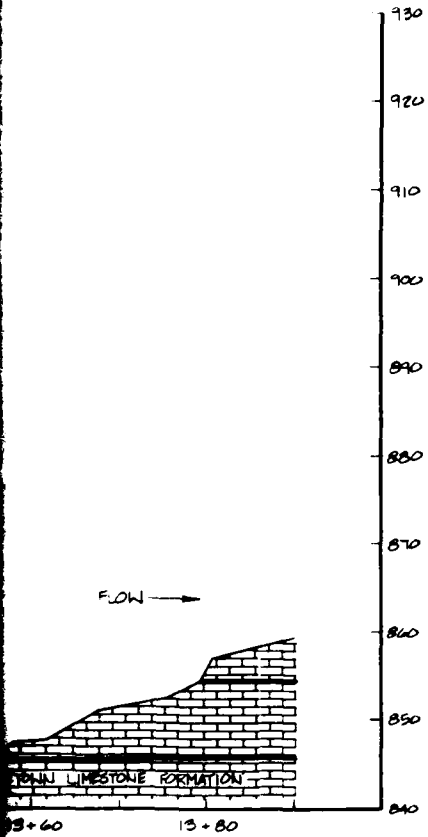

SECTION $\frac{C}{56}$

NOTE:
FOR LOCATION OF SECTIONS,
SEE PLATE 5.

SECTION $\frac{A}{56}$

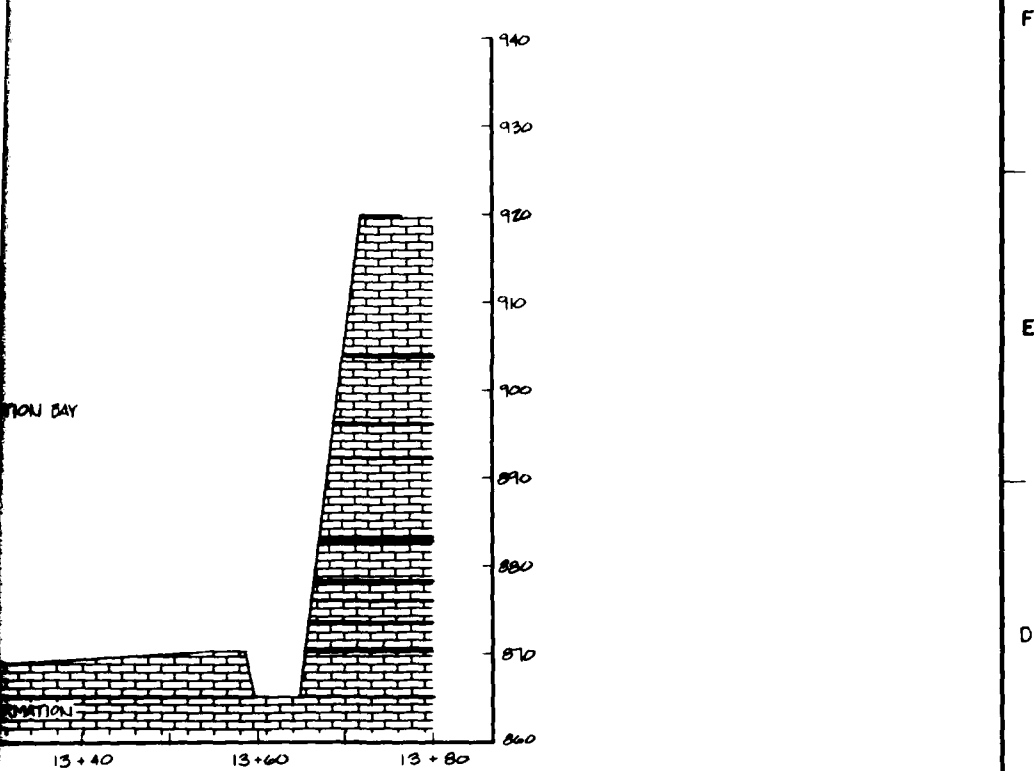



SECTION $\frac{C}{516}$

- LEGEND**
- LIMESTONE (GEORGETOWN FM)
DARKER LINES WITHIN LIMESTONE DENOTE SHALE BANDS
 - NORMAL FAULT EXPOSED AT SURFACE

NOTE:
FOR LOCATION OF SECTIONS,
SEE PLATE 5.

INVITATION NO.	ACTION	DATE	DESCRIPTION OF REVISION
			U.S. ARMY ENGINEER DISTRICT, FORT WORTH CORPS OF ENGINEERS FORT WORTH, TEXAS
DESIGNED BY A. MARR	AMISTAD DAM DEL RIO, TEXAS AMISTAD POWER PLANT GEOLOGIC SECTIONS A-A B-B C-C		
DRAWN BY L. GOES			
REVIEWED BY M. GREEN			
SUBMITTED BY MEL GREEN ENGINEER	INVITATION NO.	DATE	PLATE 6
	CONTRACT NO.	SHEET NO. OF	
	QUANTITY NUMBER		

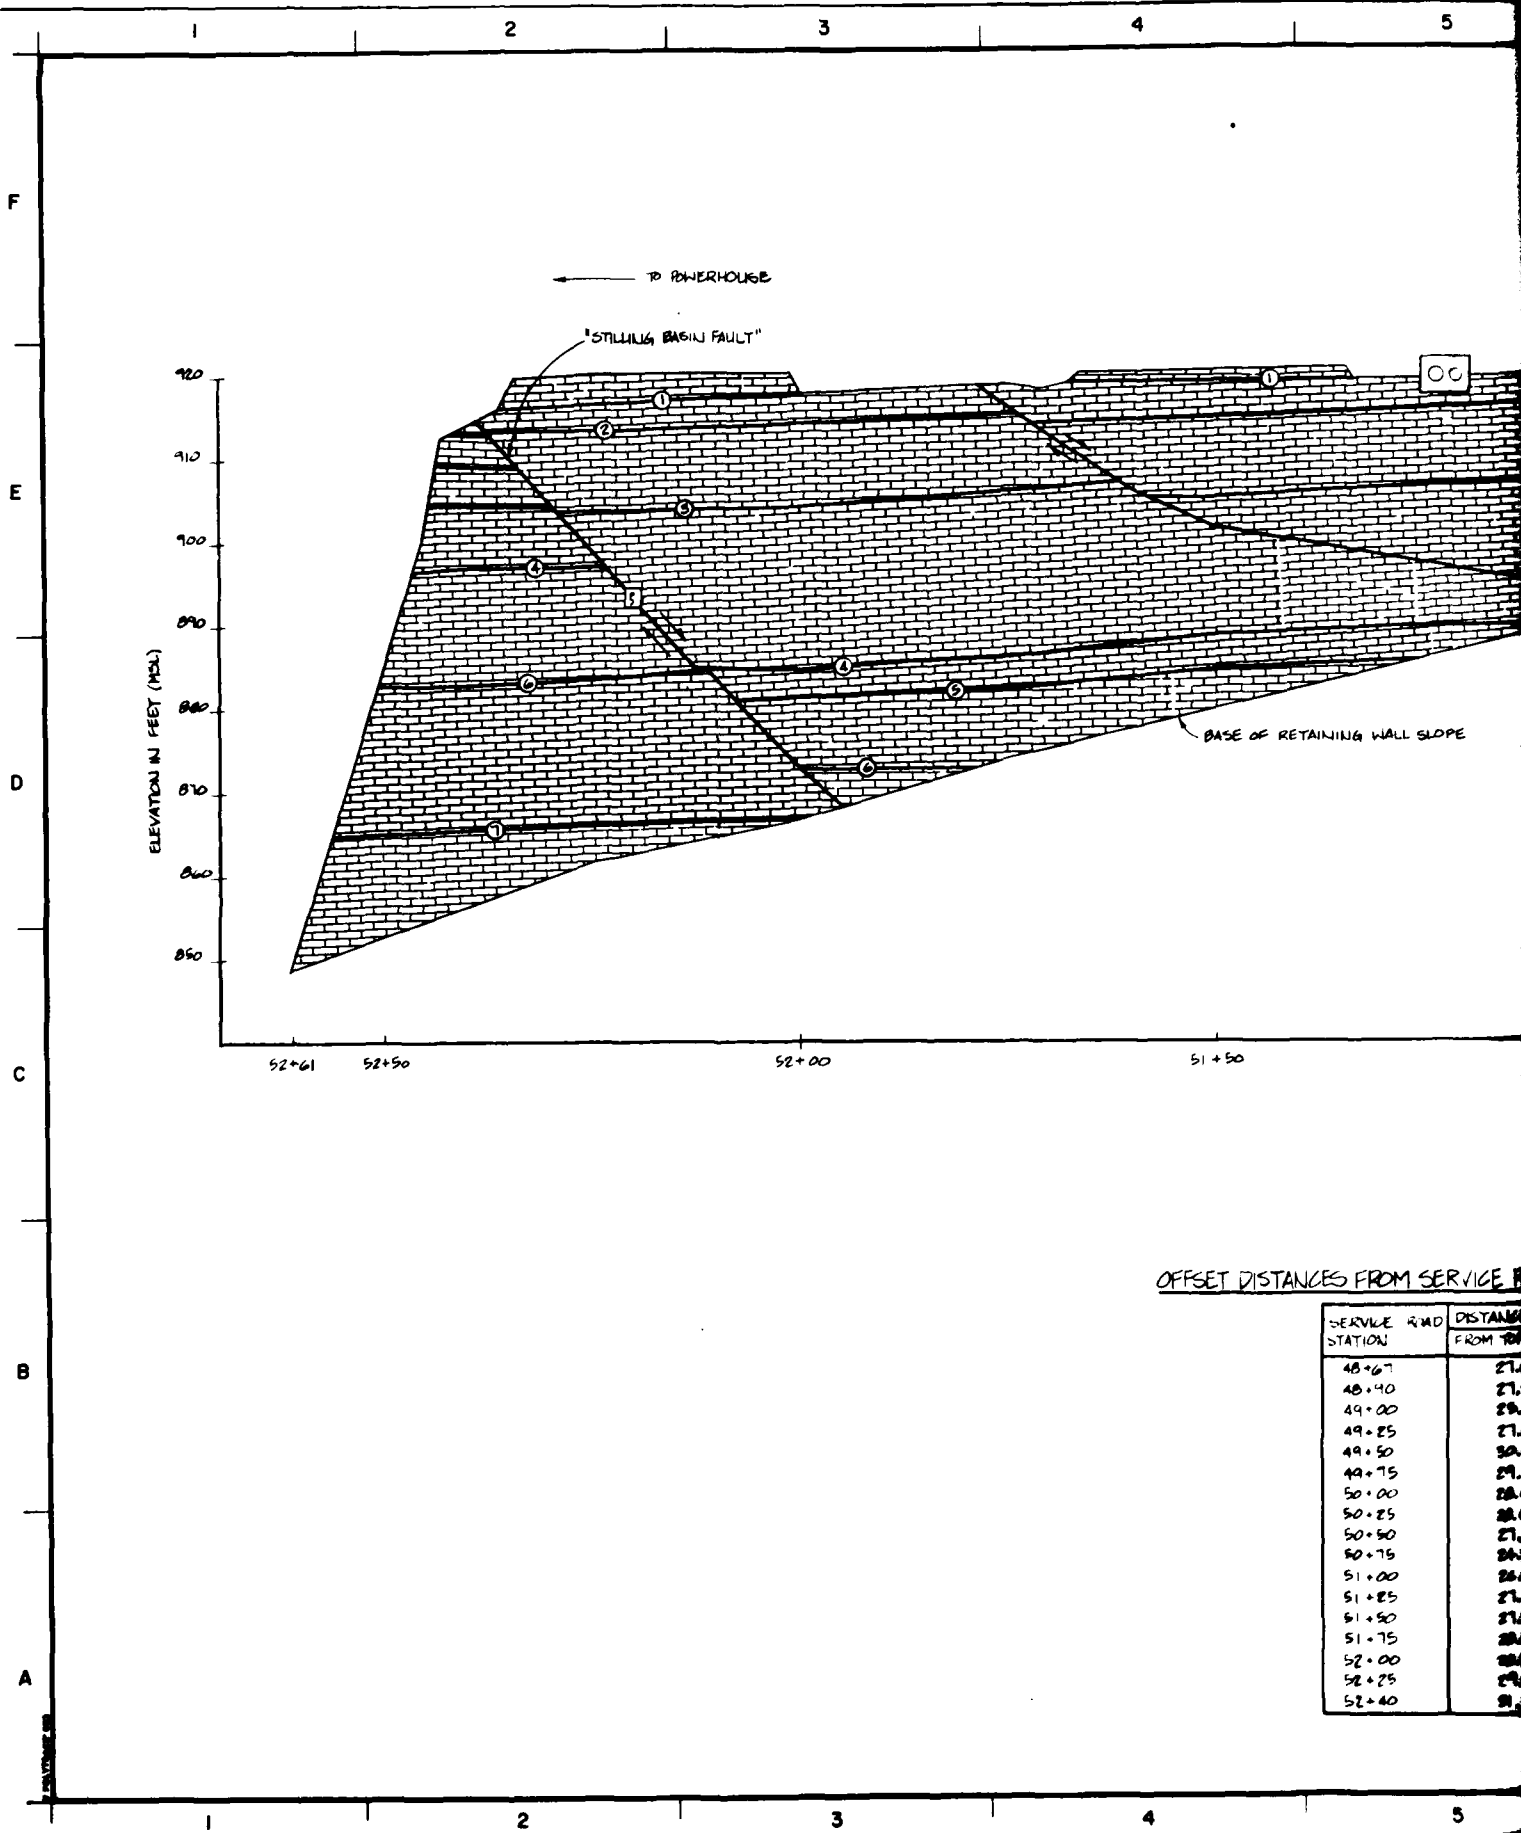

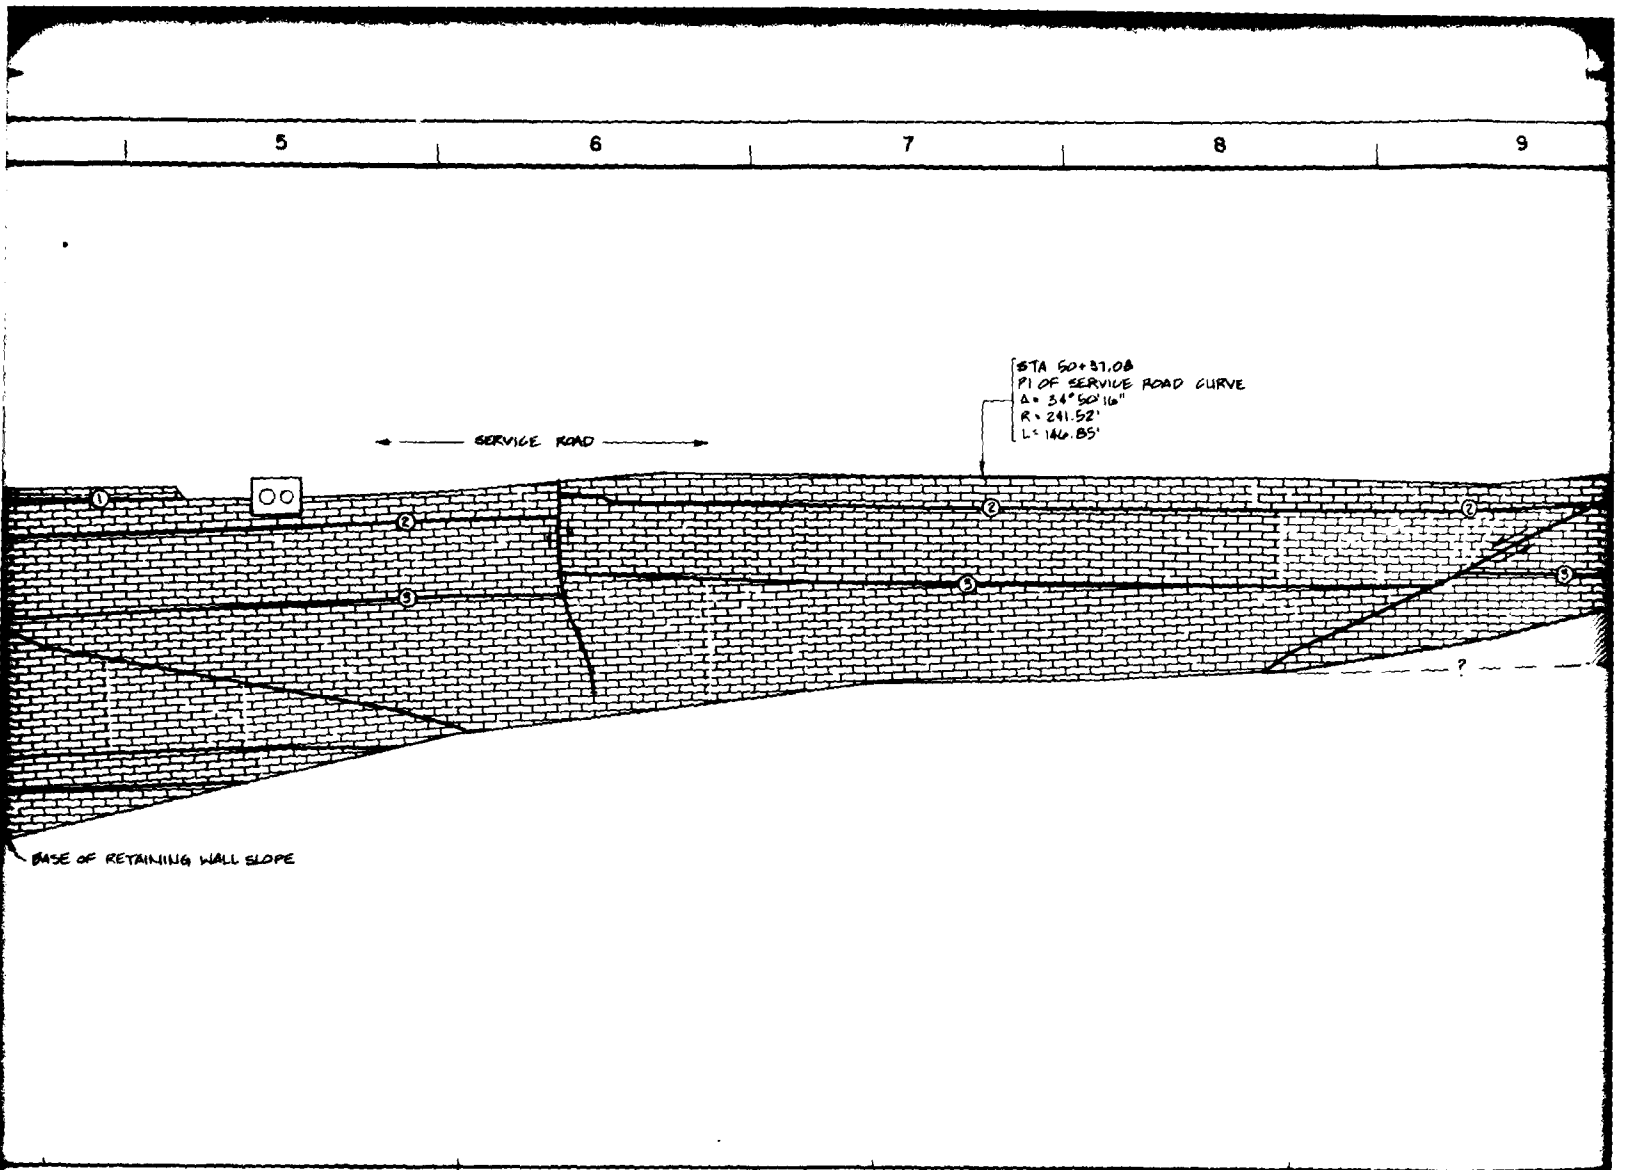

FEET DISTANCES FROM SERVICE ROAD & TO RETAINING WALL FACE.

SERVICE ROAD STATION	DISTANCE TO & SERVICE ROAD (IN FEET)	
	FROM TOP OF SLOPE	FROM BASE OF SLOPE
48+67	27.0	27.0
48+90	27.2	30.0
49+00	29.0	30.4
49+25	27.6	32.2
49+50	30.0	33.8
49+75	29.6	34.9
50+00	28.0	35.2
50+25	28.6	34.4
50+50	27.2	33.1
50+75	24.9	31.1
51+00	26.8	33.1
51+25	27.8	34.7
51+50	27.9	36.9
51+75	28.6	38.9
52+00	28.8	41.5
52+25	29.2	41.5
52+40	31.0	-

LEGEND


- LIMESTONE (GEORGETOWN FM)
- ACCESS ROAD FILL
- COPPERDAM FILL
- SHALE BANDS
- SEEPAGE
- EXPOSED NORMAL FAULT

- NOT
1. SEE
 2. SEE
 3. SEE
 4. SEE



9

10

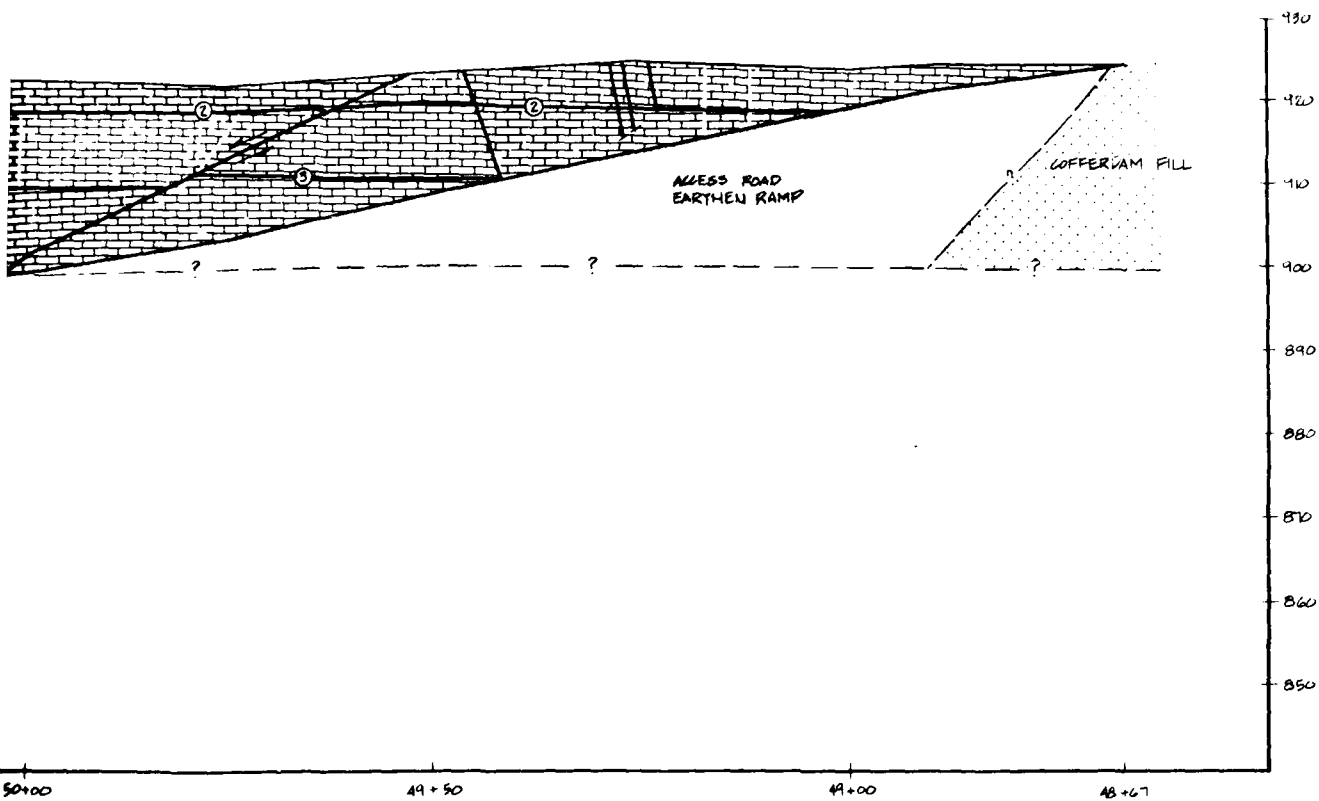


NOTES:

1. SEE PLATE 2 FOR LOCATION OF PROFILE.
2. PROFILE USING SERVICE ROAD CENTERLINE STATIONS. SERVICE ROAD STA 52+47.16 FORWARD EQUALS POWERHOUSE STA 13+79.00 BACKWARD
3. SHALE BANDS ARE NUMBERED FOR CORRELATION PURPOSES.
4. MATERIAL CHANGES DASHED WHERE INFERRED.

REV. NO.	ACTION	DATE	DESCRIPTION OF REVISION
DESIGNED BY A. MARR			U.S. ARMY ENGINEER DISTRICT, FORT WORTH CORPS OF ENGINEERS FORT WORTH, TEXAS AMISTAD DAM DEL RIO, TEXAS AMISTAD POWER PLANT RETAINING WALL GEOLOGIC PROFILE D-D
DRAWN BY L. GROSS			
REVIEWED BY M. GREEN			
SUBMITTED BY MEL GREEN ENGINEER			
INVITATION NO.		DATE	
CONTRACT NO.		SHEET NO. OF 7	
DRAWING NUMBER		DATE	

TO ACCOMPANY FINAL FOUNDATION REPORT

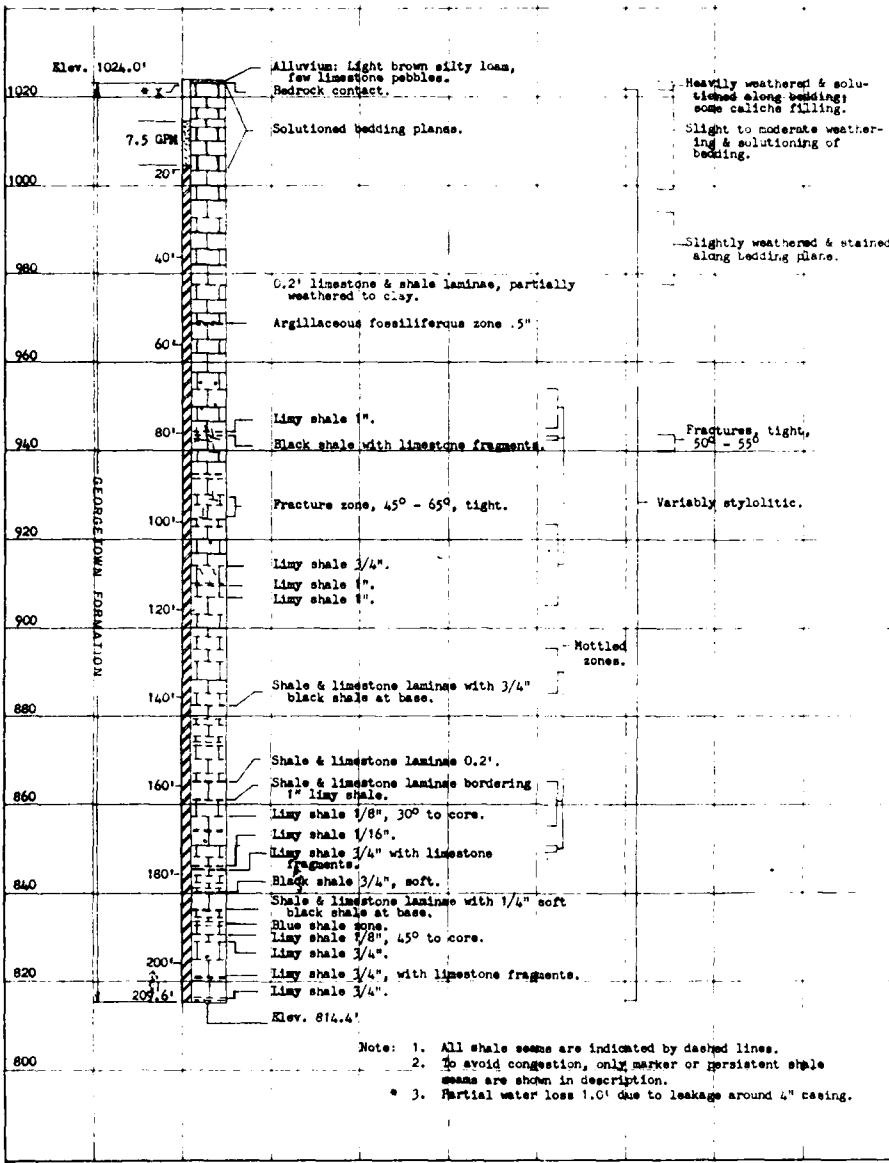


Note: 1. All shale seams are indicated by dashed lines.
 2. To avoid congestion, only marker or persistent shale seams are shown in description.
 3. Partial water loss 1.0' due to leakage around 4" casing.

Altitude Vertical
 Location Axis Sta 159+30
 312' downstream Dam Axis

Total Depth 209.6
 Total Core Bored 206.6
 Total Core Recovered 206.2
 % Total Core Recovered 99.8

Sheet 1 of 1 Sheets
 N.G. Elevation 1024.0
 Casing Elevation 1026.8
 Water Table Elevation 1015.3 (5-7-62)
 Driller DeArmond
 Inspector Trevino, Thornton
 Date Started April 7, 1962
 Date of Completion May 6, 1962



GEOLOGIC LOG
CORE HOLE NO. PH 13

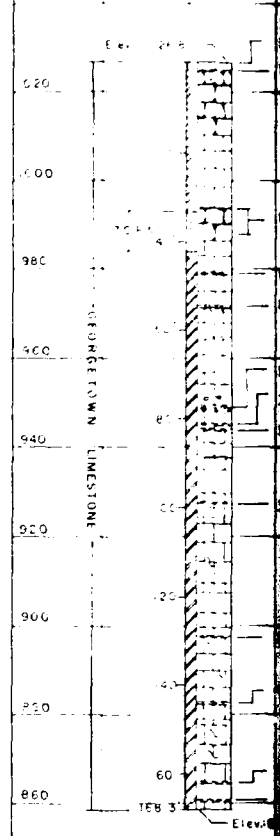

Altitude Vertical
 Location Axis Sta 159+30
 312' downstream Dam Axis


Total Depth 168.3
 Total Core Bored 167.2
 Total Core Recovered 164.8
 % Total Core Recovered 98.6

PARTIAL
 TOTAL
 PRESSURE
 PRESSURE
 RECORD

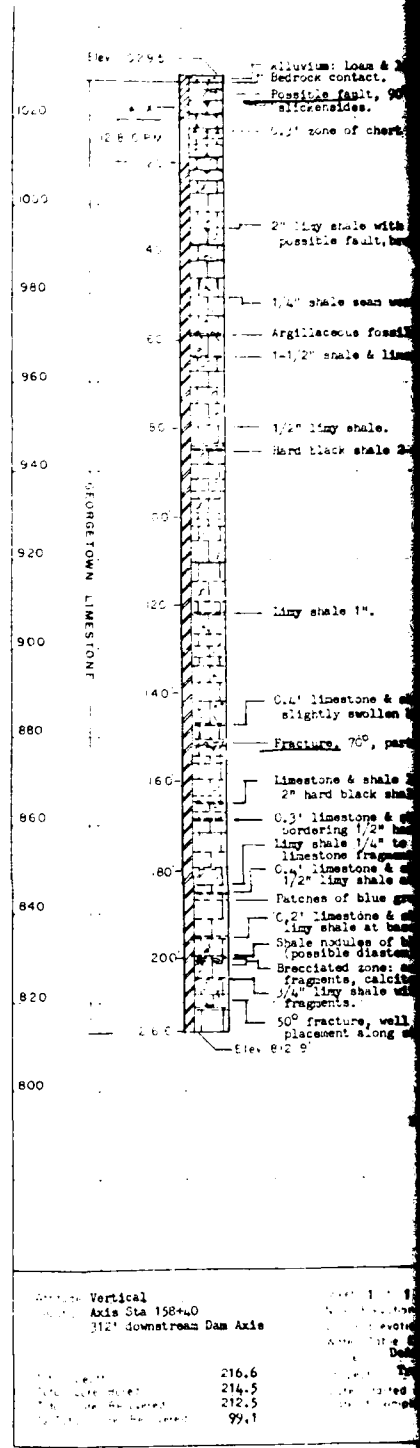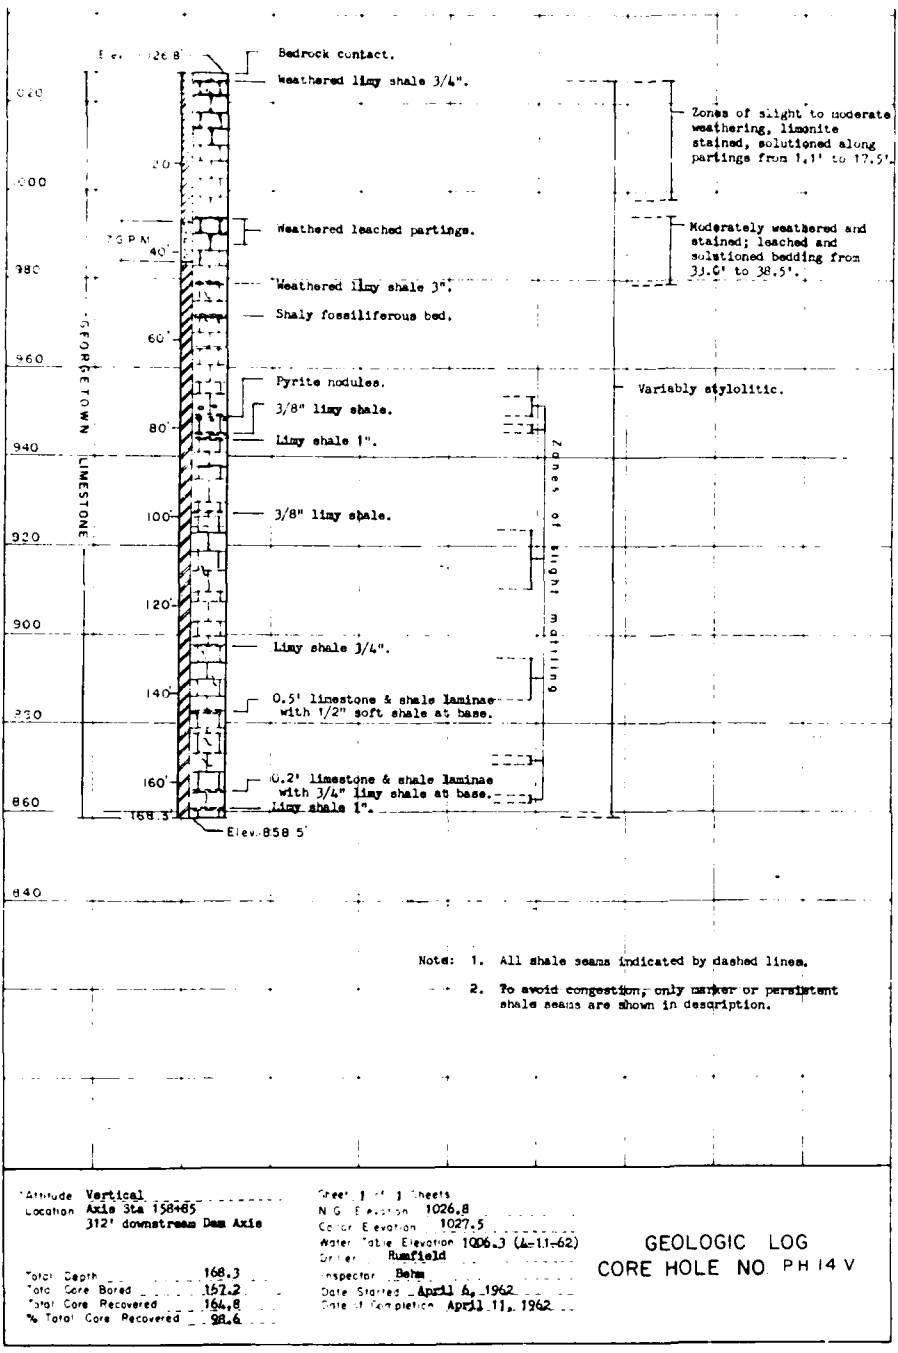

LEGEND

- X PARTIAL LOSS CIRCULATING DRILL WATER
- XX TOTAL LOSS CIRCULATING DRILL WATER
- PRESSURE TEST REFUSAL
- PRESSURE TEST-WATER LOSS
- CIRCULATING DRILL WATER RETURN

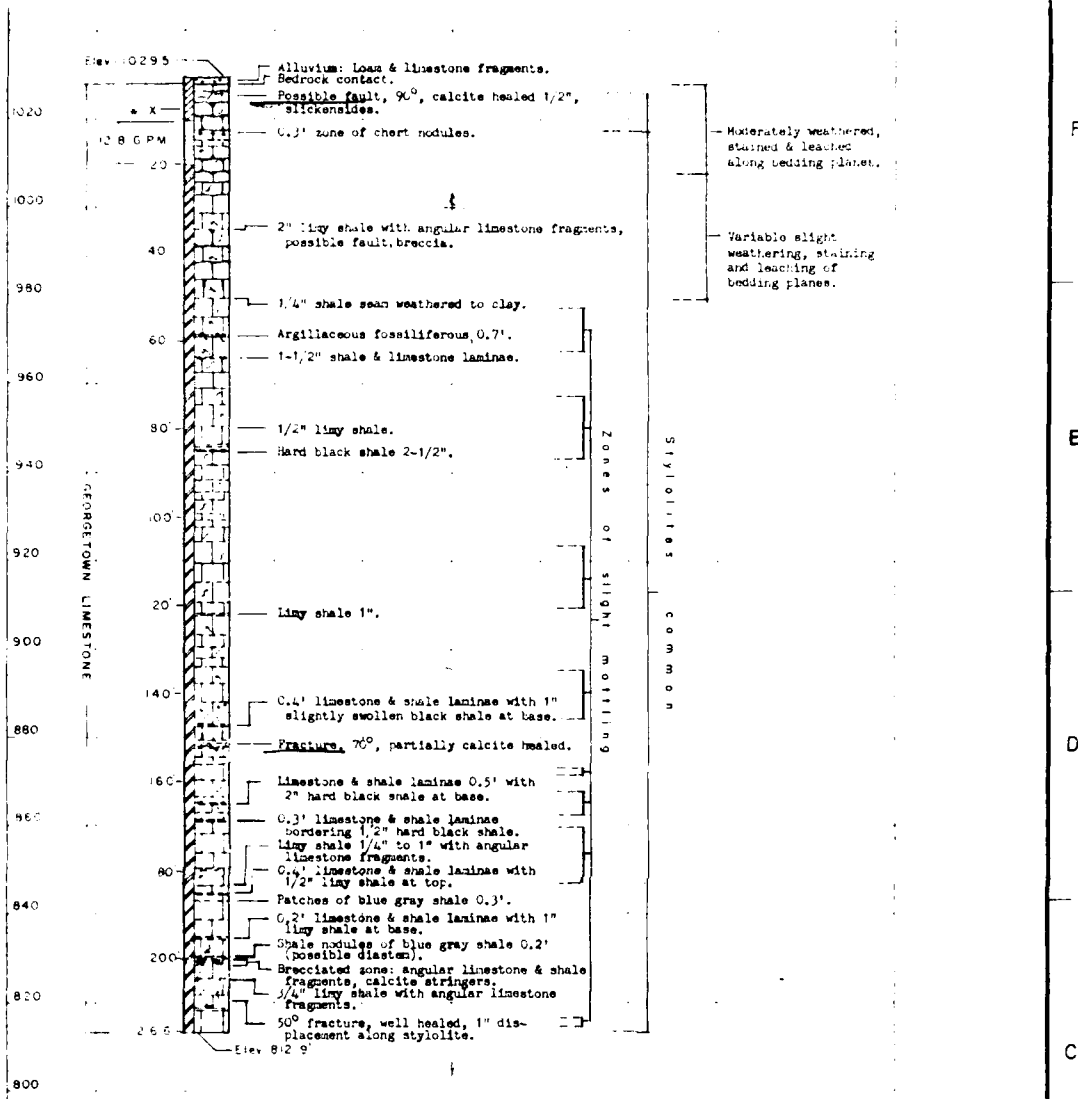

- Note: 1. Shale seams indicated by dashed lines.
2. To avoid congestion only persistent or marker shale beds are shown in description.
- * 3. Unable to set packers to test zone of partial drill water loss.

Vertical
Axis Sta 158+40
312' downstream Dam Axis

216.6
214.5
212.5
99.1

1029.5
1029.9
982.0 (4-16-62)
Dearmond, Runfield
Trautwein, Thornton, Behm
April 4, 1962
April 17, 1962

GEOLOGIC LOG
CORE HOLE NO PH 15 V

SYMBOL NO.		SECTION		DATE		SECTION NUMBER	
U.S. ARMY ENGINEER REGIMENT, FORT WORTH CORPS OF ENGINEERS FORT WORTH, TEXAS							
DESIGNED BY A. MARR	AMISTAD DAM DEL RIO, TEXAS						
DRAWN BY L. GOSS	AMISTAD POWER PLANT LOGS OF BORINGS						
REVIEWED BY M. GREEN							
SUBMITTED BY MEL GREEN ENGINEER	INVITATION NO.		DATE		SHEET NO.		Plate
	CONTRACT NO.				OF		3
	DRAWING NUMBER						3

MED
8