

CONSTRUCTION FOUNDATION REPORT


2

AD-A165 955

NORTHWEST BOUNDARY, RMA CONTAINMENT/ TREATMENT SYSTEM

TEXT, DRAWINGS, PHOTOS,

20030122143

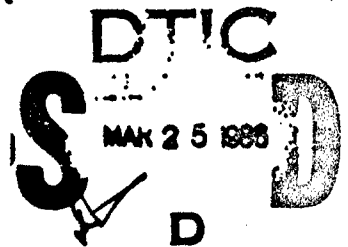

ROCKY MOUNTAIN ARSENAL
Commerce City, Colorado

*Original contains color
plates: All DTIC reproductions
will be in black and
white*

DTIC FILE COPY

MARCH 1986



US Army Corps
of Engineers
Omaha District

This document has been approved
for public release and sale; its
distribution is unlimited.

86 3 24 064

DISCLAIMER NOTICE

THIS DOCUMENT IS BEST QUALITY PRACTICABLE. THE COPY FURNISHED TO DTIC CONTAINED A SIGNIFICANT NUMBER OF PAGES WHICH DO NOT REPRODUCE LEGIBLY.

UNCLASSIFIED

SECURITY CLASSIFICATION OF THIS PAGE (When Data Entered)

REPORT DOCUMENTATION PAGE		READ INSTRUCTIONS BEFORE COMPLETING FORM
1. REPORT NUMBER	2. GOVT ACCESSION NO.	3. RECIPIENT'S CATALOG NUMBER
4. TITLE (and Subtitle) ROCKY MOUNTAIN ARSENAL NORTHWEST BOUNDARY CONTAINMENT/TREATMENT SYSTEM CONSTRUCTION FOUNDATION REPORT		5. TYPE OF REPORT & PERIOD COVERED Final Report
7. AUTHOR(s) Linda M. Houston		6. PERFORMING ORG. REPORT NUMBER
9. PERFORMING ORGANIZATION NAME AND ADDRESS U.S. Army Corps of Engineers, Omaha District Geotechnical Branch, Geology Sect. (MROED-GC) 6014 U.S.P.O. and Courthouse, Omaha, NE 68102		8. CONTRACT OR GRANT NUMBER(s) DACA 45- 83 -C0123
11. CONTROLLING OFFICE NAME AND ADDRESS Director Rocky Mountain Arsenal Commerce City, CO		10. PROGRAM ELEMENT, PROJECT, TASK AREA & WORK UNIT NUMBERS
14. MONITORING AGENCY NAME & ADDRESS (if different from Controlling Office)		12. REPORT DATE March 1986
		13. NUMBER OF PAGES 86
		15. SECURITY CLASS. (of this report) Unclassified
		15a. DECLASSIFICATION/DOWNGRADING SCHEDULE
16. DISTRIBUTION STATEMENT (of this Report) Approved for public release, distribution unlimited		
17. DISTRIBUTION STATEMENT (of the abstract entered in Block 20, if different from Report) <i>fr back</i>		
18. SUPPLEMENTARY NOTES This project was authorized by Directive No. 2 Design FY 82 - Rocky Mountain Arsenal dated 8 January 1982, and Directive No. 1, FY 81, PN 36.2 Liquid Waste Disposal, Phase II - WPC dated 14 January 1983.		
19. KEY WORDS (Continue on reverse side if necessary and identify by block number) Ground Water Hydrology, Soil-Bentonite Cutoff Barrier, Excavation, Permeability, Carbon Adsorption, Transmissivity, Dewater Wells, Organic Contaminant, Recharge Wells, Bedrock,		
20. ABSTRACT (Continue on reverse side if necessary and identify by block number) The Northwest Boundary Project is located along the northwest boundary of Rocky Mountain Arsenal, Commerce City, Colorado. The system was constructed to contain and treat ground water which has been polluted with organic contaminants produced at the arsenal. The system consists of: 1) A Soil Bentonite cutoff barrier keyed into bedrock, 2) 15 dewatering wells, 3) 21 recharge wells, 4) 17 piezometers, and 5) a carbon adsorption treatment plant.		

UNCLASSIFIED

SECURITY CLASSIFICATION OF THIS PAGE (When Data Entered)

Cost

Foundation explorations included soil borings, bedrock sampling, ground water hydrology testing, and bedrock and soil permeability tests. Investigations during construction included visually logging well cuttings, inspection of excavated slurry trench materials, blast hole drilling, and slurry and backfill testing.

The contract began in July 1983 and was essentially completed by July 1984. Ms. L. M. Houston was the geotechnical inspector.

Keywords: J
FLD 19

UNCLASSIFIED

**ROCKY MOUNTAIN ARSENAL NORTHWEST BOUNDARY
CONTAINMENT/TREATMENT SYSTEM CONSTRUCTION**

FOUNDATION REPORT

TABLE OF CONTENTS

<u>Paragraph</u>	<u>Title</u>	<u>Page</u>
<u>CHAPTER 1 - INTRODUCTION</u>		
1.1	Location and Description	1-1
1.2	Construction Authority	1-1
1.3	Purpose of Report	1-2
1.4	Project History	1-2
1.5	Design Concept	1-6
1.6	Location of Containment/Treatment System	1-6
1.7	Contractors and Contract Supervision	1-7
1.8	Resident and Design Staff	1-9
<u>CHAPTER 2 - FOUNDATION EXPLORATION AND STUDIES</u>		
2.1	Preconstruction Investigations	2-1
2.2	Investigations During Construction	2-2
<u>CHAPTER 3 - GEOLOGY</u>		
3.1	General Geology	3-1
3.2	Site Geology	3-3
3.3	Ground Water Hydrology	3-5
3.4	Engineering Characteristics of Overburden	3-6
3.5	Engineering Characteristics of Bedrock	3-6
<u>CHAPTER 4 - EXCAVATION PROCEDURES</u>		
4.1	General Excavations	4-1
4.2	Scheduling	4-1
4.3	Excavation Grades	4-1
4.4	Well Drilling	4-2
4.5	Barrier Construction	4-6
4.6	Blasting	4-9
4.7	Safety Precautions	4-9
<u>CHAPTER 5 - CHARACTER OF FOUNDATION</u>		
5.1	General	5-1
5.2	Cemented Zones	5-1

TABLE OF CONTENTS (CONT'D)

<u>Paragraph</u>	<u>Title</u>	<u>Page</u>
<u>CHAPTER 5 - CHARACTER OF FOUNDATION (CONT'D)</u>		
5.3	Cobbles and Boulders	5-1
5.4	Denver Formation Sandstones	5-1
5.5	Clay Shale	5-1
<u>CHAPTER 6 - POSSIBLE FUTURE PROBLEMS</u>		
6.1	Potential Problem Conditions	6-1
6.2	Recommended Observations	6-1

*Photocopy containing color
information. All DTIC reproductions
will be in black and white.*

Accession For	
NTIS CRA&I	<input checked="" type="checkbox"/>
DTIC TAB	<input type="checkbox"/>
Unannounced	<input type="checkbox"/>
Justification	
By _____	
Distribution: /	
Availability Codes	
Dist	Avail and/or Special
A-1	23

Loose

FIGURES

Figure

Title

Page

3-1
3-2

Topographic Map of RMA
Denver Formation Outcrop

3-1i
3-3i

TABLES

<u>Table</u>	<u>Title</u>	<u>Page</u>
1-1	Contractors	1-8
2-1	Blasting	2-3
4-1	Equipment	4-1
4-2	Well Testing and Development	4-4
4-3	Recharge Well Percolation Test	4-5
4-4	Piezometer Testing and Development	4-5
4-5	Backfill Gradation Analysis	4-8
4-6	Backfill Permeability	4-9

APPENDICES

APPENDIX A

Contract Modifications

0

v

PHOTOGRAPHS

Photograph No.

Title

1	FMC Link-Belt LS-7400-A
2	Backhoe with Extended Dipper Stick
3	Kelley K12 Reverse Circulation Rotary Drill
4	Port-A-Drill Air-Foam Rotary Drill
5	CME-45 Auger Drill
6	Preparing Slurry Trench Working Surface
7	Working Surface
8	Blast Hole Drilling
9	Loading Blast Holes
10	Blasting
11	Colloidal Slurry Mixer and Pump
12	Slurry Trench
13	Slurry Trench
14	Bedrock Sampler
15	Backfill Material
16	Mixing Backfill with Dozer
17	Backfill Slump Test
18	Placement of Backfill
19	Capping Trench
20	Typical Cobbles in Aquifer
21	Typical Cobbles in Aquifer
22	Cobbles with Drill Pipe
23	Recharge Well Screen with Tailpipe
24	Placing Well Screen
25	Installing Riser Pipe
26	Jetting Tool
27	Well Development Setup
28	Well Development Setup
29	2-1/2 h.p. Submersible Pump for Pump Test

PLATES

<u>Plate No.</u>	<u>Title</u>
1	Project Location
2	Geotechnical Legend and Notes
3	Preconstruction Boring Plan
4	Containment System Location Plan
5	Log of Borings - DH82-1 Through 4A
6	Log of Borings - DH82-5 Through 8A
7	Log of Borings - DH82-9 Through DH82-11
8	Log of Borings - DH82-50 Through DH82-56
9	Log of Borings - DH82-57 Through DH82-61
10	Well and Piezometer Details
11	Site Plan
12	Log of Wells - RW-1 Through RW-8
13	Log of Wells - RW-9 Through RW-16
14	Log of Wells - RW-17 Through RW-21
15	Log of Wells - DW-1 Through DW-9
16	Log of Wells - DW-10 Through DW-15 and Slurry Trench Profile
17	Grading Plan
18	Well Service Loop Road Grading Plan
19	Well Service Loop Road Grading Plan
20	Well Service Loop Road Grading Plan
21	Well Service Loop Road Grading Plan
22	Isopach Map (Saturated Thickness)
23	Isochlor Map
24	Ground Water Table
25	Bedrock Configuration

CHAPTER 1. - INTRODUCTION

1.1 LOCATION AND DESCRIPTION. Rocky Mountain Arsenal (RMA) occupies 17,000 acres in Adams County, Colorado, 10 miles northeast of downtown Denver, and directly north of Denver's Stapleton International Airport. The Northwest Boundary Containment/Treatment System Project is located along the northwest boundary of RMA, parallel to Colorado State Highway 2 in Section 22, Township 2 South, Range 67 West. The project consists of a combination slurry trench cutoff wall/hydraulic barrier which includes:

(1) A soil-bentonite ground water barrier, which is a minimum of 30-inches wide, and is keyed 3 feet into impervious bedrock. Barrier length is 1,425 feet and is located 800 feet inside and parallel to the northwest boundary, as shown on Plate 4. Average depth of the barrier is 43 feet.

(2) Fifteen dewatering wells, five of which are 50 feet upgradient of the soil-bentonite barrier. The remaining 10 discharge wells form the hydraulic barrier.

(3) Twenty-one recharge wells, 600 feet down gradient of the cutoff wall and discharge wells.

(4) Seventeen piezometers for monitoring ground water elevation and contamination.

(5) A treatment plant for removal of organic contaminants by carbon adsorption.

1.2 CONSTRUCTION AUTHORITY. The Northwest Boundary Containment/Treatment System Project was authorized by Directive No. 2, Design FY 82-Rocky Mountain

Arsenal, dated 8 January 1982, and Directive No. 1, 14 January 1983, FY 81, PN 36.2 Liquid Waste Disposal, Phase II-WPC.

1.3 PURPOSE OF REPORT. An as-built foundation report is required for all major or unique construction projects as per Regulation No. 1110-1-1801 dated 1 April 1983. These reports insure the preservation for future use of complete records of foundation conditions during construction and of methods used to adapt structures to these conditions. They are also used in planning additional foundation treatment after project completion, if necessary, in evaluating stress, in planning remedial action should structural failure occur due to foundation deficiencies, for guidance in planning foundation explorations and in anticipating foundation problems for comparable future construction projects, and as an information base in determining the validity of claims made by construction contractors in connection with difficulties arising from alleged foundation conditions.

1.4 PROJECT HISTORY. RMA was established in 1942 to produce chemical warfare agents and incendiary munitions. Since 1946, portions of the RMA facilities have been leased to private industry for chemical manufacturing. Production of chemical warfare agents continued at RMA until 1957. In 1971, a demilitarization program was initiated to reduce stocks of obsolete chemical agents and munitions. Chemical production by private industry and the demilitarization program were still in operation during construction of the Northwest Boundary Containment/Treatment System Project.

During the production years (1942 to 1957), the industrial wastes generated at RMA by private lessee and Government operations were disposed of in unlined ponds. Basin "A," located in Section 36, was the most extensively used unlined pond. At the peak of production in 1955, the surface water in Basin "A" reached approximately 300 acres in area. The use of the natural basin with no other provisions for waste containment allowed large quantities of contamination to percolate into the ground water system. Unlined Basins "C," "D," "E," and "F" were also used during this time to contain overflow wastes from Basin "A."

The first indication of ground water contamination outside of RMA came with a formal letter of request for investigation from the Great Western Sugar Company to Brigadier General C. S. Shadle, RMA, dated 4 June 1954. A subsequent letter, from the Great Western Sugar Company to the Chief of Engineering and Service Division, RMA, dated 18 June 1954, related more information concerning ground water contamination. This letter described a correlation between crop damage and irrigation water from wells in farmland adjacent to RMA as early as 1951. Studies of the problem were initiated in November 1954 by the Corps of Engineers, Omaha District, in cooperation with the U.S. Geological Survey (USGS) at the request of the Commander, Rocky Mountain Arsenal. The Corps of Engineers study, "Report on Ground Water Contamination," September 1955, consisted of well-sample analyses for contamination and an electrical resistivity investigation to determine contaminant migration patterns. The USGS open file report by Petri and Smith was dated August 1956. These studies did delineate general patterns of contaminant migration, and they recommended that a program be implemented to monitor the contaminated ground water.

Another study, conducted by the Ralph M. Parsons Company under contract with the Corps of Engineers, Omaha District, resulted in "The Final Report, Disposal of Chemical Wastes, Rocky Mountain Arsenal" in September 1955. This report described studies of toxicity to plants and chemical constituents in irrigation wells near RMA, and provided recommendations for cost-effective actions, including reduction of the volume of contaminated water discharge from plants, asphalt membrane seals in existing storage reservoirs, and the study of bentonite-sealed reservoirs, reduction of wastes into salable by-products as much as possible, neutralization of surplus acids into salts, and solar evaporation of a portion of the waste liquids in the reservoirs to reduce liquid contents. It also recommended against the use of an injection well for disposal of liquid wastes.

Many of the recommendations were followed for reduction of waste volumes, and existing Basin "F" was lined with an impermeable sprayed asphalt membrane covered with 1 foot of clay soil. Apparently, no study of

bentonite-sealed reservoirs was conducted and no other waste reservoirs were lined to prevent continued leaching of contaminants into the ground water aquifer. All process wastes since 1956 have been placed in Basin "F."

The U.S. Public Health Service, acting on claims of crop damage from the use of irrigation water on lands adjacent to RMA in 1958, performed a survey of damages. This study resulted in a report released in November 1959 acknowledging the Government's responsibility for contamination of RMA-area ground water. This report provided impetus for containment and cleanup of contaminated ground water leaving RMA. The Omaha District was directed to perform a preliminary study of the ground water problem at RMA by Office, Chief of Engineers (OCE) Directive No. 1, dated 18 March 1960. Results of this preliminary study were submitted to OCE in report form dated 11 May 1960.

By letter from OCE, dated 11 July 1960, the Omaha District was directed to proceed with completion of the final integrated study of the ground water contamination at RMA, based on information available at that time. This study resulted in the comprehensive report, "Program for Reclamation of Surface Aquifer," dated January 1961. This report accurately described the nature and extent of contamination, the nature of the phytotoxicants, and supplementary methods of waste disposal. It also provided several schemes for correction of the contamination. These schemes included the proper locations for barriers which were used when designing the Northwest Boundary Containment System. Also recommended was a program for monitoring contamination and ground water flows, and a program for further studying the nature of the contaminants and their effect on plants and animals.

By the summer of 1959, Basin "F" was dangerously close to capacity for two reasons: (1) the production of liquid wastes exceeded expectations, and (2) Basin "F," the only lined basin, had only two-thirds the capacity recommended in the Corps of Engineers' sponsored study, due to limited funds available to the Chemical Corps. The Chemical Corps, acting on the advice of

their Industrial Advisory Council, decided upon a deep well for the underground injection of future wastes. Under contract to the Omaha District, U.S. Army Corps of Engineers, E. A. Polumbus, Jr., and Associates, Inc., produced the report, "Final Design Analysis, Pressure Injection Disposal Well, Rocky Mountain Arsenal," in July 1960.

The injection well was drilled in 1961 under the supervision of the Omaha District to a depth of over 12,000 feet, penetrating Precambrian gneiss. This well was unique in that it was by far the deepest injection well to date, and that the reservoir consisted of fractures in crystalline rock as opposed to sedimentary rock commonly used for injecting wastes. Regular pressure injection of wastes from Basin "F" began on 8 March 1962. On 23 November 1965, David M. Evans, a Denver geologist, publicly announced the results of a study conducted by him which alleged to prove that injection of liquid wastes in the deep well at RMA was causing earthquakes in the Denver area. Mr. Evans based his allegation on the statistical correlation between volumes of waste injected into the well and the frequency of earthquake events. This correlation covered the period from March 1962 to October 1965, during which a total of 150 million gallons of waste were injected and a total of 710 earthquakes were recorded.

Interest in a relationship between injection of fluids and earthquakes soon became widespread. Upon the advice of the Corps of Engineers, RMA reduced the rate of waste injection on 20 January 1966, and discontinued injection altogether on 20 February 1966. The investigation of the situation then expanded. The U.S. Geological Survey, University of Colorado, Colorado School of Mines, and the Corps of Engineers, Omaha District, cooperated in the investigation. The correlation between injection rates and earthquake frequency was confirmed, and in February 1969, injection of waste was permanently discontinued. Process wastes were again stored in Basin "F."

In 1974, contaminants that originated from RMA operations were detected in surface waters located to the north of RMA and in wells located near the city of Brighton. The State of Colorado Department of Health, following

Resource Conservation and Recovery Act guidelines, issued three Cease and Desist Orders against Shell Chemical Company (SCC) and RMA in April 1975. These orders stated that SCC and RMA:

- (1) Immediately stop the off-post discharge of contaminants, both surface and subsurface.
- (2) Take action to preclude future off-post discharge of contaminants.
- (3) Provide written notice of compliance with Item (1).
- (4) Submit a proposed plan to meet the requirements of Item (2).
- (5) Develop and institute a surveillance plan to verify compliance with Items (1) and (2).

As a result of these orders, a program was developed and implemented to satisfy the compliance criteria. The Northwest Boundary Containment/Treatment System is one of several projects designed to implement this program.

1.5 DESIGN CONCEPT. Originally, the design concept for the containment system was a total hydraulic barrier. However, the thin saturated thickness and low permeability of the aquifer along the northeast half of the system made a hydraulic barrier along this reach economically and operationally undesirable. The slurry trench cutoff wall was selected to contain the ground water flow in the thin aquifer because it offers several advantages over the hydraulic barrier. Advantages of the slurry trench cutoff wall are:

- (1) Less maintenance time and costs, due to the reduced number of wells and pumps. Less shutdown time for well maintenance.
- (2) Assures positive cutoff in an area with complex hydrology.
- (3) Less complex operation.
- (4) Seasonal variations in ground water level will have less effect on system operation.
- (5) Less operating cost.

1.6 LOCATION OF CONTAINMENT/TREATMENT SYSTEM. Originally, there were several proposed locations for the containment system. As preconstruction investigations progressed, it became apparent that more favorable subsurface

conditions existed closer to the boundary. Moving northwest, away from the bedrock bench situated approximately 1,600 feet inside and roughly parallel to the boundary, the geology and hydrology is more conducive to operation of the containment system. There is greater saturated thickness and less bedrock influence on ground water flow (Plates 22, 24, and 25). Therefore, the final containment system location is as close to the boundary as practical. This location provides several advantages over any other site considered. Some of the advantages are as follows:

- (1) Ground water flow in this area is nearly perpendicular to the boundary and the containment system. This allows the DBCP plume to be intercepted with a shorter system. Review of the ground water and bedrock plans indicates that a system located further inside the boundary would be nearly parallel to the ground water flow and the plume. This would require the system to be an additional 1,000 feet in length to assure the entire plume is intercepted.
- (2) The saturated thickness increases closer to the boundary. As a result, the length of the slurry cutoff wall is less, because there is less thin aquifer to cutoff.
- (3) There is a fairly extensive network of existing monitoring wells in this area. These wells can be used to monitor the system eliminating the need to construct new monitor wells. There is a row of monitor wells along the boundary that can be used to monitor water quality and levels down-gradient of the recharge line. There is also a row of monitor wells that fall approximately midway between the discharge line/slurry wall and the recharge line. These will provide water quality and levels within the system. Several monitor wells are located upgradient of the discharge line/slurry wall to provide ground water data prior to entering the containment system.
- (4) The location contains more contaminated ground water initially. By moving the barrier close to the boundary, there is less contaminated ground water between the system and the boundary to flow off the arsenal after startup.
- (5) The bedrock high in the vicinity of boring DH82-8A provides a place to tie the northeast end of the cutoff wall into.
- (6) Low ground water gradient; reversal can be achieved with minimum drawdown and mounding.

1.7 CONTRACTORS AND CONTRACT SUPERVISION. The contract for Rocky Mountain Arsenal Northwest Boundary Containment/Treatment System began in July 1983.

Initial grading and clearing work began in August 1983, with the soil-bentonite barrier beginning on 4 October 1983 and finishing on 20 November 1983. Well drilling proceeded from September 1983 through May 1984. The entire project was essentially completed by July 1984. Subcontractors involved in the project are included in Table 1.

TABLE 1-1 - CONTRACTORS

<u>CONTRACTOR</u>	<u>WORK PERFORMED</u>
Western States Construction Co., Inc. (Prime Contractor) P.O. Box 598 Loveland, CO 80539	Treatment building, sumps, well vaults, site grading, service roads, yard piping
Geo-Con, Inc. E. Touchy Avenue Des Plaines, IL 60018	Slurry trench excavation 1011 and backfill Suite 245
Bechtold Construction Co., Inc. West 41st Avenue	Discharge and recharge 7709 wells Wheatridge, CO 80033
Fox Consulting Engineers & Geologists Denver, CO	Piezometers 4765 Independence
Bath Excavating & Construction 1333 80522	Blasting for trench P.O. Box excavation Fort Collins, CO
Western Testing Laboratories, Inc. Sheridan Boulevard Lakewood, CO 80214	Concrete, compaction, 775 gradation, and backfill testing
Chen & Associates El Paso	Barrier permeability 3405 N. testing Denver, CO
Westvaco 1107	Treatment system P.O. Box fabrication Castle Rock, CO
Decker Erectors 474 80457	Metal building P.O. Box fabrication Kittredge, CO

TABLE 1-1 - CONTRACTORS (CONTINUED)

<u>CONTRACTOR</u>	<u>WORK PERFORMED</u>
Meyer-Weddle Co. 12580 W. Cedar Drive Denver, CO 80228	Galgon tank interior piping
Consolidated Engineering, Inc. 11185 E. 51st Avenue Denver, CO	Electrical and instrumentation
Union Power Construction Co. 2045 W. Union Avenue Denver, CO	Overhead electrical
Craftsman Decorating, Inc. 2634 12th Avenue Greeley, CO 80631	Painting, coatings, pipe identifications
Re-Bar Placing, Inc. 9520-B East 104th Avenue Henderson, CO 80640	Reinforcing installation
Steelock Fence Co. 5208 Adams Street Denver, CO 80216	Security fence and gates
Gendreau Construction P.O. Box 696 Glenwood Springs, CO	Concrete formwork

1.8 RESIDENT AND DESIGN STAFF. Design of the system was developed by the U.S. Army Engineer District, Corps of Engineers, Omaha, Nebraska, under the direction of District Engineer, COL W. R. Andrews, Jr. Key design personnel in Engineering Division include G. Williams, Military Branch; L. Tate, R. Curnyn, and M. Bayon, Design Branch; and D. Pendrell, J. Topi, and T. McDaniel, Geotechnical Branch. L. Houston, Geotechnical Branch, provided field inspection and geotechnical expertise during the well and ground water barrier construction. Construction Division personnel include M. Mailander, Supervision and Inspection Branch. The Rocky Mountain Area Office, under COL J. I. Coars, Area Engineer, was responsible for project construction. Key Rocky Mountain Area personnel include K. Thonen, Resident Engineer, and R. McRae and J. Minicz, Project Engineers. The treatment plant was designed by Stearns and Roger; and using equipment was designed by Rubel-Hager, Inc. Technical review was provided by the Omaha District.

CHAPTER 2. - FOUNDATION EXPLORATION AND STUDIES

2.1 PRECONSTRUCTION INVESTIGATIONS. A number of pump tests and interference tests were performed prior to 1961 to determine aquifer and ground water characteristics. From the test data obtained, the hydraulic conductivity factor was 1,500 feet per day; the factor for the average storativity was 20 percent. Average porosity was computed as 35 percent. The distance from Reservoir "A" (Plate 1) to the South Platte River showed a 20-foot per mile hydraulic gradient, with the average velocity of movement of 16 feet per day.

A comprehensive study of ground water contamination was completed by the Omaha District Corps of Engineers in January 1961. This report, titled, "Program for Reclamation of Surface Aquifer, Rocky Mountain Arsenal," was the first report to identify major contaminant sources and contaminated ground water plumes, as well as provide containment/collection system schemes and locations for the proposed systems. All following investigations generally confirmed the hydrologic information and preferred containment system locations as submitted in the 1961 report. The information derived from this report is shown on Plates 22 through 25. The disposal methods for contaminated water are not included in this report.

A field exploration program for the Northwest Boundary project was planned and performed by the Omaha District to provide more detailed geologic, hydrologic, and contaminant data. Field work for the project began on 18 March 1982 and was completed in January 1983. A total of 89 holes were drilled. Refer to Plate 3 for boring locations. Sixty-seven of the borings were located in five lines parallel to the northwest boundary in Sections 22 and 27. The lines were located approximately 200, 800, 1,600, 2,400, and 3,400 feet southeast of the boundary. The first four lines inside the boundary were situated along three potential locations for the containment system. The fifth line (3,400 feet southeast of the boundary) was drilled to clarify complex hydrology and to determine contaminant flow paths. The remaining 22 holes included 5 wells and 17 observation wells (piezometers) used for performing and monitoring aquifer pump tests.

Drilling for the project was performed by the Army Corps of Engineers' drill crews, Omaha, Nebraska, with the exception of Wells W-1, W-2, and W-3, which were drilled under contract by Caissons, Inc., Denver, Colorado. The majority of the holes were drilled with a CME-75 equipped with a hollow stem auger. Three-inch or two-inch diameter split spoon samples were taken at intervals ranging from 2-1/2 to 5 feet. The remainder of the exploratory borings were drilled with a cable tool (churn) drill rig. Cable tool-drilled holes utilized a Bucyrus-Erie churn, and were sampled continuously. Wells W-1, W-2, and W-3 were drilled with a rotary rig equipped with a 36-inch-diameter flight auger; Well W-4 was drilled with a Failing 1500, and Well W-5 was drilled with the cable tool. Profiles along the dewater well, slurry trench, and recharge well lines, along with logs of adjacent borings, are shown on Plates 5 through 9. Holes were visually logged by Omaha District geologists and samples were forwarded to the Missouri River Division Laboratory for further analysis.

If ground water was encountered in the borings, 2-inch diameter PVC piezometers were installed for water level measurements and sampling for water quality analyses.

Two 48-hour alluvial aquifer pump tests were run to determine the hydraulic characteristics of the aquifer in the vicinity of the proposed containment system. One (W-4) utilized 20 observation wells, and was conducted by Woodward-Clyde Consultants and Omaha District personnel with some technical assistance from the US Geological Survey, Denver. Six observation wells were monitored during the W-5 pump test, which was performed by Omaha District personnel only. Pump test locations are shown on Plate 3. Aquifer characteristics for the alluvial aquifer were determined by using the time-drawdown data from the observation wells. Analyses using Boulton's method, assuming delayed yield for an unconfined aquifer, gave an average transmissivity value of 210,228 gpd/ft and an average specific yield of .085 for Well W-4. Hydraulic conductivities calculated using the values for transmissivity and saturated thickness (25 feet) averaged 1144 ft/day. For Well W-5 an average transmissivity of 33,213 gpd/ft, specific yield of .25, and hydraulic conductivity of 587 ft/day was calculated.

2.2 INVESTIGATIONS DURING CONSTRUCTION. Investigations during construction included visually logging the well cuttings, inspection of excavated slurry trench materials, additional drilling performed by Geo-Con for blasting purposes, and slurry and backfill testing.

WELL LOGGING. Using a strainer, grab samples of the well cuttings were taken during drilling. A jar sample of aquifer material was also taken from each well. Samples were logged according to ASTM D 2488, "Description of Soil. (Visual-Manual Procedure)." Logs are compiled in Plates 12 through 16.

TRENCH INVESTIGATIONS. Bedrock samples were taken at the minimum excavation depths (as shown on Plate 16) at 20-foot horizontal intervals using the sampler shown in Photo No. 14. The sampler was pinned to a tooth on the backhoe bucket and pushed vertically into the bedrock until refusal. When samples indicated heavy weathering, silt, sand, or fractured zones, excavation was continued until less permeable material was encountered.

A total of 213 blast holes were rotary drilled along the slurry trench line from Stations 16+64 to 18+50 for removal of sandstone lenses. The holes were not logged; however, the upper and lower contacts of the argillaceous sandstone were determined by the driller as shown in Table 2-1.

TABLE 2-1 - BLASTING

<u>Hole No.</u>	<u>Station</u>	<u>Top of Rock (ft)</u>	<u>Bottom of Rock (ft)*</u>	<u>Thickness of Rock (ft)*</u>	<u>Bottom of Hole (ft)</u>	<u>No. of Sticks "Tover"</u>	<u>Pounds of "Tover"</u>
19	16+64	40.5	41	0.5	45.5	1	2.27
20	16+67.8	43	4.5	1.5	44.9	1	2.27
94	16+69.4	43	44.5	1.5	44.4	1	2.27
21	16+71.2	43	45	2	44	1	2.27
93	16+73	43	45	2	47.6	1	2.27
22	16+74.8	42	45	3	46	2	4.50
92	16+76.6	42	45	3	46	2	4.50
23	16+78.4	41	45.5	4.5	46	3	6.80
24	16+82	40.5	46	5.5	47	4	9.08
90	16+83.8	40.5	46	5.5	45	3.5	7.90
25	16+85.6	40.5	46	5.5	48.5	4	9.08
89	16+87.4	40.5	46	5.5	45.2	3.5	7.90
26	16+89.2	40	46.5	6.5	46.1	4.5	10.20
88	16+91	40	46.5	6.5	45.6	4	9.08
27	16+92.8	39	46.5	7.5	48.5	5	11.35
87	16+94.6	39	46.5	7.5	46.2	5	11.35
28	16+96.4	38.5	46.5	8	46.9	6	13.60
86	16+98.2	38.5	46.5	8	48	6	15.60
29	17+00	38	47	9	46.8	6.5	14.75
85	17+01.8	38	47	9	46.9	6	13.60
30	17+03.6	39	46.5	7.5	45.8	5	11.35
84	17+05.4	39	46.5	7.5	45.5	5	11.35
31	17+07.2	40	46.5	6.5	46.8	4.5	10.20
83	17+09	40	46.5	6.5	45.6	4	9.08
32	17+10.8	41	46.5	5.5	46.2	4	9.08
82	17+12.6	41	46.5	5.5	46.5	4	9.08
33	17+14.4	42	46.5	4.5	47	3	6.80
81	17+16.2	42	46.5	4.5	46.2	3	6.80
34	17+18	43.5	47	3.5	46.5	2	4.54
80	17+19.8	43.5	47	3.5	46	2	4.54
35	17+21.6	44	47	3	47	2	4.05
79	17+23.4	44	47	3	47.8	2	4.05
36	17+25.2	44	47	3	46.8	2	4.05
78	17+27	44	47	3	46.5	2	4.05
37	17+28.8	44	46.5	2.5	45.8	2	4.05
77	17+30.6	44	46.5	2.5	45.5	2	4.05
38	17+32.4	44	46	2	45.8	1	2.27
76	17+34.2	44	46	2	46.8	1	2.27
39	17+36	43.5	45.5	2	45.8	1	2.27
75	17+37.8	43.5	45.5	2	50	1	2.27
40	17+39.6	43	45	2	?	1	2.27
44	17+41.4	43	45	2	?	1	2.27
73	17+45	43.5	44	0.5	43.5	1	2.27
42	17+46.8	42.5	43	0.5	42.5	1	2.27
72	17+48.6	43	44.5	1.5	44	1	2.27
71	17+50.4	42.5	43	0.5	42.5	1	2.27

TABLE 2-1 - BLASTING (CONTINUED)

<u>Hole No.</u>	<u>Station</u>	<u>Top of Rock (ft)</u>	<u>Bottom of Rock (ft)*</u>	<u>Thickness of Rock (ft)*</u>	<u>Bottom of Hole (ft)</u>	<u>No. of Sticks "Toxer"</u>	<u>Pounds of "Toxer"</u>
43	17+52.2	42.5	43	0.5	42.5	1	2.27
57	17+99.8	44	48	4	57.1	3	6.80
200	18+02.6	42	47	5	52.4	4	9.08
201	18+03.4	43	48	5	53.5	4	9.08
202	18+06.2	45	48	3	55.2	2	4.54
203	18+07	43	48	5	53.7	4	9.08
204	18+10	42	49	7	54.3	5	11.35
205	18+10.6	44	48	4	50	3	6.80
208	18+17	42	49	7	57.2	5	11.35
209	18+17.8	41	49	8	56	6	13.62
210	18+20.6	42	50	8	50.6	6	13.62
211	18+21.4	41	49	8	57.6	6	13.62
213	18+25	44	49	5	52	4	9.08

*NOTE: Bottom of rock and feet of rock as determined by contractor. For actual rock profile, see Plate No. 16.

CHAPTER 3. - GEOLOGY

The following is a general discussion of the regional and site geology and hydrology. A much more detailed discussion is presented in the Concept Design Analysis for the NW Boundary Containment, FN37, Rocky Mountain Arsenal.


3.1 GENERAL GEOLOGY.

3.1.1 PHYSIOGRAPHY. Rocky Mountain Arsenal is located within the Colorado Piedmont section of the Great Plains physiographic province and is characterized by late mature to old elevated plains and low rolling topography. The site itself is on the eastern edge of a broad valley of the South Platte River, east of the foothills of the Front Range of the Rocky Mountains. Topographic relief across the entire Arsenal is approximately 200 feet, with the land surface generally sloping northwest toward the South Platte River (see Figure 3-1).

3.1.2 DESCRIPTION OF OVERBURDEN. The overburden consists primarily of alluvial clays, sands, silts, gravels, cobbles, and small boulders in various combinations. Above the bedrock, the soils are quaternary alluvial deposits ranging from 0 to 70 feet in thickness, with irregular, braided channel deposits and lenses characteristic of alluvium. Occasional calcareous cemented zones occur in the alluvium and may vary from several inches to several feet in thickness. The alluvium is overlain in places by more recent deposits of windblown silts and sands.

3.1.3 BEDROCK STRATIGRAPHY. The Denver and Arapahoe Formations are the bedrock units immediately underlying the Rocky Mountain Arsenal. They consist of deltaic shales, claystones, sandstones, and conglomerates.

Studies by WES (1980) indicate that the Denver Formation is 250 to 400 feet thick in the vicinity of the northwest boundary and, therefore, this formation is the only bedrock unit of concern for this project. All further references to bedrock in this report refer to the Denver Formation.

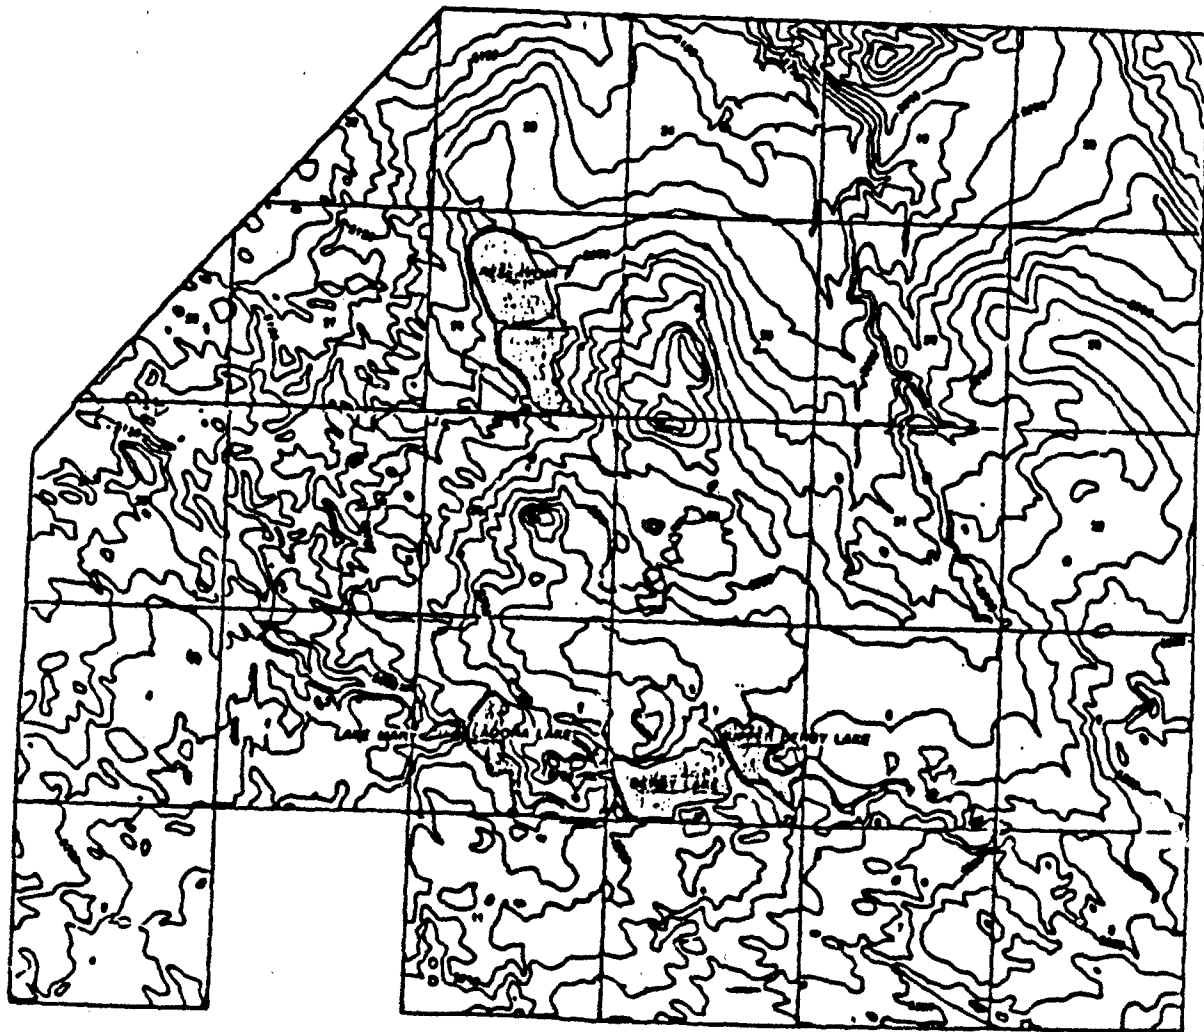

TOPOGRAPHIC MAP
OF
ROCKY MOUNTAIN ARSENAL

SCALE
1:50,000
50 FT CONTOUR INTERVAL

3-11

FIGURE 3-1

The Denver Formation is of probable Paleocene age consisting of sequences of deltaic deposits. The depositional environment resulted in a predominance of fine grained materials rich in organic matter. Lignite seams have been reported nearby and fragments of lignite were encountered in boreholes during this study. Interbedded with the fine grained sediments are sand deposits and silty sands that apparently represent stream channel deposits that were probably deposited in meandering channels and adjacent portions of flood plains.

The sandstones of the Denver Formation constitute important aquifer zones in the Denver Basin and yield water to domestic, municipal, and industrial wells. Individual sandstone beds are lens shaped in cross section, but may extend for long distances along sinuous channels. Interweaving of these channels provides good regional lateral interconnection by occasional overlapping of channel deposits. Thickening with vertical overlapping or stacking provides good vertical interconnection over wide areas although this vertical interconnection may be poor at a given location. As a result, individual sandstone beds by themselves are not important aquifers, but rather groups of beds act as aquifer zones that respond or act much as a single aquifer. This condition is typical of the major ground water basins of much of the Western United States and the Atlantic and Gulf coastal plains where they are composed of deep alluvial fill.

3.1.4 BEDROCK STRUCTURE. RMA is located near the northwestern flank of the Denver Basin, an oval structural basin measuring approximately 120 by 70 miles. This basin is filled with about 15,000 feet of sedimentary rocks. The bedrock at RMA is a thick sequence of Paleocene and Cretaceous deltaic and alluvial deposits with gentle regional dips to the southeast, toward the axis of the Denver basin (see Figure 3-2).

In late Cretaceous and early Tertiary times, major deposition occurred in the Denver Basin. In the Tertiary Period, the Laramide Orogeny began, resulting in uplift of the entire area and the development of the Rocky Mountains to the west of the site. In time, the uplift caused erosion which removed most of the Tertiary sediments and exposed the late Cretaceous sediments. The remnants of this erosional period are pediments formed along

the eastern plains near the foothills. With the retreat of the glaciers in the Quaternary Period, massive erosion of the Cretaceous formations continued, shaping the present bedrock topography in the RMA area.

No significant faulting has been noted at RMA, although some seismic activity in basement rock was associated with the deep well disposal program in the mid-1960's.

3.2 SITE GEOLOGY.

3.2.1 BEDROCK. In the northwest boundary area, the Denver Formation consists of predominantly gray to gray-brown shale or claystone, with irregular, discontinuous sandstone lenses.

The Denver Formation is jointed and fractured in the vicinity of the barrier, as observed in sample cores and described in borehole logs. The clay shales or claystones are relatively massive and do not exhibit shale partings. They are not fissile. Joints and fractures are probably related to stress relief due to unloading by erosion, and perhaps more importantly, due to desiccation resulting in contraction cracks. The upper part of the unit, especially in the weathered zone, is often classified as intensely fractured or crushed. Iron staining was noted on fracture surfaces which indicates the joints and fractures were open enough to transmit water when the rocks were unsaturated and an oxidizing environment existed.

Along the barrier alignment, bedrock is weathered to depths ranging from 2 to 5 feet below the erosional surface of the formation. Weathering is gradational with color changes from shades of brown in the weathered zone to gray colors in the unweathered materials. This weathering indicates the erosional surface of the Denver Formation has been exposed to air and desiccation permitting oxidation and decomposition of mineral constituents. This suggests that the weathered zone was unsaturated during the geologic past, during the Tertiary Period or possibly early Pleistocene.

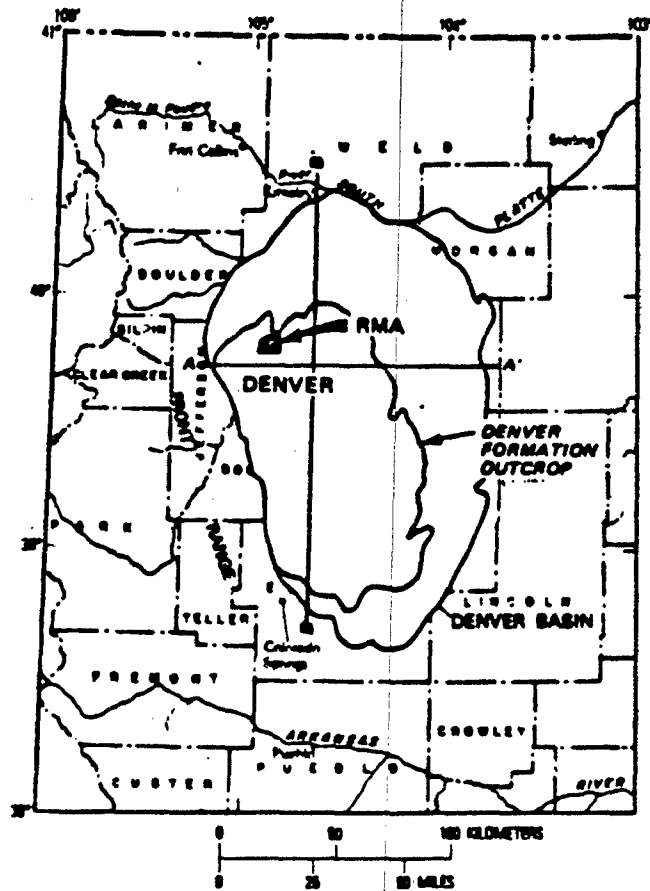


FIGURE 3-2 Rocky Mountain Arsenal in relation to the Denver Basin and outcrop pattern of Denver formation (Robson and Romero 1981)

The degree of weathering, freshness, and fracturing of the bedrock during construction was determined by examination of trench bottom samples and boring samples. Trenching operations frequently extended 3 to 5 feet deeper than the minimum excavation line due to fracturing and weathering of the Denver Formation near the bedrock surface. The Denver Formation sandstones at the northwest boundary frequently contained yellow-brown stained weathered zones near the base of blue-gray unweathered zones. These zones were slightly softer than the blue-gray sandstone and appeared to be slightly more permeable. These areas contained numerous pockets of clay and loose fine grained sands. During excavation, the alluvium-sandstone contacts were distinct over the site, but alluvium-claystone contacts were frequently ambiguous due to the similar characteristics of weathered claystone and the overlying alluvium.

3.2.2 ALLUVIUM. The alluvium was deposited during the Quaternary Period. It was deposited primarily by tributaries of the ancient Platte River drainage System.

Bedrock is directly overlain by unconsolidated and occasionally cemented coarse alluvium. This is the alluvial aquifer material and consists of highly permeable sands and gravels with varying amounts of silt, cobbles, and occasional boulders. The thickness of the alluvial aquifer ranges from over 25 feet to less than 5 feet.

The alluvial aquifer material is overlain by fine-grained overbank alluvial sediments. This material can act as a confining layer to ground water. The fine-grained sediments are predominantly sandy or silty lean clays, or less commonly, highly plastic clays. Zones of clayey sands were occasionally encountered. The thickness of these sediments averages 20 feet.

3.2.2.1 EOLIAN DEPOSITS. A thin mantle of eolian soils overlies the northwest boundary area. These Wisconsin Age deposits were derived from glacial outwash material. They are generally a fine grained, fairly uniform silty sand.

Plates 12 through 16 indicate the types of materials encountered throughout the project area.

3.3 GROUND WATER HYDROLOGY. At the northwest boundary area of RMA, it is reasonable to separate the regional flow system into two subsystems based on geology; alluvium and bedrock flow. The Quaternary Alluvium in this area is predominantly underlain by clay shales, siltstones, and sandstones of the Denver Formation.

Regional studies of the ground water flow system by Geraghty and Miller (Evaluations of the Hydrogeologic and Contamination Migration Patterns, Rocky Mountain Arsenal, Denver, Colorado, January 1981) indicate a general north to northwesterly flow angling toward the South Platte River. The shallow or upper Denver Formation and the alluvial deposits interact in transmitting flows and are both part of the same flow system. Flow in the Denver Formation is both confined and unconfined, and in the alluvium, it is generally unconfined, but may be locally semiconfined. Potentiometric levels in both units generally correspond rather closely. Locally potentiometric levels between may vary greatly due to locally imposed stresses such as heavy pumping from one of the units or by local recharge. Even though flow through both geologic units is part of one system, there are significant differences that were used to advantage in developing pollution containment systems. In general, the alluvial aquifer is much more permeable than sandstones or other materials in the Denver Formation.

The shallow alluvial aquifer is composed of the sand, gravel, clay, and silt as described in Paragraph 3.2.2, and is the most used aquifer in the RMA area. The flow of water through this aquifer generally conforms to the bedrock surface, which slopes from southeast to northwest. Zones of impermeable clays and silts in the aquifer may slightly alter the flow or may form isolated perched water tables. The flow pattern is also locally modified by seepage from ponds, lagoons, and canals. The seepage type of artificial recharge is the primary cause of the extensive contamination at RMA, the main sources being the disposal basins for process wastes.

Only minor fluctuations in ground water level have been recorded over several years, indicating the relative stability of the ground water system.

The ground water in the alluvial aquifer is rather mineralized and of poor quality, with an average total dissolved solids concentration of 1,300 mg/liter. This water is marginally suitable to unsuitable for domestic supplies, but is used where better quality water is not available.

3.4 ENGINEERING CHARACTERISTICS OF OVERBURDEN. The permeability of the alluvial aquifer was determined to be 2.07×10^{-1} to 3.88×10^{-1} cm/sec, based upon pump tests performed by the Corps of Engineers. Select material was chosen over native material for backfilling the trench to decrease permeability of the barrier. Cemented zones in the alluvium caused some difficulty in well drilling, but little in trench excavation. Cobbles and small boulders (to 16 inches) were encountered in discharge and recharge wells throughout the aquifer, which seriously impeded drilling.

3.5 ENGINEERING CHARACTERISTICS OF BEDROCK. The permeability of the upper Denver Formation claystones was found to be 4.7×10^{-6} cm/sec in the vertical direction and 0.19×10^{-6} cm/sec in the horizontal direction, (WES, 1982 "Hydrogeology of Rocky Mountain Arsenal, Colorado") indicating an increase of permeability in the vertical movement of water. This increase was attributed to joints, fractures, and weathering in this direction, and was a major basis for keying the barrier into a significantly less weathered zone several feet into the claystone. Based on a slug test run on Well 5A (See Plate 3 for location), the coefficient of permeability of the sandstone lenses was calculated to be 4 to 5×10^{-5} cm/sec. As this would allow contaminated ground water to flow under the barrier through the sandstone units, the decision was made to remove the sandstone while excavating the trench.

CHAPTER 4. - EXCAVATION PROCEDURES

4.1 GENERAL EXCAVATIONS. Standard excavation methods were used on structure excavations using backhoes and tracked dozers. Scrapers and graders were used to build roads and working surfaces. Equipment used for the project is listed in Table 4-1.

TABLE 4-1 - EQUIPMENT

<u>Model No.</u>	<u>Type</u>
Cat 623B	Scraper
Cat DW10	Scraper
Cat 12	Grader
Cat D8K	Dozer
Komatsu D65E	Dozer
Allis-Chalmers HD16	Dozer
Cat C920	Front End Loader
John Deere JD510	Front End Loader
Dyanhoe 190	Front End Loader
Ford A-62	Front End Loader
Case 1450	Front End Loader
TCI H4M80	Torque Converter
Cat C815B	Sheepsfoot Compactor
Hyster	Sheepsfoot Compactor
Cat C215	Backhoe
Link-Belt LS-7400A	Backhoe
Kelley K12	Reverse Rotary Drill
Port-A-Drill 522	Air-Foam Rotary Drill
CME-45	Auger Drill
Atlas-Copco	O-Dex Rotary Drill

4.2 SCHEDULING. Installation of the treatment system building and recharge wells was concurrent with trench excavation. As RMA would not allow any pumping until the entire system was complete, all phases of construction were independent of one another, excepting the requirement that Discharge Well DW-10 and Piezometers P-4 and P-11 be installed after trench construction. Barrier construction was a priority, as no backfill was to be mixed or placed when the air temperature was below 20 degrees Fahrenheit.

4.3 EXCAVATION GRADES. Excavation was to the lines and grades as shown on the drawings in Plates 16 and 18 through 21, excluding the changes discussed in the following paragraphs.

The minimum excavation line for the slurry trench was used as a guideline. Actual termination depth was determined by the Corps inspector after examining bedrock samples as described in paragraph 2.2.2. Actual termination depths generally ranged from 2 to 4 feet below the minimum excavation, with Station 25+50 requiring 12 feet of excavation below the minimum excavation line.

Of the 36 wells drilled on site, 24 wells had field adjustments from the design depth, which is common for well designs. See Plate 10 for well details.

Recharge Well RW-15 contained only 4 feet of poor quality aquifer and produced 1.5 gpm during test pumping. It was abandoned and RW-15A was drilled 50 feet to the northeast. It was also a nonproducing well and was subsequently abandoned. Well RW-15B was installed 50 feet southwest of the original RW-15. It is a successful well, producing 160 gpm.

Discharge Well DW-11 produces 6 gpm. The calculated design capacity was 25 gpm. The well was not relocated as the aquifer quality deteriorates towards DW-12 as per exploratory borings, and any movement to the south would adversely effect the capacity of Well DW-10. The wells adjacent to DW-11 are capable of pumping over design capacity to compensate for its low production.

4.4 WELL DRILLING. Alluvial discharge and alluvial recharge wells were drilled for the project by the reverse circulation rotary method using a Kelly K-12 drill rig (see Photo No. 3) with 6-inch drill pipe and Moab bit. A 16-inch diameter bit was used for the discharge wells, and a 26-inch bit for the recharge wells. A 2,500 pound drill collar with tri-cone roller rock bit was utilized for drilling through heavily cemented zones and cobbles in the aquifer. Well designs are shown on Plate 10. In general, materials encountered during drilling of the wells corresponded with the preconstruction borings. A major exception was the occurrence of cobbles and small boulders (to 16 inches) throughout the aquifer in nearly every well drilled.

The use of augers and 2- and 3-inch split spoon samplers in the pre-construction borings did not allow for the recovery of these larger diameter materials.

Both the alluvial discharge and recharge wells were drilled by the reverse circulation rotary method using only clean, clear water as a drilling fluid. This particular drilling method and fluid was used to prevent clogging of the aquifer. The reverse circulation rotary method worked well except in zones of cobbles, where the drill pipe, valves, and pump tended to trap the objects. A rock bailer was used to remove loose cobbles and boulders from the drill hole. Drilling rates were significantly slowed during such encounters.

4.4.1 WELL TESTING AND DEVELOPMENT. The discharge and recharge wells were developed as follows: air-water jetting for a minimum of three cycles using the jetting tool shown in Photo 26, 2 hours of pumping, disinfection with sodium hypochlorite to a concentration of 1,000 ppm, followed by a 4-hour pump test after a minimum of 24 hours. In addition, percolation tests were conducted on the recharge wells. Test data is compiled in Tables 4-2 and 4-3.

Piezometers were drilled with a CME-45 equipped with 7-inch hollow stem continuous flight augers.

TABLE 4-2 - WELL TESTING AND DEVELOPMENT

<u>Well No.</u>	<u>Screen Depth</u>	<u>Initial W.L.</u>	<u>Final W.L.</u>	<u>GPM</u>
RW-1	33.0-54.0	28'2"	30'6"	200
RW-2	32.0-53.0	27'5"	31'0"	200
RW-3	30.0-51.0	27'5"	30'6"	200
RW-4	29.0-49.0	30'0"	38'2"	200
RW-5	30.0-50.0	28'0"	30'1"	200
RW-6	30.6-50.6	28'0"	31'1"	200
RW-7	33.0-52.0	25'1"	31'6"	200
RW-8	32.0-50.0	26'0"	29'0"	200
RW-9	29.0-44.0	27'0"	35'4"	200
RW-10	32.0-45.0	27'2"	33'2"	200
RW-11	32.0-43.0	27'0"	35'1"	110
RW-12	35.0-43.0	28'0"	34'8"	180
RW-13	34.0-44.0	27'0"	35'0"	75
RW-14	32.5-44.5	28'7"	33'0"	145
RW-15B	42.5-48.0	33'5"	40'0"	160
RW-16	37.0-45.0	35'1"	40'0"	55
RW-17	35.0-45.0	36'0"	39'0"	100
RW-18	38.0-46.0	36'6"	40'5"	75
RW-19	35.0-44.0	38'0"	42'2"	75
RW-20	40.0-49.0	37'0"	38'7"	100
RW-21	43.0-49.0	39'6"	42'0"	60
DW-1	38.0-56.0	30'0"	37'4"	150
DW-2	32.0-55.0	31'0"	36'3"	150
DW-3	39.0-57.0	31'25"	48'1"	200
DW-4	42.3-59.0	33'0"	45'1"	200
DW-5	40.0-56.0	29'5"	38'1"	200
DW-6	37.4-54.0	31'0"	34'9"	200
DW-7	37.0-54.0	30'0"	34'3"	200
DW-8	36.0-54.0	50'0"	33'7"	200
DW-9	37.0-52.0	33'3"	36'8"	150
DW-10	42.0-50.0	34'0"	41'4"	100
DW-11	44.0-49.0	37'0"	46'0"	6
DW-12	41.0-46.0	42'0"	44'1"	40
DW-13	32.0-40.0	34'0"	36'1"	35
DW-14	41.0-48.0	38'0"	40'5"	25
DW-15	42.0-49.0	38'4"	41'7"	30

TABLE 4-3 - RECHARGE WELL PERCOLATION TEST

<u>Well No.</u>	<u>Static Water Level</u>	<u>Gallons Added</u>	<u>Recovery Time</u>
RW-1	28'2"	4,000	45 sec.
RW-2	28'5"	3,000	30 sec.
RW-3	30'5"	2,250	2 min.
RW-4	38'2"	2,300	1 min.
RW-5	28'0"	2,300	45 sec.
RW-6	28'0"	2,300	45 sec.
RW-7	25'1"	2,300	45 sec.
RW-8	26'0"	2,300	2 min.
RW-9	27'0"	2,300	2 min.
RW-10	27'2"	2,300	3 min.
RW-11	27'0"	2,300	4 min.
RW-12	28'0"	2,300	2 min.
RW-13	27'0"	2,300	5 min.
RW-14	28'7"	2,300	4 min.
RW-15B	33'5"	2,300	4 min.
RW-16	35'1"	2,300	4 min.
RW-17	37'0"	2,300	3 min.
RW-18	36'6"	2,300	5 min.
RW-19	38'0"	2,300	3 min.
RW-20	37'0"	2,300	1 min.
RW-21	39'6"	2,300	5 min.

4.4.2 PIEZOMETER TESTING AND DEVELOPMENT. Piezometers were disinfected with sodium hypochlorite to achieve a 400 ppm concentration and were left undisturbed for a minimum of 24 hours. Two well volumes of water were then removed by bailing. Recovery rates are recorded in Table 4-4.

TABLE 4-4 - PIEZOMETER TESTING AND DEVELOPMENT

<u>Piezometer No.</u>	<u>Screen Depth</u>	<u>Bailing & Recovery</u>	
		<u>Static W.L.</u>	<u>Recovery Time</u>
P-1	35.5-55.5	33'7"	6 min.
P-2	39.0-58.0	36'0"	3 min. 30 sec.
P-3	35.5-54.5	34'0"	5 min. 25 sec.
P-4	41.0-49.0	36'6"	7 min.
P-5	41.0-49.0	37'0"	11 min. 5 sec.
P-6	37.0-45.0	38'7"	7 min. 10 sec.
P-7	37.0-45.0	38'4"	5 min.
P-8	41.0-50.0	41'6"	12 min. 45 sec.
P-9	41.0-50.0	41'6"	15 min.
P-10	30.0-35.0	31'2"	8 min. 20 sec.
P-11	30.0-35.0	31'0"	4 min. 50 sec.
P-12	33.0-54.0	33'0"	9 min. 30 sec.
P-13	35.0-51.0	31'1"	2 min.
P-14	34.0-46.0	34'0"	7 min. 10 sec.
P-15	32.0-42.0	35'0"	9 min. 15 sec.
P-16	42.0-51.0	44'0"	8 min. 35 sec.
22-13	34.0-44.0	37'8"	9 min.

4.5 BARRIER CONSTRUCTION. The working surface for the barrier was made by standard cut and fill methods, using scrapers, graders, and dozers. Minimal fill was required.

Dry sodium bentonite was supplied in 50 pound bags and mixed with potable water (supplied by a temporary 4-inch water line) in a 5 cubic yard collidal mixer with a diesel-powered pump. Slurry storage ponds were not used as the mixer was capable of producing 1,000-gallon batches in 10 to 15 minutes. Slurry was pumped from the mixer to the trench by the use of a centrifugal pump and a 6-inch temporary piping system.

4.5.1 TRENCH EXCAVATION. The slurry trench was excavated with an FMC Link Belt LS-7400A backhoe with an extended boom to allow excavation to 55 feet (Photos 1 and 2). The bucket used was nonperforated, with the exception of two holes that allowed the release of the vacuum formed by the wet overburden. Initial excavation began 50 feet northeast of the plan starting station and was sloped down to full depth at the starting point. This enabled placement of backfill by sliding it down the slope and eliminated the need for a clamshell or tremie for initial backfill placement. Slurry was pumped into the trench and generally maintained within 2 feet of the working surface by adding slurry as the excavation progressed.

4.5.1.1 SLURRY TESTING. The slurry used in the excavation and backfill of the barrier was a mixture of ultrafine natural sodium cation-based montomrillonite clay and potable water. Slurry properties were tested following the American Petroleum Institute (API) Code RP13B. Initially, the slurry was tested four times daily. Testing showed that the slurry properties changed very little in the course of a day; subsequently testing was reduced to twice daily. The slurry in the trench was sampled at intervals of every 10 feet of depth and at 50-foot horizontal intervals. Tests required were: density (not less than 64 pounds per cubic foot), filtration (not greater than 20 cc at 100 psi in 30 minutes), viscosity (not less than 40 seconds at 65 degrees F.), and sand content. Prior to mixing the slurry with backfill material,

density was to be not less than 70 pounds per cubic foot nor greater than 85 pounds per cubic foot. Slurry from the trench had an average viscosity of 44 seconds, density of 77 pounds per cubic foot, filtrate of 20 cc, and sand content of 10 percent. Slurry was used directly from the mixer for blending with backfill.

4.5.2 TRENCH BACKFILL. A dike was formed along the trench to prevent unblended material from flowing in. The select backfill material was mixed with fresh slurry by tracking and blading with dozers, and was then tested as described in Chapter 2. The blended backfill was then pushed from the working surface into the trench, allowing it to slide down the initially inclined surface, and later down the surface of the previously placed backfill. The toe of the backfill lagged behind the trench excavation by a maximum of 100 feet. Backfill was sounded twice daily to determine sliding and settlement. The backfill was capped by a minimum of 1-1/2 feet of relatively impervious material within 3 days after the backfill reached the top of the slurry trench. Bulldozers placed the material and it was compacted in 12-inch thick layers with a sheepsfoot compactor to a dry density of 95 percent of maximum density at optimum moisture (within 2 percent).

4.5.2.1 BACKFILL TESTING. Backfill consisted of a mixture of slurry and select soil. Gradation tests were taken for every 300 cubic yards of fill placed in the trench. Procedures for the gradation analyses were according to ASTM C 136-81, and were to conform with the following requirements:

<u>Screen Size or Number (U.S. Standard)</u>	<u>Percent Passing By Dry Weight</u>
3-inch	100
1-1/2-inch	95-100
3/4-inch	80-100
No. 4	50-100
No. 30	25-70
No. 200	12-35

Test results are shown in Table 4-5.

Slump tests were performed twice daily on the backfill mixture just prior to placement in the trench. Testing was according to ASTM C 143-78, with an allowable slump range from 2 to 5 inches.

TABLE 4-5. BACKFILL GRADATION ANALYSIS

Sieve	Spec.	10/2	10/6	10/11	10/12	10/17	10/25	10/27	10/29	11/09
3"	100Z	100	100	100	100	100	100	100	100	100
1-1/2"	95-100Z	100	100	100	100	100	100	100	100	100
3/4" 80-100Z	80-100Z	100	100	100	100	100	100	100	100	100
No. 4	50-100Z	98	98.4	98.5	98	98.2	97.5	97.6	97.6	96.2
No. 30	25-70Z	76.2	70.6	80.4	78.6	72.9	76.7	71	70.1	56.3
No. 200	12-35Z	13.4	21.7	30.7	28.6	18	22.7	16	16.4	32.3

Backfill permeability determinations were made on undisturbed samples obtained from the completed trench in accordance with ASTM D 1587. A 7-inch diameter hollow stem auger was used to advance the hole to sampling depth. Three-inch diameter Shelby tube samples were obtained from 10.0 to 12.5 feet below the surface. One sample was recovered and tested for each 300 linear feet of backfilled slurry trench. Samples were tested for permeability in accordance with EM 1110-2-1906, Appendix VII, Back-Pressure Method. Test results are compiled in Table 4-6.

TABLE 4-6 - BACKFILL PERMEABILITY

<u>Sample No.</u>	<u>Station No.</u>	<u>Coefficient of Permeability (CM/Sec)</u>
1	22+50	2.9x10 ⁻⁸
2	13+50	3.1x10 ⁻⁸
3	19+50	6.6x10 ⁻⁸
4	16+50	1.8x10 ⁻⁸

4.6 BLASTING. Bath Excavating and Construction was hired by Geo-Con to remove two lenses of argillaceous sandstone from Stations 18+50 to 17+99 and 17+50 to 16+64. HD detaprime caps and primacord were used to detonate 1-3/4 inch by 16-inch DuPont "Tovex" water gel with a 25 millisecond delay between holes. The two blasts used patterns of 2-inch thinwall PVC cased holes in two rows on 3.6-foot centers with 3 feet between the rows. Blasting information is listed in Table 2-1.

4.7 SAFETY PRECAUTIONS. Standard safety procedures were followed as per the Corps of Engineers' Safety and Health Requirements Manual, EM 385-1-1. When blasting was performed, RMA Security was notified of each imminent blast. No explosives were stored on site.

CHAPTER 5. - CHARACTER OF FOUNDATION

5.1 GENERAL. Conditions encountered during construction have been described in Chapter 3. The specific locations of each condition as determined from trenching and well drilling operations are discussed below.

5.2 CEMENTED ZONES. Occasional calcium carbonate cemented zones of sand and gravel were encountered in several of the discharge and recharge wells at the northeast end of the line (Plates 13 through 16). The random zones were moderately hard to hard, and ranged from 6 inches to 6 feet in thickness. There was minimal impact on trenching, but some difficulty in drilling when such zones were encountered.

5.3 COBBLES AND BOULDERS. Cobbles and small boulders were encountered throughout the aquifer. The effect of this material on slurry trench excavation was negligible. They did, however, cause serious delay in drilling operations. The cobbles and boulders lodged in the bit intake, return valve in the Kelley, and in the pump (Photo No. 22). The contractor filed a claim and was compensated as the Government considered the number and location of the cobbles a type one differing site condition (see Appendix A).

5.4 DENVER FORMATION SANDSTONES. Two lenses of very hard blue-gray sandstone were encountered along the slurry trench between Station 18+25 and Station 16+64, as shown on Plate 16. The total sandstone thickness ranged from 1 to 13 feet, at depths of 38 to 51 feet. Blasting was required to fracture the rock prior to removal. Excavation continued below the bottom of the sandstone to assure a tie-in with the clay shale bedrock.

5.5 CLAY SHALE. The uppermost layers of clay shale bedrock are highly fractured and moderately to very weathered to depths of up to 5 feet into the rock. Below this, the rock is essentially unweathered.

CHAPTER 6. - POSSIBLE FUTURE PROBLEMS

6.1 POTENTIAL PROBLEM CONDITIONS. Aside from mechanical failure, which is beyond the scope of this report, potential conditions which could produce problems with the effectiveness of the containment/treatment system are discussed below.

Zones of high permeability occurring as windows in the slurry trench backfill could allow seepage of contaminated ground water through the barrier. Windowing could occur by sloughing of portions of the trench sides during excavation, sand layers settled out of the slurry, or pockets of unblended backfill. Any of these could allow a higher permeability zone through the trench, and would be difficult to locate upon completion of construction.

Isolated seepage through permeable sand lenses, fractures, or lignite seams in the Denver Formation below the depth of the barrier could allow leakage beneath the barrier.

Any cemented sands or fractured rock remaining at the base of the trench could also allow leakage beneath the barrier.

Unexpected high ground water levels could overtax the dewater/recharge system. This is unlikely under the range of expected situations for which the system was designed. The possibility for such an occurrence does exist under a combination of conditions such as a high ground water level and heavy precipitation combined with a prolonged shutdown of the system, where ground water could build up along the barrier until the system was again operational.

6.2 RECOMMENDED OBSERVATIONS. The system as designed will require periodic maintenance. Constant observation is recommended as follows:

(1) Regular readings of piezometers and wells down gradient of the barrier should indicate the total effectiveness of the system, and would provide indications of problem areas of the barrier.

(2) Monitoring of wells and piezometers on the up gradient side of the system is also essential. Readings here could provide information on pre-treatment contaminant levels and possibly on migrating ground water patterns as well. Additional monitoring wells could be installed as required to detect any change in shape or depth of the contamination plumes.


(3) Regular inspection of the surface of the slurry wall is recommended. Slumps or depressions along the surface of the barrier may be an indication of a "window" condition caused by improper backfill. Saturated surface conditions might indicate ineffective dewater/recharge system function.

APPENDIX A
Contract Modifications


CONTRACT MODIFICATIONS

<u>Mod.</u>	<u>Description</u>	<u>Cost</u>
P00001	Delete booster pump. Provide flow controls on emergency showers. Provide pressure reducing valve.	\$5,519
P00002	Add bends at valve pit.	\$2,703
P00003	Claim--Cobbles in wells.	\$97,175
P00004	Relocate two power poles.	\$1,382
P00005	Not executed.	-----
P00006	Not executed.	-----
P00007	Extend contract 5 days.	No cost
		<hr/>
	Total Mod Costs	\$ 106,799
	Contract Bid	2,641,580
		<hr/>
	Total Cost	\$2,748,359


PHOTOGRAPHS

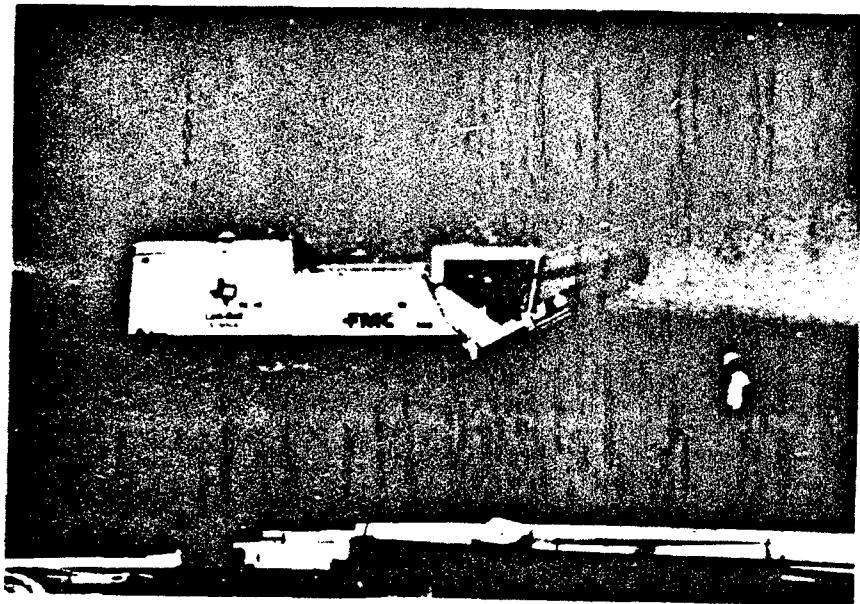


Photograph 1. FMC Link-Belt LS-7400 A, used for slurry trench excavation.

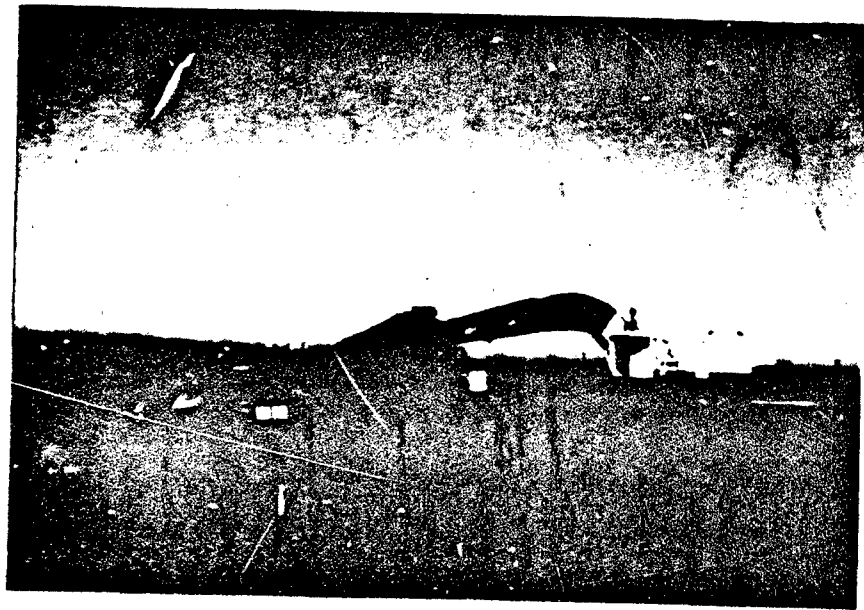


Photograph 2. LS-7400 A with 55 foot dipper stick and boom.

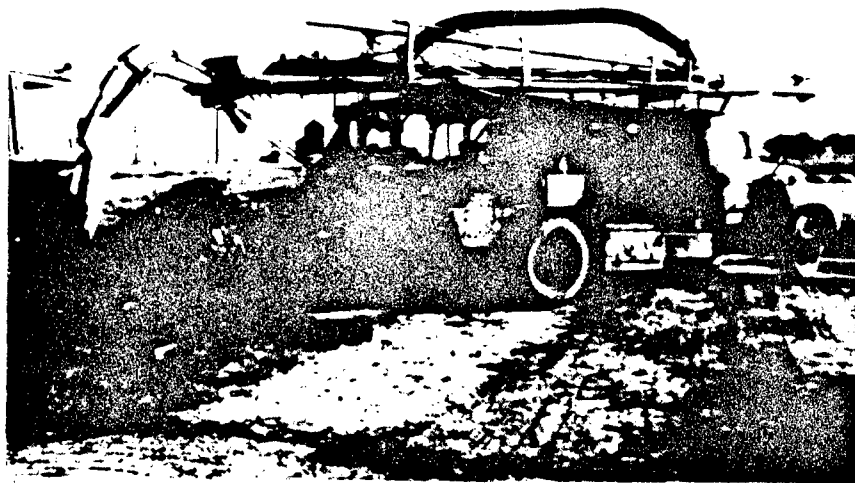

Photograph 3. Kelley K12 Reverse Circulation Rotary Drill used for well drilling.

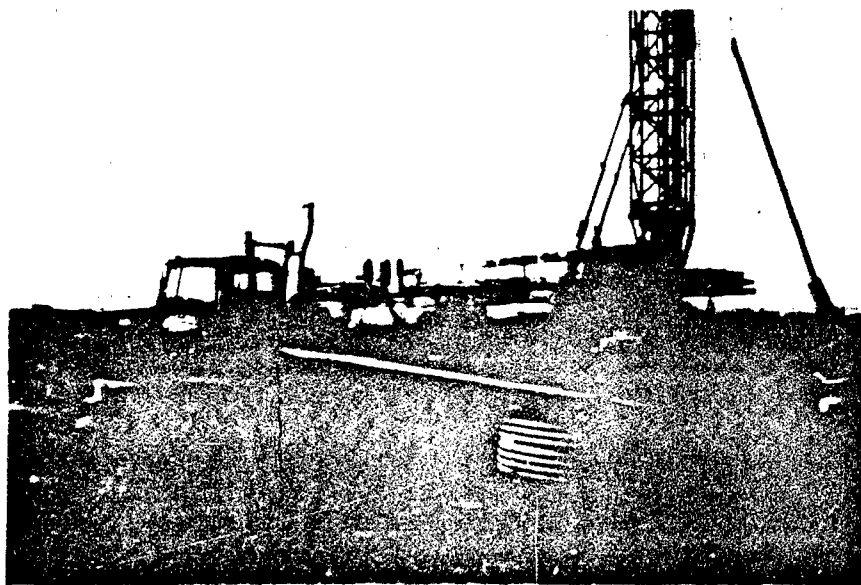


Photograph 4. Port-A-Drill Air-Foam Rotary Drill used for well development.

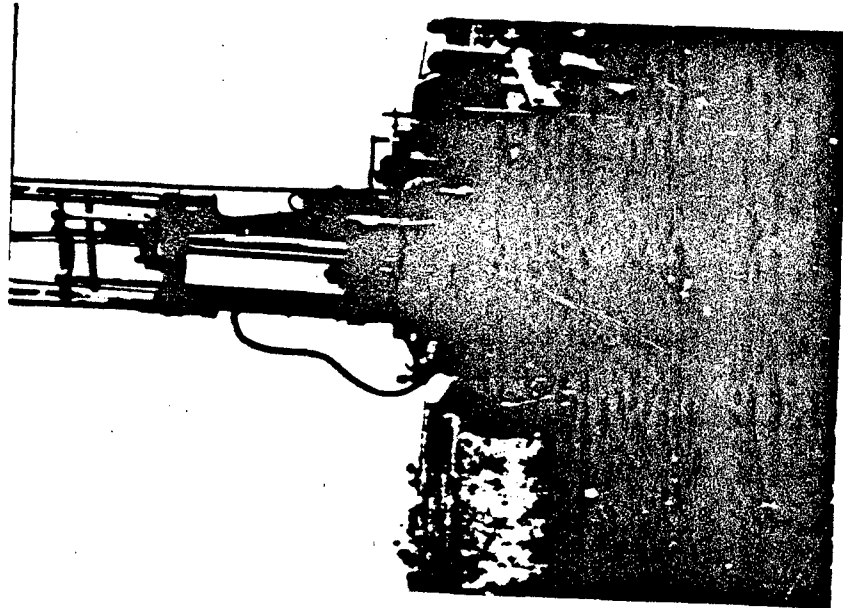


Photograph 5.

CME-45 Auger Drill used for piezo-meter installation.

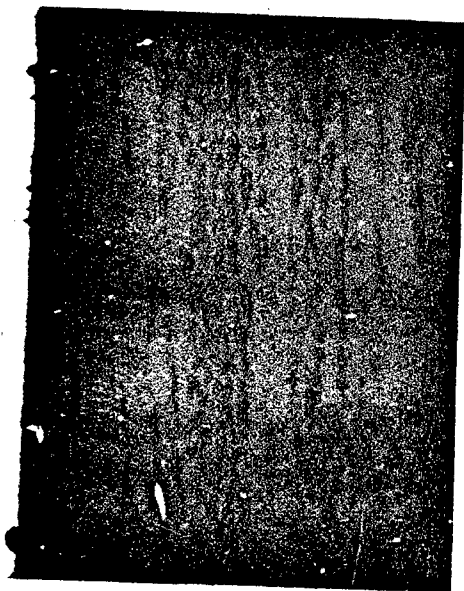


Photograph 6.


Preparing slurry trench working surface, looking southwest from Station 22+50.

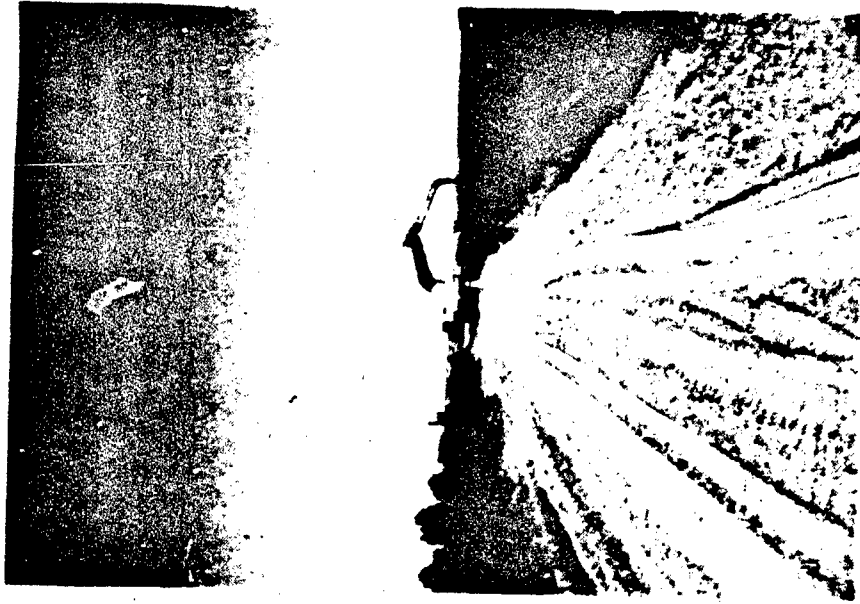


Photograph 7.
Slurry trench working surface,
looking northeast from Station
22+50.

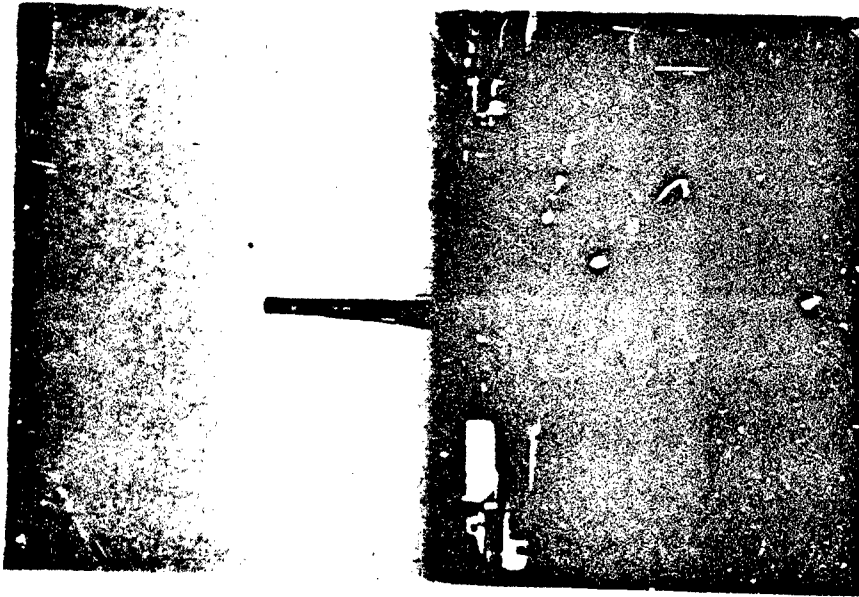

Photograph 8.
Blast hole drilling at Stations
18+50 to 17+99 and 17+50 to
16+64, looking southwest.

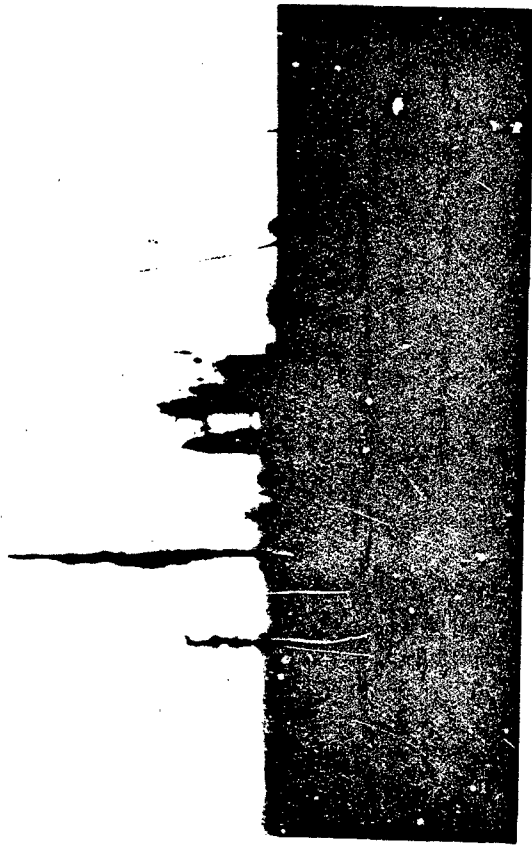

Photograph 10. Blasting sandstone lenses along slurry trench.

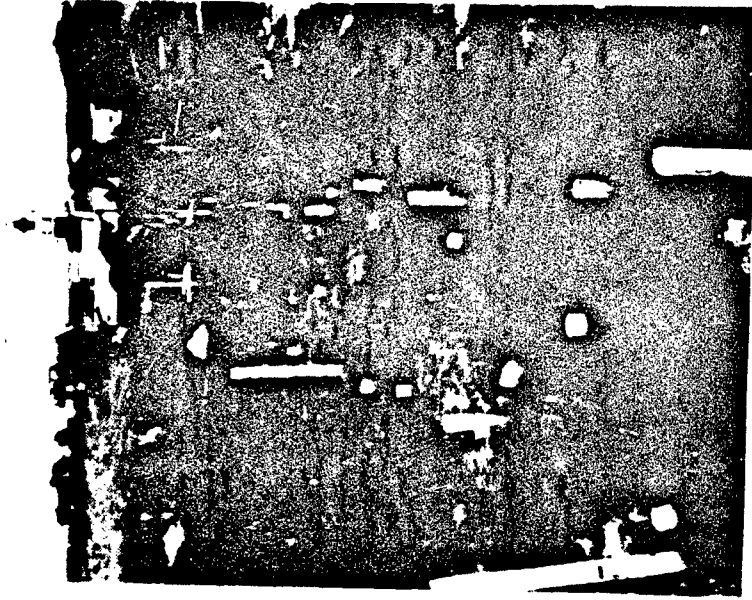


Photograph 9. Loading blast holes.



Photograph 12.

Slurry trench excavation, looking southwest from Station 14+00.

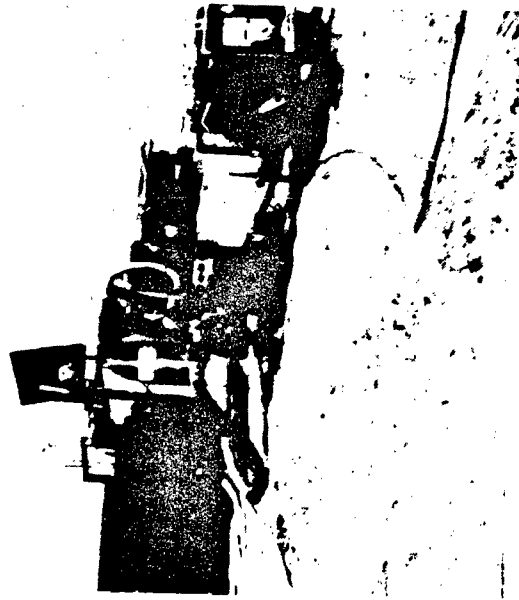


Photograph 11.

Colloidal Slurry mixer and pump for mixing bentonite.




Photograph 14.

Bedrock Sampler

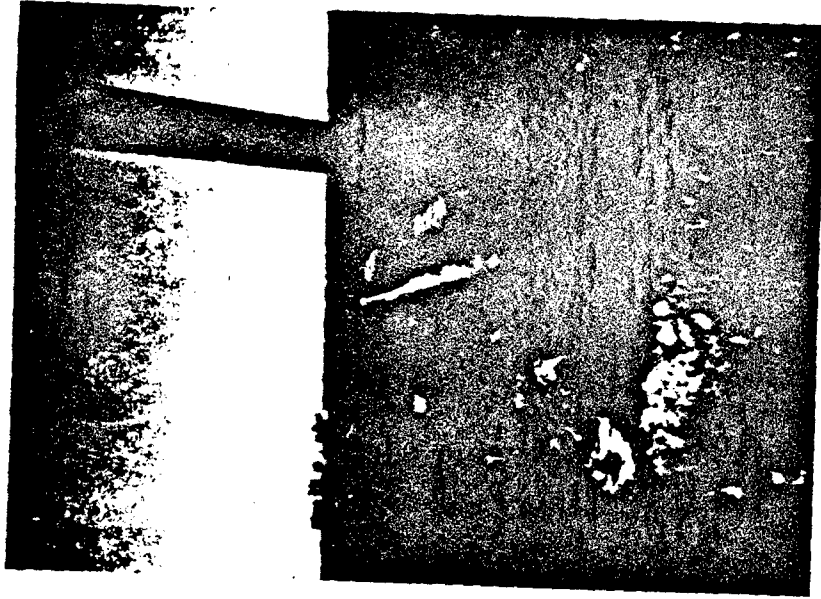

Photograph 13.

Slurry trench excavation, looking northeast from Station 12+00.

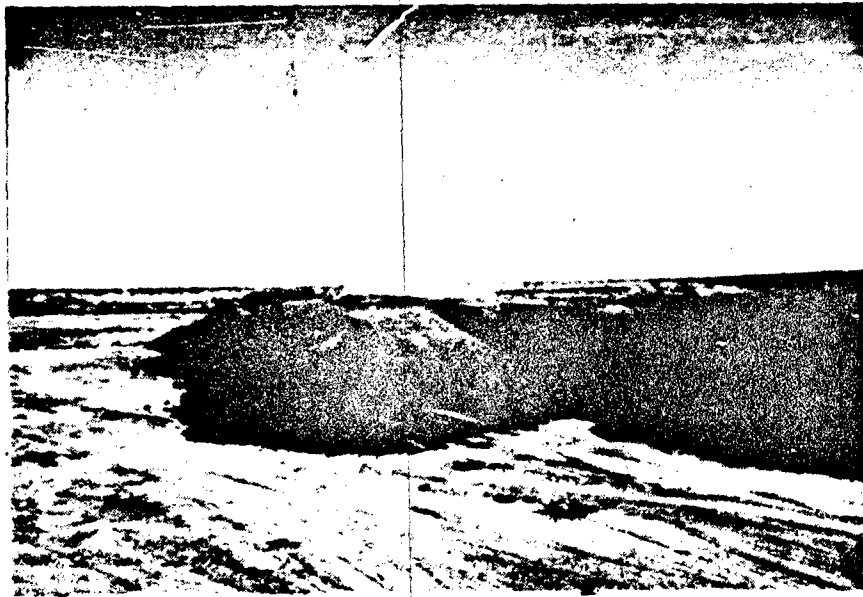

Photograph 15. Backfill material for slurry trench.




Photograph 16. Mixing backfill and slurry.




Photograph 18.

Placement of backfill in trench
with dozer, Station 25+50.

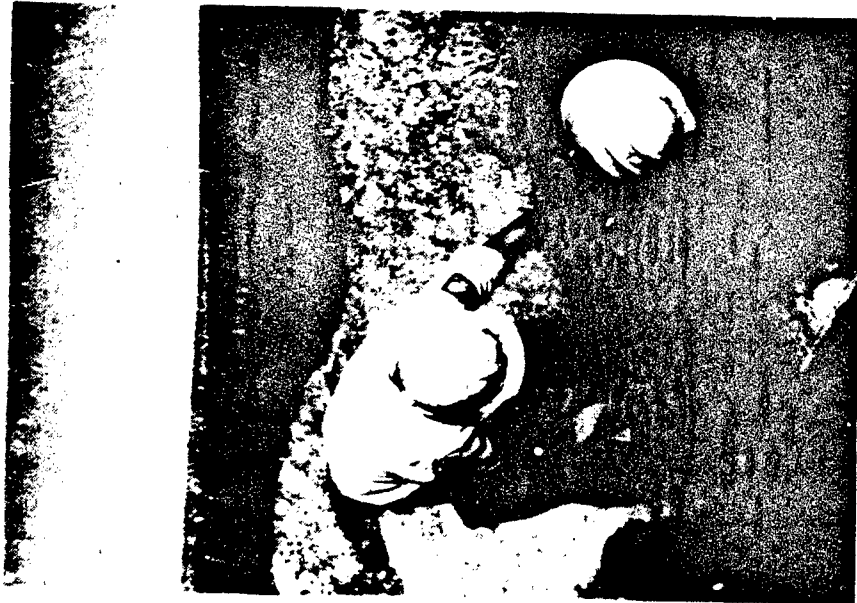


Photograph 17.

Slump testing backfill for trench.

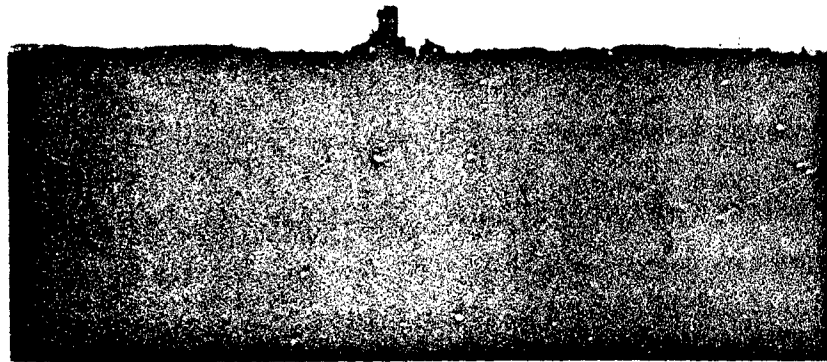

Photograph 19: Capping trench, looking southwest from Station 25+00.

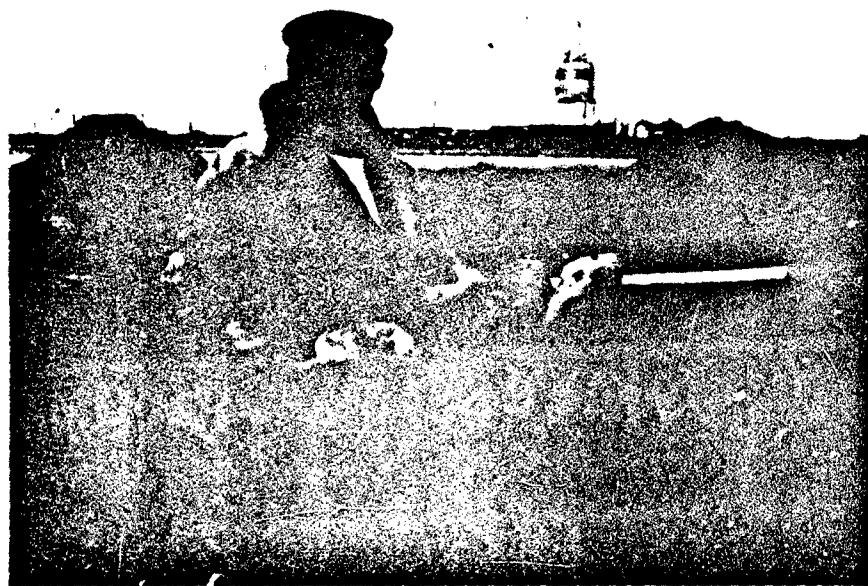

Photograph 20. Cobbles from DW-2.




Photograph 21. Cobbles removed from DW-2.



Photograph 22.


Cobbles from top of aquifer
of DW-3 will not go through
drill rod.

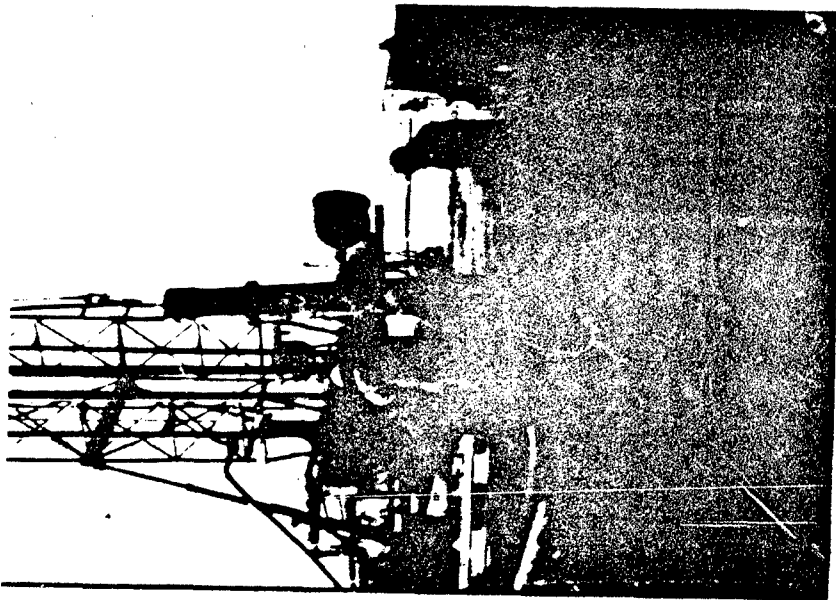


Photograph 24. Placing well screen.




Photograph 23. Recharge well screen with tail-pipe.

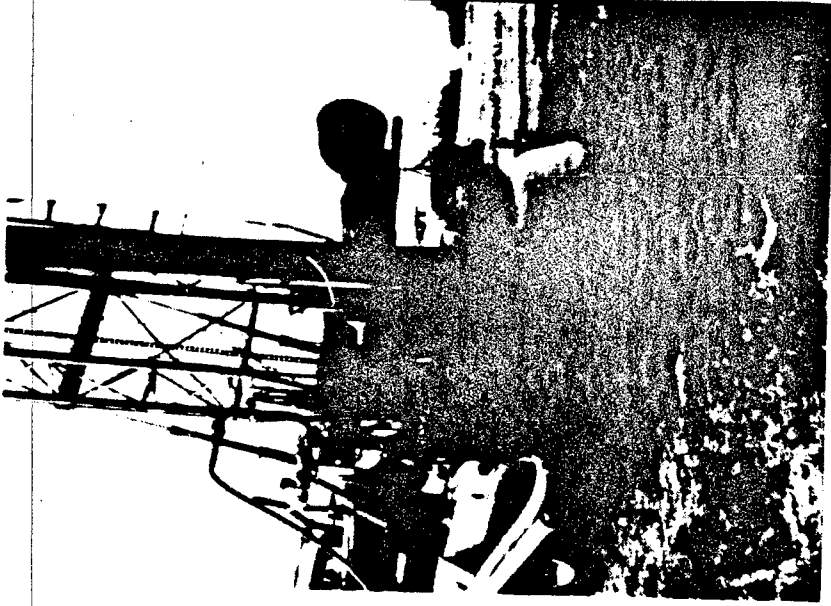


Photograph 25. Installing riser.

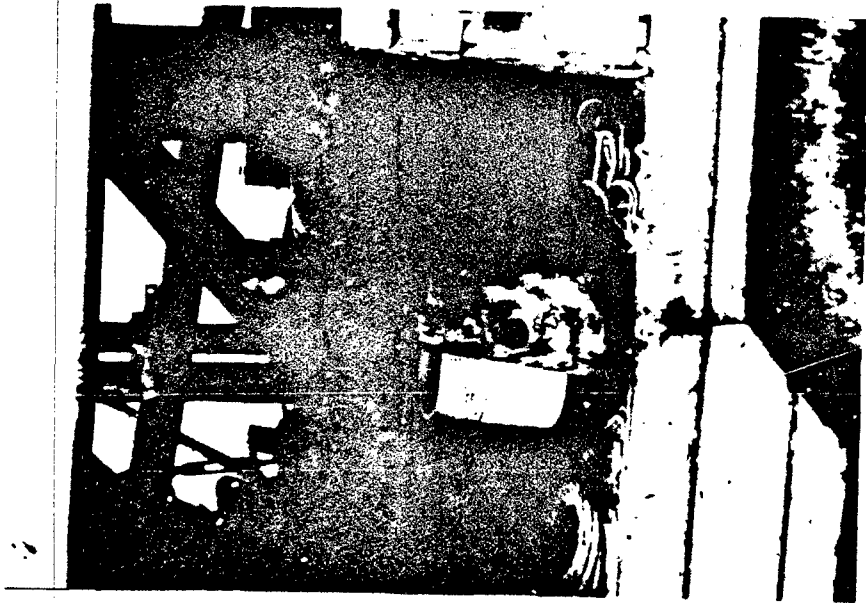


Photograph 26. Jetting tool for well development.

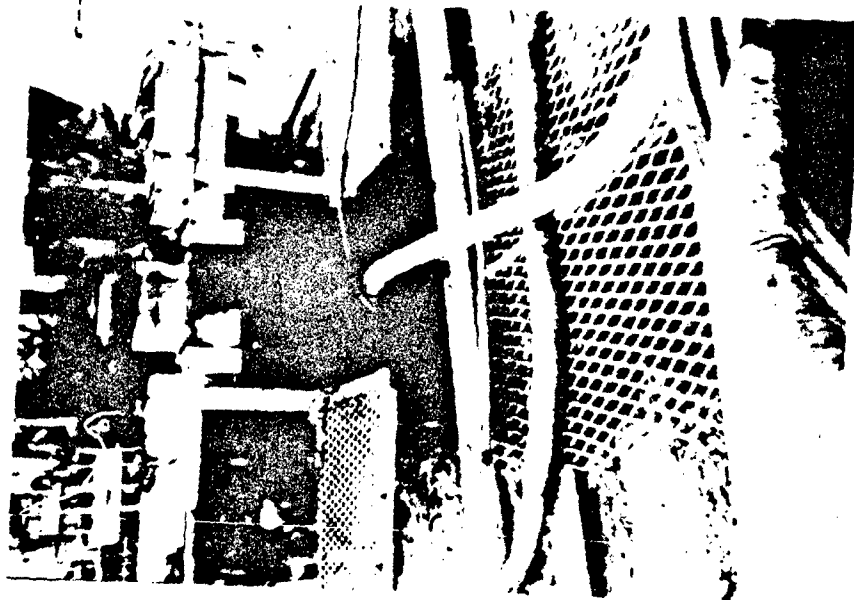

Photograph 28. Well development setup.

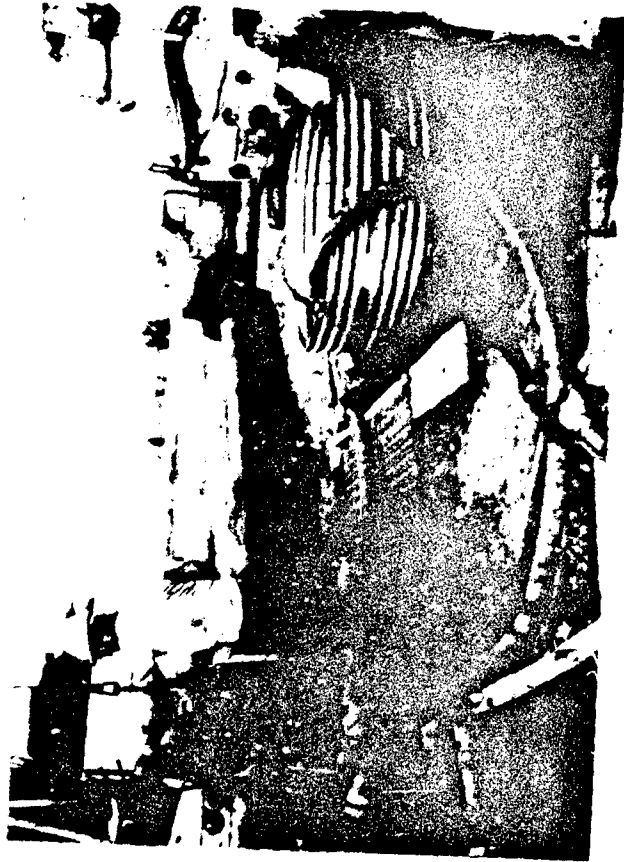



Photograph 27. Well development setup.


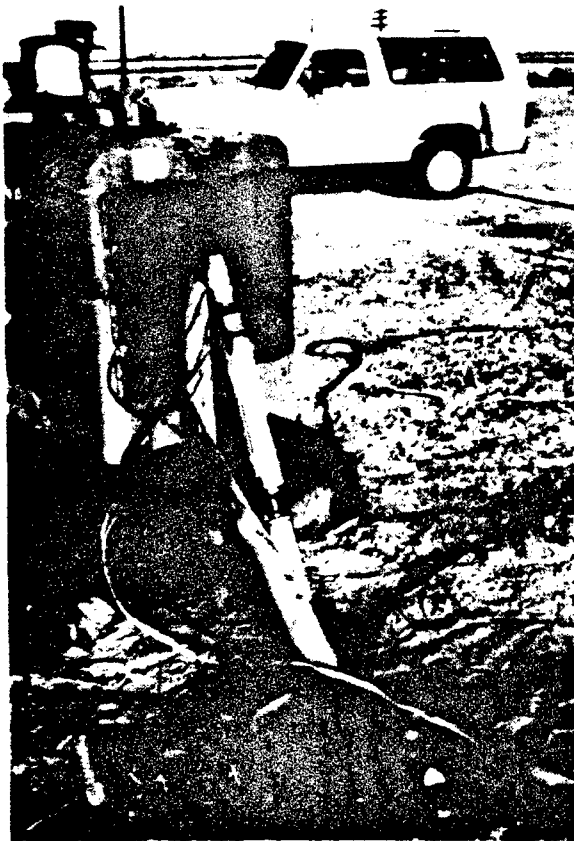


Photograph 29. 2½ h.p. submersible pump for pump test.

PLATES

CORPS OF ENGINEERS

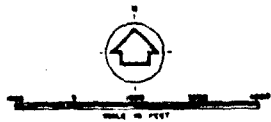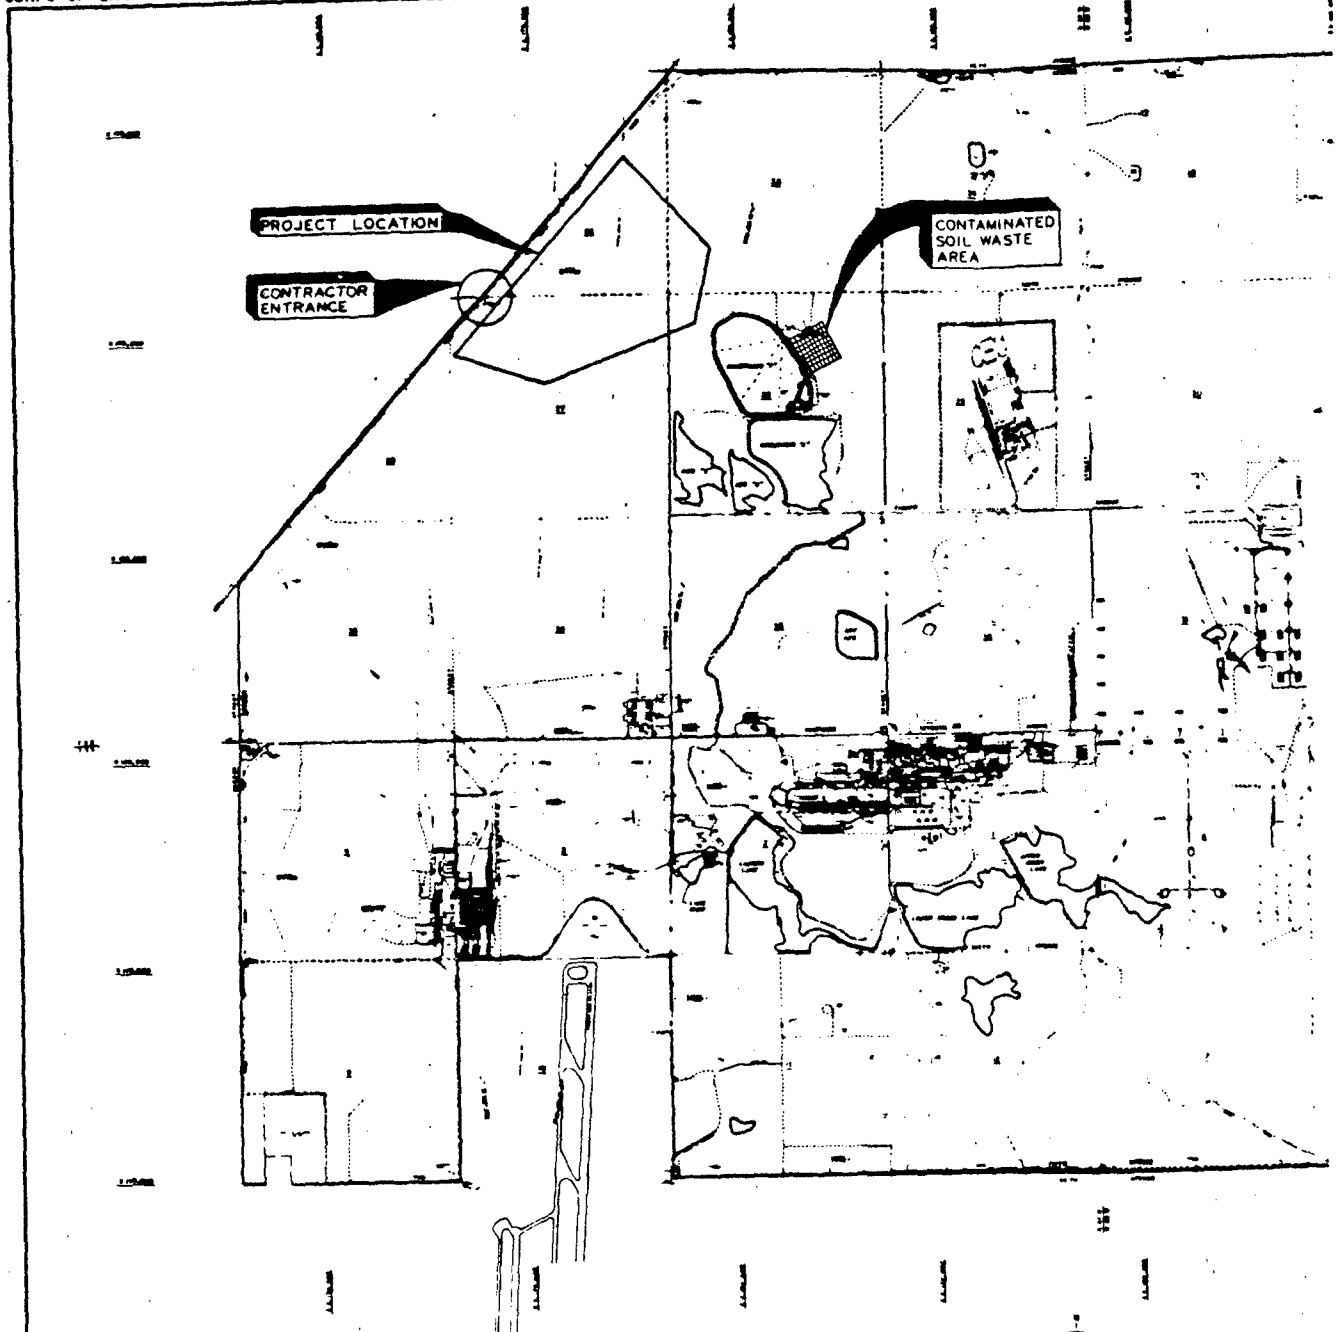

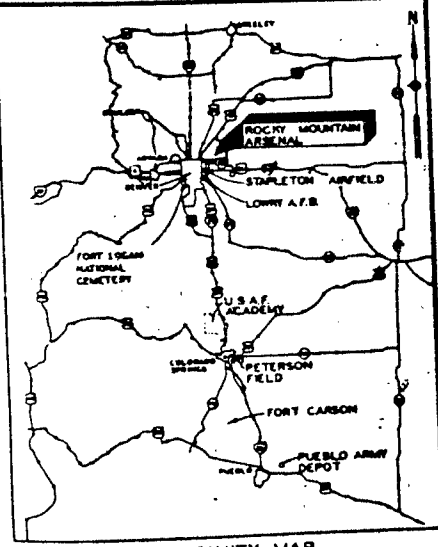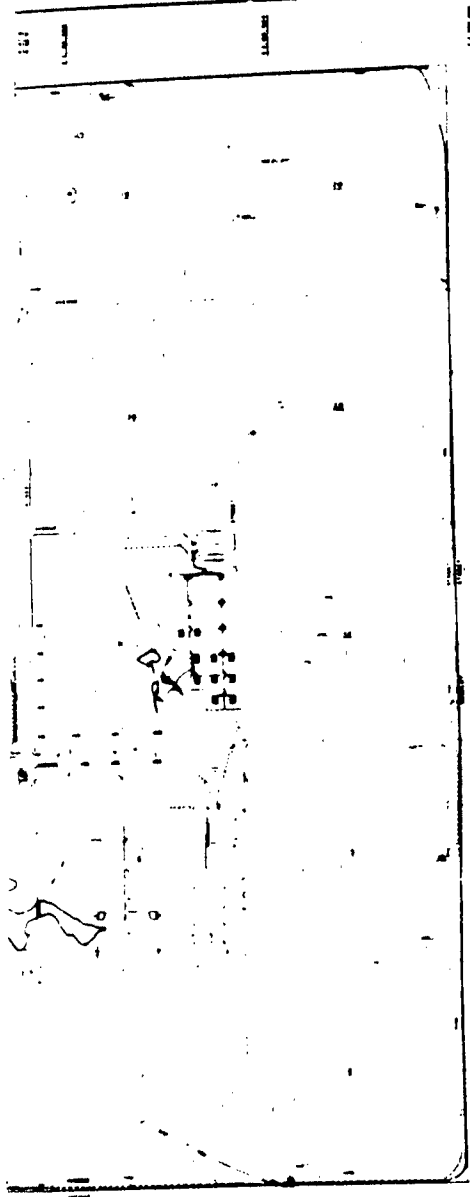

VICINITY MAP
NO SCALE.

40.1
The location of Contaminated Soil Waste Area shall be coordinated with the Contracting Officer.

THIS DRAWING HAS BEEN REDUCED TO THE SIZE SHOWN BY THIS SCALE.

DATE	DESCRIPTION	ISSUED BY	APPROVED BY
U. S. ARMY ENGINEER DISTRICT, OMAHA CORPS OF ENGINEERS OMAHA, NEBRASKA			
ROCKY MOUNTAIN ARSENAL COMMERCIAL CITY, COLORADO		COMMERCIAL CITY, COLORADO	
NORTHWEST BOUNDARY CONTAINMENT LOCATION PLAN			
DESIGNED BY	DATE	FY 84/CA PLS 2	
DRAWN BY			
CHECKED BY			
SCALE AS SHOWN			
F 841-40-01			

2

SOIL CLASSIFICATIONS		
SYMBOL	LETTER	DESCRIPTION
	GW	Well graded gravels or gravel-sand mixtures. Little or no fines
	GP	Poorly graded gravels or gravel-sand mixtures. Little or no fines
	GM	Silty gravels. Gravel-sand-silt mixtures
	GC	Clayey Gravels. Gravel-sand-clay mixtures
	GM-GW	Dual Classification
	GM-GP	Dual Classification
	SP	Poorly graded sands or gravelly sands. Little or no fines
	SW	Well graded sands or gravelly sands. Little or no fines
	SM	Silty Sands. Sand-silt mixtures
	SC	Clayey sands. Sand-clay mixtures
	SM-SC	Dual Classification
	SM-SP	Dual Classification
	ML	Inorganic silts and very fine sands. Rock flour, silty or clayey fine sands or clayey silts with slight plasticity
	CL	Inorganic clays of low to medium plasticity. gravelly clays, sandy clays, silty clays, lean clays
	ML-CL	Dual Classification
	MH	Inorganic silts, micaceous or diatomaceous fine sandy or silty soils, elastic silts
	CH	Inorganic clays of medium to high plasticity
	SM-SW	Dual Classification

ROCK CLASSIFICATIONS	
	Sandstone, silty or clayey sandstone
	Clay Shale

CLAY CONSISTENCY		EQUIVALENT S.P.T. BLOWS
CHARACTERISTIC	DESCRIPTION	
Very soft	Without form	2-
Soft	Readily deformed by fingers with light pressure or easily squeezed through fingers.	4
Medium stiff	Easily deformed by fingers with moderate pressure, but cannot be squeezed through fingers.	8-
Stiff	Deformed with difficulty by fingers. A pencil jabbed into the sample will penetrate and tend to stick.	15
Very stiff		3
Hard	Can be gouged by fingernail. A pencil jabbed into the sample will penetrate slightly, but does not tend to stick.	

DENSITY (SILT AND SAND)		S.P.T. BLOWS/ FT.
CHARACTERISTIC		
Loose		10
Medium Dense		10-30
Dense		30-50
Very Dense		> 50

ROCK STRUCTURE	
CHARACTERISTIC	DESCRIPTION
Fragmented	Samples completely broken up (Most likely mechanically induced)
Friable	Crumbles naturally or is easily broken pulverized or reduced to powder
Highly Fractured	Fractures spaced generally less than 4 inches apart.
Fractured	Fractures spaced generally between 4 inches and 1 foot apart.

ROCK HARDNESS	
CHARACTERISTIC	DESCRIPTION
V. Soft	Can be deformed by hand
Soft	Can be scratched with fingernail.
Moderately Hard	Can be scratched easily with a knife.
Hard	Difficult to scratch with a knife.
Very Hard	Cannot be scratched with a knife.

BEDROCK WEATHERING	
CHARACTERISTIC	DESCRIPTION
Highly Weathered	Rock is reduced to a soil with reflect rock structure can be generally molded and crumbled by hand.
Weathered	Entire mass is discolored, alteration pervades nearly all of the rock with some pockets of less weathered rock noticeable, some minerals leached away, retains only a fraction of original strength.
Slightly Weathered	Slight discoloration on surfaces, slight alteration along discontinuities, less than 10% of the rock volume is altered, strength is substantially unaffected.
Unweathered	No evidence of any mechanical or chemical alteration.

CONSISTENCY	EQUIVALENT S.P.T. BLOWS/FT.
Without form	2
Earth formed by fingers with light pressure or easily squeezed through fingers	2-4
Earth formed by fingers with moderate pressure but cannot be squeezed through fingers	4-8
Determined with difficulty by fingers. A pencil jabbed into the sample will penetrate and tend to stick	8-15
	15-30
Can be pushed by fingernail. A pencil jabbed into the sample will penetrate slightly but does not tend to stick	30

DENSITY (LT AND SAND)	S.P.T. BLOWS/FT.
	10
	10-30
	30-50
	> 50

ROCK STRUCTURE
DESCRIPTION

Samples completely broken up
Most likely mechanically induced

Crumbles naturally or is easily broken pulverized or reduced to powder

Fractures spaced generally less than 4 inches apart

Fractures spaced generally between 4 inches and 1 foot apart

HARDNESS
DESCRIPTION

Can be deformed by hand

Can be scratched with fingernail

Can be scratched easily with a knife

Difficult to scratch with a knife

Cannot be scratched with a knife

SEDIMENT WEATHERING
DESCRIPTION

Rock is reduced to a soil with reticled rock structure can be generally molded and crumbled by hand.

Entire mass is discolored. Alteration penetrates nearly all of the rock with some pockets of less weathered rock noticeable some intervals washed away retains only a fraction of original strength

Slight discoloration on surfaces. Slight alteration along discontinuities. Less than 10% of the rock volume is altered, strength is substantially unaffected.

No evidence of any mechanical or chemical alteration.


SYMBOL	DEFINITION
---	Estimated ground water level measured at time of drilling.
---	Water level measured from Piezometer
○	Drill Hole
●	Discharge Well
○	Recharge Well
○	Discharge well and Drift Hole at same location
□	Piezometer
—	Water Level
—	Instrates well used for aquifer pump test.
S.P.T.	Standard Penetration Test
S.S.	Split Spoon
■	Indicates interval sampled on boring logs


- GEOTECHNICAL NOTES**
- The data shown on Plates 5 through 9 are compilations of data from the field logs which are the only record of the actual geologic features observed from detailed examination of samples obtained during exploratory drilling. This presentation of data from the field log is provided to assist the contractor in evaluating the site. Actual field logs of all the borings shown on Plate 3 are available for review at the Omaha District Office.
 - The logs shown on Plates 5 through 9 and the field logs are representative of subsurface conditions for the exploratory borings at their respective locations as shown on the drawings. Local variations characteristic of subsurface materials in this region are anticipated.
 - Letter symbols such as GC, SC, SP, SM, CL, etc., are in accordance with the Unified Soil Classification System, CDE, Technical Memorandum No. 3-597, May, 1967.
 - Bedrock classifications shown on the logs are based on visual inspection of 2 or 3 inch diameter split spoon drive samples. The degree of weathering, fracturing, etc., of the rock was determined by the physical appearance and condition of the samples. The sandstone encountered in borings P-LW-5 was cored in auxiliary holes W-5A and W-5B. PG 3, 3/8 inch diameter core samples of the sandstone are available for inspection at Rocky Mountain Arsenal. Bidders should examine the core samples to satisfy themselves as to the physical properties of the rock.
 - Most of the borings drilled for this project were drilled with a 7-7/8 inch hollow stem auger. Some were drilled utilizing a churn drill and drive barrel. The drilling method for each hole is indicated on the original field logs.
A. All borings shown on Plates 5 through 9 were drilled with the hollow stem auger.
B. Sampling was accomplished by:
A. In augered holes, 3 or 2 inch diameter split spoon samples were taken at 2-1/2 or 5 foot intervals, using a 36 pound hammer. See boring logs for sample intervals and diameter.
B. Churn drilled holes were sampled continuously using a 6 inch diameter drive barrel.
C. Core drilling was accomplished using a 10 foot long P.C. 4, 827-inch O.D. Core Barrel with inner barrel.
 - Only the logs for the borings along the discharge line skurry wall and recharge line are shown in these plans. The logs for all the borings shown in plan only on Plate 3 are available for inspection at the Omaha District, Corps of Engineers.
 - Ground Water levels are not available for all borings. Absence of ground water data on a boring log does not necessarily mean that ground water will not be encountered at that location within the vertical reach of the boring. Ground Water levels indicated on boring logs reflect the level at the time measured. Ground Water levels will vary with time.
 - Relative density of sand strata and consistency of silt/clay were estimated by visual inspection of soil samples at time of drilling and by the number of blows required to drive the samplers.
 - Moisture content descriptions were estimated by visual inspection of samples at the time of drilling.
 - More detailed information on drilling progress, water data, fractures and other data are shown on the field logs. Copies of the field logs are available for inspection in the office of the U.S. Army Engineer District, Omaha, NE.
 - Lines between borings designation at top of bedrock, top of aquifer, or top of ground are estimates only.
 - All unified soil classification symbols shown on the boring logs are laboratory classifications of the soils from the corresponding split spoon samples.

THIS DRAWING HAS BEEN INDEXED TO THREE-CENTERS THE ORIGINAL SCALE.

2

REVISIONS	
U. S. ARMY ENGINEER DISTRICT, OMAHA CORPS OF ENGINEERS OMAHA, NEBRASKA	
PROJECT NO. 84-1	ROCKY MOUNTAIN ARSENAL COMMERCE CITY, COLORADO
NORTHWEST BOUNDARY CONTAINMENT GEOTECHNICAL LEGEND AND NOTES	
FY 81 MCA PN 38-2	
DATE: JAN 1984	SCALE: AS SHOWN
PROJECT NO. 84-1	OMAHA DISTRICT
7 841-40-01	

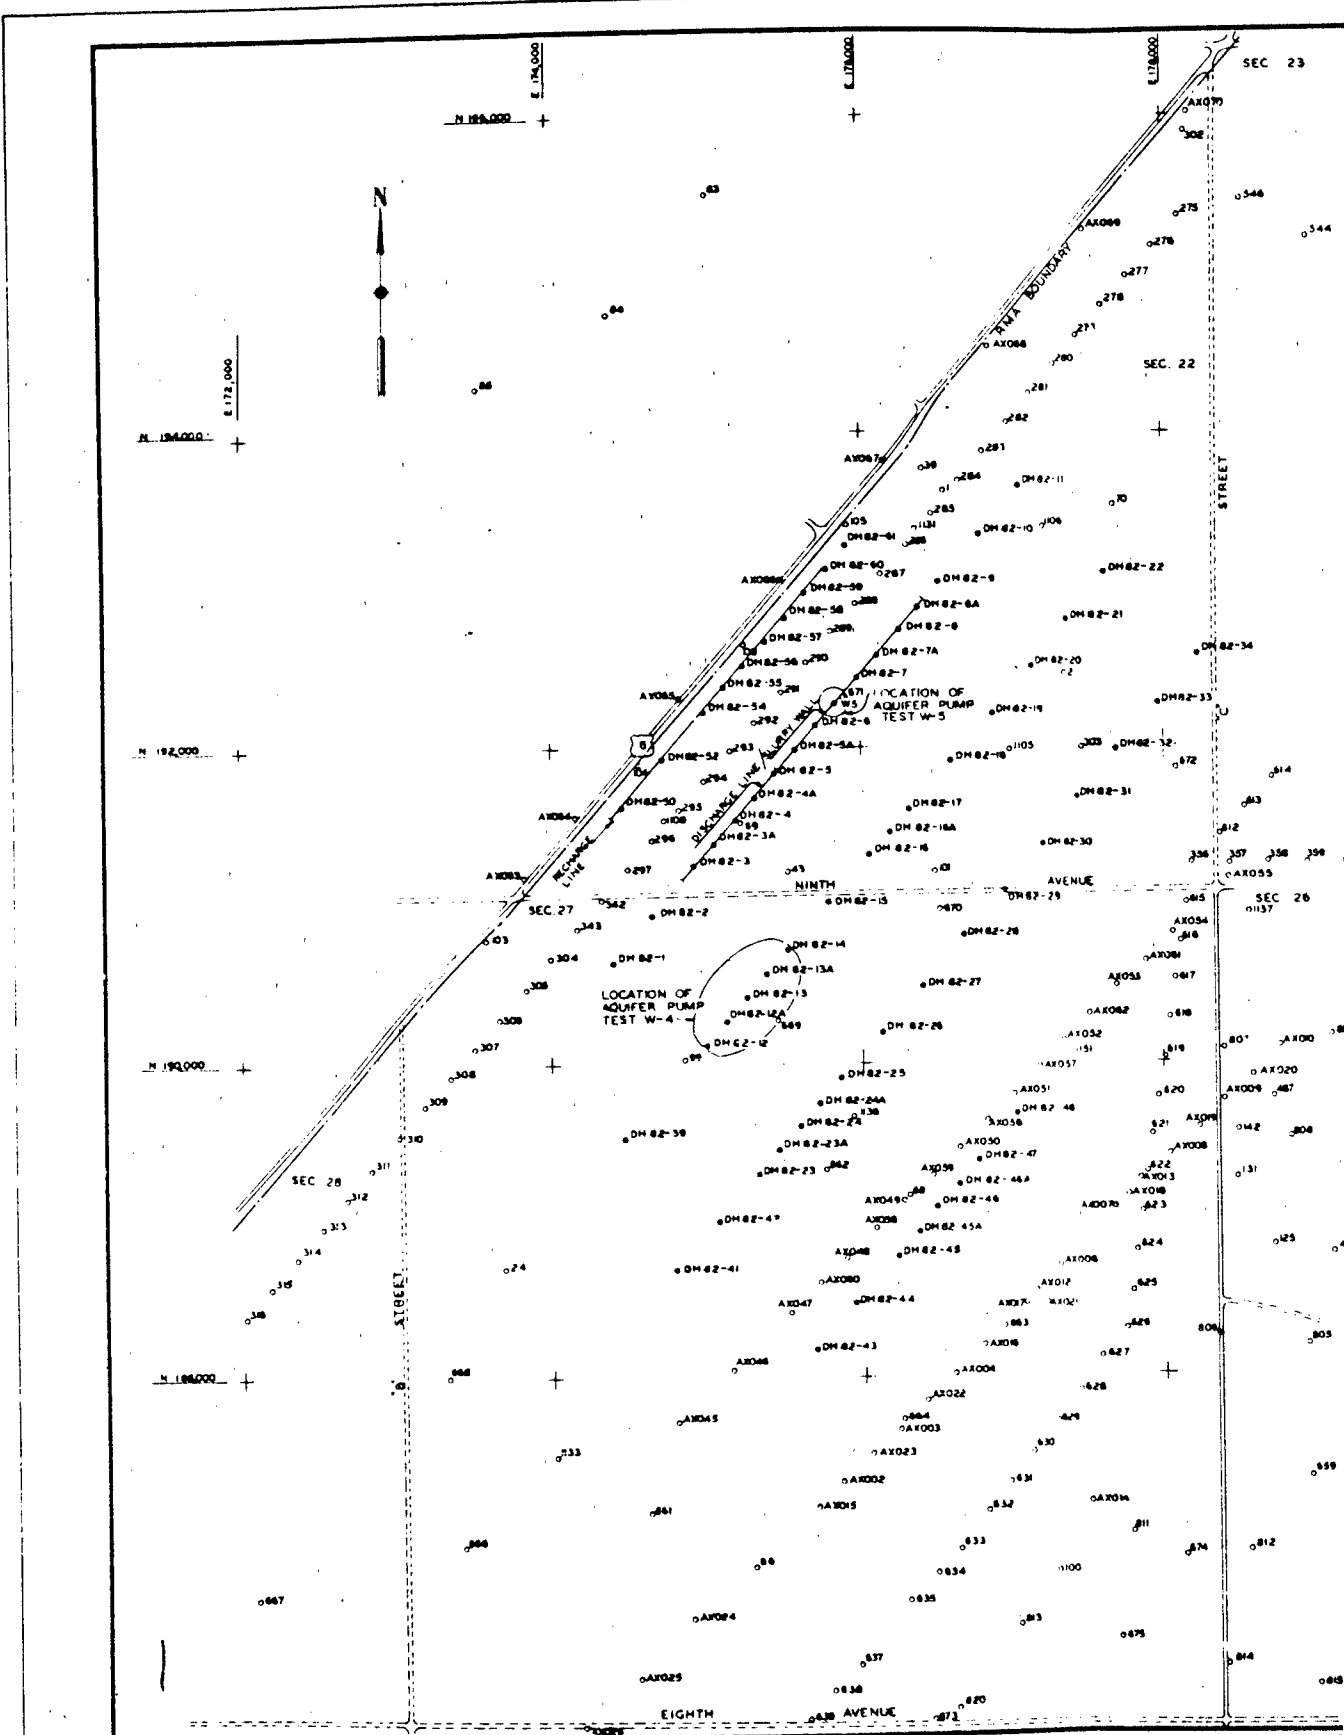

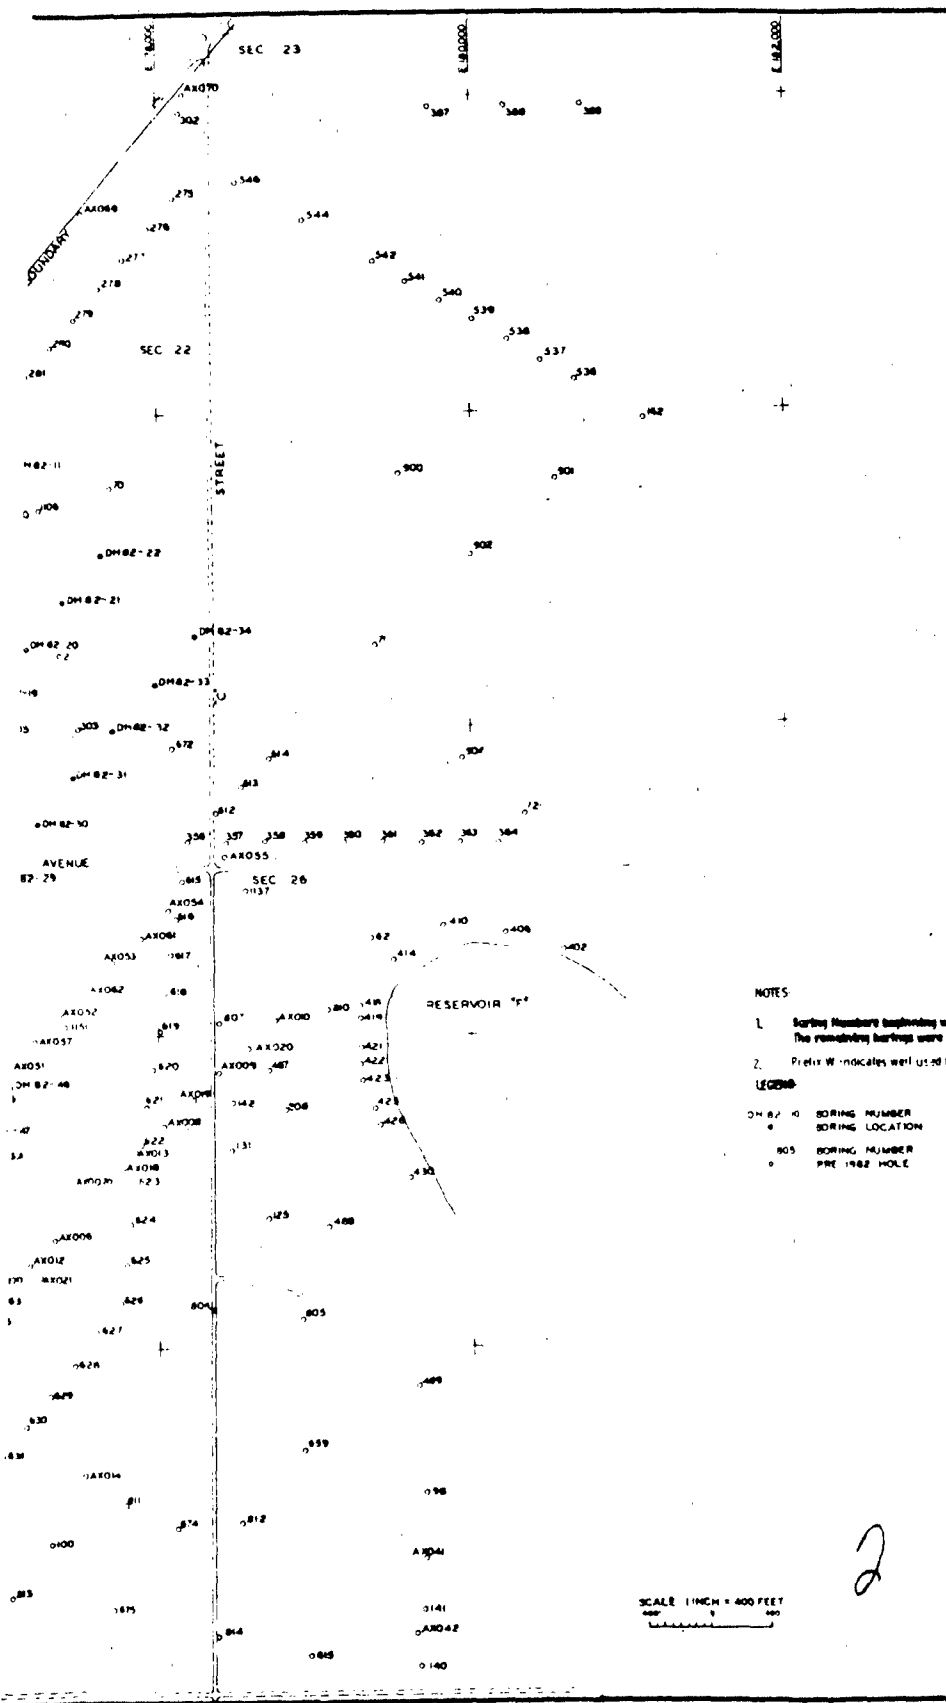

NOTES

1. Boring Numbers beginning with OH-82 indicate the holes drilled for this project. The remaining borings were drilled previously.
2. Prefix W indicates well used for aquifer pump test.

LEGEND


- OH 82-XX BORING NUMBER
- BORING LOCATION
- 805 BORING NUMBER
- PRE 1982 HOLE



SCALE 1 INCH = 400 FEET

2

THIS DRAWING HAS BEEN REDUCED TO THREE-FIFTHS THE ORIGINAL SIZE.

DATE	DESIGNATION	ISSUE	APPROVED
REVISIONS			
U. S. ARMY ENGINEER DISTRICT, OMAHA			
CORPS OF ENGINEERS			
OMAHA, NEBRASKA			
DESIGNED BY C. E. K.	ROCKY MOUNTAIN ARSENAL	COMMERCE CITY, COLORADO	
NORTHWEST BOUNDARY CONTAINMENT			
PRE-CONSTRUCTION			
BORING LOCATION PLAN			
PROJECT NO.	DATE	FY 81 MCA PN 36.8	
BY: J. P. BERRY	DATE	DATE	
CHECKED BY: J. P. BERRY	DATE	DATE	
APPROVED BY: J. P. BERRY	DATE	DATE	
		F 84-40-01	

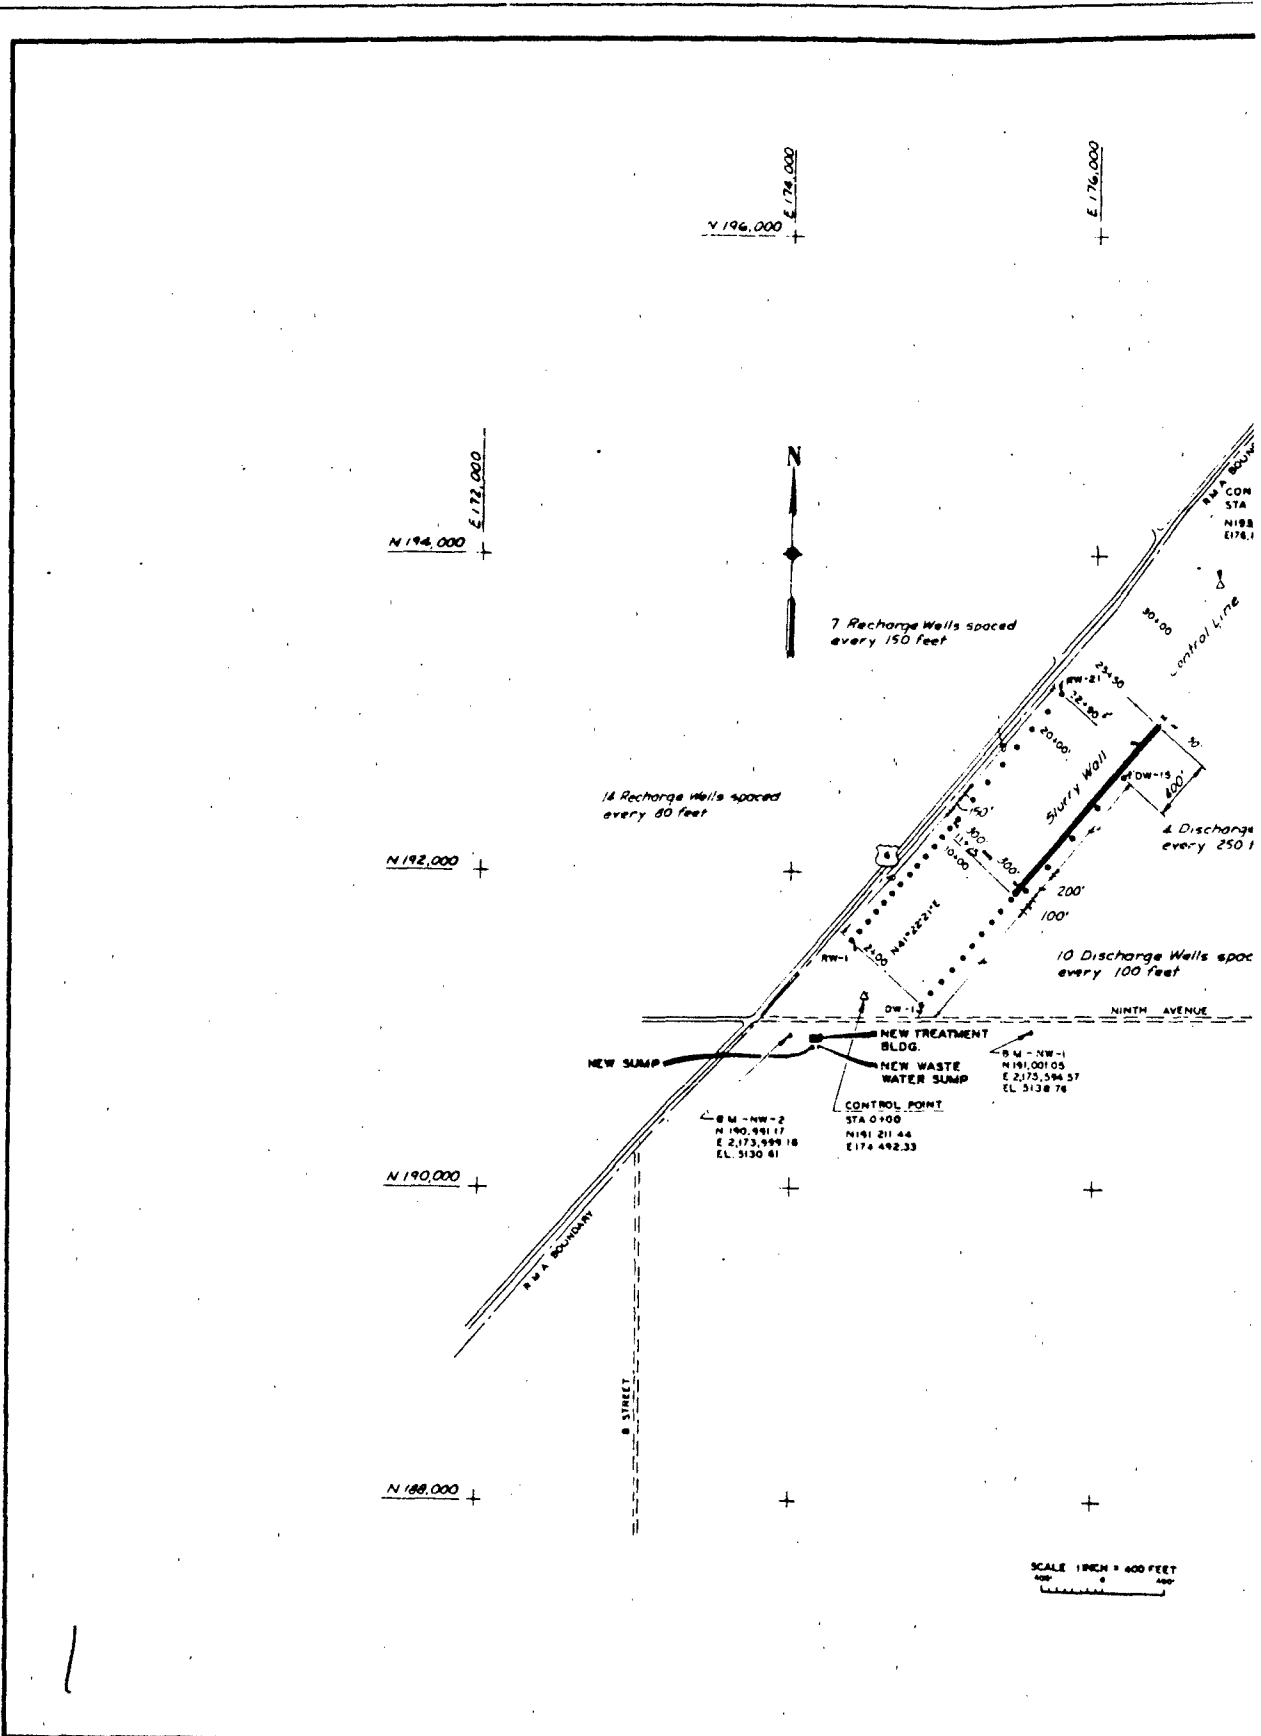

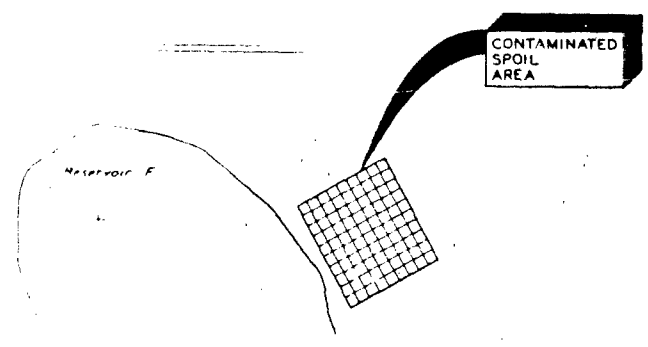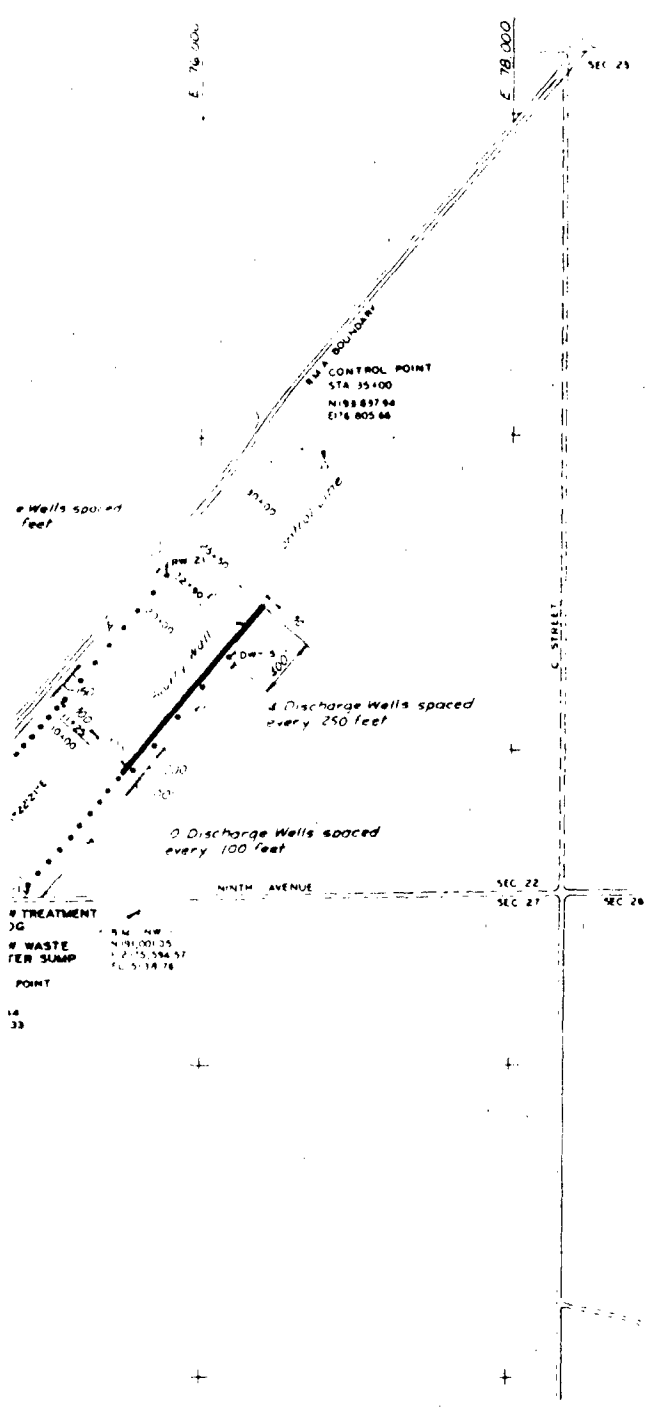


THIS DRAWING HAS BEEN REDUCED TO THREE-FIFTHS THE ORIGINAL SCALE.

DATE	DESCRIPTION	BY	APP'D
ENGINEER			
U. S. ARMY ENGINEER DISTRICT, OMAHA CORPS OF ENGINEERS OMAHA, NEBRASKA			
DESIGNED BY: S.P.	ROCKY MOUNTAIN ARSENAL	COMMERCE CITY, COLORADO	
DRAWN BY: S.P.	NORTHWEST BOUNDARY CONTAINMENT		
CHECKED BY: S.P.	CONTAINMENT SYSTEM		
LOCATION	LOCATION PLAN		
PROJECT NO.	FT. BI. MCA PH 36.2		
SCALE	AS SHOWN	DATE	BY
PROJECT NO.	DATE	SCALE	DATE
PROJECT NO.		DATE	
F 841-40-01			

300 Ft of Control Line

DW-1 ● P-1 □ DW-2-1 ● DW-3 ●
 2+00 2+50 3+00 4+00

SCALE 1/10

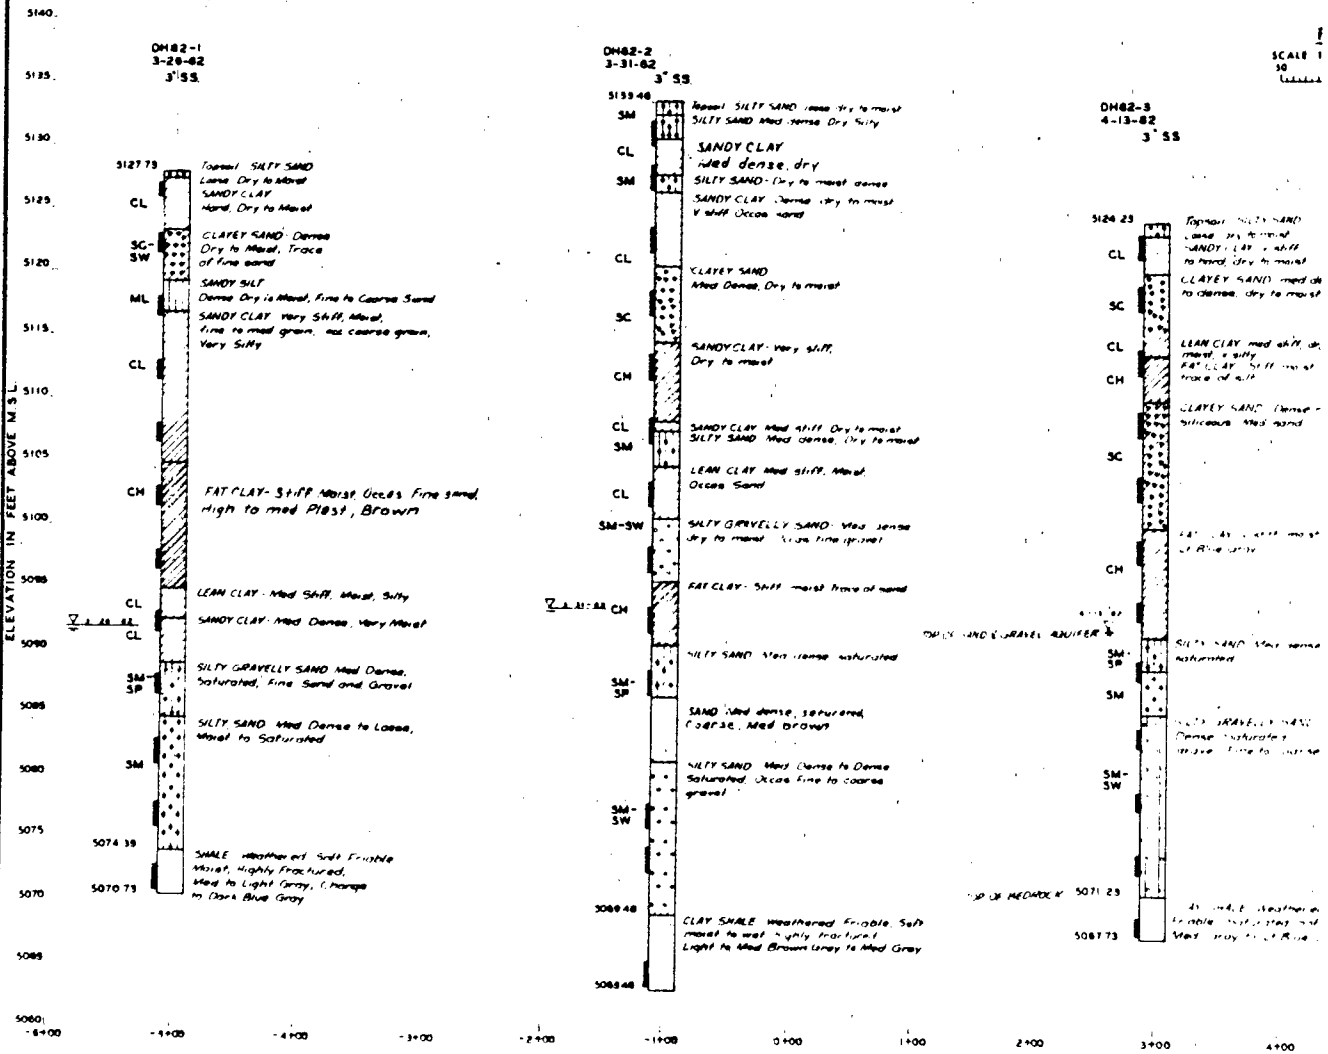

PROFILE
 VERT 1 INCH = 5 FEET
 HORIZ 1 INCH = 50 FEET


NOTES
 1
 2
 3

With 1/4" Control Line



PLAN
SCALE 1 INCH = 50 FEET

DH82-3 4-13-82 3' 55"
DH82-3A 12-08-82 2' 55"
DH82-4 4-13-82 3' 55"
DH82-4A 11-12-82 3' 42" S.S.

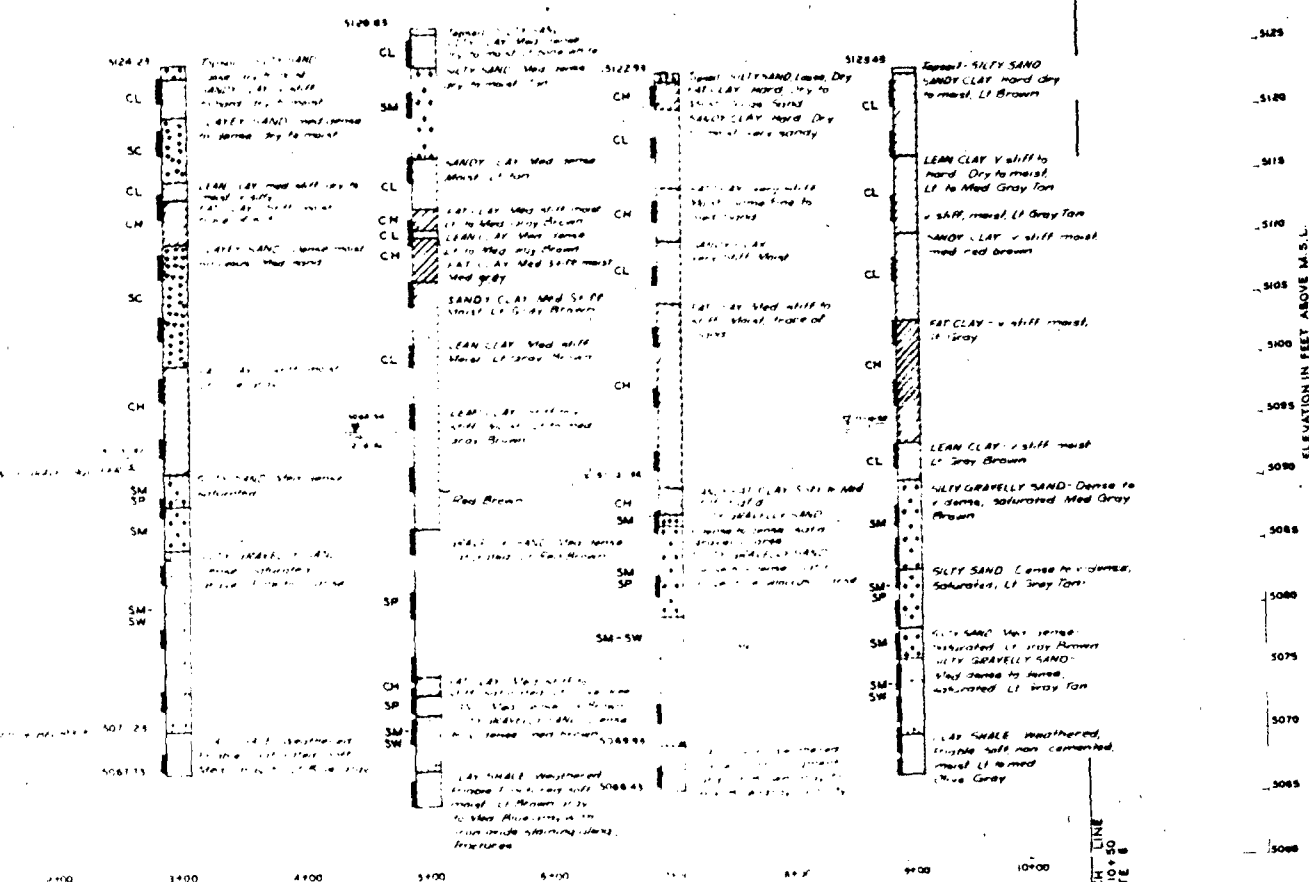

PROFILE



SCALE VERT 1 INCH = 5 FEET
HORIZ 1 INCH = 50 FEET

NOTES:



1. See Plate 10 for Well and Piezometer Observation Schedule.
2. The Descriptive data at the right of the logs are the results of field descriptions made by the geologist in the field at the time of drilling and laboratory data. Laboratory classifications at the left of the logs are in accordance with the Unified Soil Classification System TM-5-597, May, 1967.
3. See Plate 2 for Geotechnical Layout and Notes.

2

REVISIONS	
NO.	DESCRIPTION
U. S. ARMY ENGINEER DISTRICT, OMAHA SCHOOL OF ENGINEERING OMAHA, NEBRASKA	
ROCKY MOUNTAIN ARSENAL COMMERCE CITY, COLORADO	
NORTHWEST BOUNDARY CONTAINMENT PLAN AND PROFILE OF DISCHARGE LINE/SLURRY WALL LOG OF BORINGS-DH82-1 THRU 4A	
BY: MCA PM 38-2	
DATE: 1-18-68	SCALE: AS SHOWN
BY: J.A.M. (SIGNED)	CHECKED BY: DCA43
DRAWING NUMBER F 841-40-01	

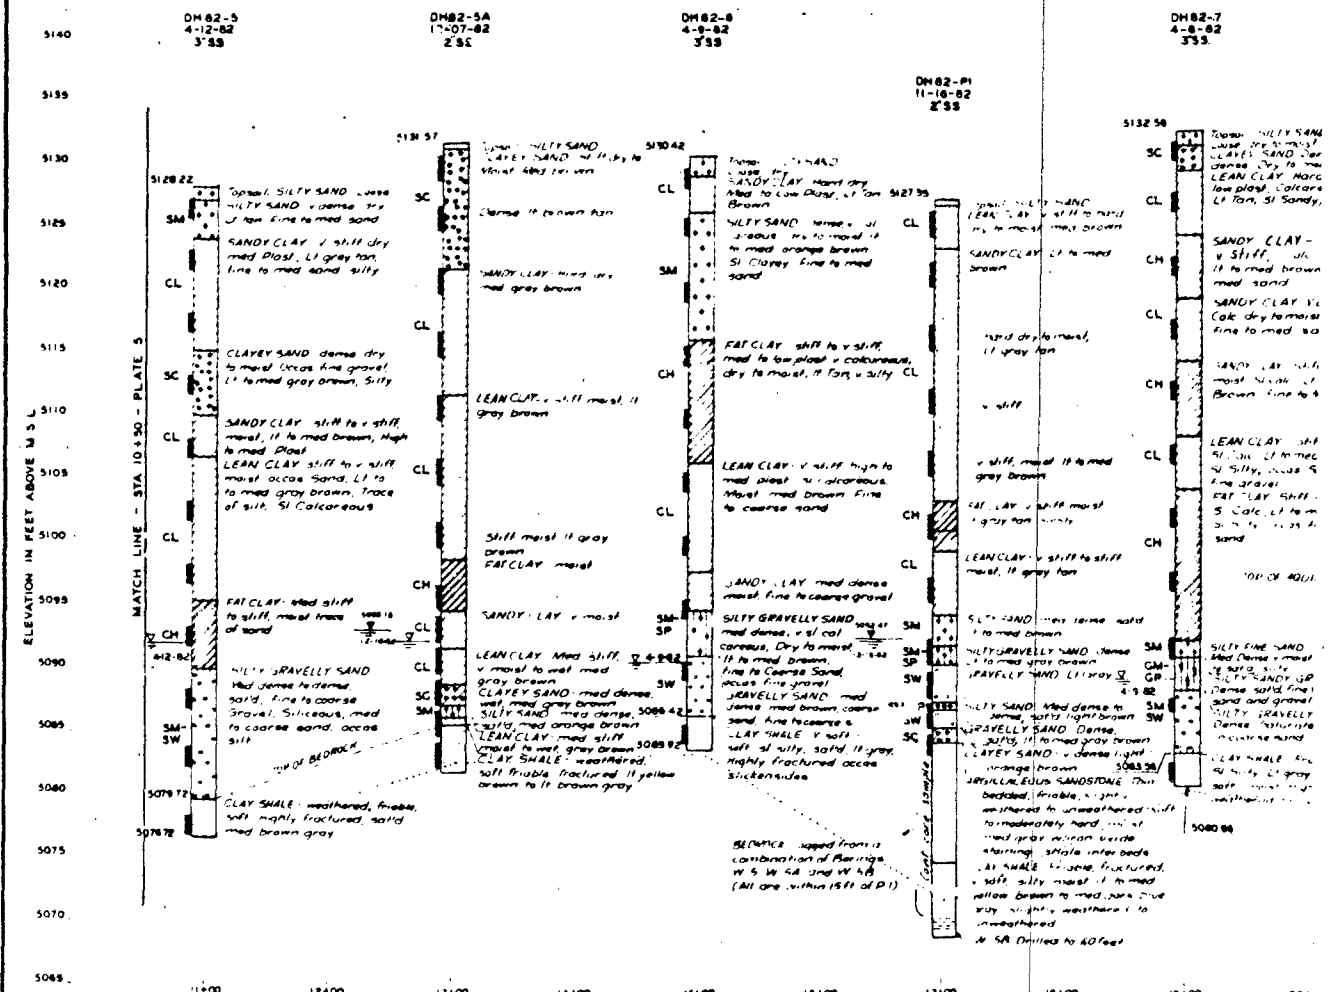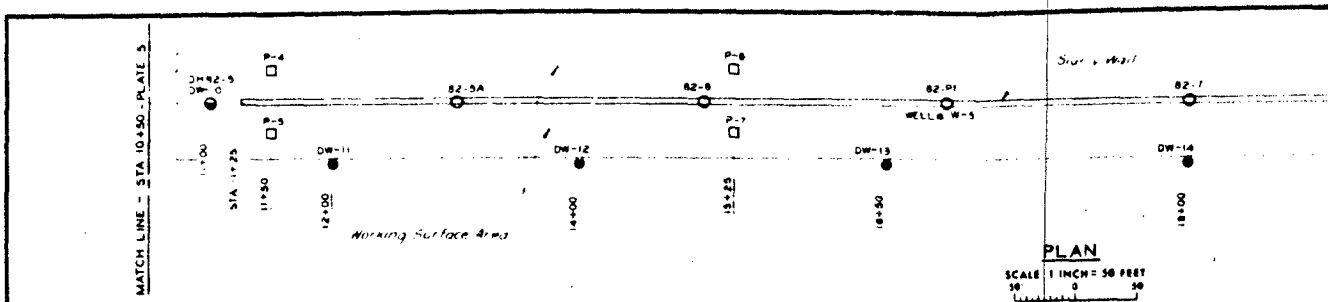

PROFILE
 SCALE VERT 1 INCH = 5 FEET
 HORIZ 1 INCH = 50 FEET

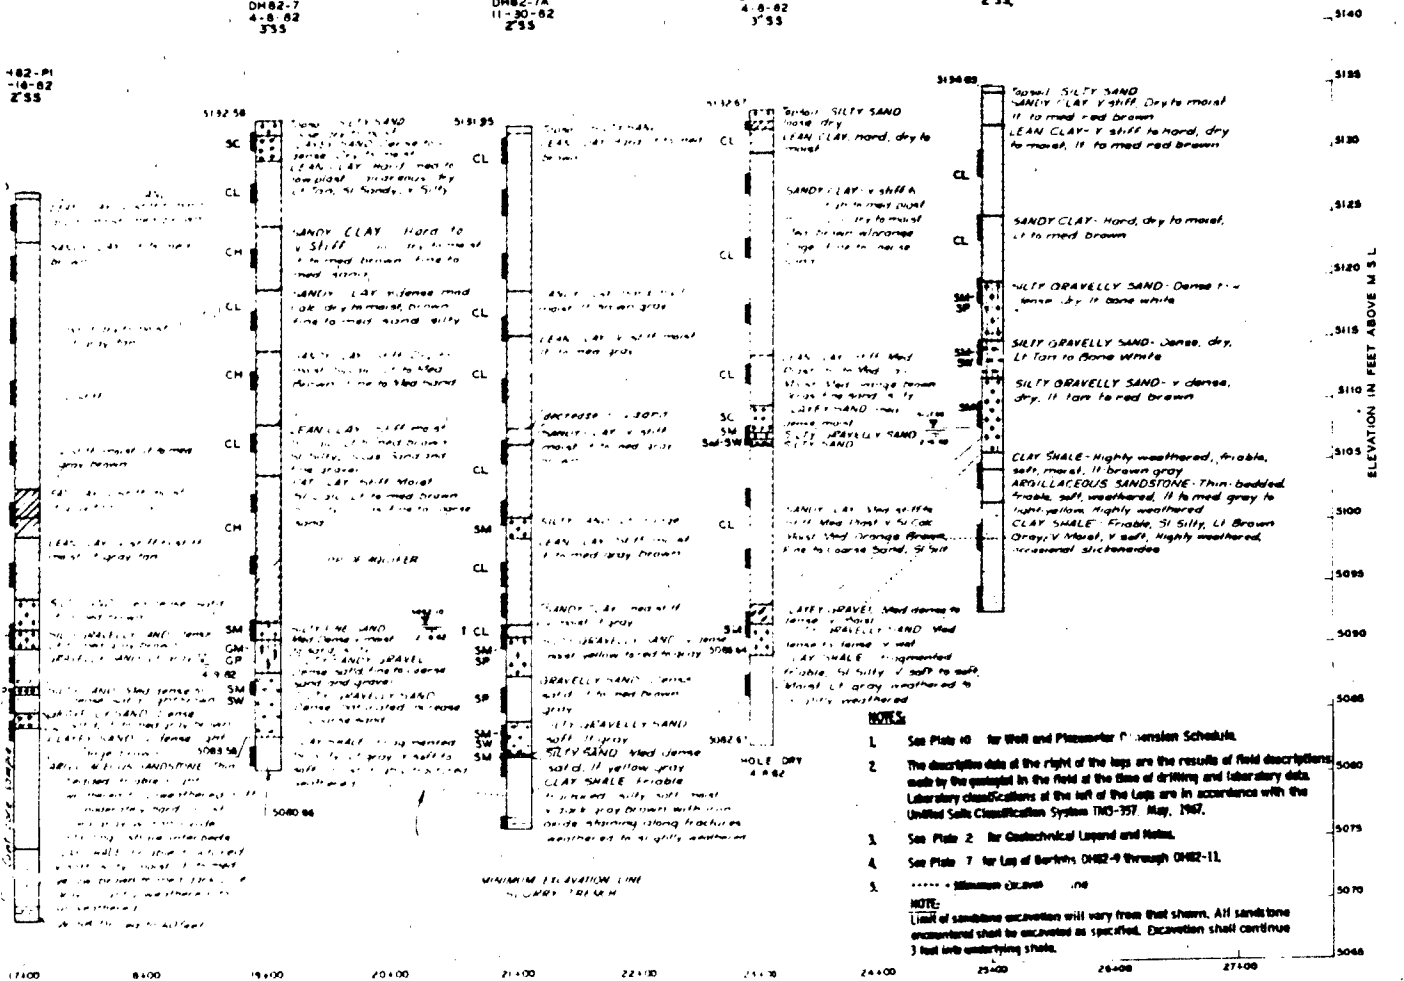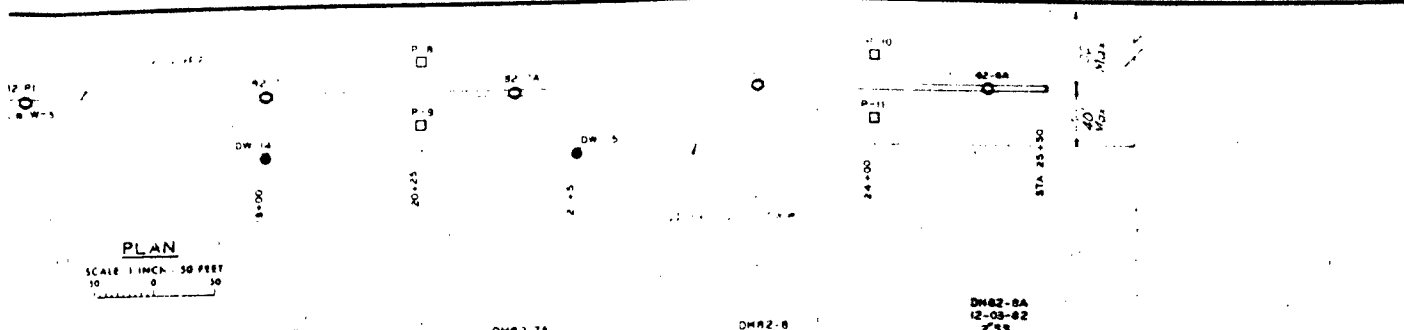


PROFILE
 SCALE VERT. 1/4 INCH = 5 FEET
 HORIZ. 1 INCH = 50 FEET


- NOTES:**
1. See Plate 10 for Well and Piezometer Construction Schedule.
 2. The descriptive data at the right of the logs are the results of field descriptions made by the geologist in the field at the time of drilling and laboratory data. Laboratory classifications at the left of the logs are in accordance with the Unified Soil Classification System TMO-977, May, 1967.
 3. See Plate 2 for Geotechnical Legend and Notes.
 4. See Plate 7 for Log of Borings DH82-9 through DH82-11.
 5. ***** Minimum Elevation *****
- NOTE:**
 Limit of sandstone excavation will vary from that shown. All sandstone encountered shall be excavated as specified. Excavation shall continue 3 feet into underlying shale.

DATE	REVISION	BY	APP'D
U. S. ARMY ENGINEER DISTRICT, OMAHA GROUP OF ENGINEERS OMAHA, IOWA			
PROJECT NO. 17 DRAWING NO. 200		ROCKY MOUNTAIN ARSENAL COMMERCE CITY, COLORADO	
NORTHWEST BOUNDARY CONTAINMENT PLAN AND PROFILE OF DISCHARGE LINE/SLURRY WALL LOG OF BORINGS - DH 82-5 THRU 8A PY 81 MCA PH 38.2			
SCALE: 1/4" = 5' VERT. 1" = 50' HORIZ.		DATE: 11-30-62 DRAWN BY: J. J. [unreadable] CHECKED BY: [unreadable]	
F 841-40-01			

2

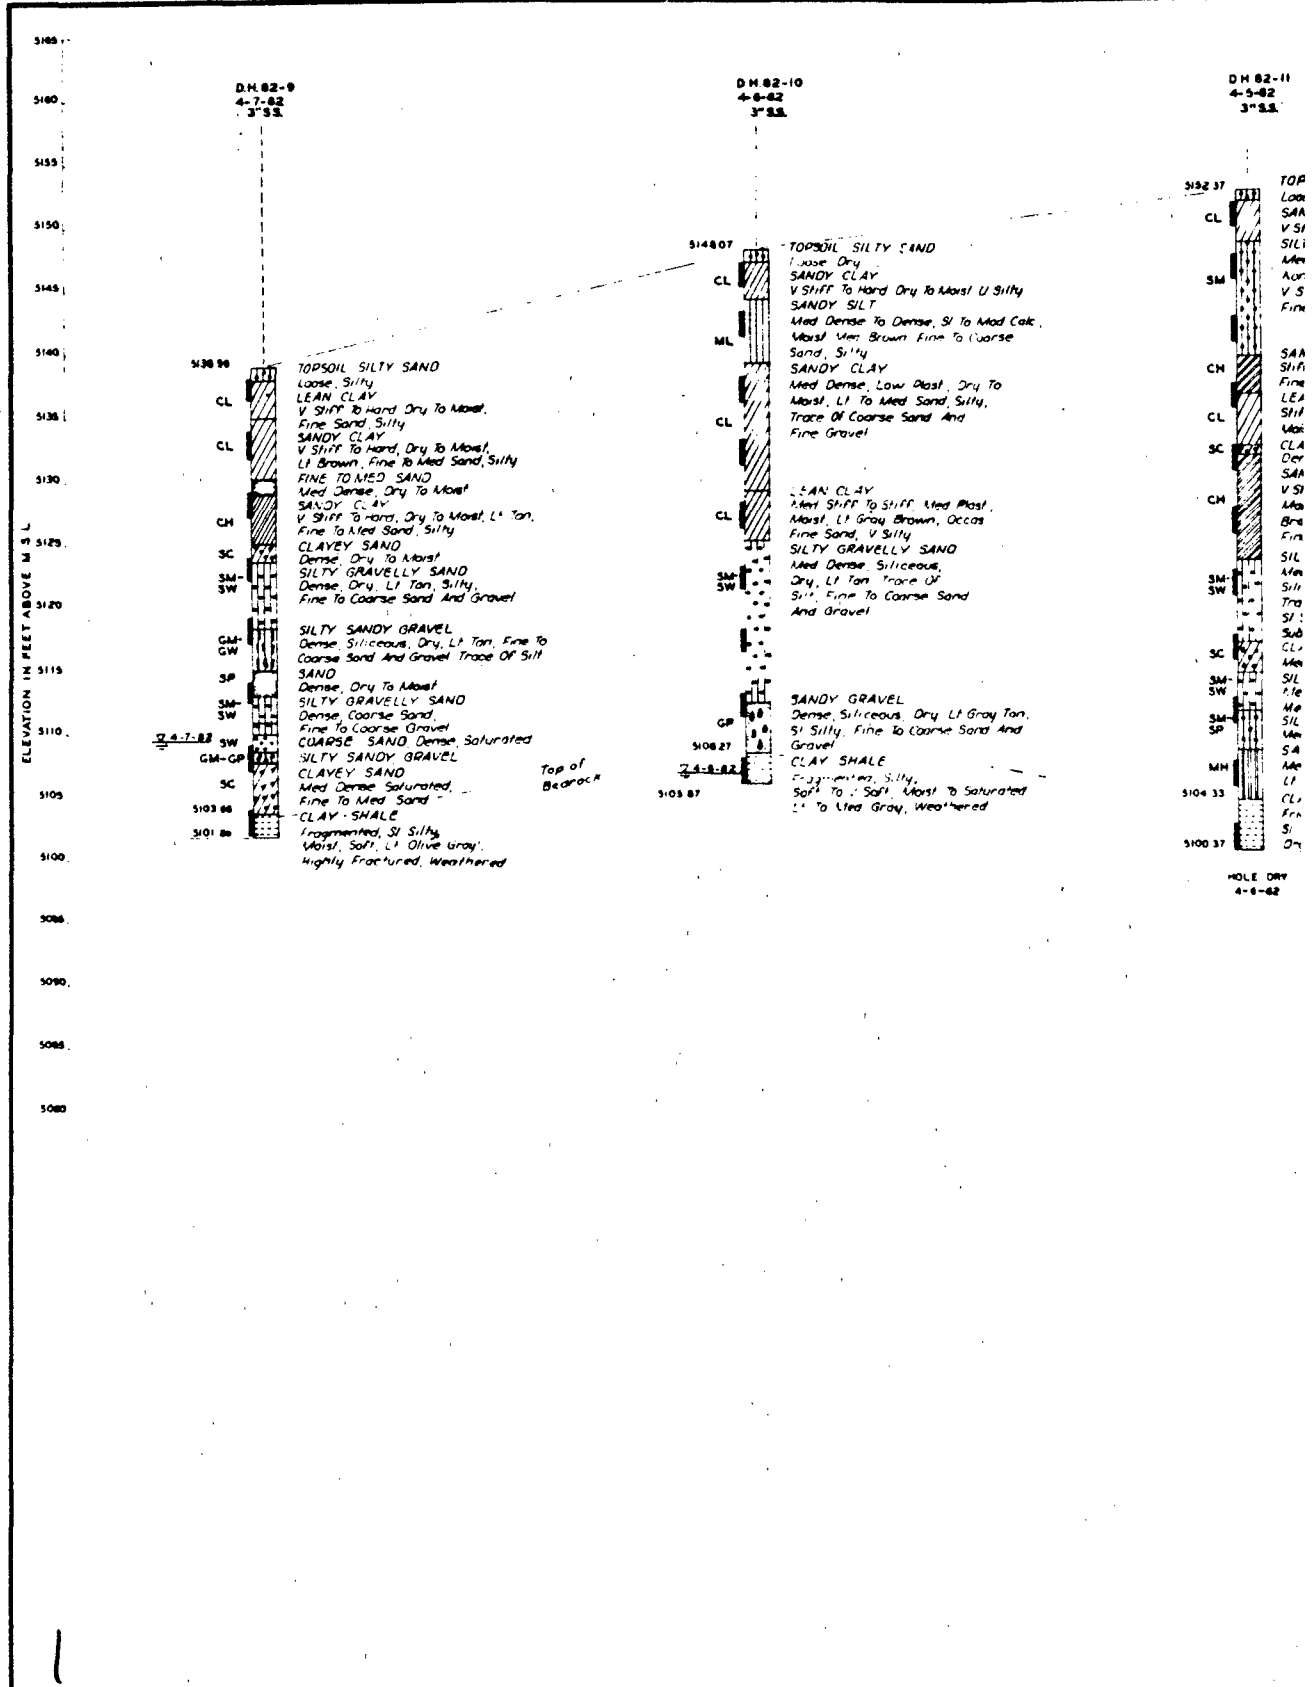

DH 82-11
4-3-62
3" x 8"

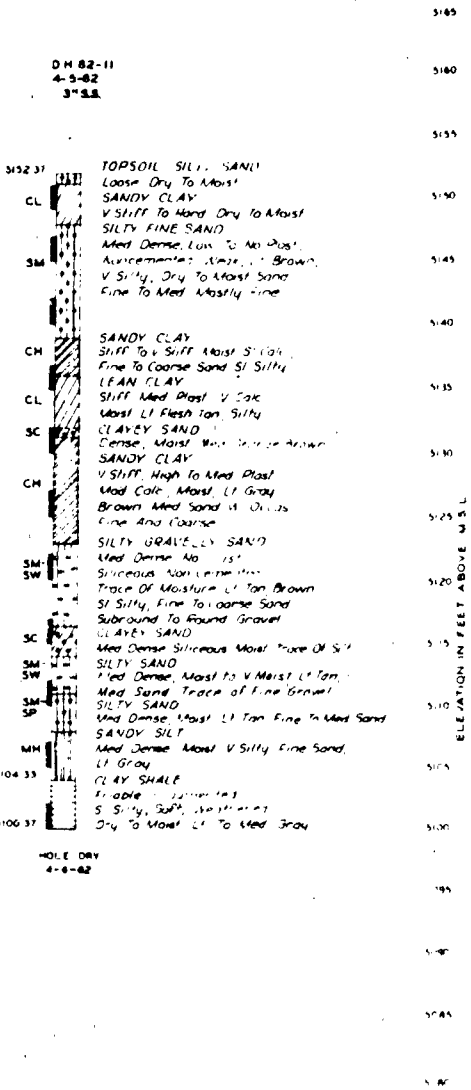


- NOTES:
- The descriptive data at the right of the logs are the results of field descriptions made by the geologist in the field at the time of drilling and laboratory data. Laboratory classifications at the left of the logs are in accordance with the Unified Soil Classification System (USCS), 1967.
 - See Plate 2 for geotechnical Legend and Notes.
 - See Plates 5 & 6 for Log of Borings DH82-1 through DH82-6A.

THIS DRAWING HAS BEEN REDUCED TO
THREE-FIFTHS THE ORIGINAL SIZE.


REVISIONS	
NO.	DESCRIPTION
U. S. ARMY ENGINEER DISTRICT, OMAHA CORPS OF ENGINEERS OMAHA, NEBRASKA	
PROJECT NO. 8-3-62	ROCKY MOUNTAIN ARSENAL, COMMERCE CITY, COLORADO
NORTHWEST BOUNDARY CONTAINMENT PLAN AND PROFILE OF DISCHARGE LINE/SLURRY WALL LOG OF BORINGS DH 82-9 THROUGH DH 82-11 BY S. H. L. PH 36.2	
DATE	SITE
SCALE AS SHOWN	DATE OF PACAGE
F 841-40-01	

2

300 ft If of Control Line

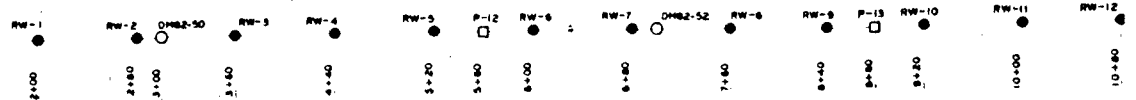


PLAN
SCALE 1 INCH = 50 FEET

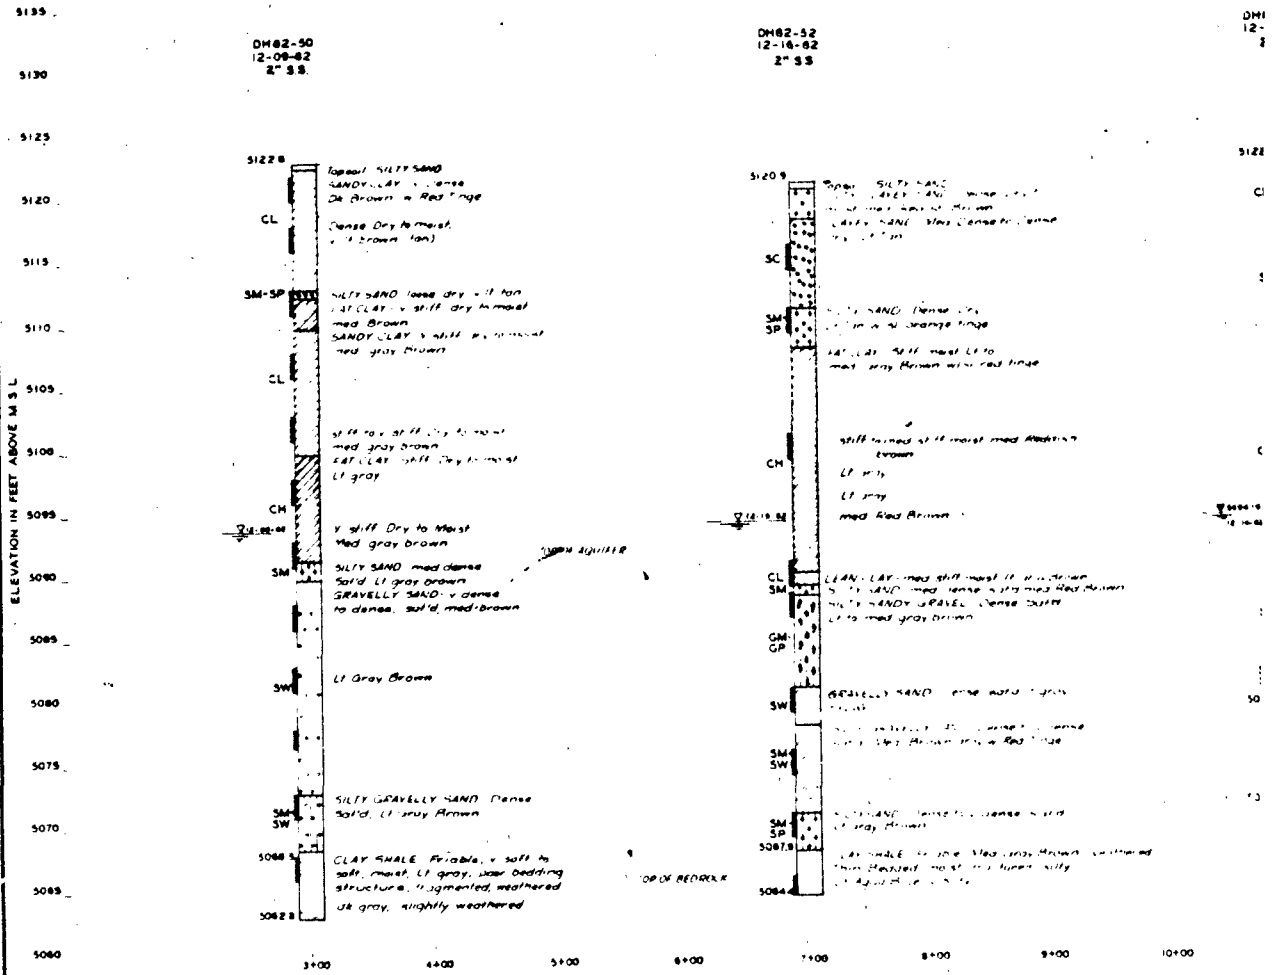

PROFILE
VERT 1 INCH = 5 FEET
HORIZ 1 INCH = 50 FEET

of Line

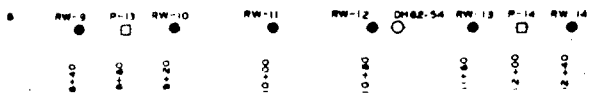


PLAN
SCALE 1 INCH = 50 FEET

DH82-54
12-10-82
2'S.S.

DH82-55
11-10-82
2'S.S.

DH82-56
11-10-82
2'S.S.

MATCH LINE - STA 18+50 - PLATE 9

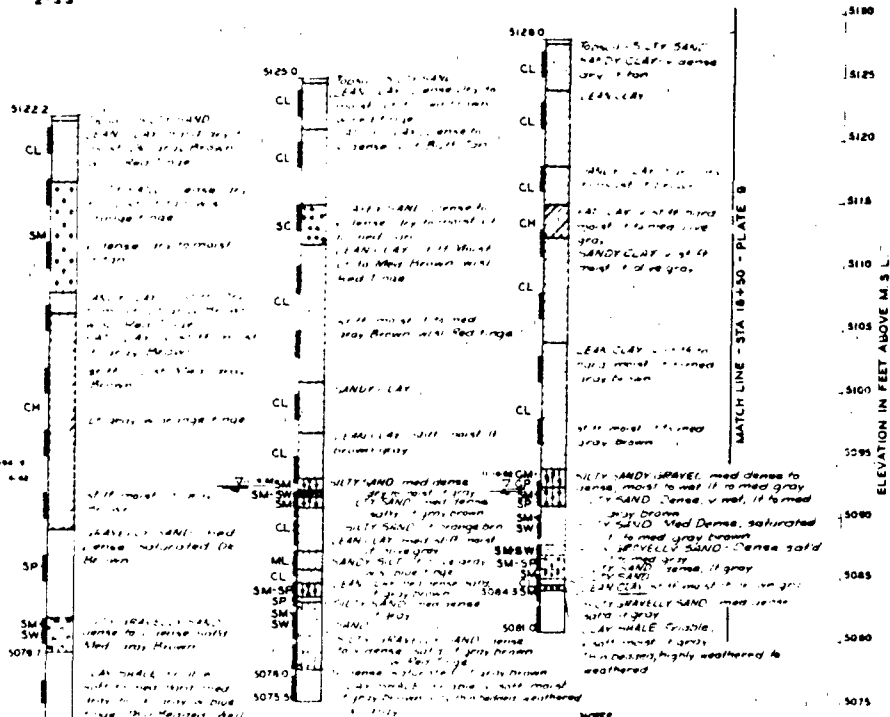

NOTES

1. See Plate 10 for Well and Piezometer Dimension Schedules.
2. The descriptive data at the right of the logs are the results of field descriptions made by the geologist in the field at the time of drilling and laboratory tests. Laboratory classifications at the left of the logs are in accordance with the Unified Soil Classification System TM 5-977, May 1967.
3. See Plate 2 for Geotechnical Layout and Notes.

THIS DRAWING HAS BEEN APPROVED TO REPRODUCE AT THE ORIGINAL SCALE.


PROFILE
VERT. 1 INCH = 5 FEET
HORIZ. 1 INCH = 50 FEET

DATE	DESIGNED BY	MADE	CHECKED
REVISIONS			
U. S. ARMY ENGINEER DISTRICT, OMAHA CORPS OF ENGINEERS OMAHA, NEBRASKA			
ROCKY MOUNTAIN ARSENAL		COMMERCE CITY, COLORADO	
NORTHWEST BOUNDARY CONTAINMENT PLAN AND PROFILE OF RECHARGE LINE LOG OF BORINGS - DH 82-50 THRU 56 BY SLMCA PL 34.2			
PROJECT	ENGINEER	SCALE AS SHOWN	DATE
PROJECT NUMBER		DRAWING NUMBER	
F 841-40-01			

2

MATCH LINE - STA 18+50 - PLATE B

300 ft of Control Line

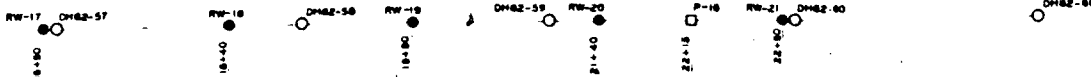


DH62-57
11-17-82
7 7/8" ASA
2" S.S.

DH62-58
12-13-82
2" S.S.

DH62-59
11-22-82
2" S.S.

DH62-60
12-14-82
2" S.S.

DH62-61
12-14-82
2" S.S.

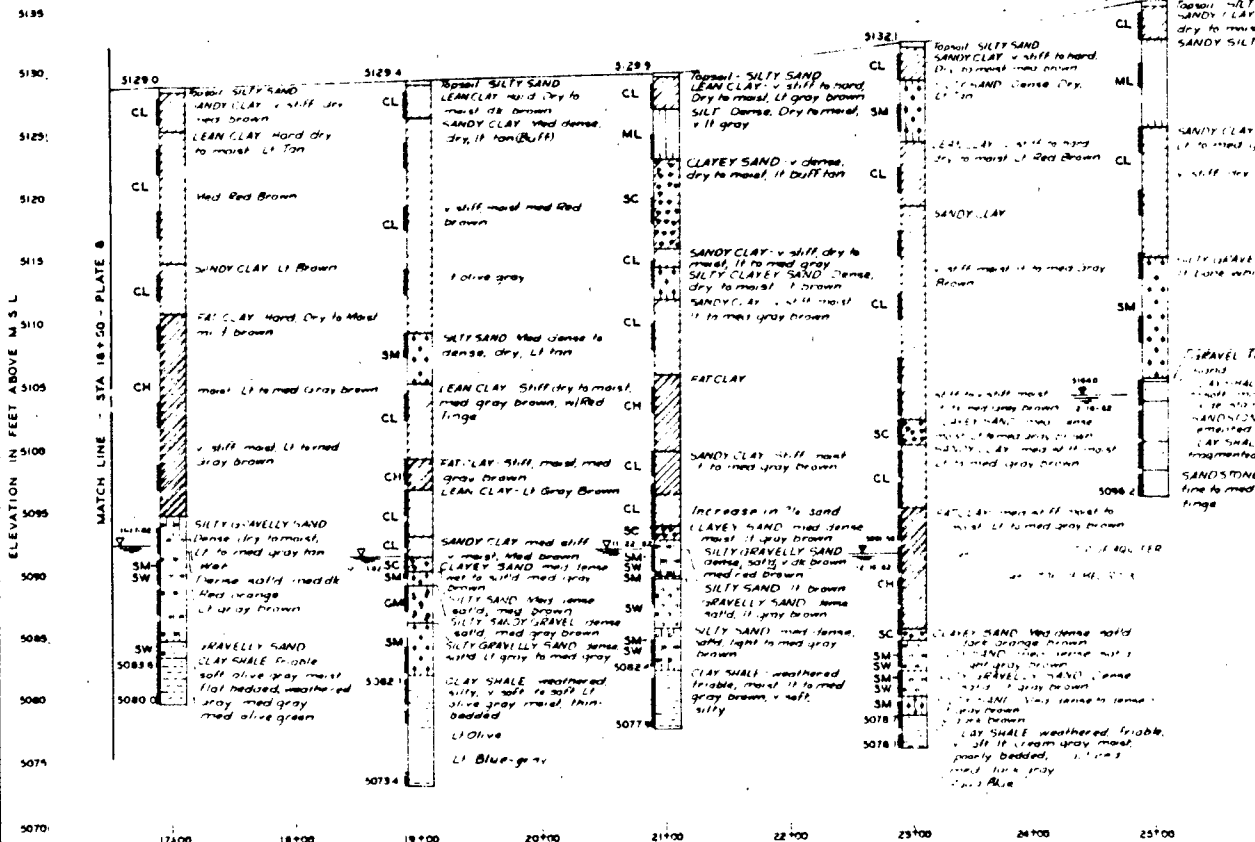


DH82-60

DH82-61

52-00
14-02
-35

DH82-61
2-14-62
2'53

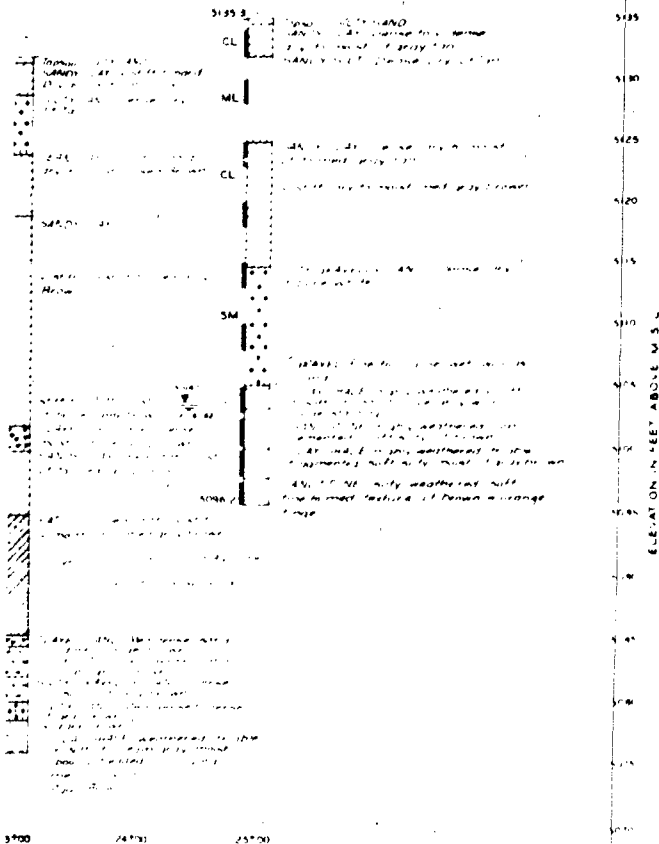


NOTES


1. See Plate 10 for Well or Piezometer Dimension Schedule.
2. The descriptive data at the right of the logs are the results of field descriptions made by the geologist in the field at the time of drilling and laboratory data. Laboratory classifications at the left of the logs are in accordance with the Unified Soil Classification System TM 3-357, May 1967.
1. See Plate 2 for Geotechnical Legend and Notes.

THIS DRAWING HAS BEEN REPRODUCED TO THE BEST OF THE ORIGINAL SCALE.

DATE	DESIGNATION	NAME	APPROVE
REVISIONS			
U. S. ARMY ENGINEER DISTRICT, OMAHA CORPS OF ENGINEERS OMAHA, NEBRASKA			
DESIGNED BY: S. P.	ROCKY MOUNTAIN ARSENAL COMMERCE CITY, COLORADO		
DRAWN BY: J. J.	NORTHWEST BOUNDARY CONTAINMENT PLAN AND PROFILE OF RECHARGE LINE LOG OF BORINGS - DH 82-57 THRU 61 FY 81 MCA PN 36.2		
CHECKED BY: S. P.			
DATE: 1/11/62	SCALE:	DATE:	
BY: S. P.	SCALE AS SHOWN	DATE: 1/11/62	
PROJECT:	DRAWING NUMBER		
	F 841-40-01		

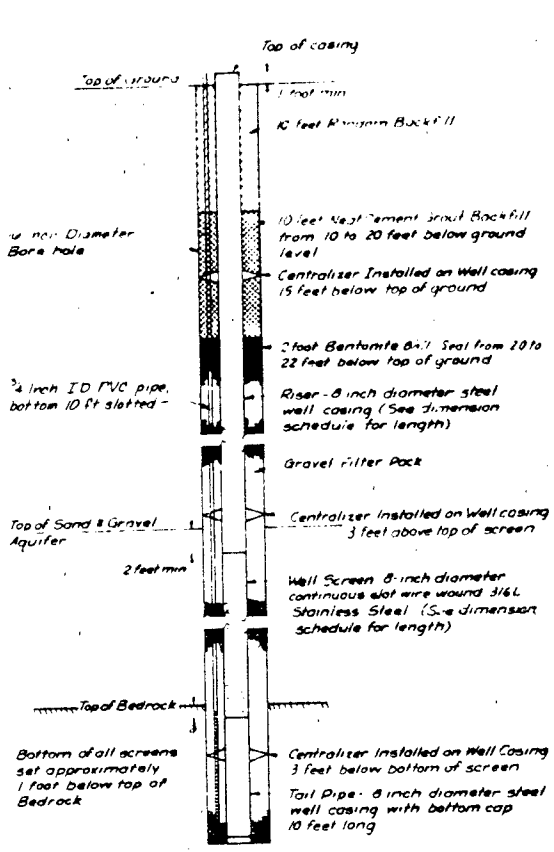

TYPICAL DISCHARGE WELL
NO SCALE

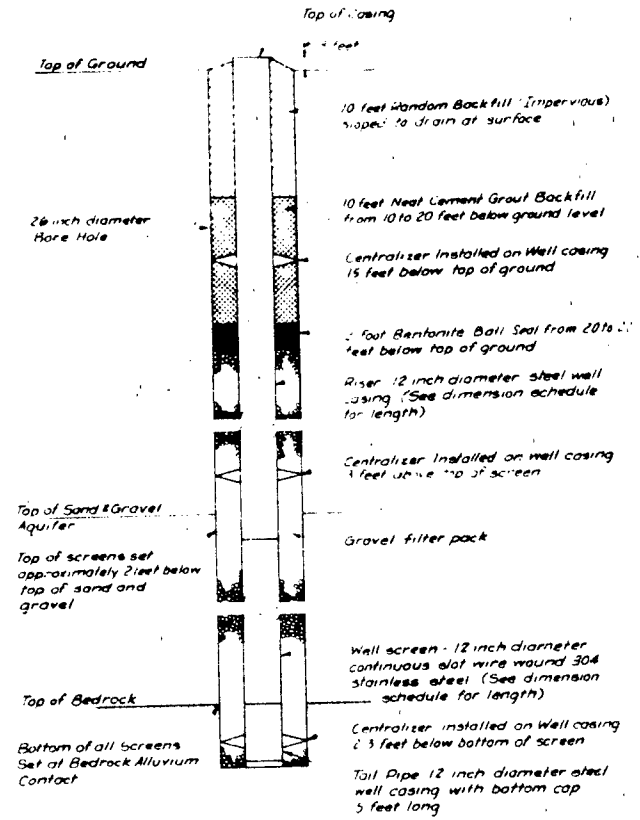

TYPICAL RECHARGE WELL
NO SCALE

Top of C.S. 11
 7 feet

10 feet granular backfill (2 layers) plus
 5 feet of gravel at surface

10 feet Neat Cement Grout Backfill
 from 5 feet to 15 feet below ground level


Centerizer installed on Well casing
 15 feet below top of ground

2 inch Neat Cement Ball Seal from 20 to
 25 feet below top of ground

Rise 2 inch diameter steel well
 casing (See dimension schedule
 for length)

Centerizer installed on Well casing
 1 feet below top of screen

Gravel filter pack

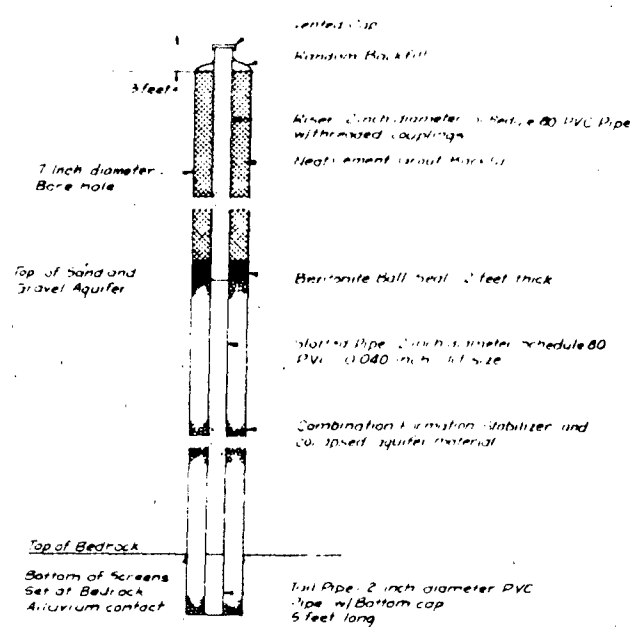

TYPICAL PIEZOMETER
 NO SCALE

We screen 2 inch diameter
 continuous slot wire wound 304
 stainless steel (See dimension
 schedule for length)

Centerizer installed on well casing
 2 feet below bottom of screen

Tail Pipe - 2 inch diameter steel
 well casing with bottom cap
 5 feet long

LARGE WELL
 SEE

WELL NUMBER	STATION	DISCHARGE AND RECHARGE WELL AND PIEZOMETER DIMENSION SCHEDULE		
		DEPTH (FT)	SCREEN LENGTH (FT)	SCREEN DEPTH (FT)
DW-1	2+00	66	18	38.0-56.0
DW-2	3+00	65	21	32.0-55.0
DW-3	4+00	67	18	39.0-57.0
DW-4	5+00	69	17	42.0-59.0
DW-5	6+00	66	16	40.0-56.0
DW-6	7+00	54	17	37.0-54.0
DW-7	8+00	64	17	37.0-54.0
DW-8	9+00	64	18	36.0-54.0
DW-9	10+00	62	15	37.0-52.0
DW-10	11+00	60	8	42.0-50.0
DW-11	12+00	59	5	44.0-49.0
DW-12	14+00	56	5	41.0-46.0
DW-13	16+50	50	8	32.0-40.0
DW-14	19+00	58	7	41.0-48.0
DW-15	21+50	59	7	42.0-49.0
RW-1	2+00	59	21	33.0-54.0
RW-2	2+80	58	21	32.0-53.0
RW-3	3+60	57	21	30.0-51.0
RW-4	4+40	54	20	29.0-49.0
RW-5	5+20	55	20	30.0-50.0
RW-6	6+00	55.6	20	30.0-50.6
RW-7	6+80	57	19	33.0-52.0
RW-8	7+60	55	18	32.0-50.0
RW-9	8+40	49	15	29.0-44.0
RW-10	9+20	50	13	32.0-45.0
RW-11	10+00	48	11	32.0-43.0
RW-12	10+80	48	8	35.0-43.0
RW-13	11+60	49	10	34.0-44.0
RW-14	12+40	50	12	32.5-44.5
RW-15	13+40	53	5.5	42.5-48.0
RW-16	15+40	50	8	37.0-45.0
RW-17	16+90	52	10	35.0-45.0
RW-18	18+40	49	8	38.0-46.0
RW-19	19+90	54	9	35.0-44.0
RW-20	21+40	54	9	42.0-49.0
RW-21	22+90	54	6	43.0-49.0
P-1	2+50	61	20	35.5-55.5
P-2	5+50	64	19	38.0-58.0
P-3	8+50	59.5	21	33.5-54.5
P-4	11+50	54	8	41.0-49.0
P-5	11+50	54	8	41.0-49.0
P-6	15+25	50	8	37.0-45.0
P-7	15+25	50	8	37.0-45.0
P-8	20+25	55	9	41.0-50.0
P-9	20+25	55	9	41.0-50.0
P-10	24+00	40	5	30.0-35.0
P-11	24+00	40	5	30.0-35.0
P-12	5+60	57	21	33.0-54.0
P-13	8+80	56	16	35.0-51.0
P-14	12+00	51	12	34.0-46.0
P-15	14+65	42	10	32.0-42.0
P-16	22+15	56	9	42.0-50.0
ZZ-13	17+50	49	10	34.0-44.0


NOTES:


- Well and Piezometer designs are based on existing subsurface data. Screen placements for all wells and piezometers shall be based on conditions observed at each well site during construction.
- See Plates 12 through 16 for location of Discharge Wells, Recharge Wells and Piezometers.

THIS DRAWING HAS BEEN REVISED TO
 THREE EIGHTS THE ORIGINAL SCALE

2

DATE	REVISION	BY	APP'D
REG. NO.			
U. S. ARMY ENGINEER DISTRICT, OMAHA			
CORPS OF ENGINEERS			
OMAHA, NEBRASKA			
DESIGNED BY: J.P.P.	ROCKY MOUNTAIN ARSENAL, COMMERCE CITY, COLORADO		
DRAWN BY: J.L.P.	NORTHWEST BOUNDARY CONTAINMENT		
ENGINEER BY: J.P.P.	WELL AND PIEZOMETER		
CHECKED BY:	DETAILS		
SCALE:	FY 84MCA PH 30.2		
PROJECT:	PHASE		
DATE:	DRAWN BY: J.L.P.		
BY:	CHECKED BY: J.P.P.		
DATE:	PROJECT NO. 84MCA01		
BY:	F 841-40-01		

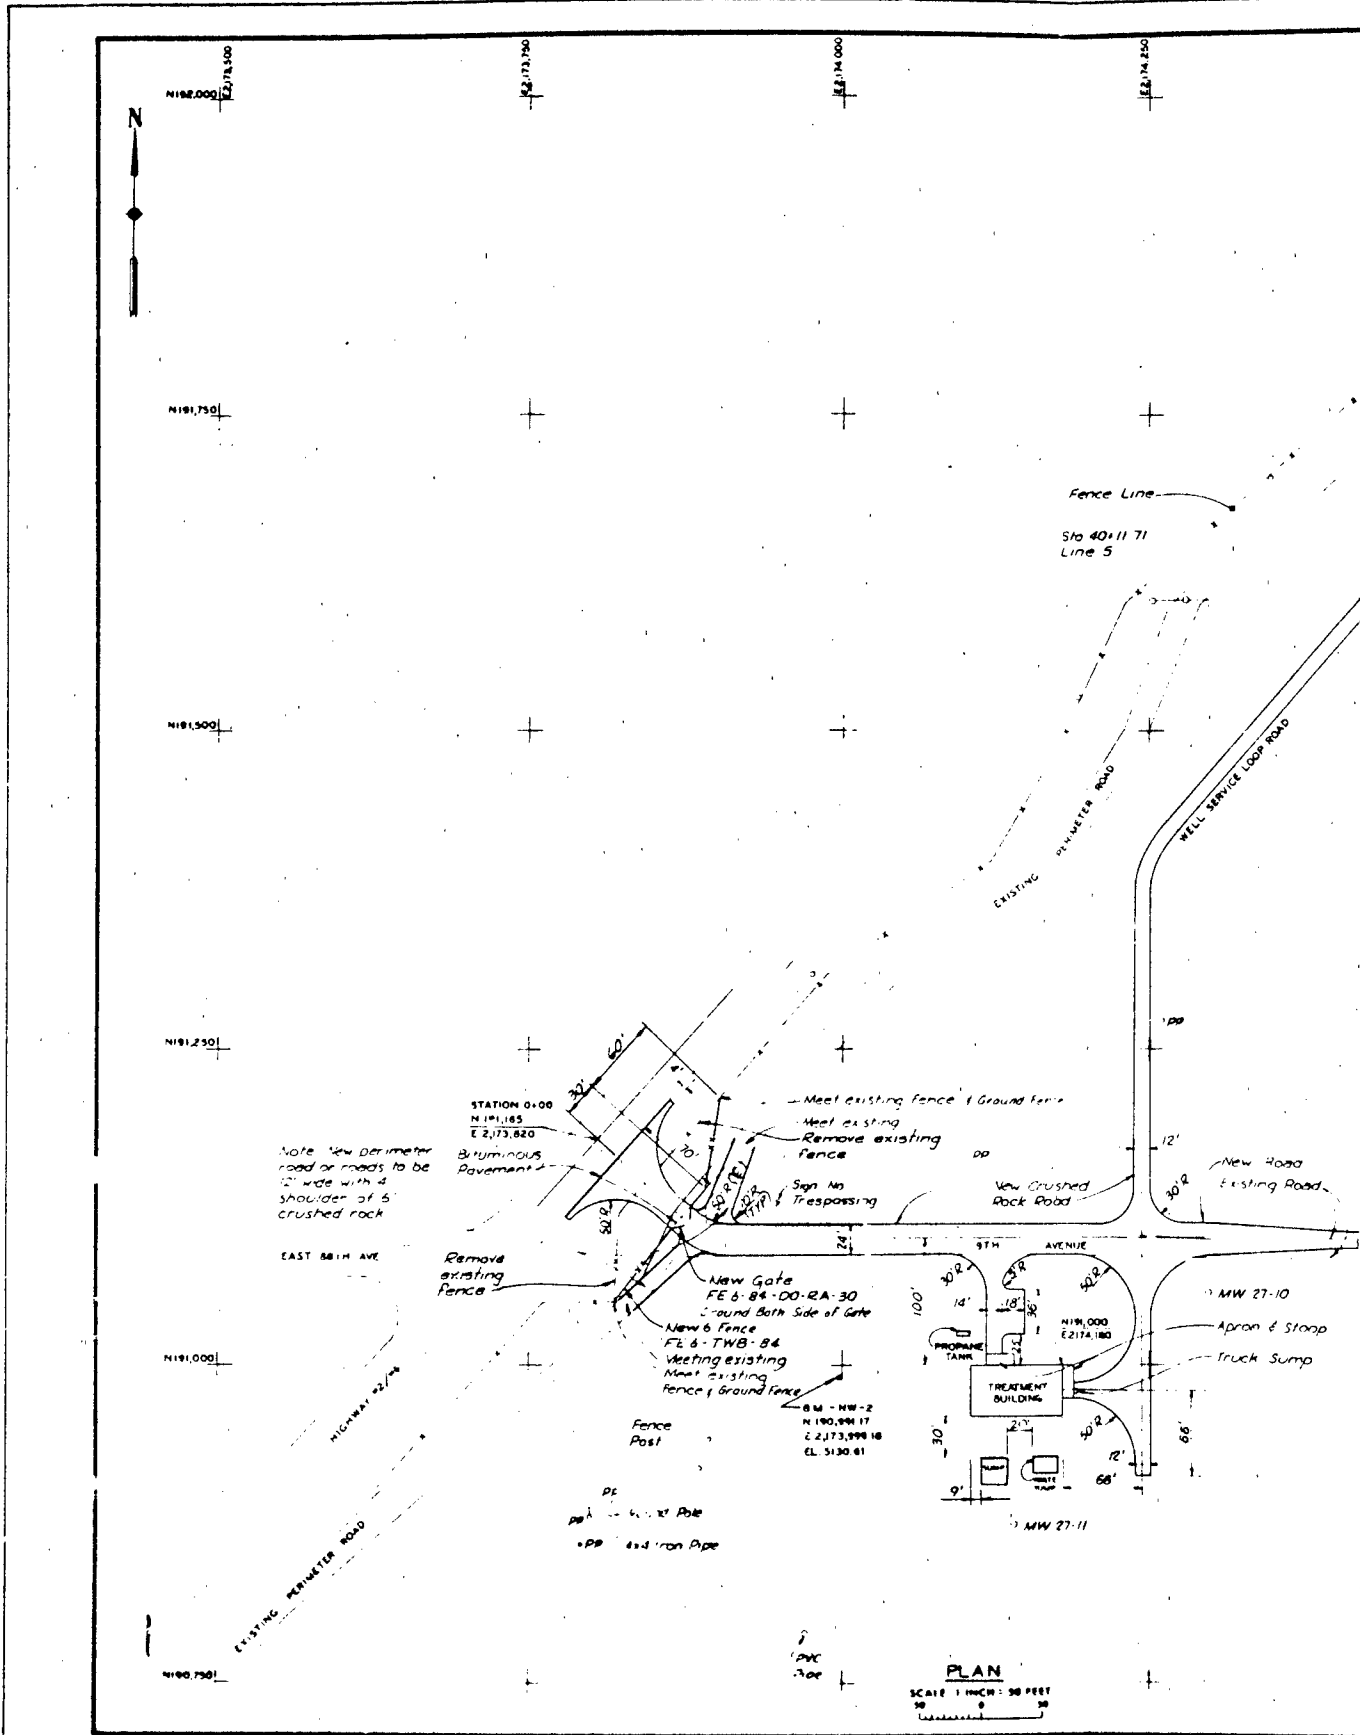

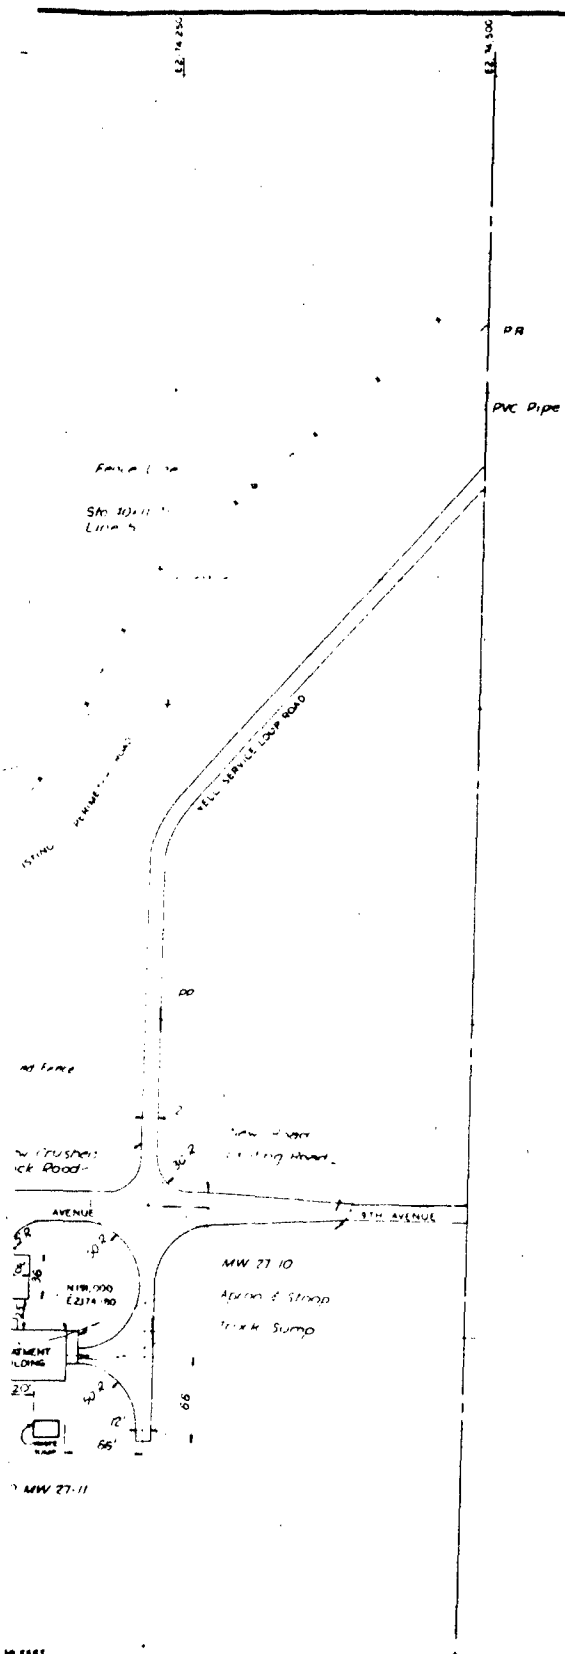


NOTE:
 1. All ground areas disturbed by grading and/or trenching and not otherwise surfaced shall be seeded.

THIS DRAWING HAS BEEN REFERRED TO
 THESE COORDINATES THE ORIGINAL SCALE

2

NO.	DESCRIPTION	DATE	BY	APPROVED
REVISIONS				
U. S. ARMY ENGINEER DISTRICT, OMAHA CORPS OF ENGINEERS OMAHA, NEBRASKA				
PROJECT NO.	ROCKY MOUNTAIN ARSENAL	COMMERCE CITY, COLORADO		
NORTHWEST BOUNDARY CONTAINMENT SITE PLAN				
DATE	FY 81 MCA PH 367			
DESIGNED BY	ENGINEER	DATE		
CHECKED BY	DATE	SCALE		
APPROVED BY	DATE	SCALE		
FR 41-40-01				


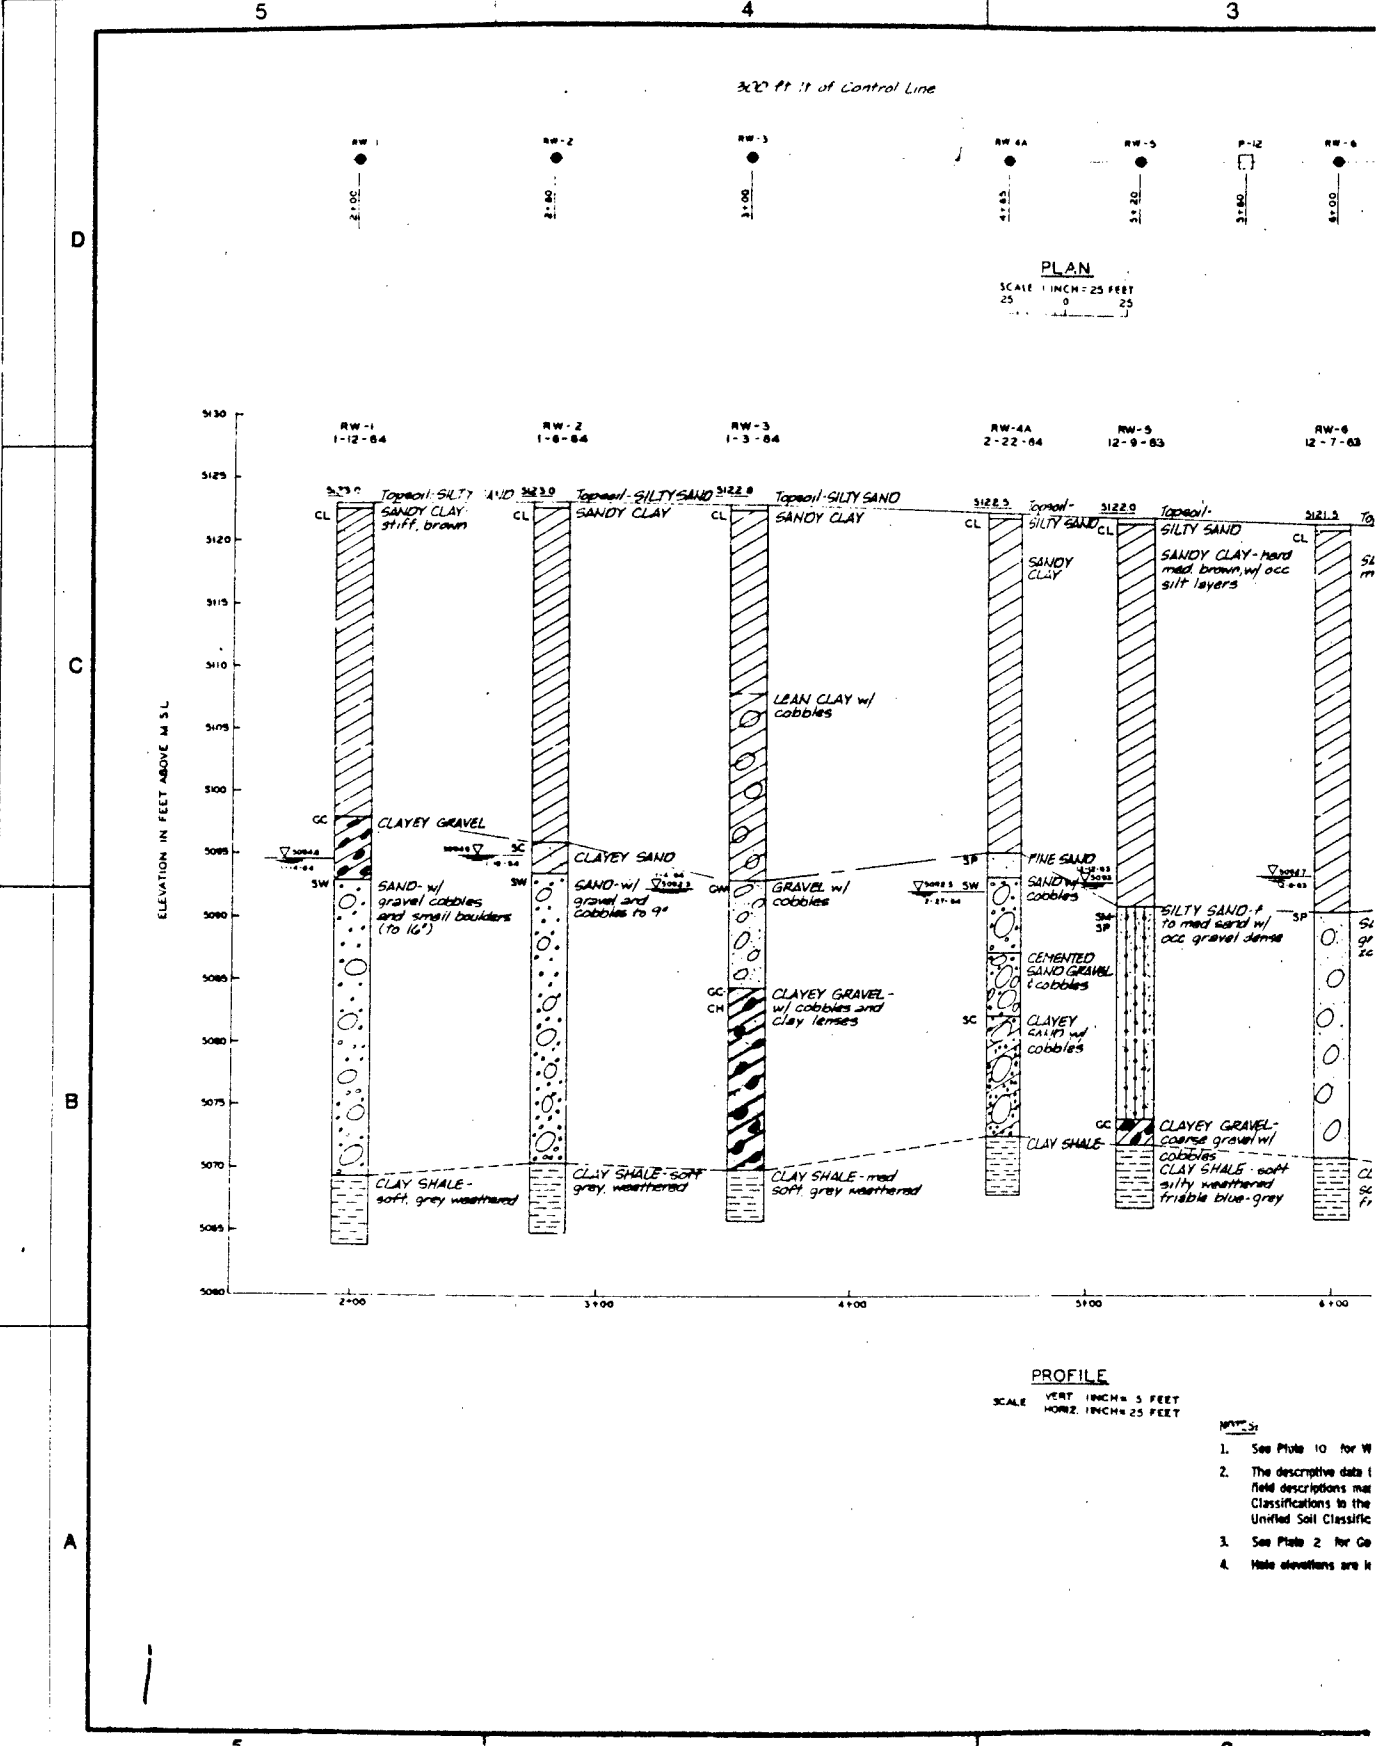


PLAN
SCALE 1 INCH = 25 FEET

PROFILE

VERT. 1 INCH = 5 FEET
HORIZ. 1 INCH = 25 FEET

- NOTES:**
1. See Photo 10 for W
 2. The descriptive data & field descriptions are classified in the Unified Soil Classification
 3. See Plate 2 for G
 4. Hole elevations are in

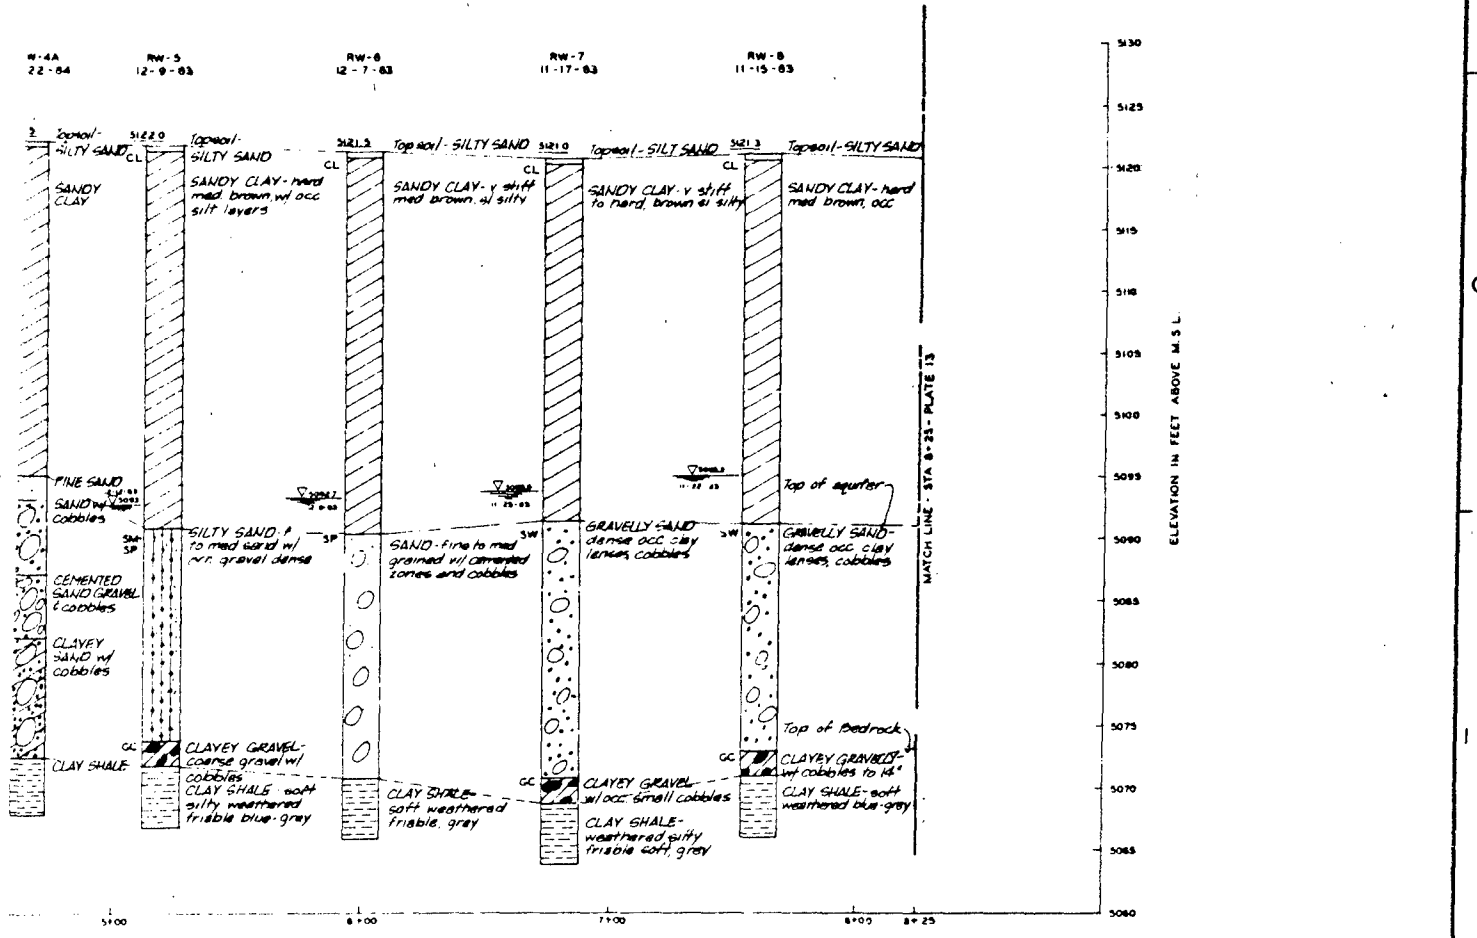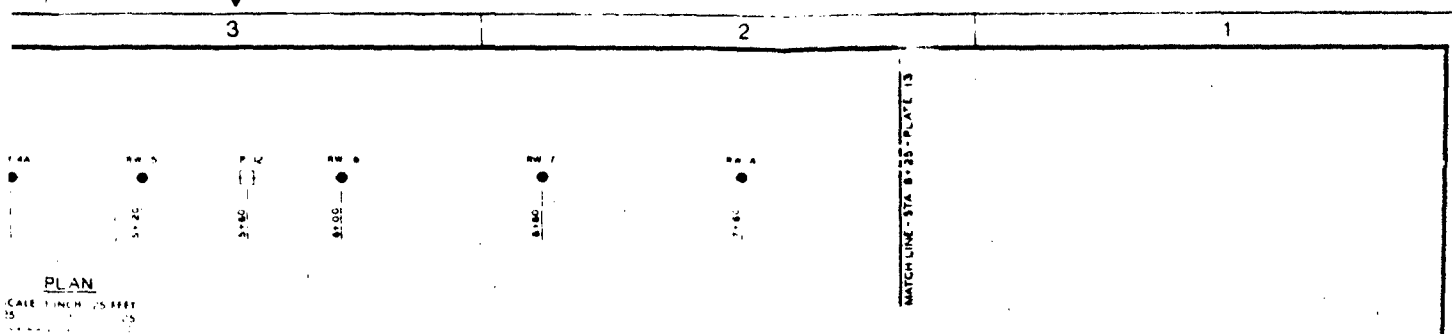

- NOTES:**
1. See Plate 10 for Well and Piezometer Dimension Schedule.
 2. The descriptive data to the right of the logs are the results of field descriptions made by the driller at the time of drilling. Classifications to the left of the logs are in accordance with the Unified Soil Classification System TMS-357, May 1967.
 3. See Plate 2 for Geotechnical Legend and Notes.
 4. Hole elevations are interpolated.

\$\$ — THINK VALUE ENGINEERING — \$\$

Symbol	Description	Date	Approved



U.S. ARMY ENGINEER DISTRICT
CORPS OF ENGINEERS
OMAHA, NEBRASKA

Designed by: L.M.H.
Checked by: M.R.A.
Reviewed by: L.M.H.



**NORTHWEST BOUNDARY CONTAINMENT
PLAN AND PROFILE OF
RECHARGE LINE
LOG OF WELLS RW-4A TO RW-8**

FY 80 SOLA PR 26.2
F 8-41-40-01



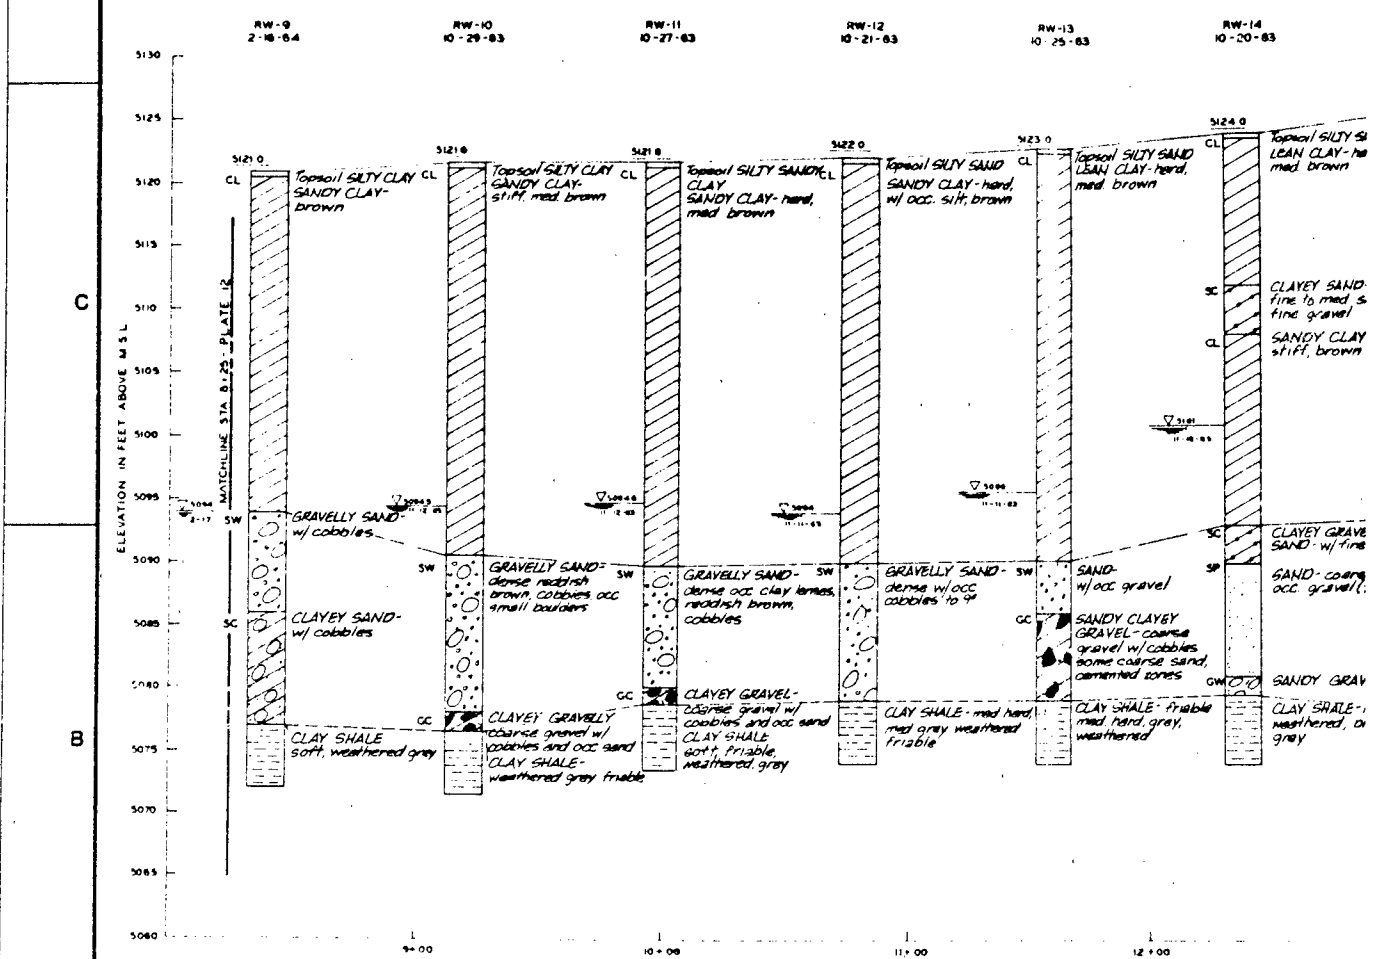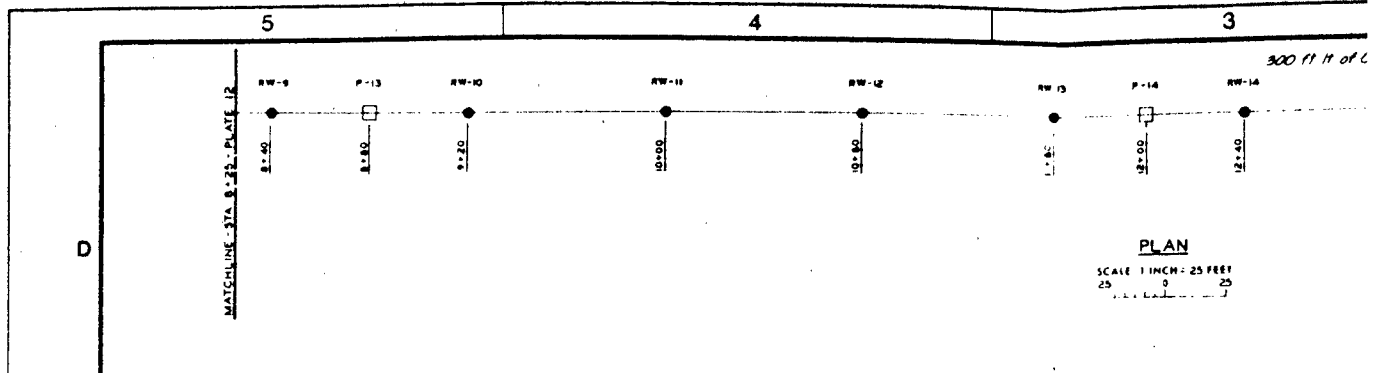

- NOTES**
1. S
 2. T
 3. C
 4. T

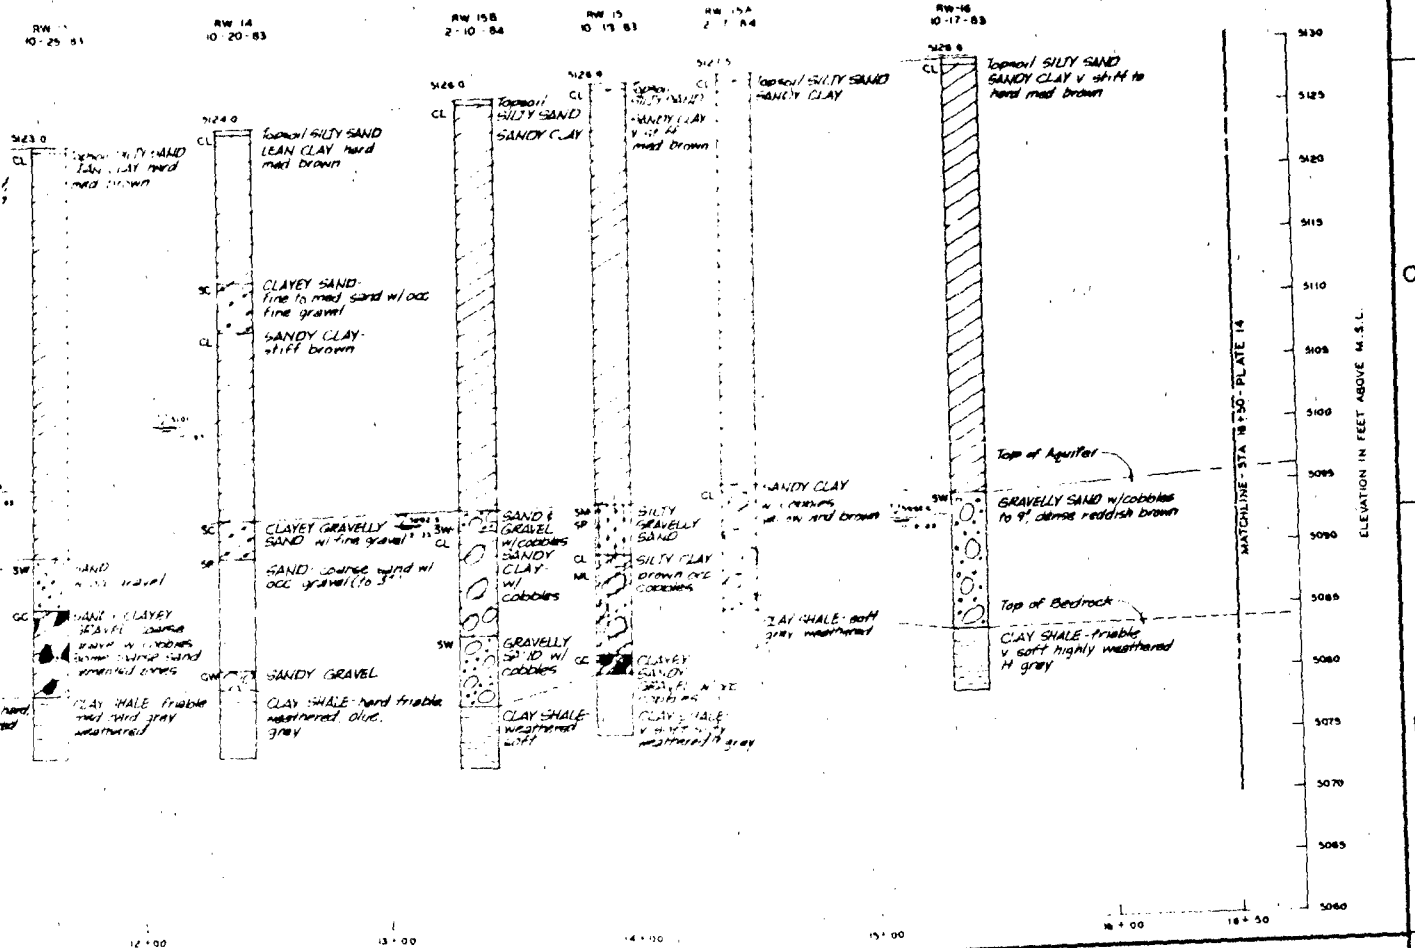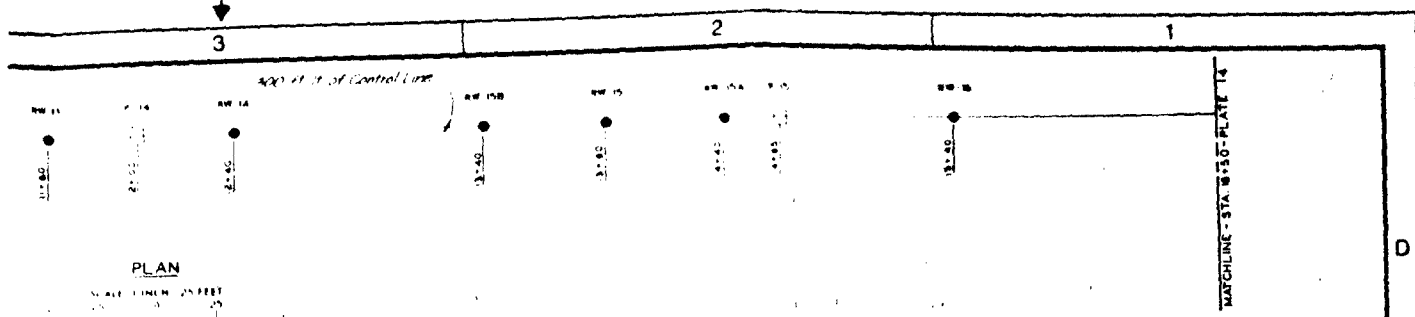

PROFILE
 VERT. INCH = 5 FEET
 SCALE
 HORIZ. INCH = 25 FEET

- NOTES:**
1. See Plate 13 for Well and Piezometer Dimension Schedule
 2. The descriptive data to the right of the logs are the results of field descriptions made by the driller at the time of drilling. Classifications to the left of the logs are in accordance with the Unified Soil Classification System (ASTM 577 - May 1967)
 3. See Plate 2 for Geotechnical Legend and Notes
 4. Hole elevations are interpolated

SS - THINK VALUE ENGINEERING - SS

Number	Description	Date	Appropriat



U.S. ARMY ENGINEER DISTRICT
 CORPS OF ENGINEERS
 CHARLOTTE, NORTH CAROLINA

Designed by: _____
 Drawn by: _____
 Checked by: _____
 Date: _____

**NORTHWEST BOUNDARY CONTAINMENT
 PLAN AND PROFILE OF
 RECHARGE LINE
 LOG OF WELLS RW-9 THRU RW-16**


F 54 400



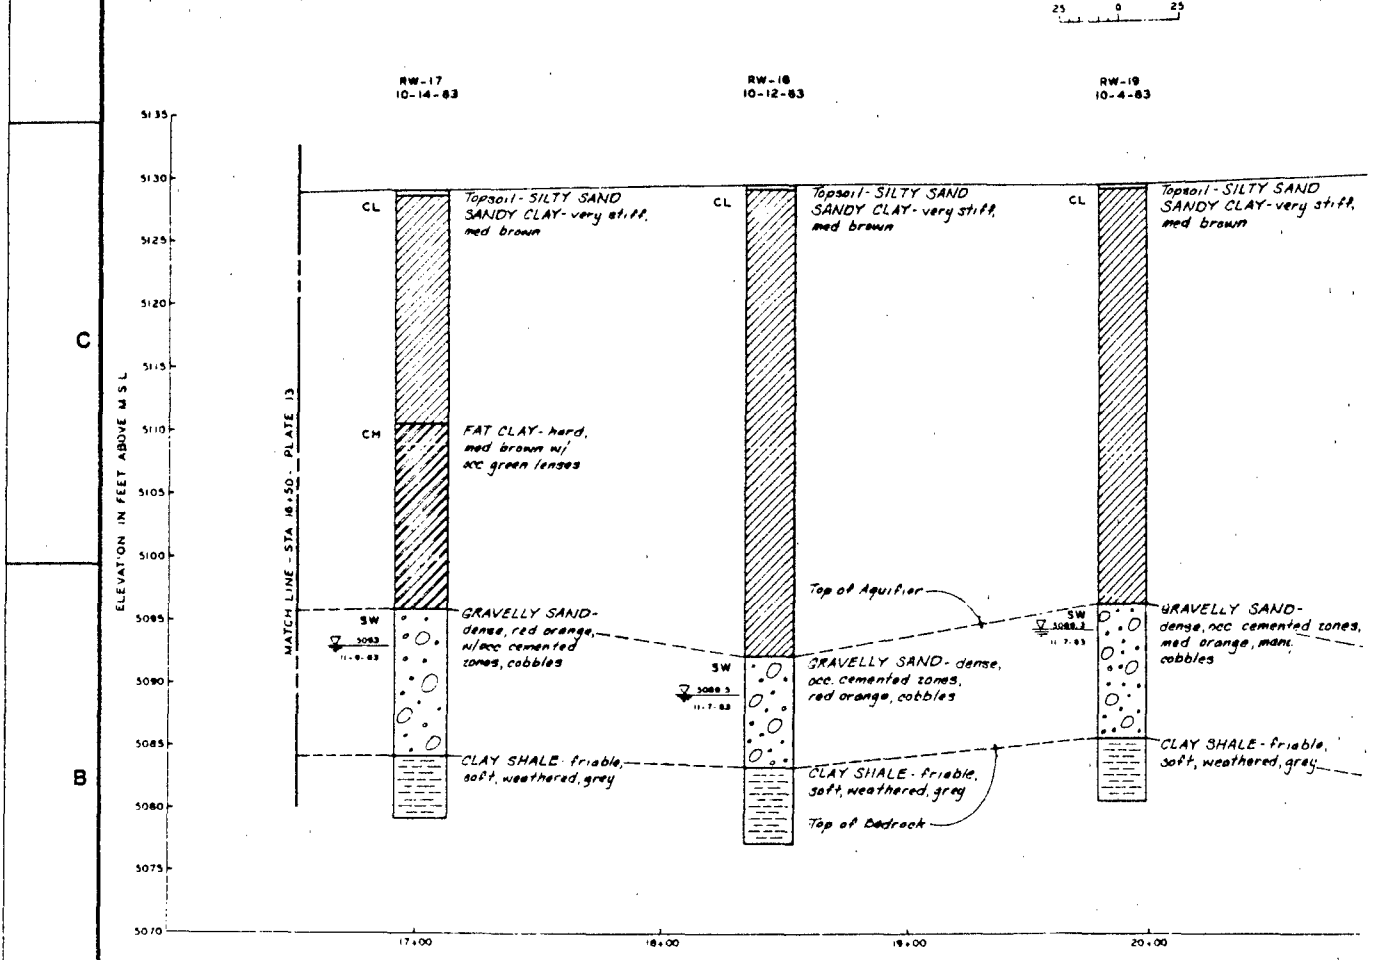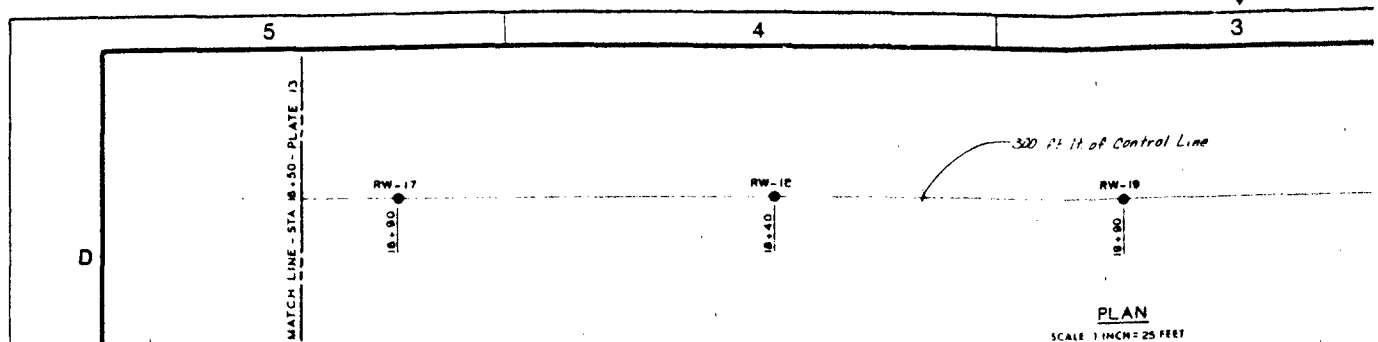


PROFILE
SCALE VERT 1 INCH = 5 FEET
HORIZ 1 INCH = 25 FEET

320 24 10 10 10 10

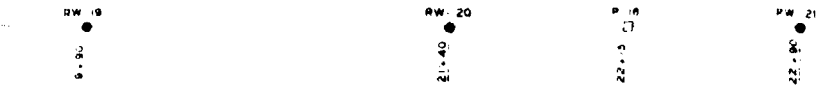

PLAN
SCALE 1 INCH = 25 FEET

RW-19 10-4-63 RW-20 08-30-63 RW-21 10-08-63

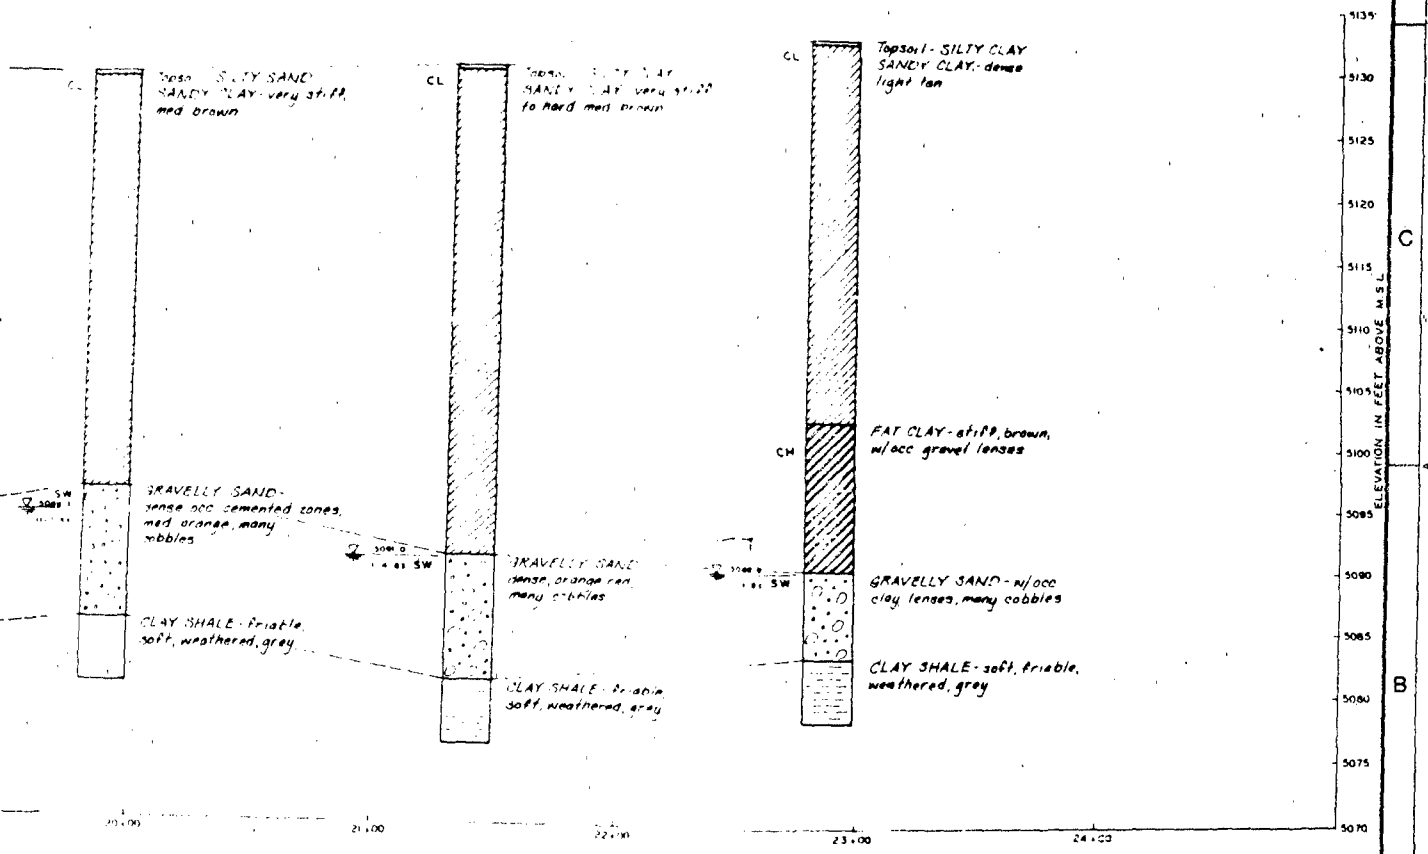


PROFILE
VERT. 1 INCH = 5 FEET
HORIZ. 1 INCH = 25 FEET


- NOTES:
1. See Plate 10 for Well and Piezometer Dimension Schedule
 2. The descriptive data to the right of the logs are the results of field descriptions made by the driller at the time of drilling. Classifications to the left of the logs are in accordance with the United Soil Classification System (M.S. 1957, May 1967)
 3. See Plate 2 for Geotechnical Legend and Notes
 4. Hole elevations are interrelated

SS — THINK VALUE ENGINEERING — SS

Approvals			
Signature	Description	Date	Requirement
U.S. ARMY ENGINEER DISTRICT CORPS OF ENGINEERS DENVER, COLORADO			
Designed by	NORTHWEST BOUNDARY CONTAINMENT		
Drawn by	PLAN AND PROFILE OF		
Checked by	RECHARGE LINE		
	LOG OF WELLS - RW-17 THRU RW-21		

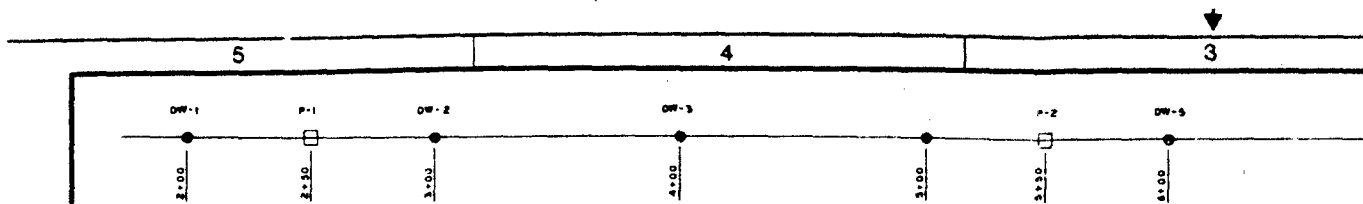


PLAN
SCALE 1 INCH = 25 FEET

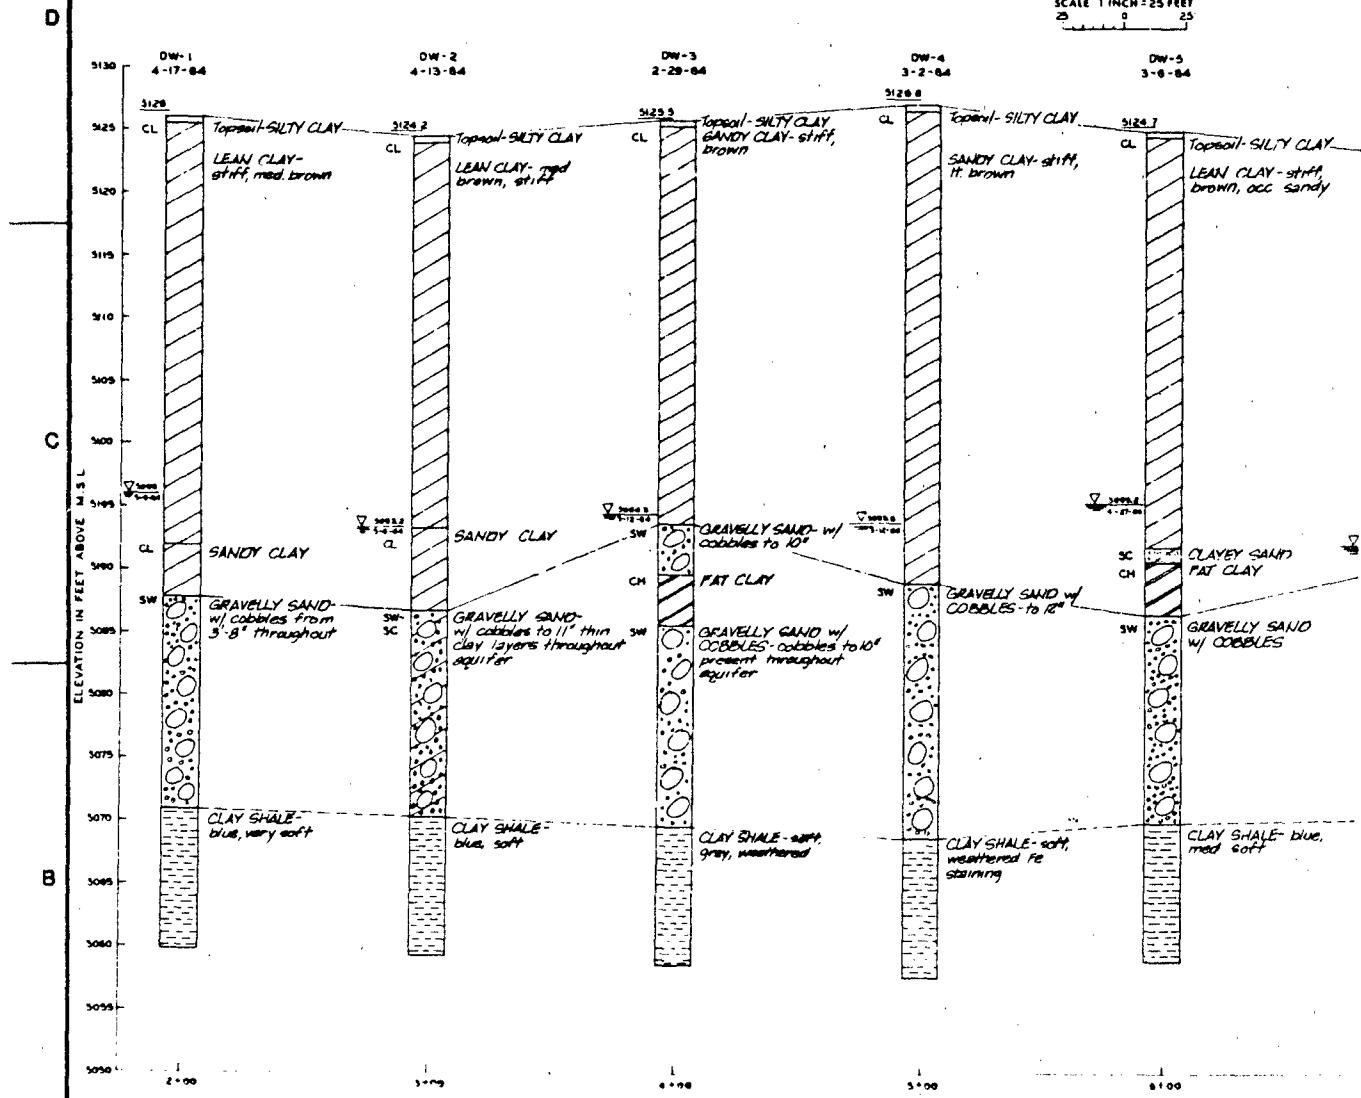


PROFILE
SCALE VERT 1 INCH = 5 FEET
HORIZ 1 INCH = 25 FEET

- NOTES**
1. See P
 2. See P
 3. See P
 4. See P

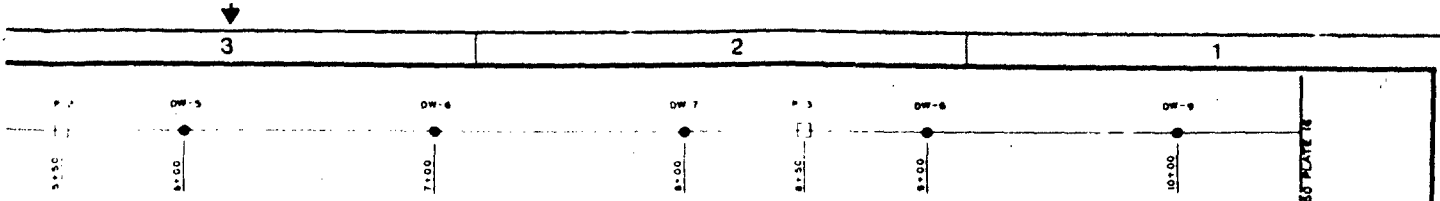

PLAN
SCALE 1 INCH = 25 FEET

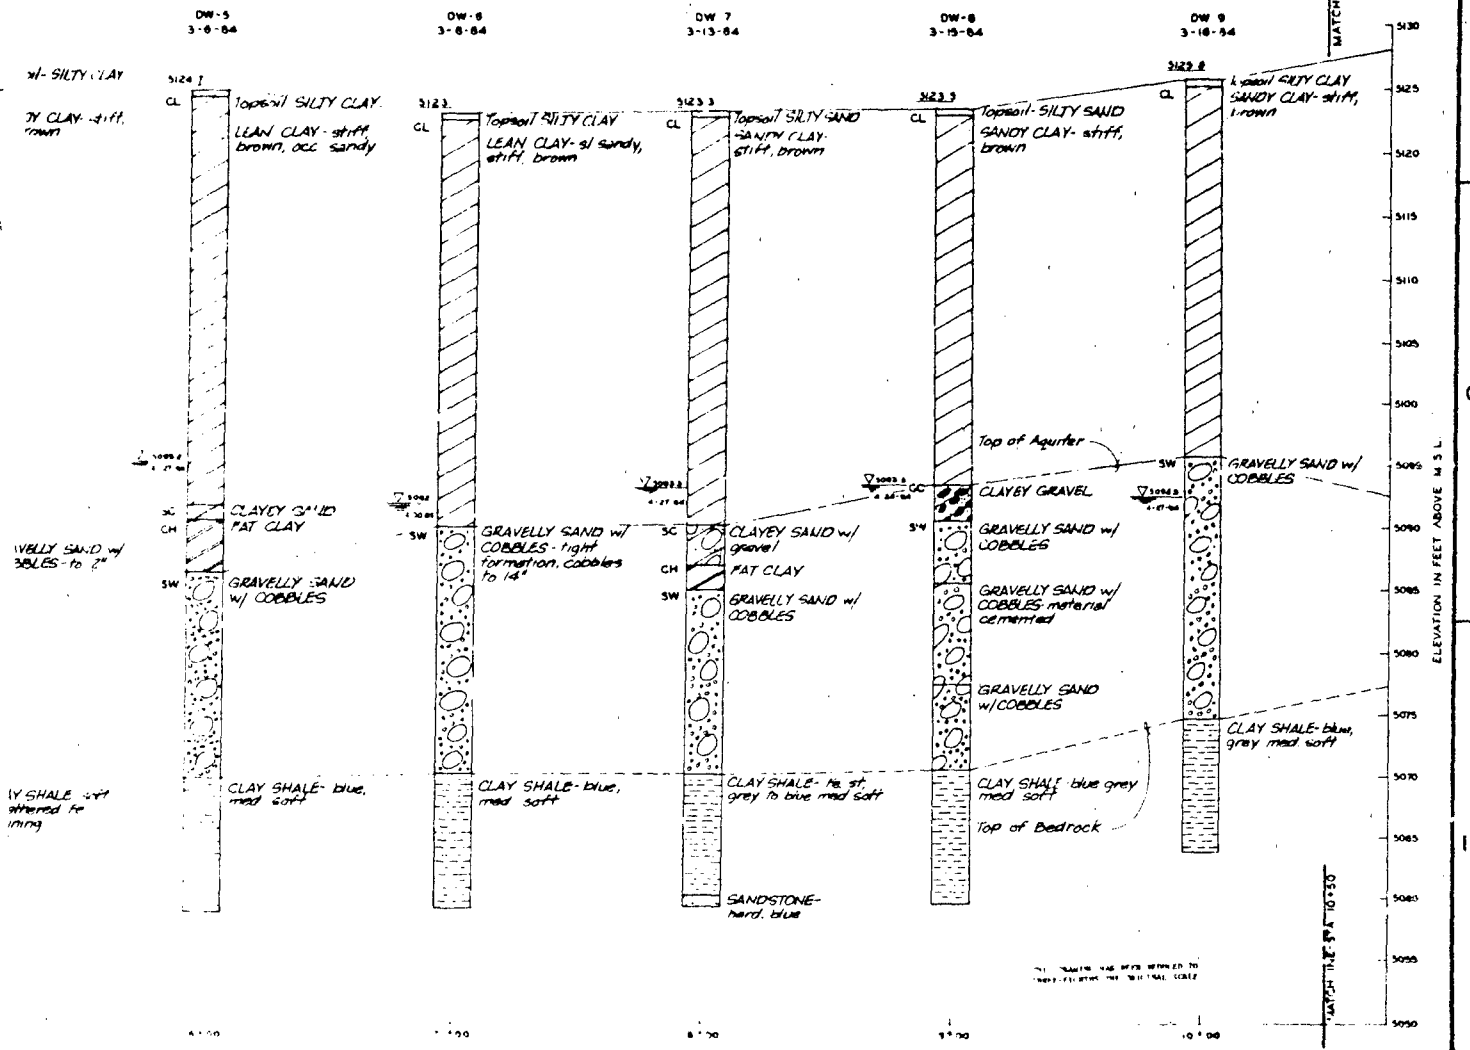

PROFILE
SCALE 1 INCH = 25 FEET

- NOTES**
- See Plan 10 for Soil and Parameter Descriptions Schedule
 - The soil types shown to the right of the logs are the results of field classifications made in the order of the logs of borings. Specifications to the soil of the logs are in accordance with the Unified Soil Classification System (ASTM D 1586).
 - See Plan 2 for Construction Layout and Notes.
 - See conditions on attachment.



SS - THINK VALUE ENGINEERING - SS

Item	Description	Date	Author


J. S. THINK VALUE ENGINEERING
CORPORATION

1000 NORTHWEST BOLLINGER AVENUE
SUITE 100
DENVER, COLORADO 80202
TEL: 303.733.8800
WWW.THINKVALUEENGINEERING.COM



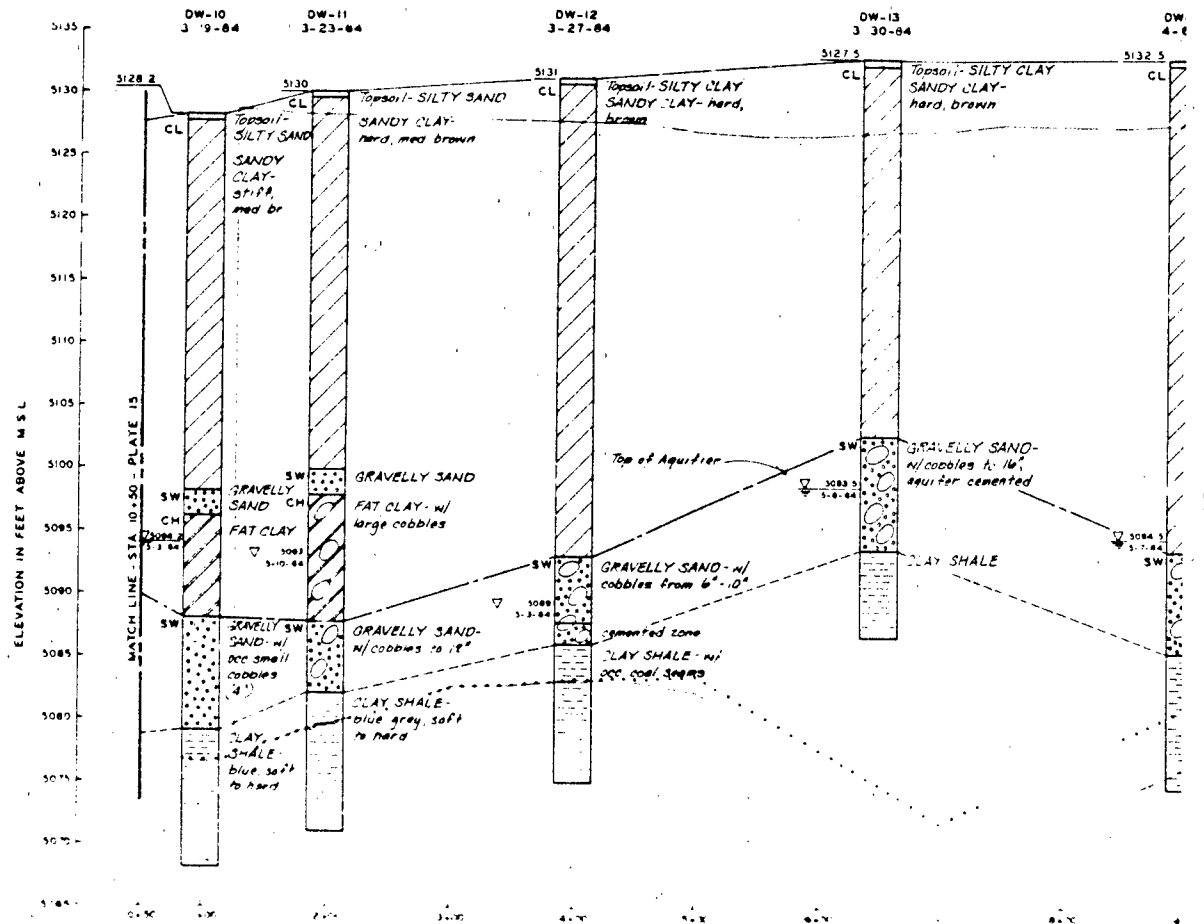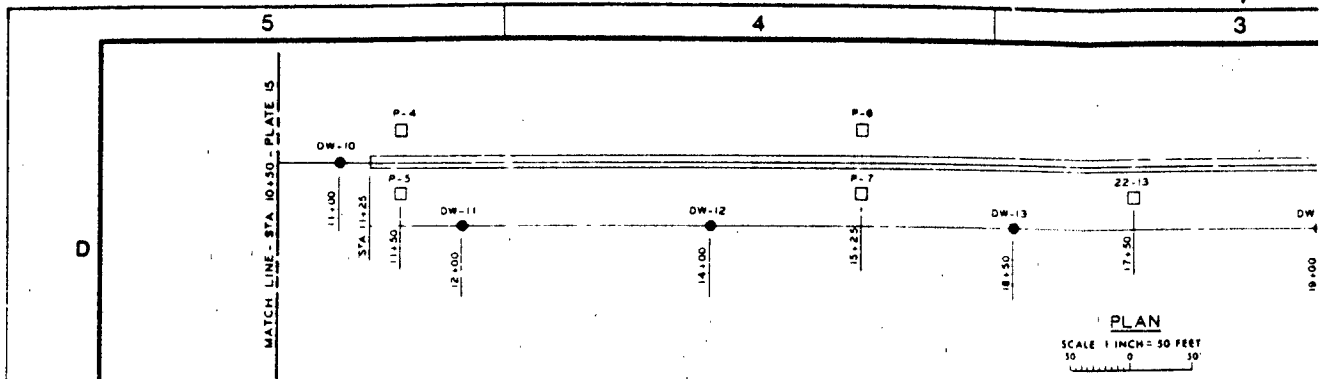

DO NOT SCALE

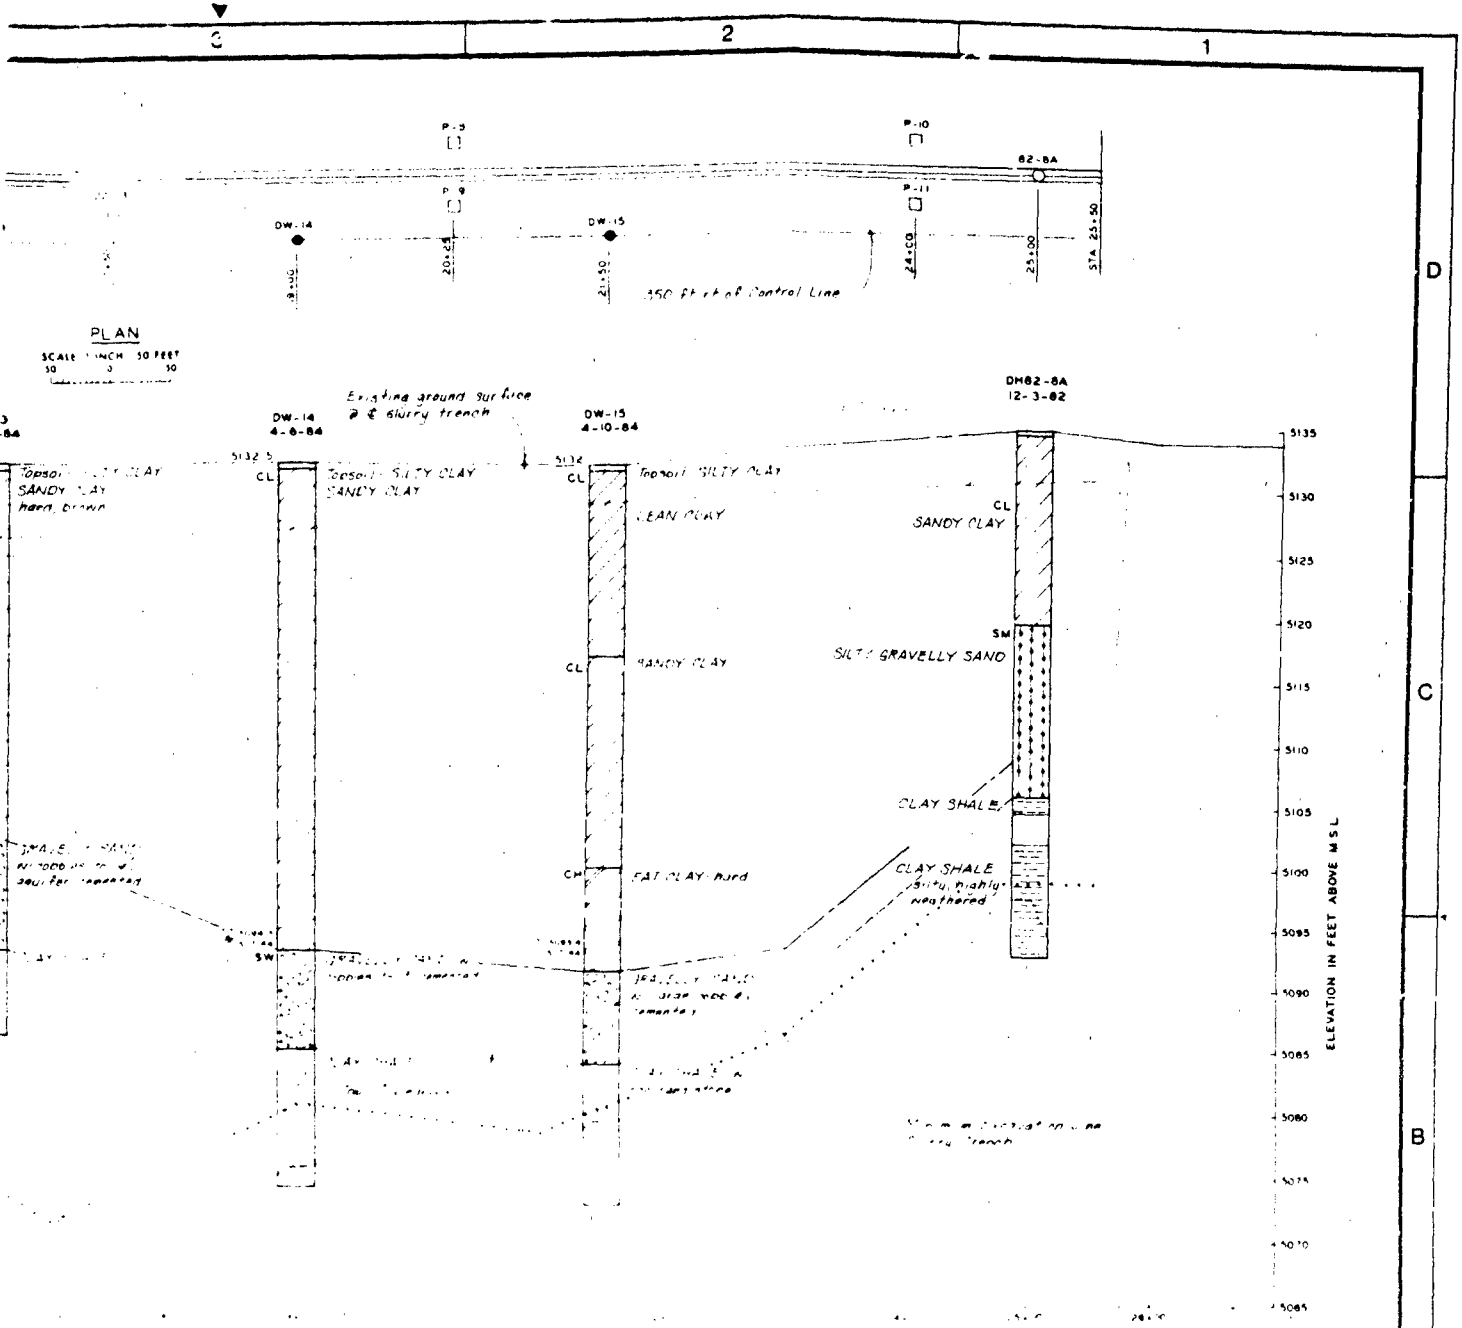

SS - TRIME VALUE ENGINEERING - SS


Number	Description	Date	Approved



U.S. ARMY ENGINEER DISTRICT
CORPS OF ENGINEERS
FORT MONMOUTH

600 1/2 WEST 10TH STREET, COVINGTON CITY, COLORADO


**NORTHWEST BOUNDARY CONTAINMENT
PLAN AND PROFILE OF
DISCHARGE LINE/SLURRY WALL
OF WELLS DW-0 THRU DW-15**



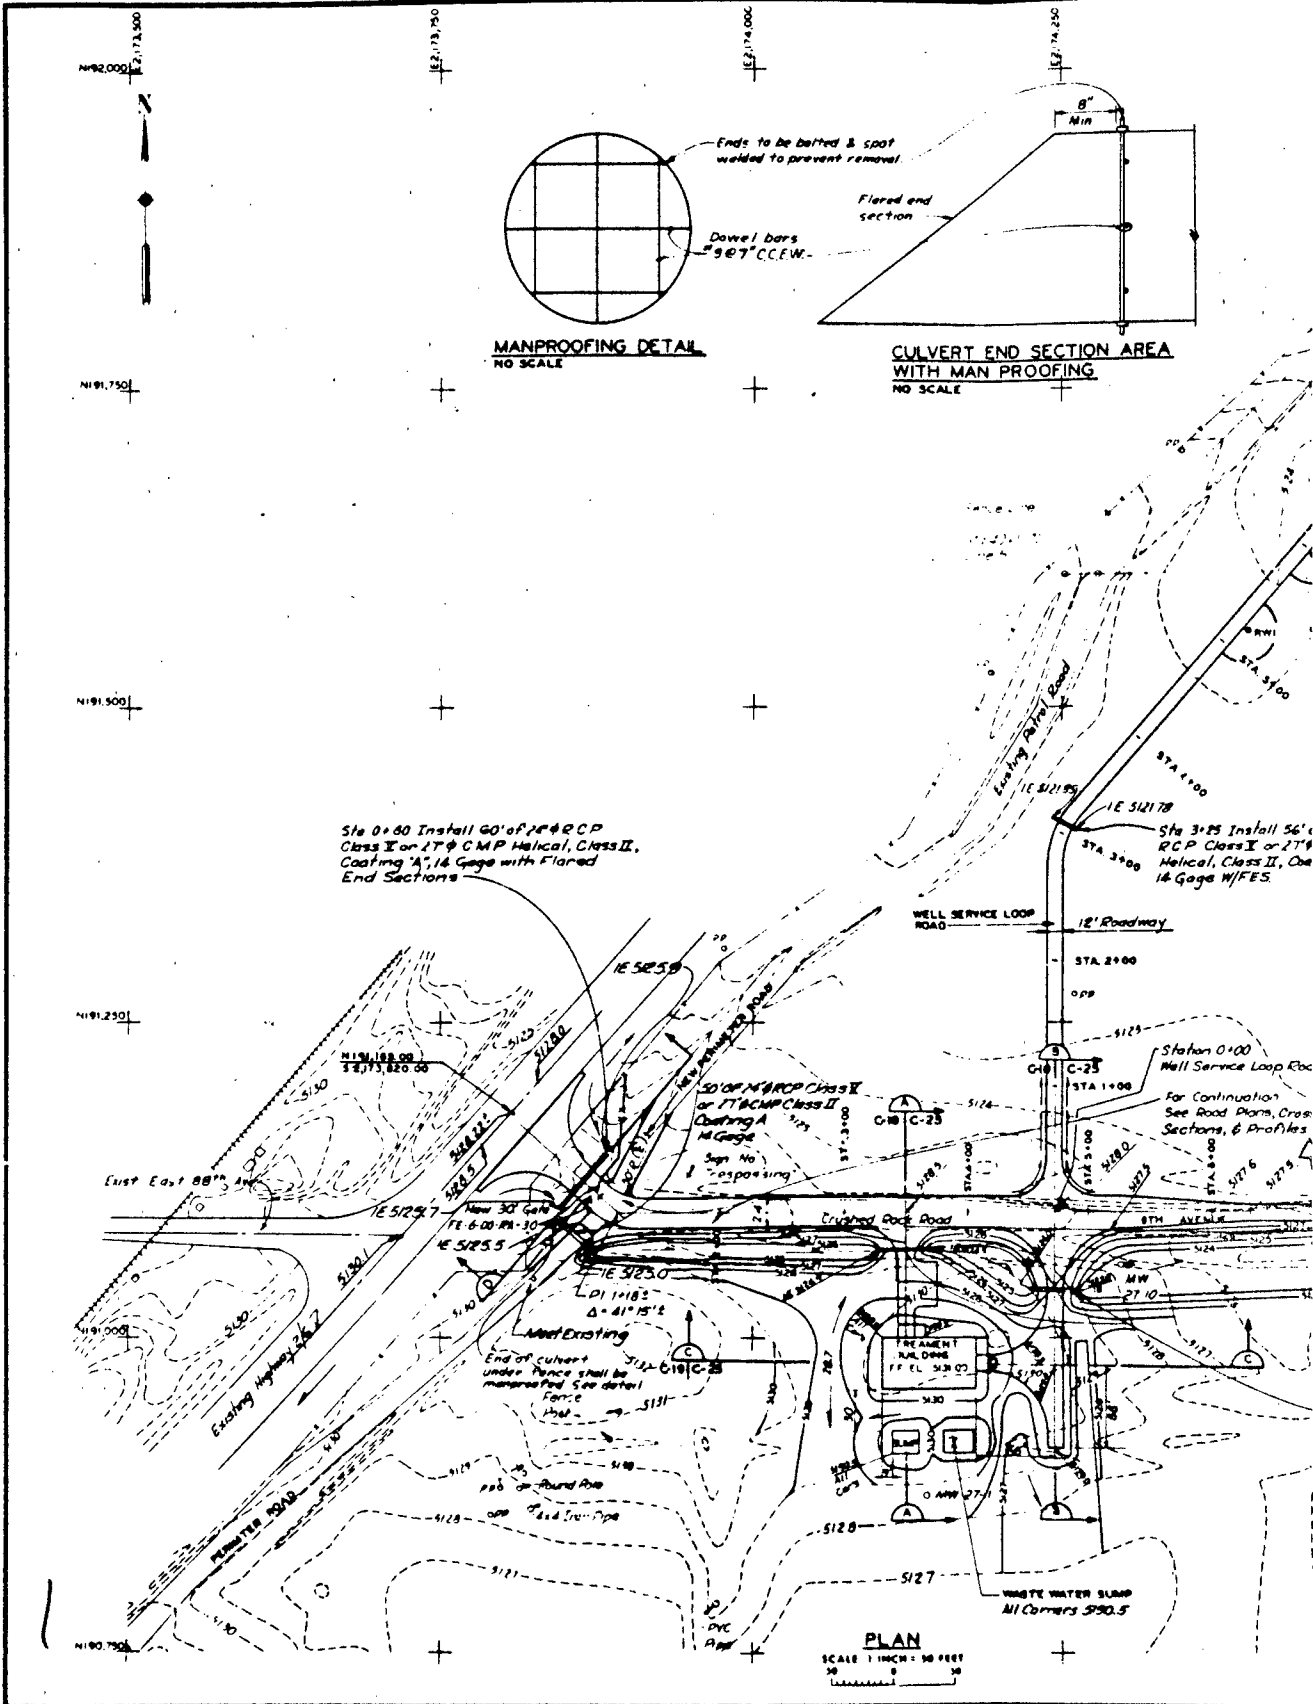


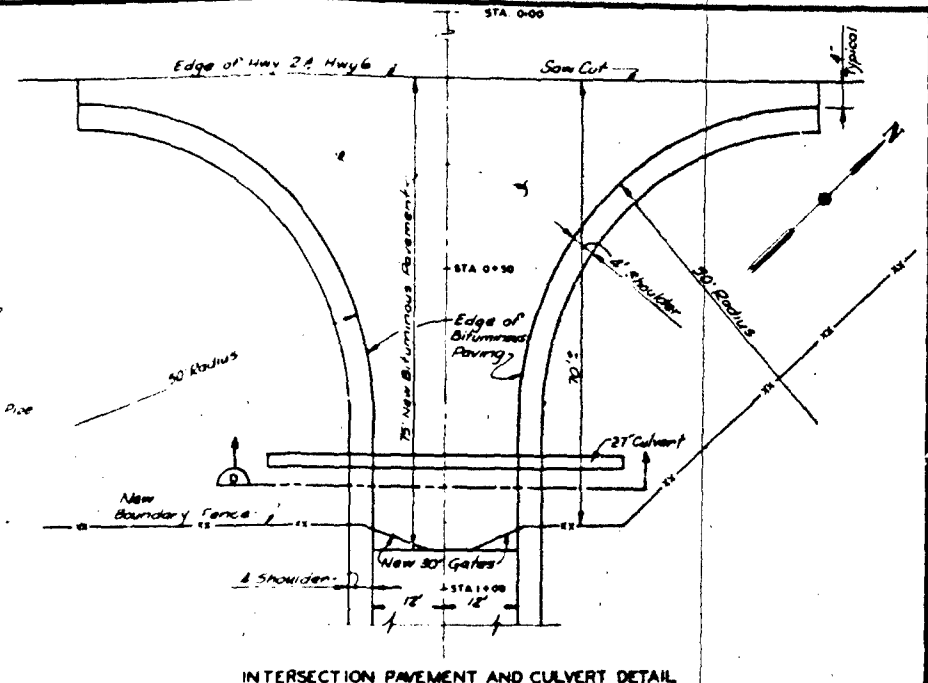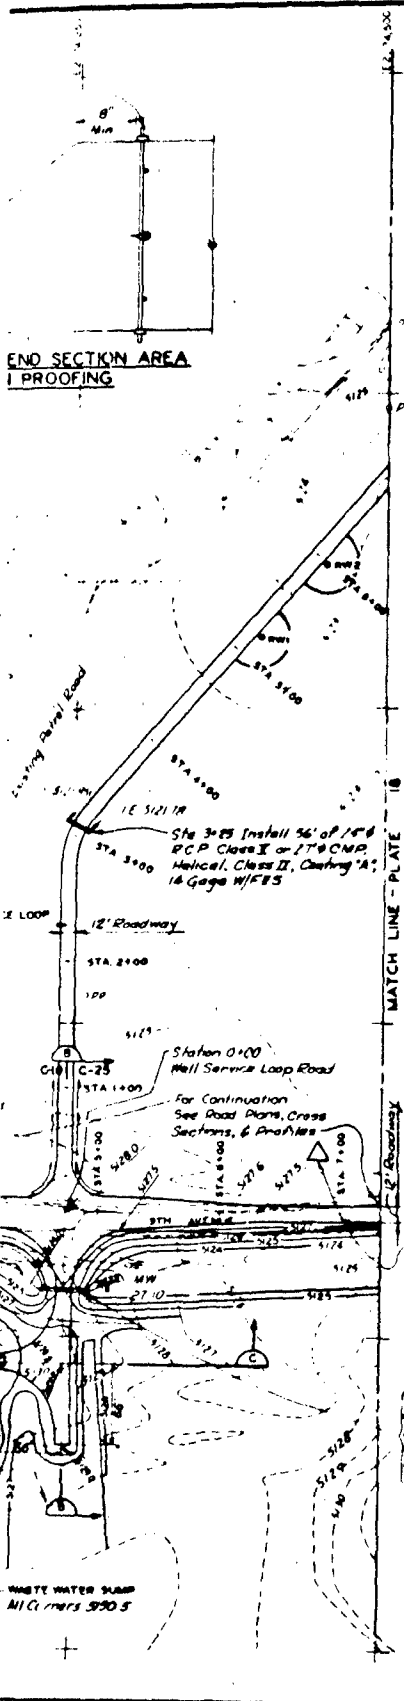

INTERSECTION PAVEMENT AND CULVERT DETAIL
SCALE 1 INCH = 10 FEET

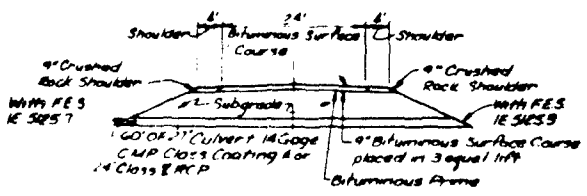


HIGHWAY ROAD INTERSECTION SECTION THRU CULVERT (D)
SCALE 1 INCH = 10 FEET

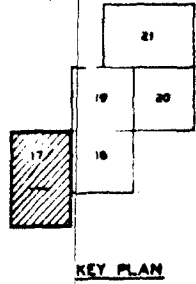


- NOTES:
1. All CMP shall have 2 2 1/2 inch by 1/2 inch corrugations and be Class II Metal with coating A in accordance with Federal Specification WWP 489
 2. All culverts shall have Flared-End Sections.

NO.	REVISIONS	DATE	BY	CHKD
REVISIONS U. S. ARMY ENGINEER DISTRICT DENVER GROUP OF DISTRICTS DENVER, COLORADO ROCKY MOUNTAIN ARSENAL, COMMERCE CITY, COLORADO NORTHWEST BOUNDARY CONTAINMENT GRADING PLAN BY N.M.A. PH 348 DATE 25 APR 68 F 641-40-01				


2

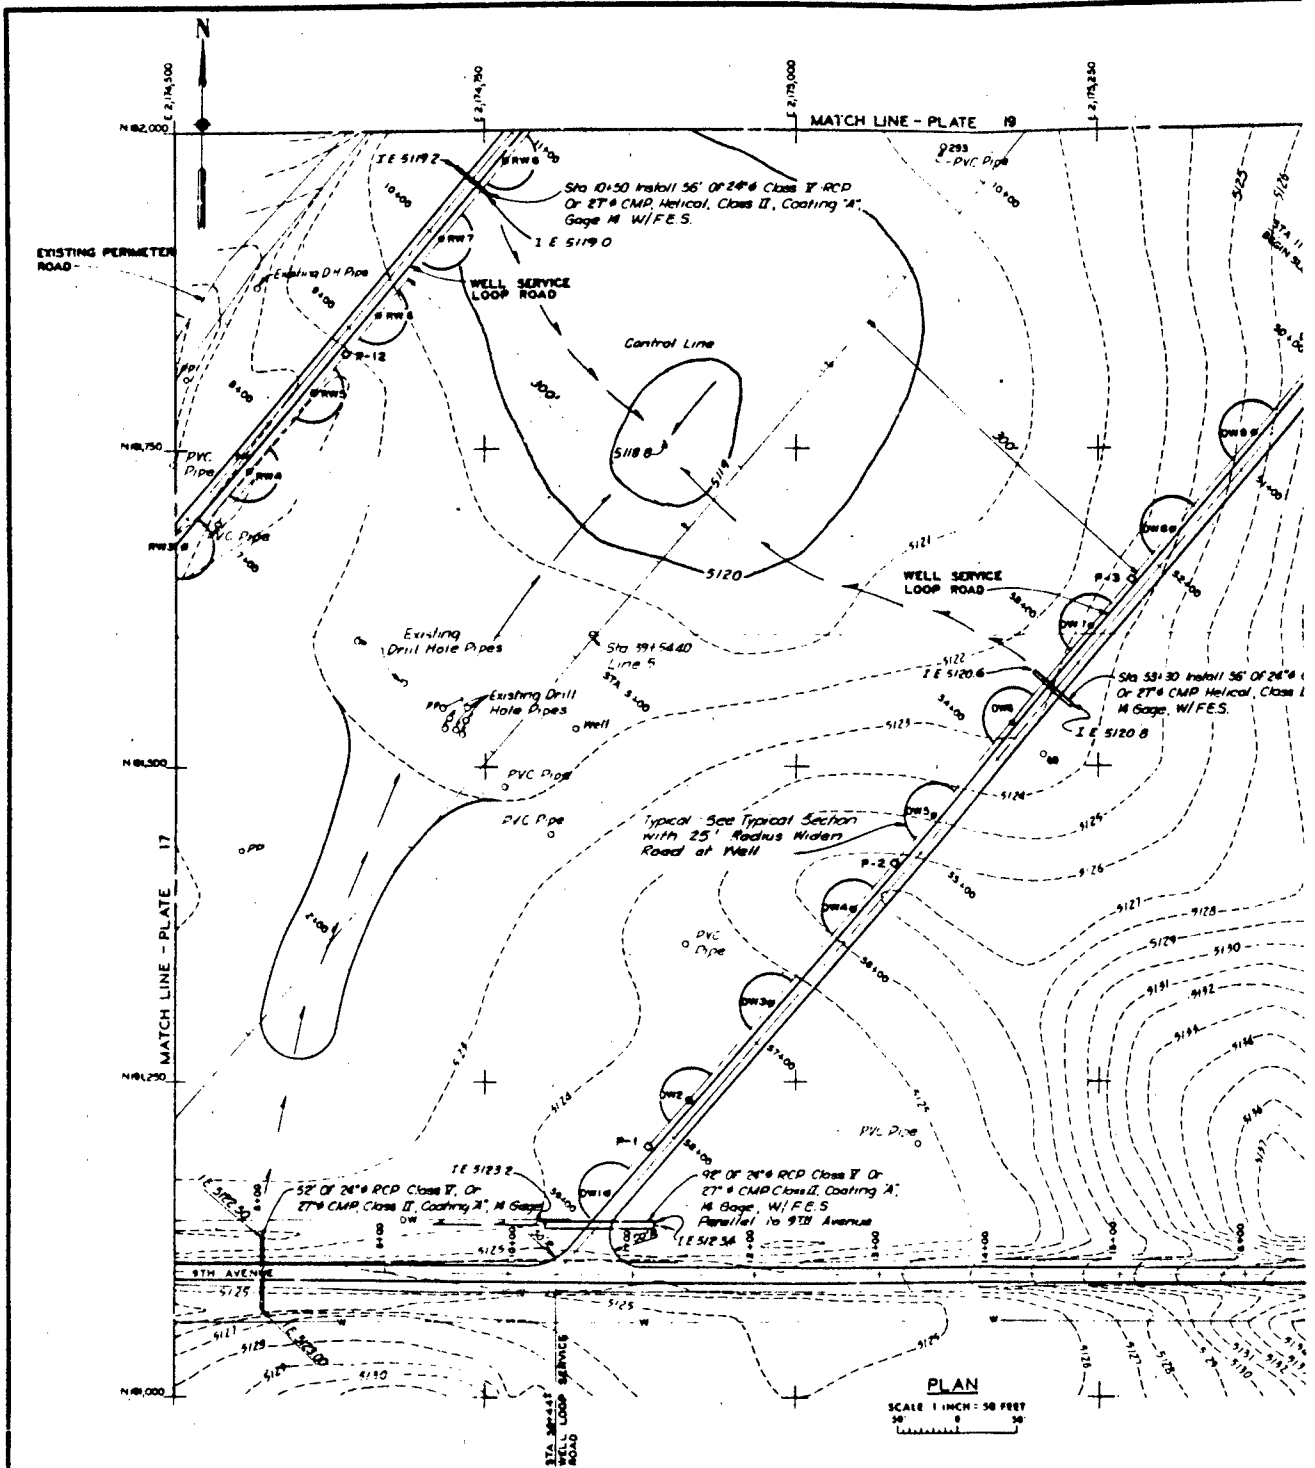

1

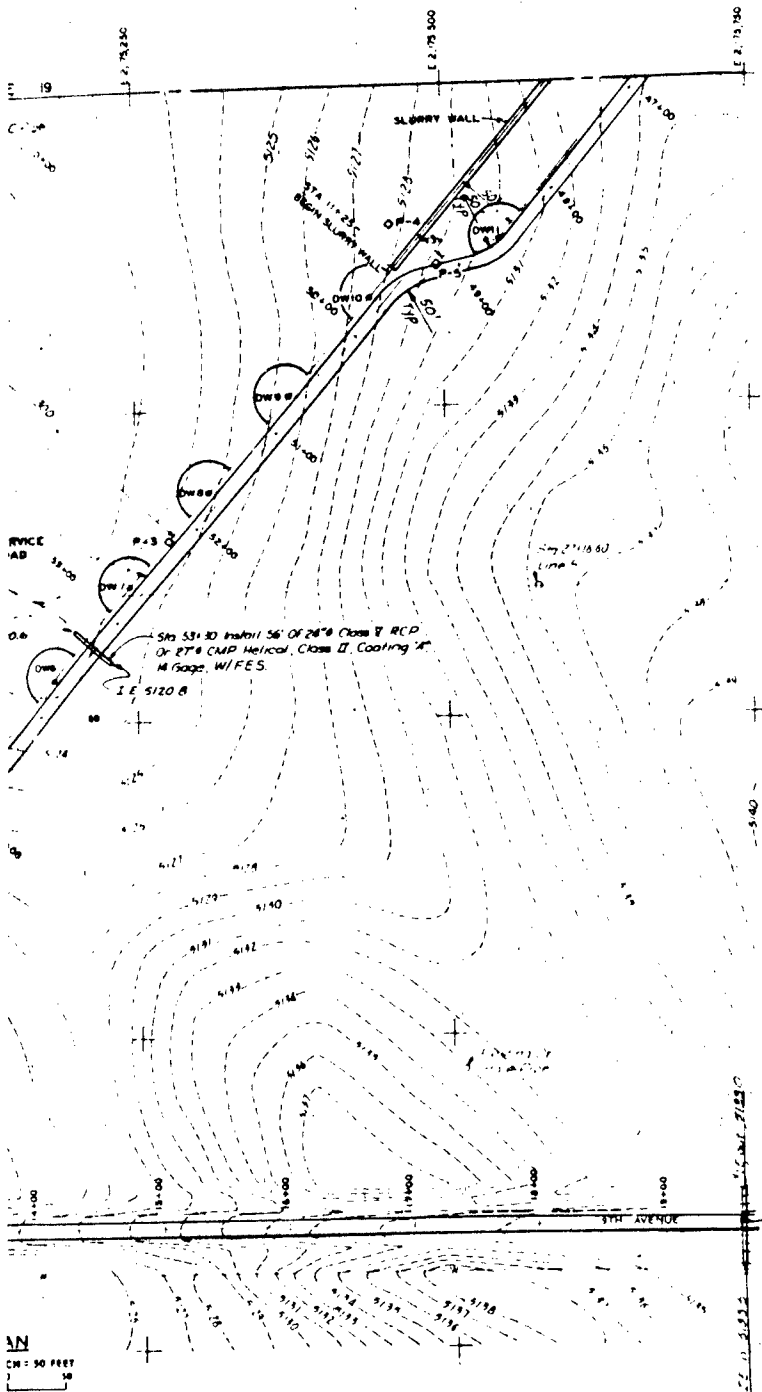

NOTE:
The ground surface over the completed sturry wall shall be restored to the original ground elevations and contours, and graded so that water does not pond on or adjacent to the sturry wall.

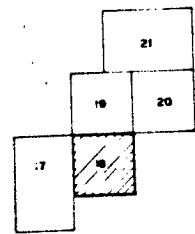


KEY PLAN



THE NUMBER SHOWN BELOW REFERS TO THE SHEET NUMBER ON THE ORIGINAL SCALE

DATE	DESIGNED	CHECKED	APPROVED
REGISTRATION			
U. S. ARMY ENGINEER DISTRICT OMAHA GROUP OF ENGINEERS SIEMENS, NEBRASKA			
ENGINEER IN CHARGE	PROJECT ENGINEER	COMMERCE CITY, COLORADO	
NORTHWEST BOUNDARY CONTAINMENT WELL SERVICE LOOP ROAD GRADING PLAN			
E. B. MCA 1955			
DRAWN BY		CHECKED BY	
APPROVED BY		DATE	
F 841-40-01			

2

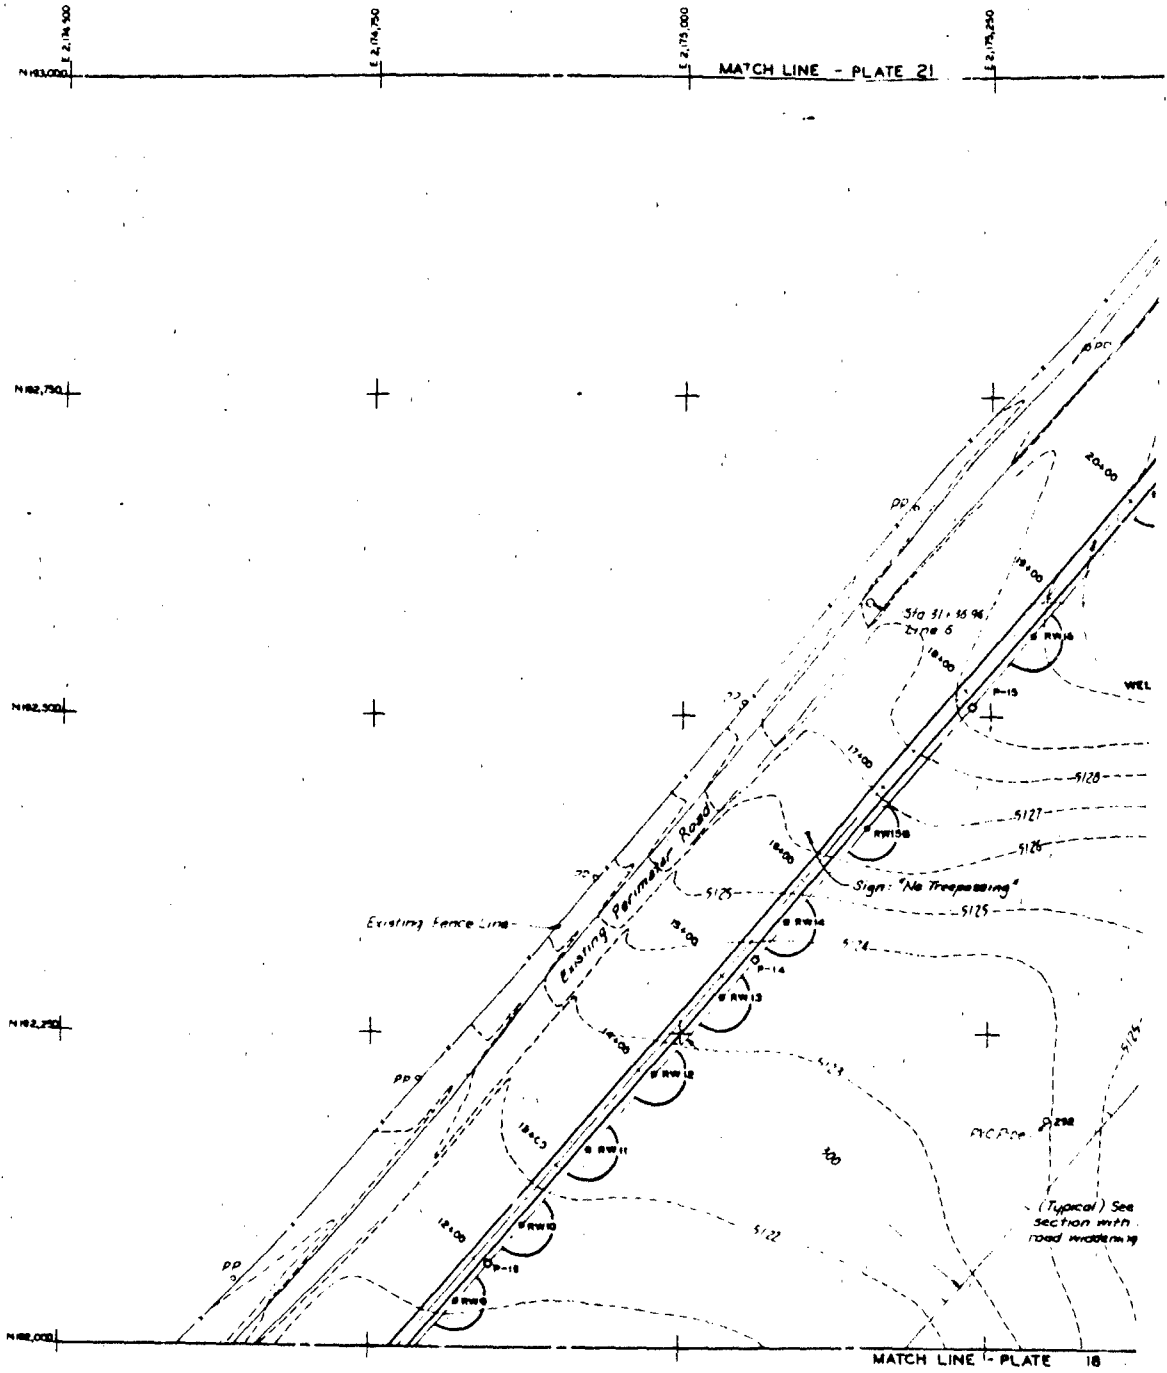

PLAN
 SCALE: 1 INCH = 50 FEET
 70 0 30

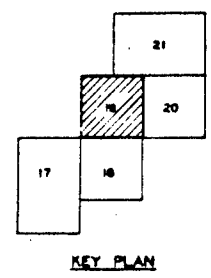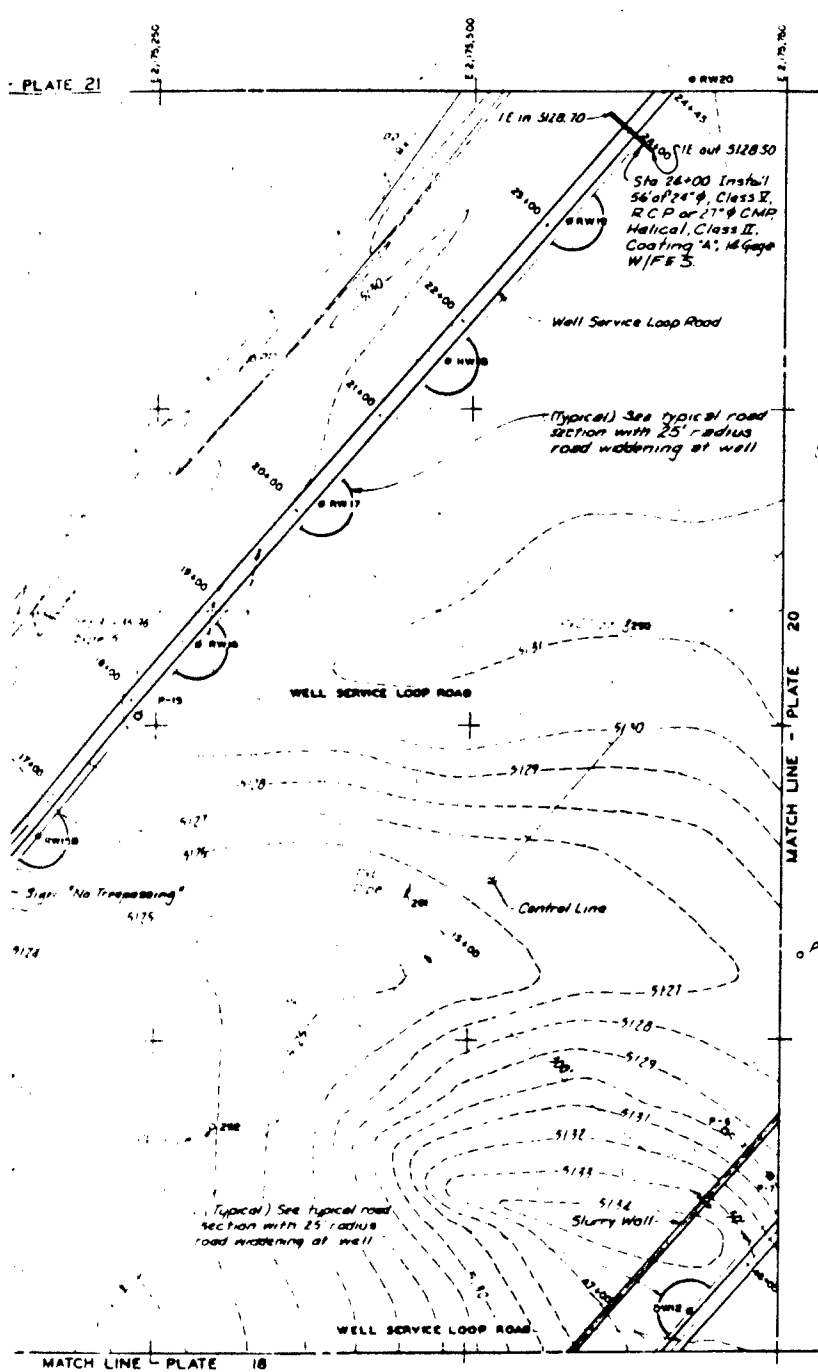


NOTE: The ground surface over the completed slurry wall shall be restored to the original ground elevations and contours, and graded so that water does not pond on or adjacent to the slurry wall.



THIS DRAWING HAS BEEN REVISIONED TO THIS DATE BY THE ORIGINAL SCALE.

DATE	DESIGNED BY	DRAWN BY	APPROVED
REVISIONS			
U. S. ARMY ENGINEER DISTRICT OMAHA GROUP OF ENGINEERS SISSON, NEBRASKA			
PROJECT NO. 18	ROCKY MOUNTAIN ARMY NAT. COMMERCIAL CITY, COLORADO		
DATE OF PLAN	NORTHWEST BOUNDARY CONTAINMENT		
DESIGNED BY	WELL SERVICE LOOP ROAD		
DRAWN BY	GRADING PLAN		
DATE OF PLAN	FT. M. WEA. PH. 18		
SCALE	SCALE	SCALE	SCALE
P 641-40-01			

2

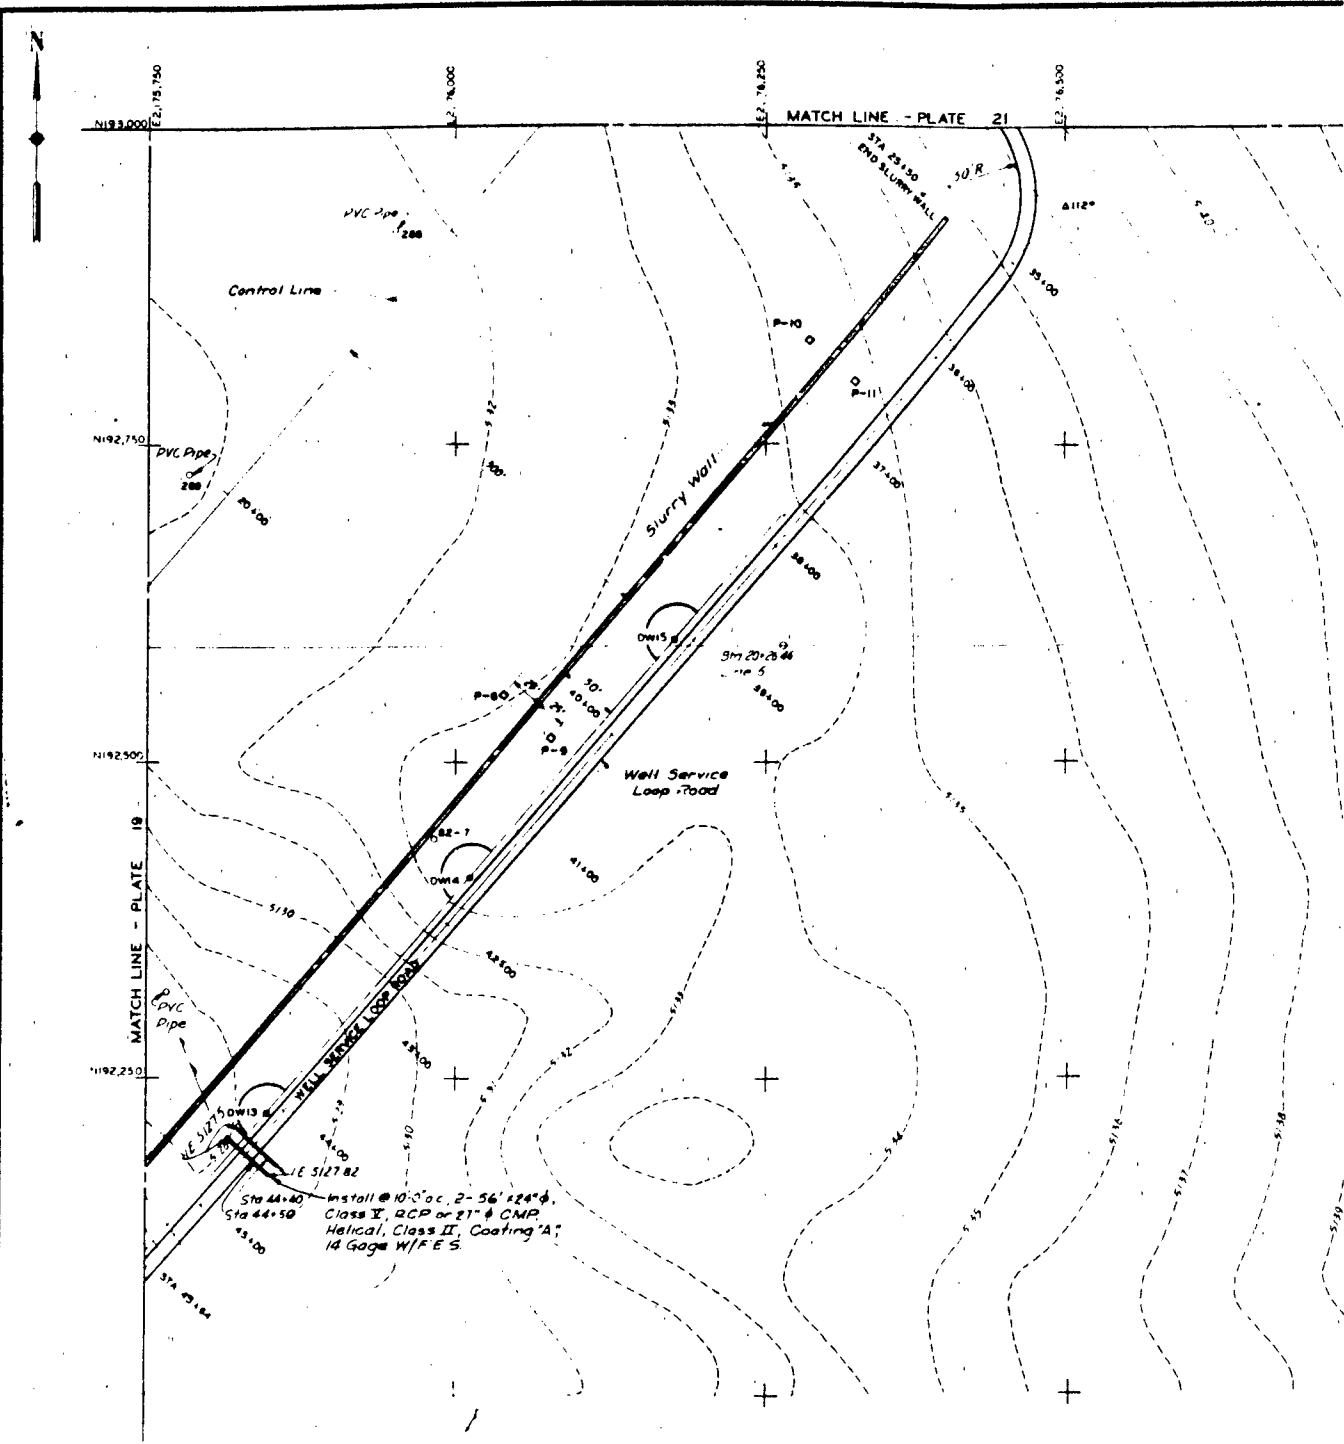

PLAN
 SCALE 1 INCH = 50 FEET
 0 50

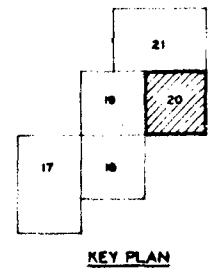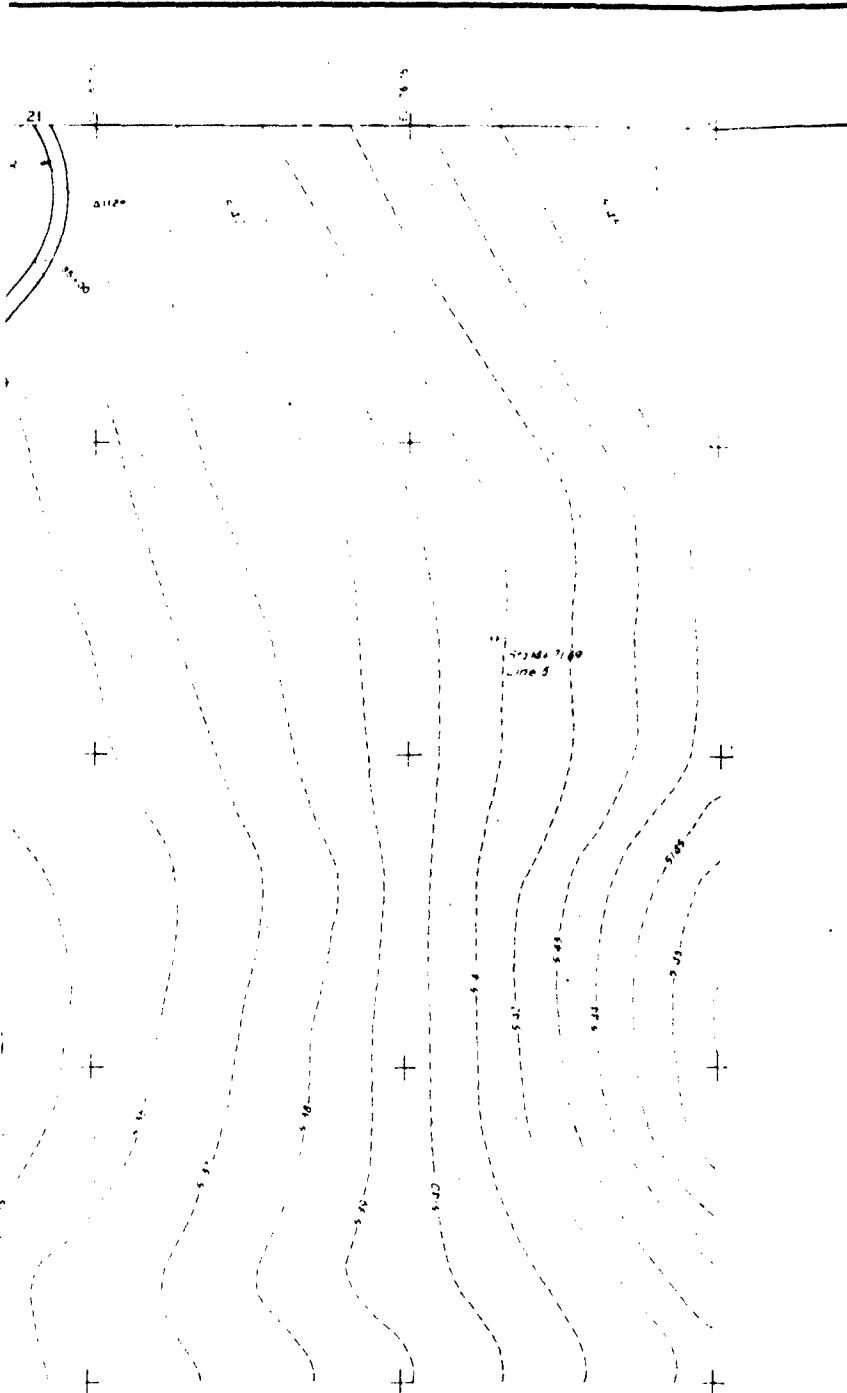


KEY PLAN

NOTE:
The ground surface over the completed slurry wall shall be restored to the original ground elevations and contours, and graded so that water does not pond on or adjacent to the slurry wall.



THIS DRAWING HAS BEEN REDUCED TO THREE-FIFTHS THE ORIGINAL SCALE

2

DATE		DESIGNED BY		CHECKED BY	
DRAWN BY		APPROVED BY		DATE	
REVISIONS					
U. S. ARMY ENGINEER DISTRICT, OMAHA GROUP OF ENGINEERS OMAHA, NEBRASKA					
ROCKY MOUNTAIN ARSENAL, COMMERCE CITY, COLORADO					
NORTHWEST BOUNDARY CONTAINMENT WELL SERVICE LOOP ROAD GRACING PLAN					
7 BY MCA PM 302					
SCALE		SHEET NO.		TOTAL SHEETS	
PROJECT NO.		DRAWING NO.		DATE	

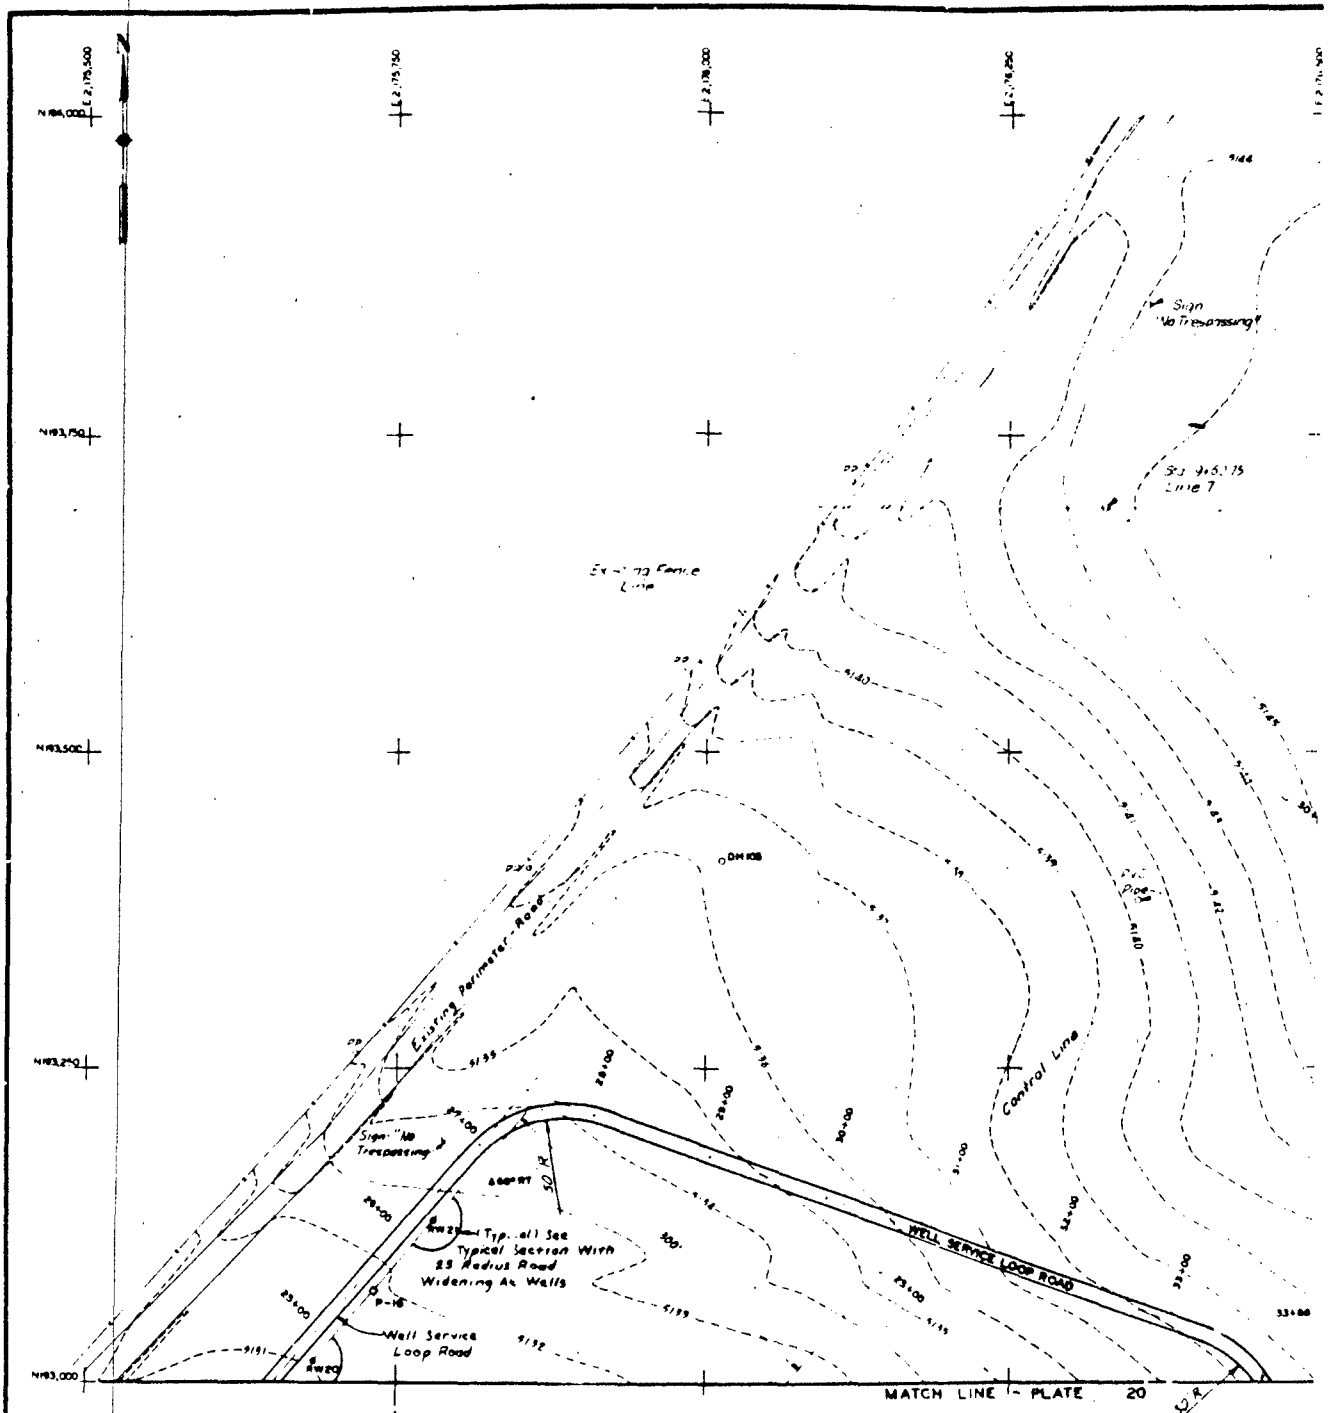

PLAN
SCALE 1 INCH = 50 FEET

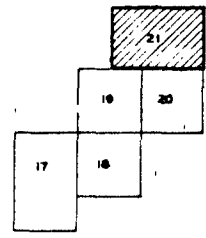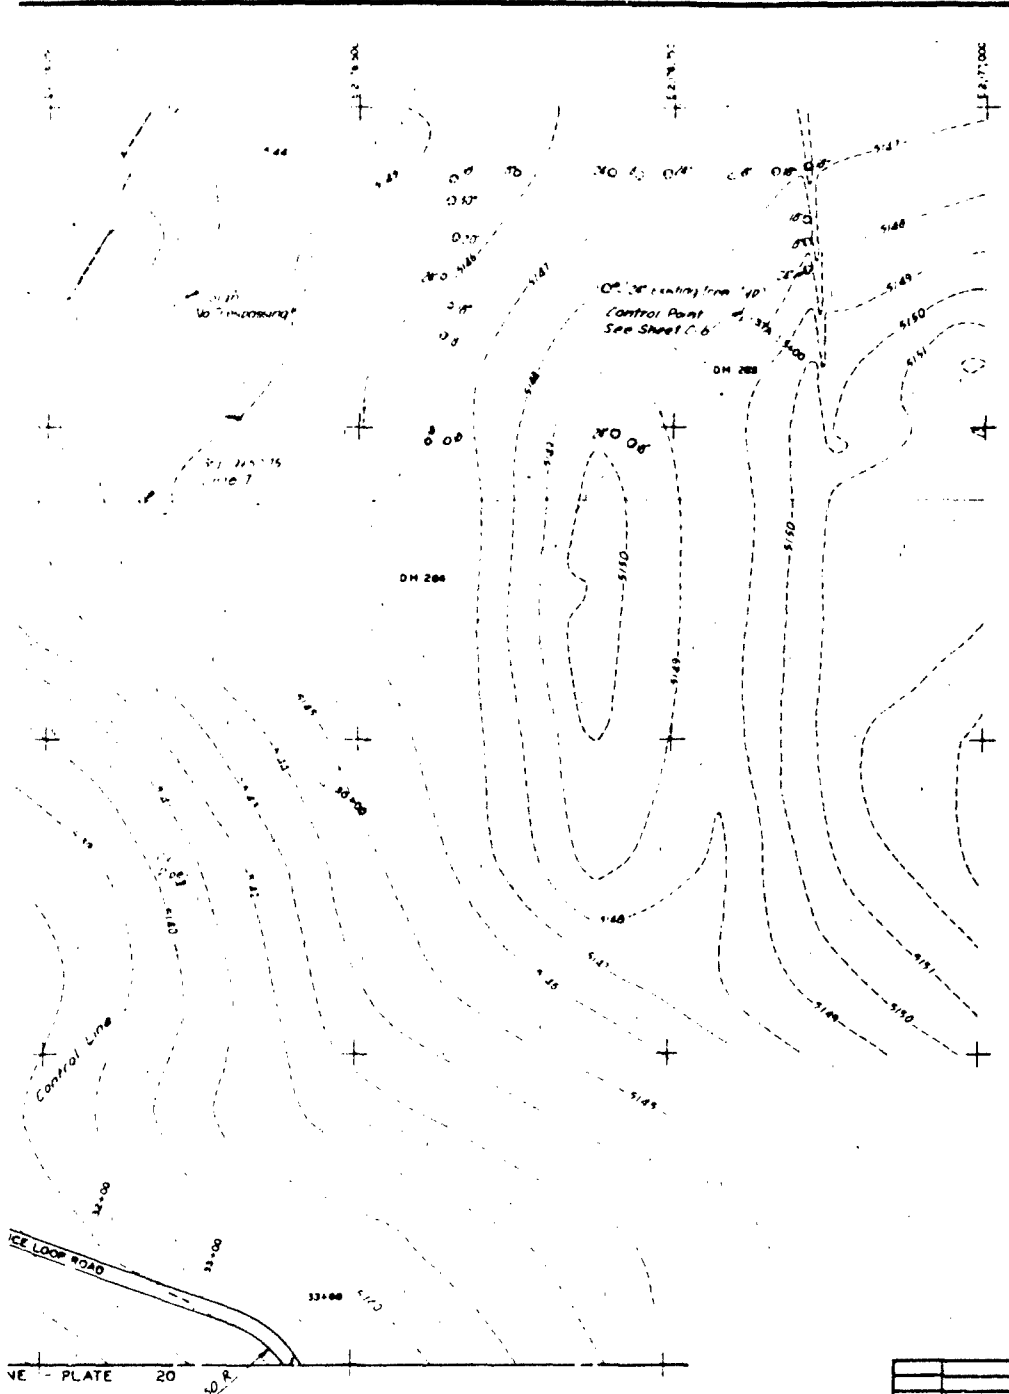


KEY PLAN


THIS DRAWING HAS BEEN REDUCED TO THREE-EIGHTHS THE ORIGINAL SCALE.

VE - PLATE 20 50 R

2


REVISIONS			
NO.	DESCRIPTION	DATE	BY
U. S. ARMY ENGINEER DISTRICT OHMFA GROUP OF ENGINEERS CHICAGO, ILLINOIS			
ROCKY MOUNTAIN ARSENAL COMMERCE CITY, COLORADO NORTHWEST BOUNDARY CONTAINMENT WELL SERVICE LOOP ROAD GRADING PLAN			
PROJECT NO.		FY 51 MCA PN 342	
DRAWN BY		CHECKED BY	
DATE		SCALE	
PROJECT NO.		F 841-40-01	

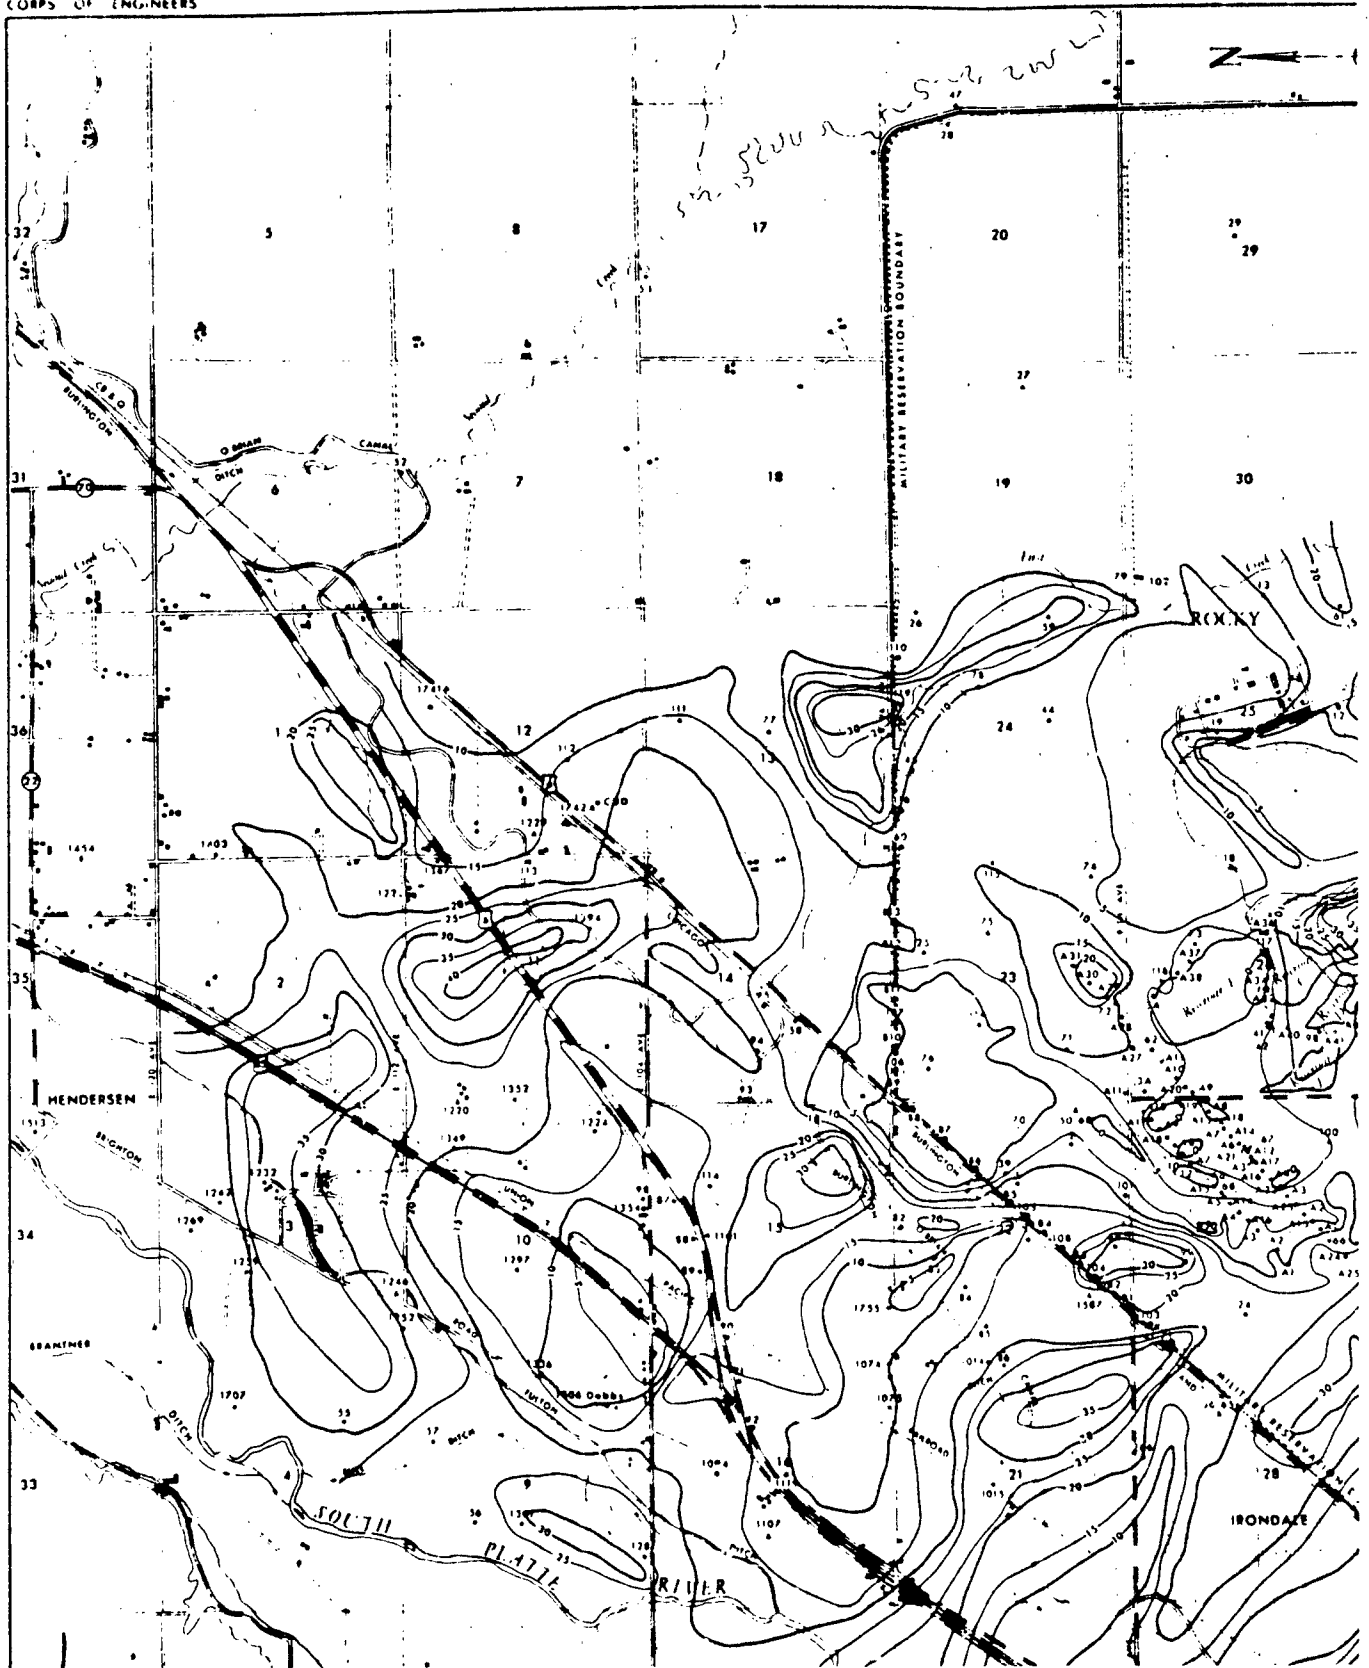


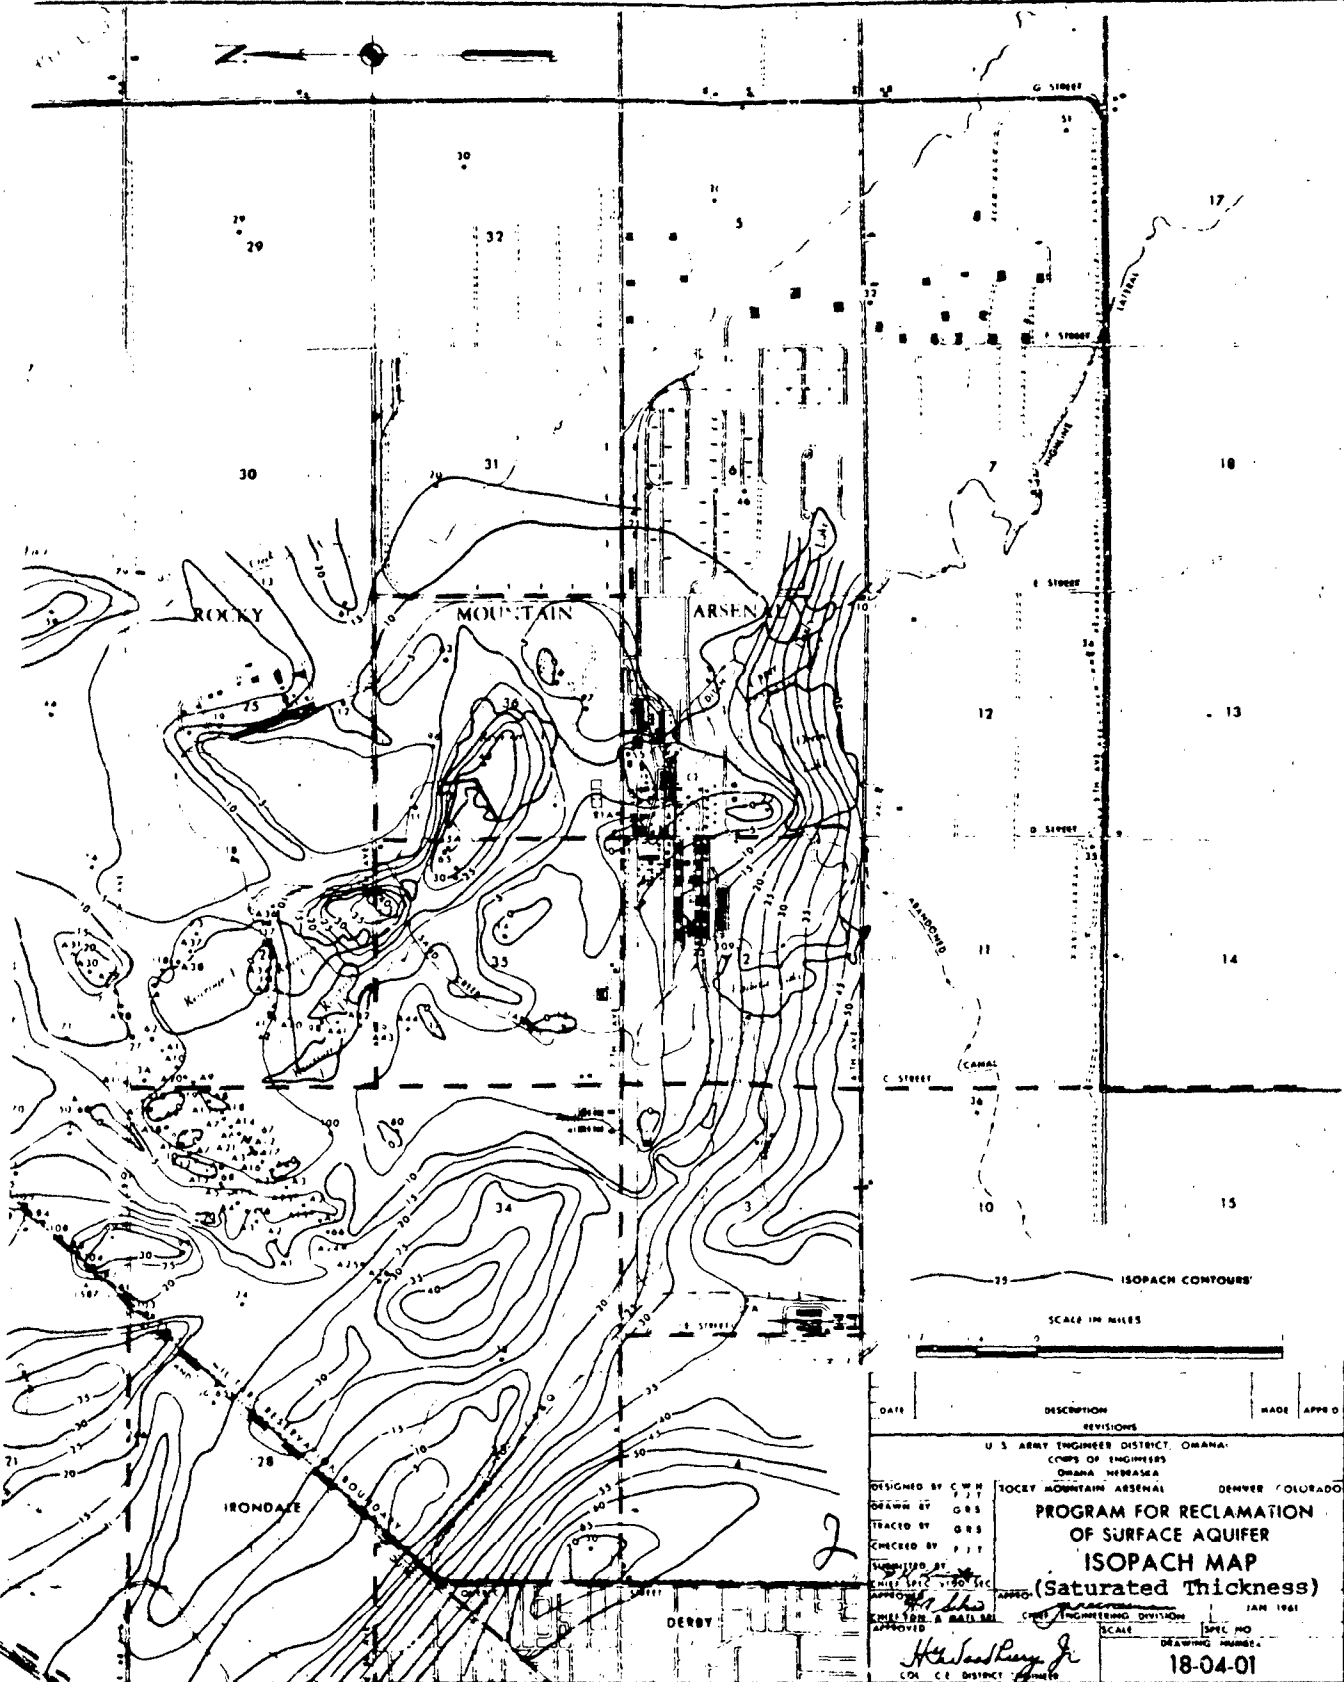

DATE	DESCRIPTION	MADE	APPRO
	REVISIONS		
U.S. ARMY ENGINEER DISTRICT OMAHA CORPS OF ENGINEERS OMAHA, NEBRASKA			
DESIGNED BY C.W.P. DRAWN BY G.S.S. TRACED BY G.S.S. CHECKED BY P.J.T. SUPERVISED BY APPROVED BY ENGINEER & RAILWAY APPROVED			
U.S. ARMY ENGINEER DISTRICT OMAHA CORPS OF ENGINEERS OMAHA, NEBRASKA ROCKY MOUNTAIN ARSENAL DENVER, COLORADO PROGRAM FOR RECLAMATION OF SURFACE AQUIFER ISOPACH MAP (Saturated Thickness) SCALE 1" = 1 MILE SPEC. NO. 18-04-01 JAN 1961			

CORPS OF ENGINEERS

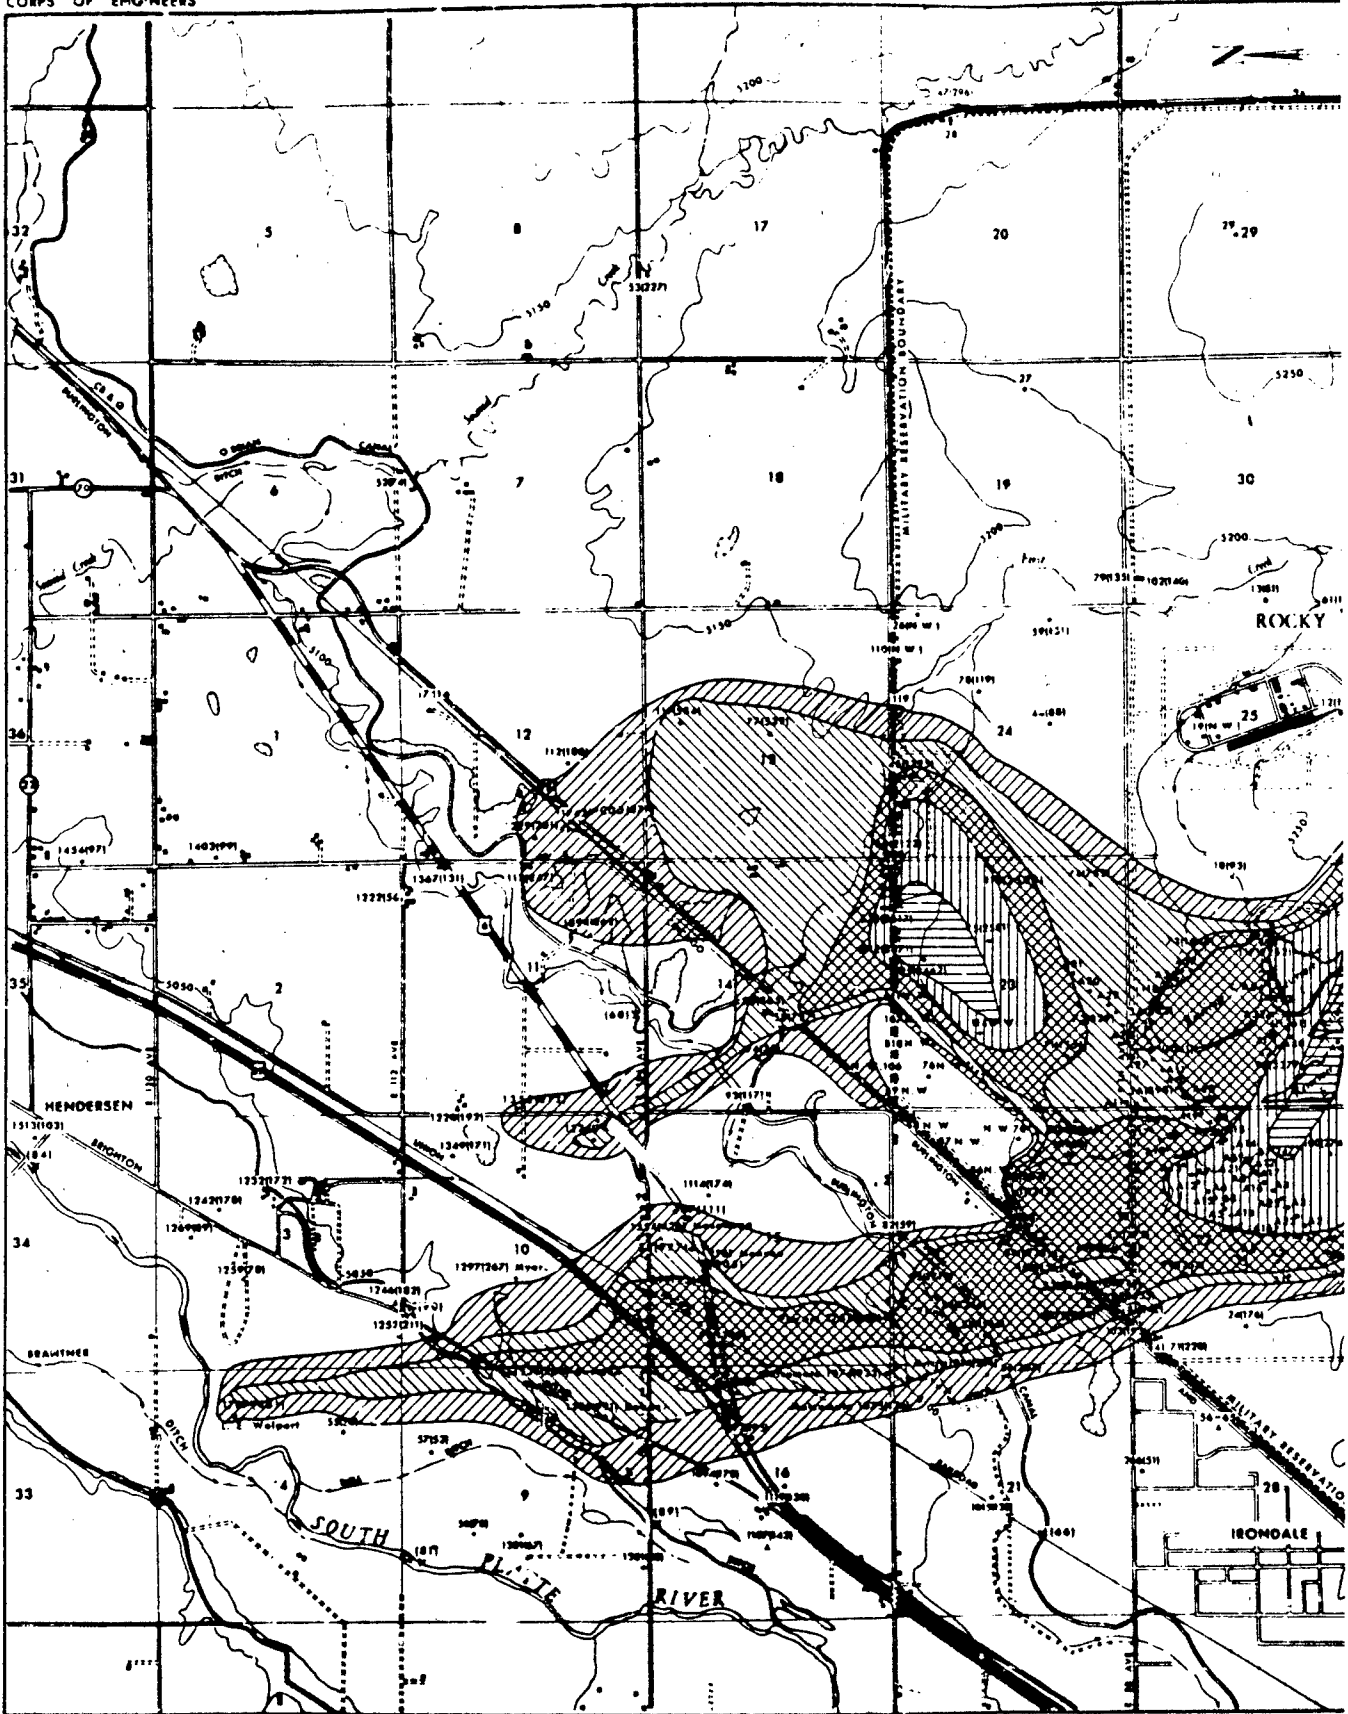

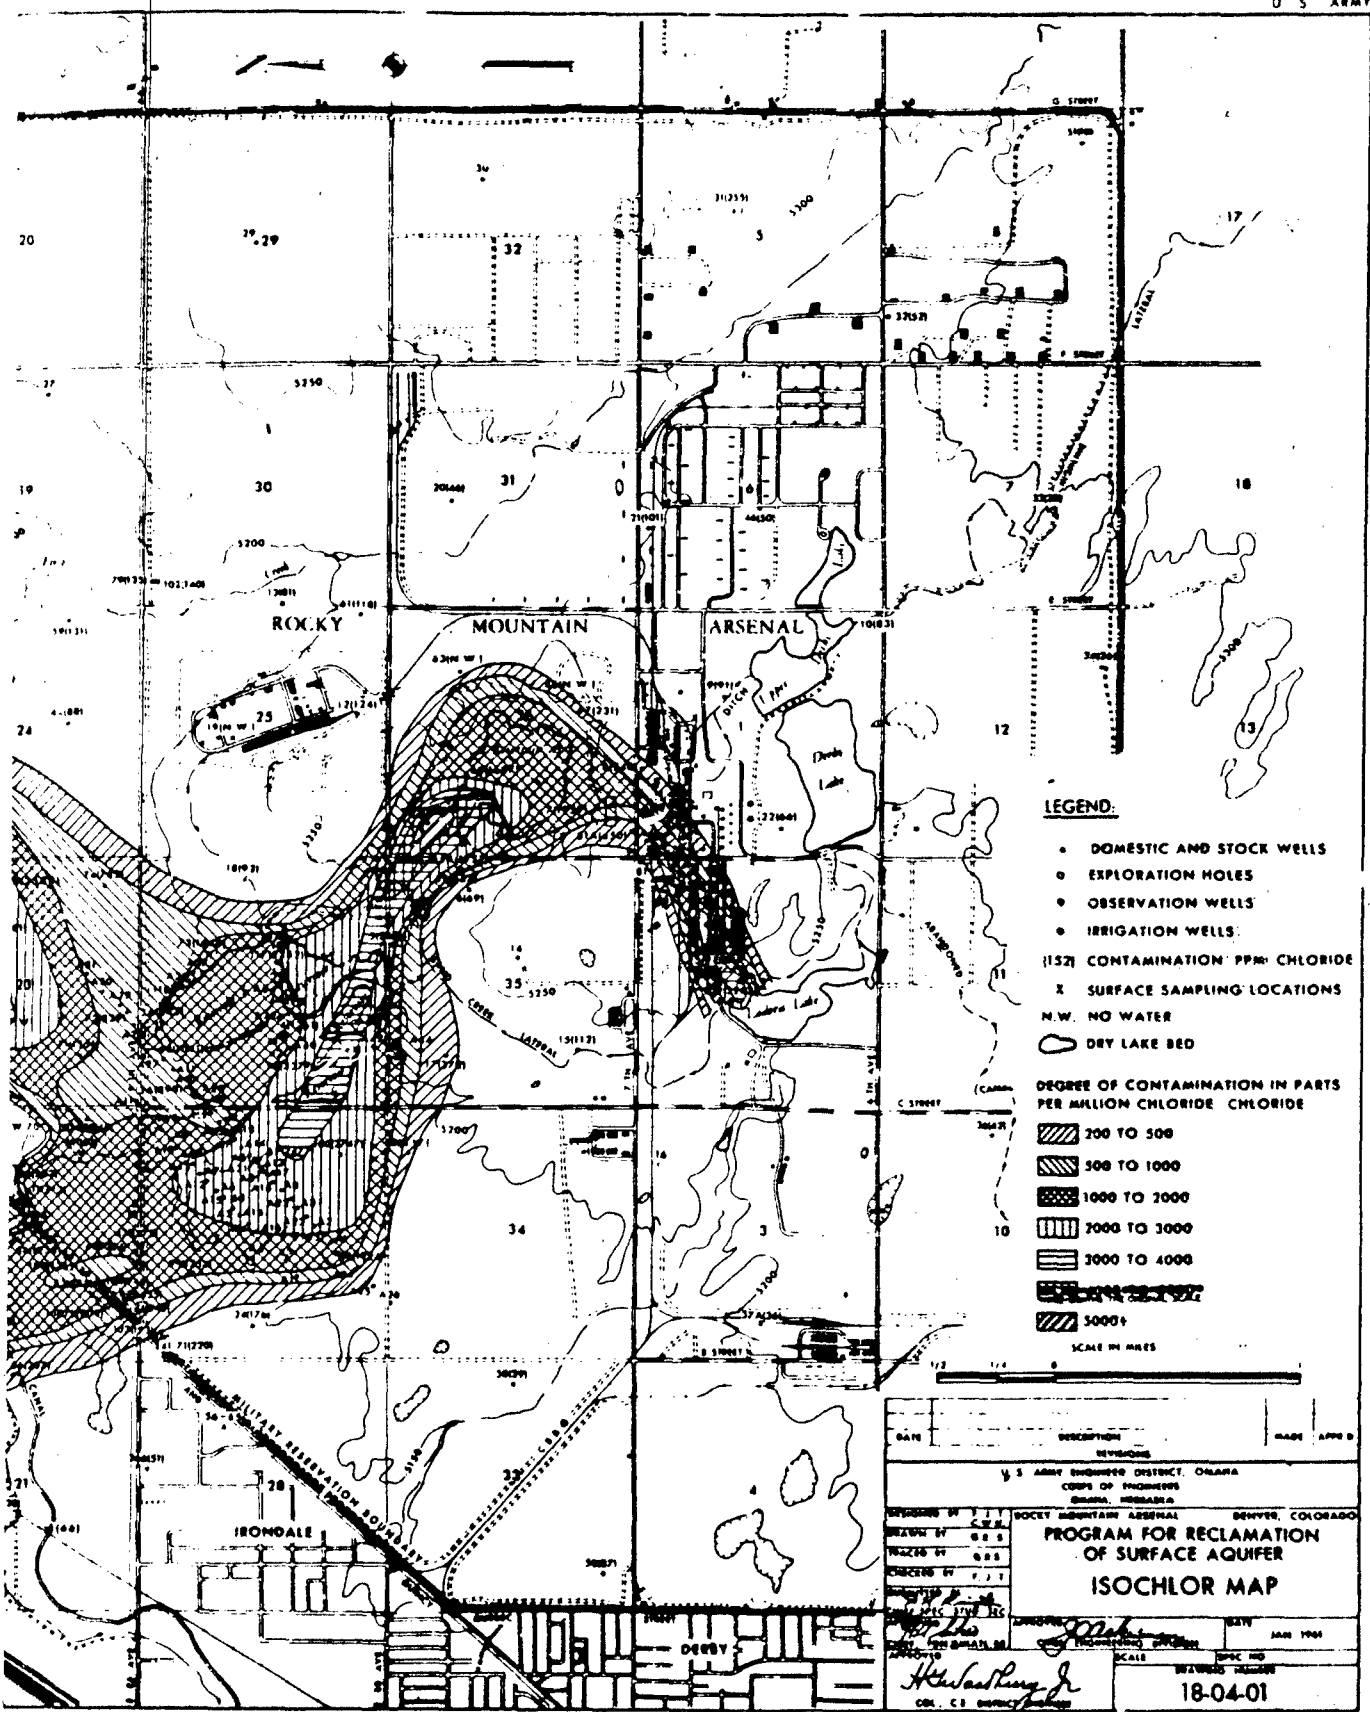

LEGEND:

- DOMESTIC AND STOCK WELLS
- EXPLORATION HOLES
- OBSERVATION WELLS
- IRRIGATION WELLS
- {152} CONTAMINATION PPM CHLORIDE
- X SURFACE SAMPLING LOCATIONS
- N.W. NO WATER
- DRY LAKE BED


DEGREE OF CONTAMINATION IN PARTS PER MILLION CHLORIDE CHLORIDE


- [Diagonal lines /] 200 TO 500
- [Diagonal lines \] 500 TO 1000
- [Cross-hatch] 1000 TO 2000
- [Vertical lines] 2000 TO 3000
- [Horizontal lines] 3000 TO 4000
- [Dense cross-hatch] 5000+

SCALE IN MILES

DATE	DESCRIPTION	MADE	APP'D
U S ARMY ENGINEER DISTRICT, DENVER CORPS OF ENGINEERS DENVER, COLORADO			
ROCKY MOUNTAIN ARSENAL DENVER, COLORADO PROGRAM FOR RECLAMATION OF SURFACE AQUIFER ISOCHLOR MAP			
DESIGNED BY	PLANNED BY	ENGINEERED BY	CONSTRUCTED BY
BY	BY	BY	BY
DATE	DATE	DATE	DATE
DRAWN BY <i>H. S. ...</i> CHECKED BY <i>H. S. ...</i>		SCALE	SPIC NO
		1" = 1 MILE	18-04-01


CORPS OF ENGINEERS

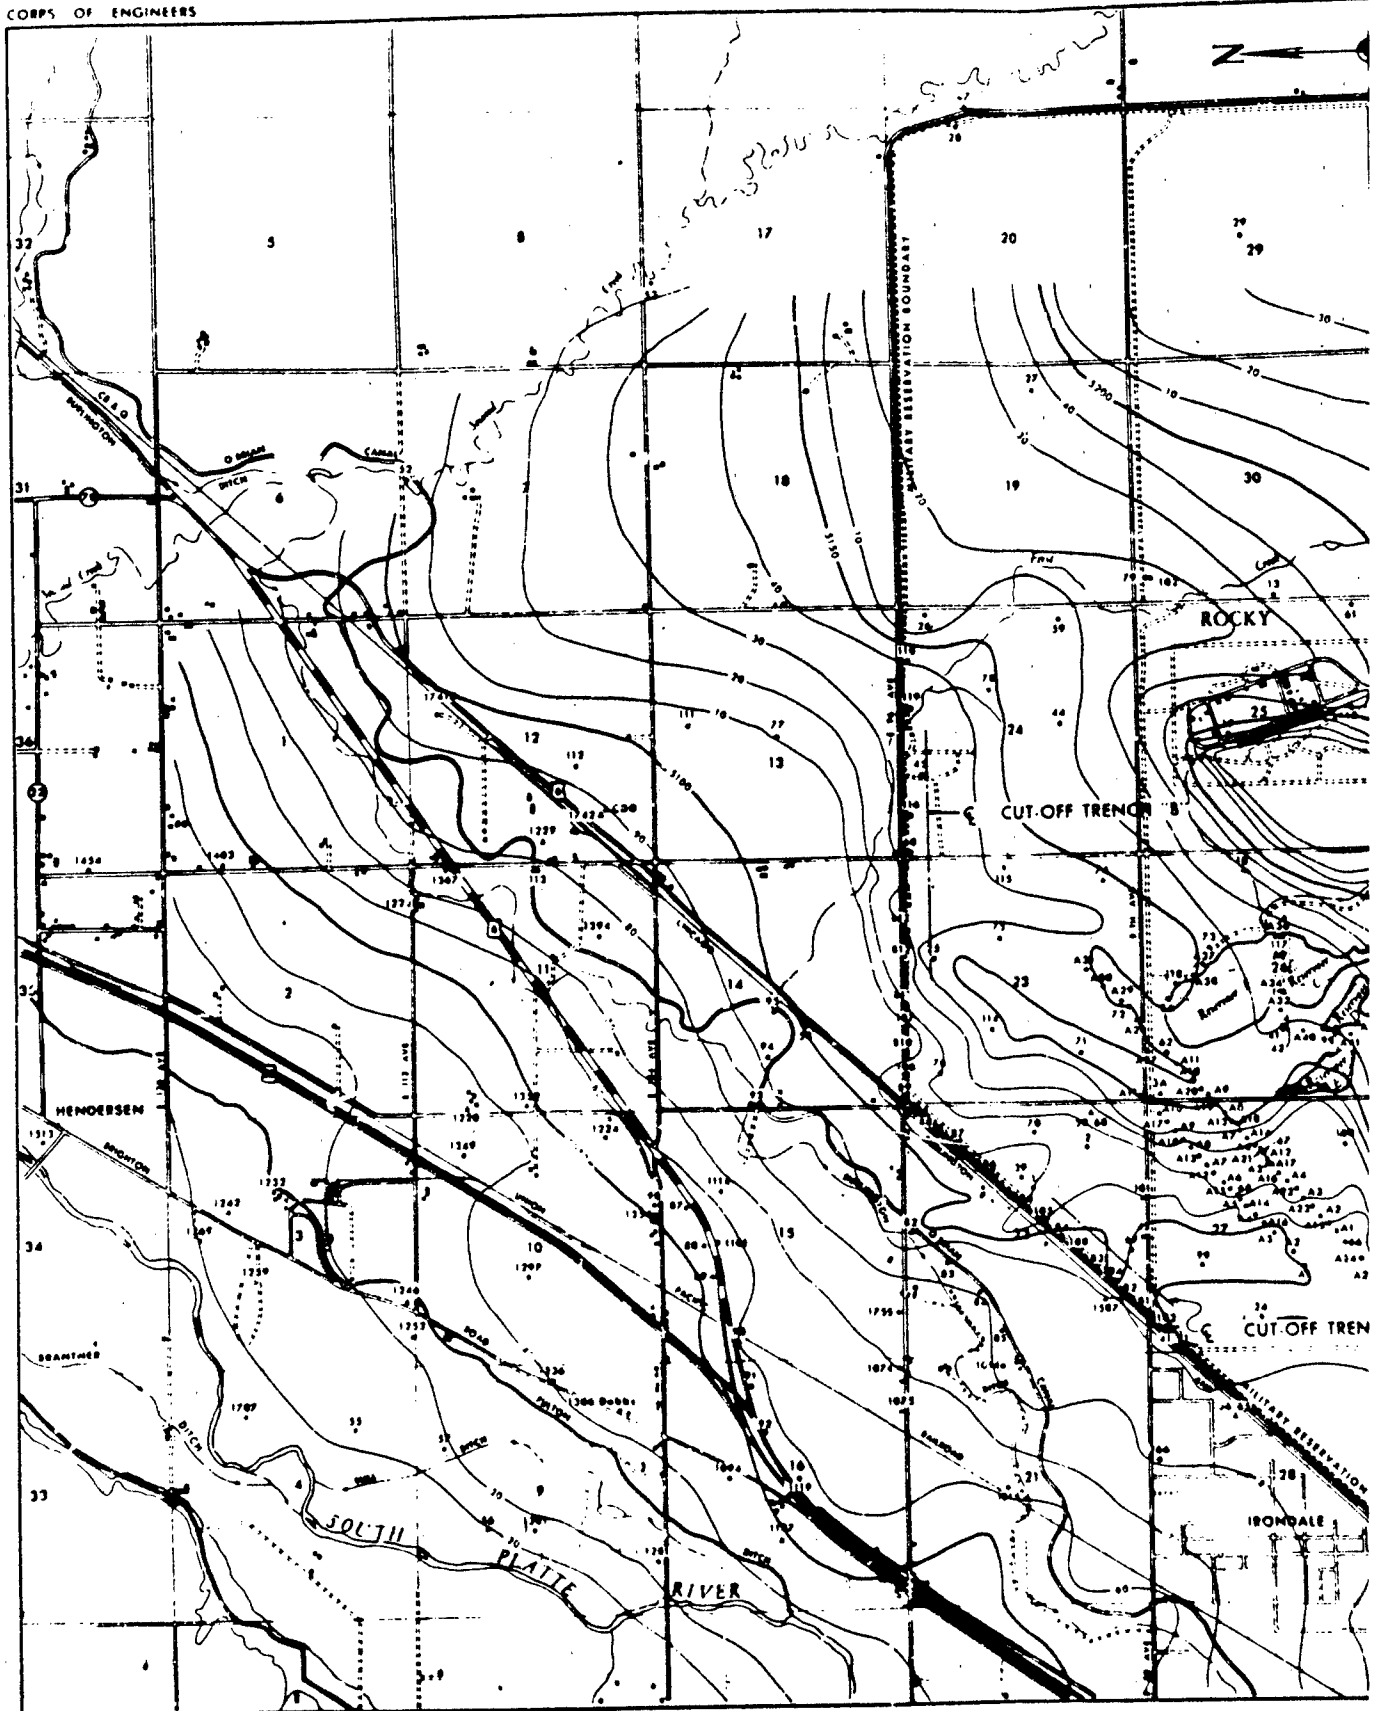


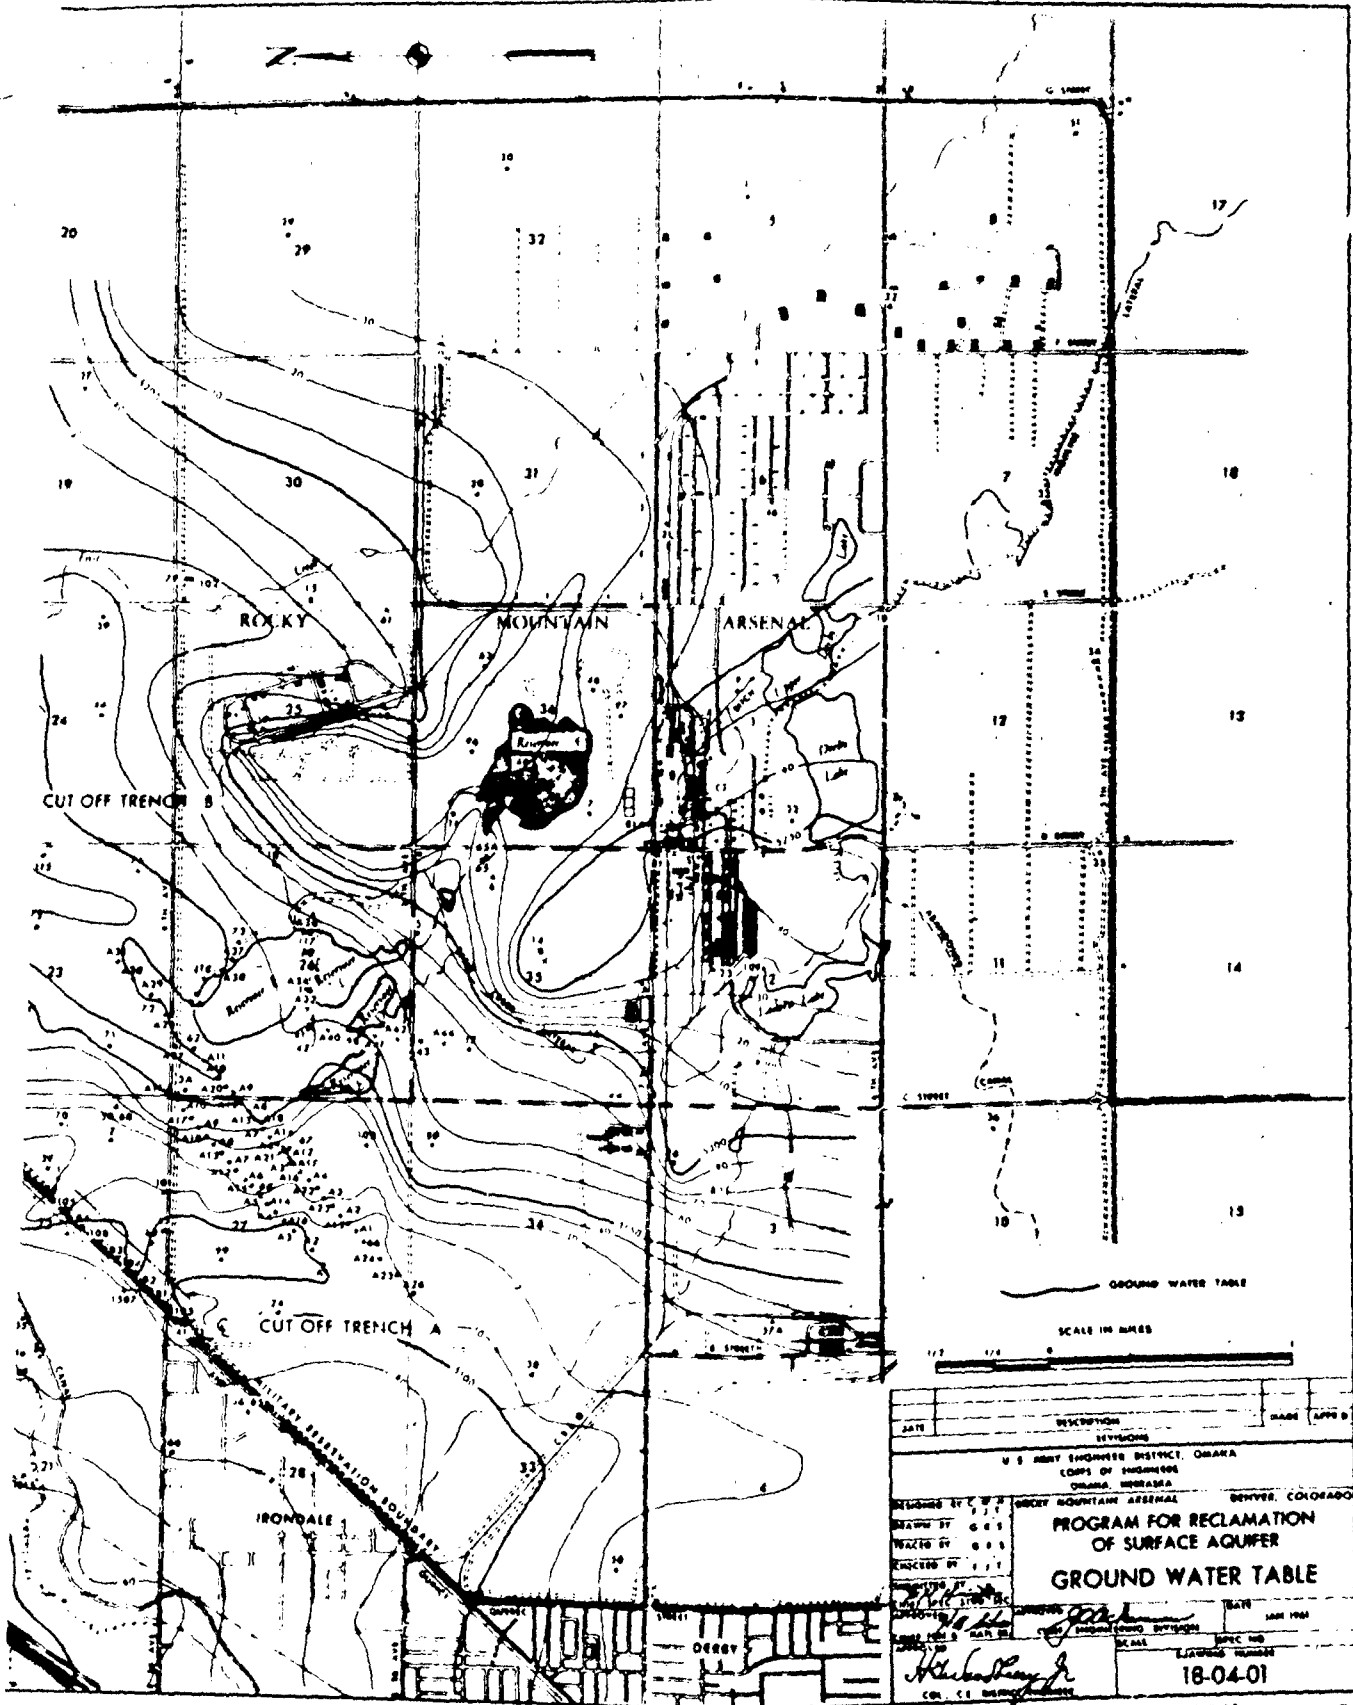

DATE	DESCRIPTION	DATE	APP'D
U S ARMY ENGINEER DISTRICT, OMAHA CORPS OF ENGINEERS OMAHA, IOWA			
DESIGNED BY		DENVER, COLORADO	
DRAWN BY		PROGRAM FOR RECLAMATION OF SURFACE AQUIFER GROUND WATER TABLE	
CHECKED BY			
DATE		DATE	
18-04-01		18-04-01	

CORPS OF ENGINEERS

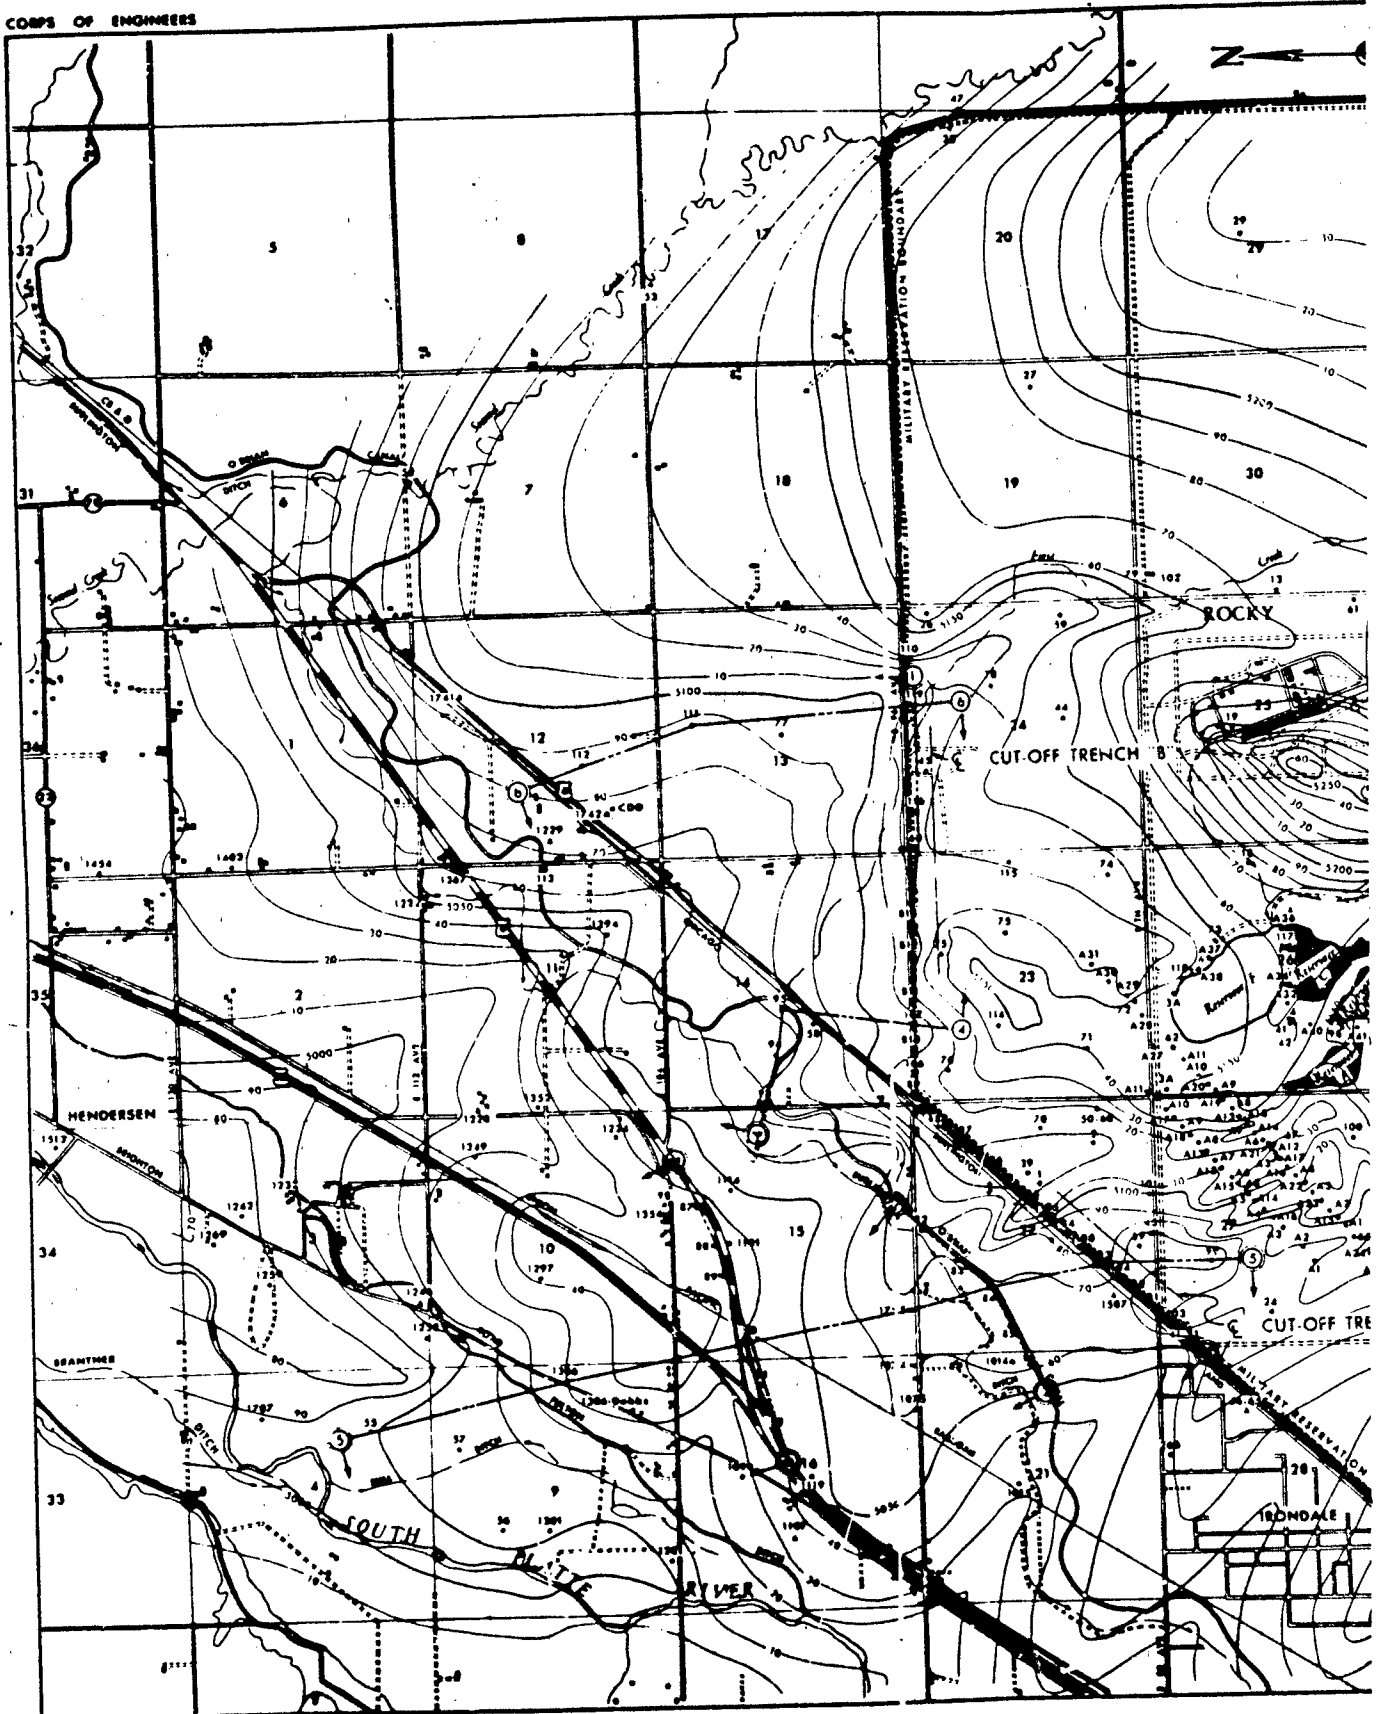

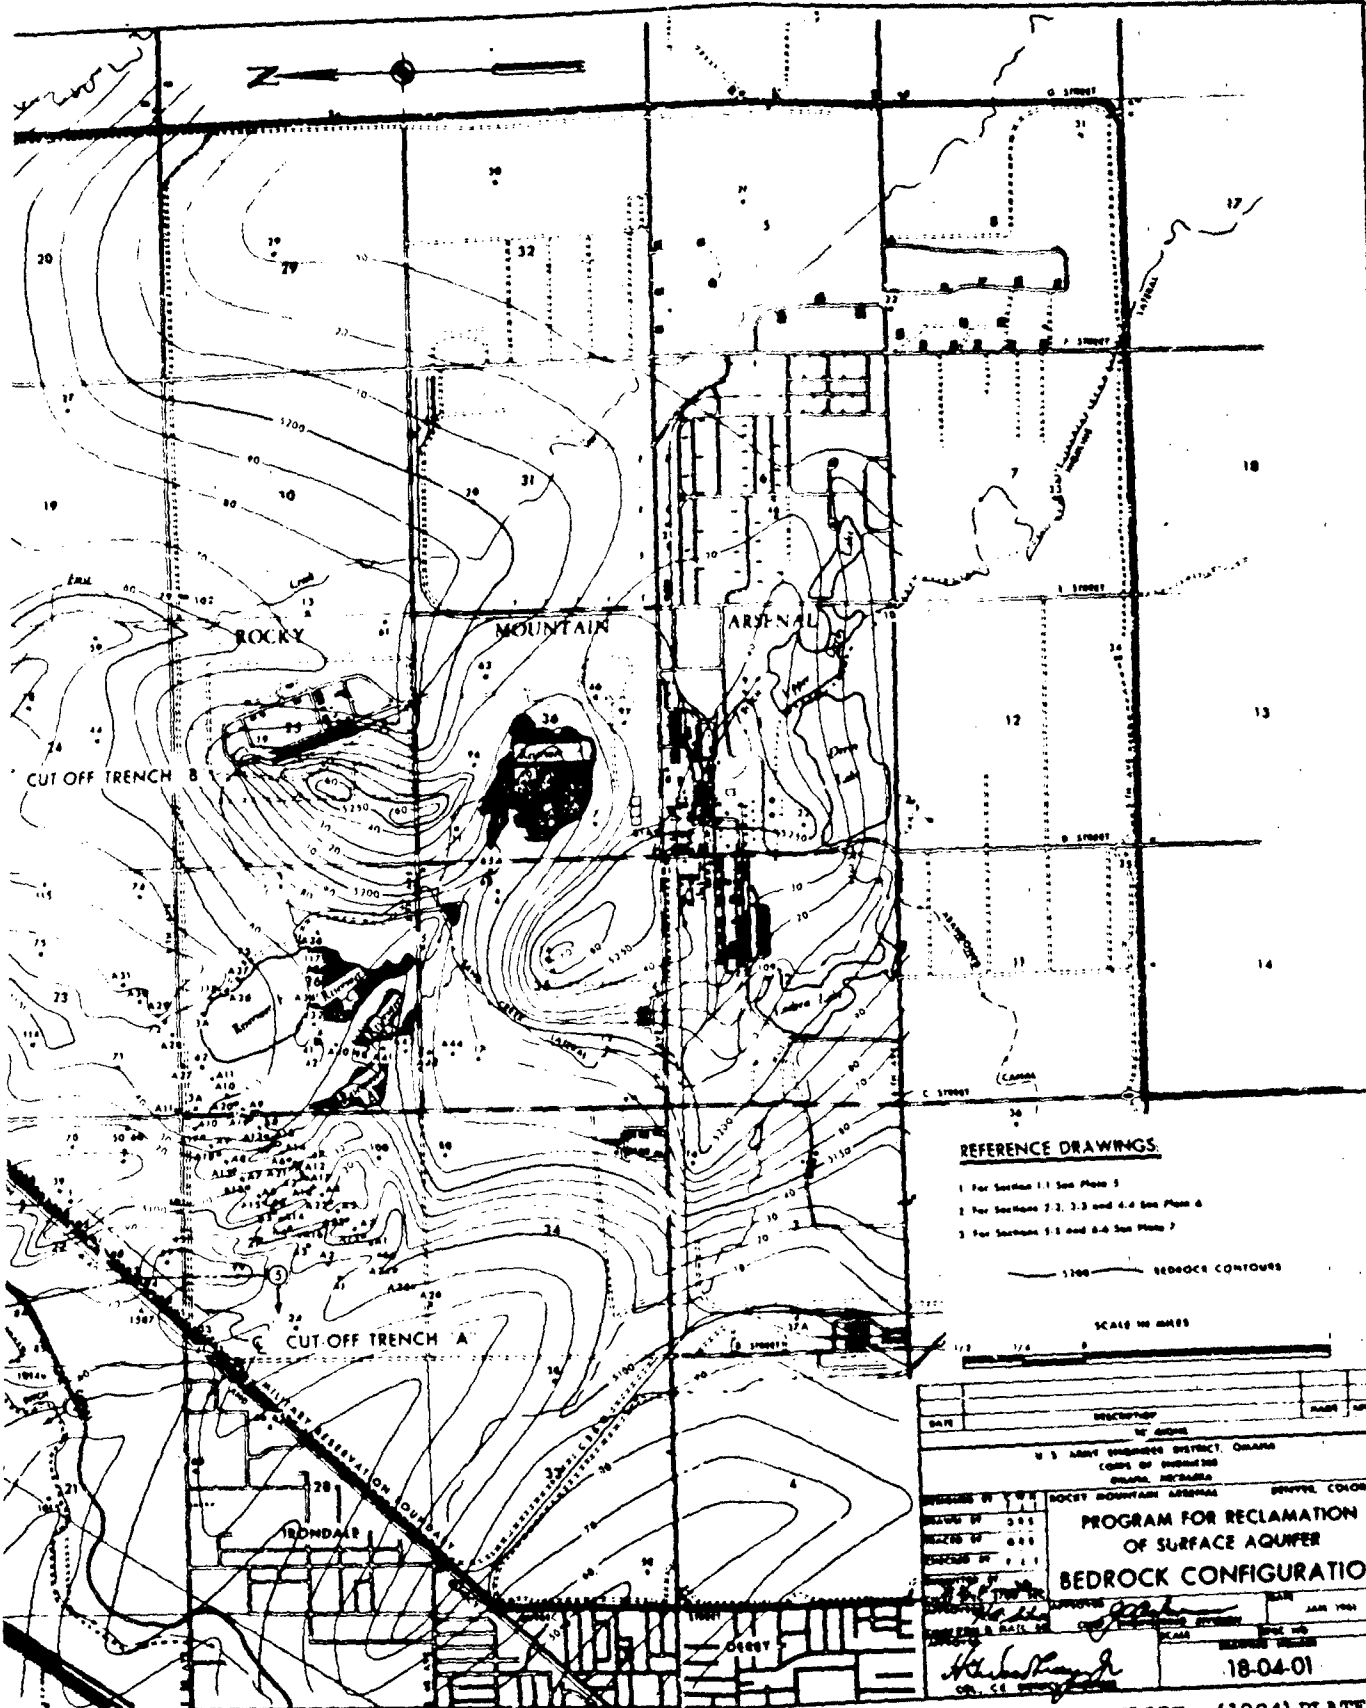

REFERENCE DRAWINGS:

- 1 For Section 1.1 See Plan 5
- 2 For Sections 2.2, 3.3 and 4.4 See Plan 6
- 3 For Sections 5.1 and 6.4 See Plan 7

1700 BEDROCK CONTOURS

SCALE IN FEET

DATE	DESCRIPTION	BY	APP'D

U. S. ARMY ENGINEER DISTRICT, DENVER
 CORPS OF ENGINEERS
 DENVER, COLORADO

ROCKY MOUNTAIN ARSENAL DENVER, COLORADO

**PROGRAM FOR RECLAMATION
 OF SURFACE AQUIFER
 BEDROCK CONFIGURATION**

DESIGNED BY: [Signature]
 DRAWN BY: [Signature]
 CHECKED BY: [Signature]
 APPROVED BY: [Signature] DATE: JAN 1961

18-04-01