



U.S. Army Environmental Center
Environmental Technology Division
Edgewood Area
Aberdeen Proving Ground, Maryland

EVALUATION OF A TRANSPORTABLE HOT-GAS DECONTAMINATION SYSTEM FOR THE DECONTAMINATION OF EXPLOSIVES - CONTAMINATED DEBRIS & PIPING

DISTRIBUTION STATEMENT A

Approved for public release;
Distribution Unlimited

Operations & Maintenance Manual

AS-BUILT DRAWINGS

VOLUME II

19961017 124

WESTON 96P-2943
MANAGERS DESIGNERS/CONSULTANTS

DISCLAIMER NOTICE



THIS DOCUMENT IS BEST QUALITY AVAILABLE. THE COPY FURNISHED TO DTIC CONTAINED A SIGNIFICANT NUMBER OF PAGES WHICH DO NOT REPRODUCE LEGIBLY.

FURNACE EQUIPMENT

<u>DRAWING NO.:</u>	<u>REV. NO.:</u>	<u>DRAWING DATE</u>	<u>DRAWING DESCRIPTION</u>
F928-01 (Sheet 1)	B	8/1/96	WIRING DIAGRAM: M
F298-01 (Sheet 2)	B	8/1/96	WIRING DIAGRAM: M
F298-01 (Sheet 3)	B	8/1/96	WIRING DIAGRAM: M
F298-01 (Sheet 4)	B	8/1/96	WIRING DIAGRAM: M
F298-02 (Sheet 1)	B	8/1/96	MODEL FBG5610: GEN
F298-02 (Sheet 2)	B	8/1/96	MODEL FBG5610: GEN
F298-03	B	8/1/96	COMBUSTION SCHEM
1300-01	-	12/27/95	INTERCONNECT DUCT
1300-02	-	1/1/96	EXHAUST PLENUM AS
1300-03	-	1/8/96	EXHAUST PLENUM DE

①

FURNACE EQUIPMENT

EQUIPMENT

DRAWING DESCRIPTION

WIRING DIAGRAM: MODEL FBG5610 GAS FIRED FURNACE
WIRING DIAGRAM: MODEL FBG5610 GAS FIRED FURNACE
WIRING DIAGRAM: MODEL FBG5610 GAS FIRED FURNACE
WIRING DIAGRAM: MODEL FBG5610 GAS FIRED FURNACE

MODEL FBG5610: GENERAL DIMESION & ASSEMBLY
MODEL FBG5610: GENERAL DIMESION & ASSEMBLY


COMBUSTION SCHEMATIC

INTERCONNECT DUCT
EXHAUST PLENUM ASSEMBLY
EXHAUST PLENUM DETAILS

②


Remote Panel (top)

12 Awg THHN

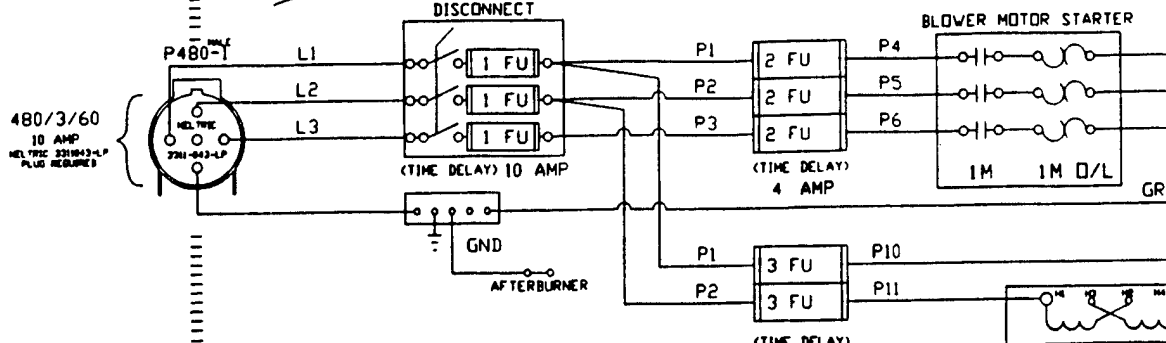

LEGEND


- XX Interconnection Panel/Panel
- q^x Local Panel Terminals
- x Remote Panel Terminals
- Afterburner Terminals
- Remote Panel Wiring
- - - Local Panel Wiring

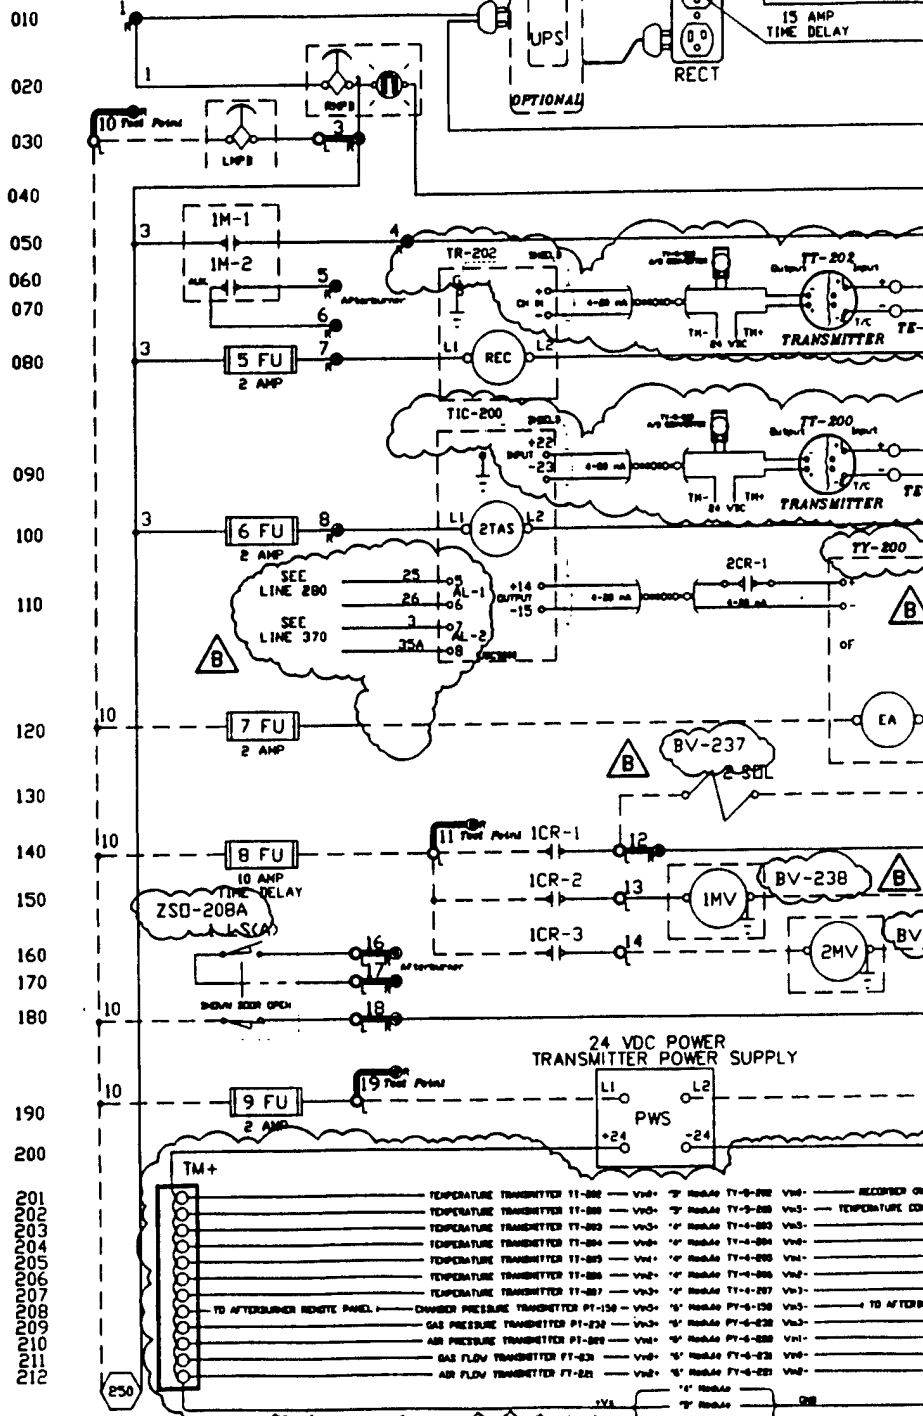

POWER REQUIREMENTS			
VOLTAGE	480 / 3 / 60		
KV	-		
H.P.	2		
FULL LOAD AMPS	L1	L2	L3
	8	8	4

Refer to Master Parts List 350 Series Numbers for individual Part Specification

①

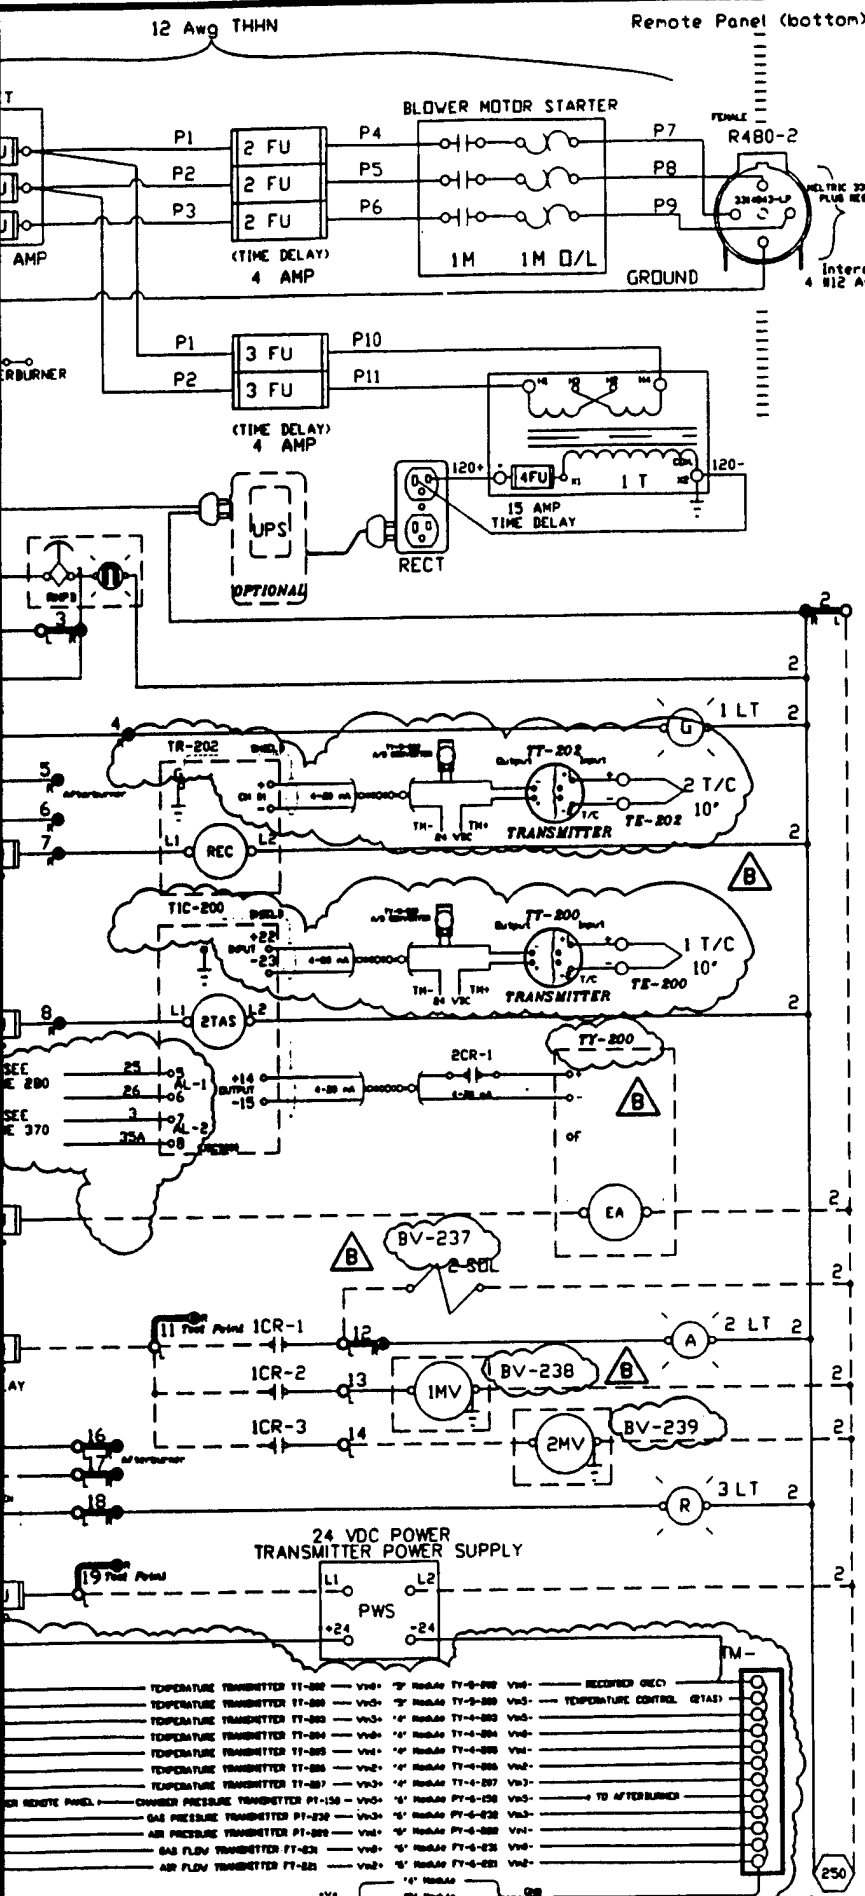

- 12 Awg THHN
- Remote Panel (bottom)
- Local Panel
- 12 Awg THHN
- BLOWER MOTOR STARTER
- BLOWER
- 2 HP.
- 3600 R.P.M
- 230/460 VAC
- 27 F.L.A.
- 145T FRAME
- 4 AMP (TIME DELAY)
- 15 AMP (TIME DELAY)
- 24 VDC POWER SUPPLY
- TRANSmitters: TR-202, TT-202, TIC-200, TT-200, BCR-1, BV-237, BV-238, BV-239, ICR-1, ICR-2, ICR-3
- RECORDERS: REC, REC
- ACTUATORS: BV-238, BV-239
- PILOTS: ICR-1, ICR-2, ICR-3
- POWER SUPPLIES: 24 VDC POWER SUPPLY, UPS (OPTIONAL)

CONTROL POWER

UNINTERRUPTABLE POWER SUPPLY

REMOTE ON/OFF

LOCAL ON/OFF (290)

COMBUSTION BLOWER ON
 COMBUSTION BLOWER ON
 Contact to Afterburner Remote Panel
 Drawg. ES120-2 Line 105

RECORDER THERMOCOUPLE

RECORDER

CONTROL THERMOCOUPLE

TEMPERATURE CONTROL

CONTROL SIGNAL

COMBUSTION GAS BUTTERFLY ACTUATOR

BLEED VALVE

FLAME ON PILOT LIGHT

ELECTRO-HYDRAULIC VALVES

DOOR CLOSED
 Contact to Afterburner Remote Panel

DOOR OPEN LIGHT

24 VDC POWER SUPPLY

DATA ACQUISITION LOOPS

Individual Part Specifications

RS485 LINK(S) TO DATALOGGER

2

FOR DATE

AP

IT

REV


Mo

DATE 5

OK

JOB NO. W

FILE NO. E

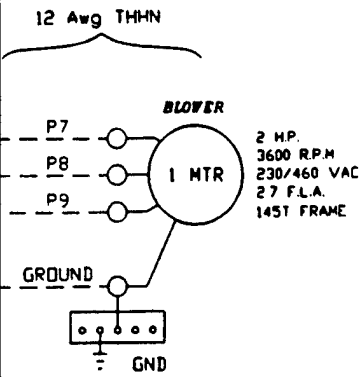

POWER SUPPLY

TURN ON
TURN ON
Turner Remote Panel
105
COUPLE

COUPLE

CONTROL

CONTROL

CONTROL

CONTROL VALVES

Turner Remote Panel

CONTROL

CONTROL

DATALOGGER

CERTIFIED FOR CONSTRUCTION

FOR JOB # WES-FBG5610-1 (1294LL)
 DATE : 9/28/94 BY : S.N.L.
 APPROVED BY : COLLEEN A. PARKER (CUSTOMER)
 DATE : 8/1/96

This is proprietary information of
 L&L SPECIAL FURNACE Co., INC.,
 which is provided in confidence.
 DO NOT DIVULGE OR TRANSFER THIS TO
 PERSONS OUTSIDE THE COMPANY TO WHICH
 IT WAS PROVIDED, OR IN ANY WAY INJURIOUS
 TO L&L SPECIAL FURNACE CO., INC.

REV#	DATE	REVISION DESCRIPTION
B	8/1/96	FIELD MODIFICATIONS
A	5.25.95	AS BUILT




L & L SPECIAL FURNACE CO., INC.

20 KENT RD. P.O. BOX 2129 ASTON, PA. 19014

WIRING DIAGRAM
 Model FBG5610 Gas Fired Furnace


DRAWN BY	<u>S.N.L.</u>	REV. CODE	DRAWING NO.
DATE	<u>5/25/95</u>	SCALE	<u>.125</u>
CHK	<u>APP</u>	<u>B</u>	<u>F928-01</u>
JOB NO.	<u>WES-FBG5610</u>	SER NO.	<u>1294LL</u>
FILE NAME	<u>FAE\W\WESTON\F928-01.DWG</u>	MADE FROM	<u>F878-01 (Hamilton Standard)</u>
		SHEET NO. <u>1</u> OF <u>4</u>	

3


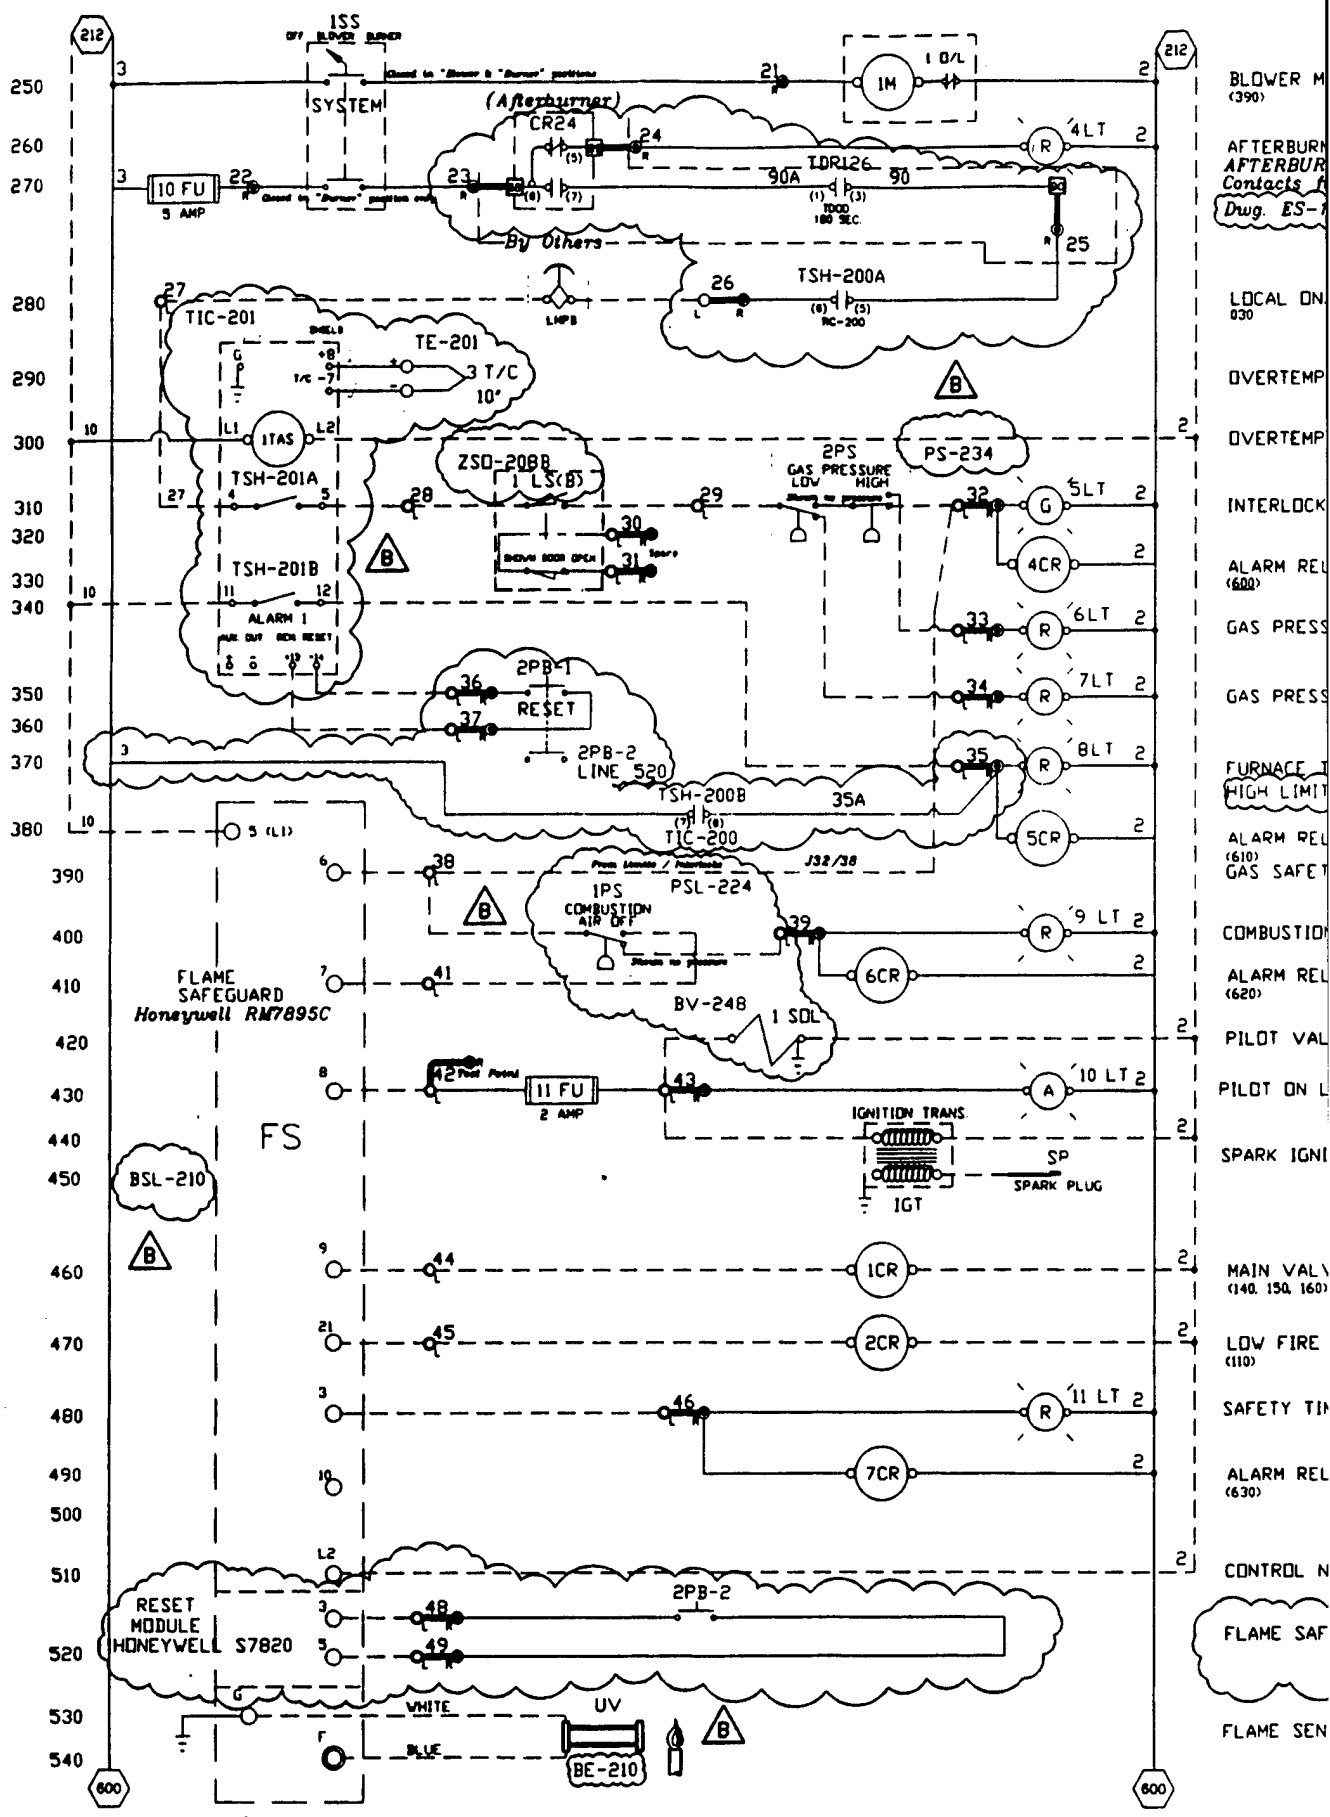


Refer to Master Parts List 350 Series Numbers for individual Part Specification



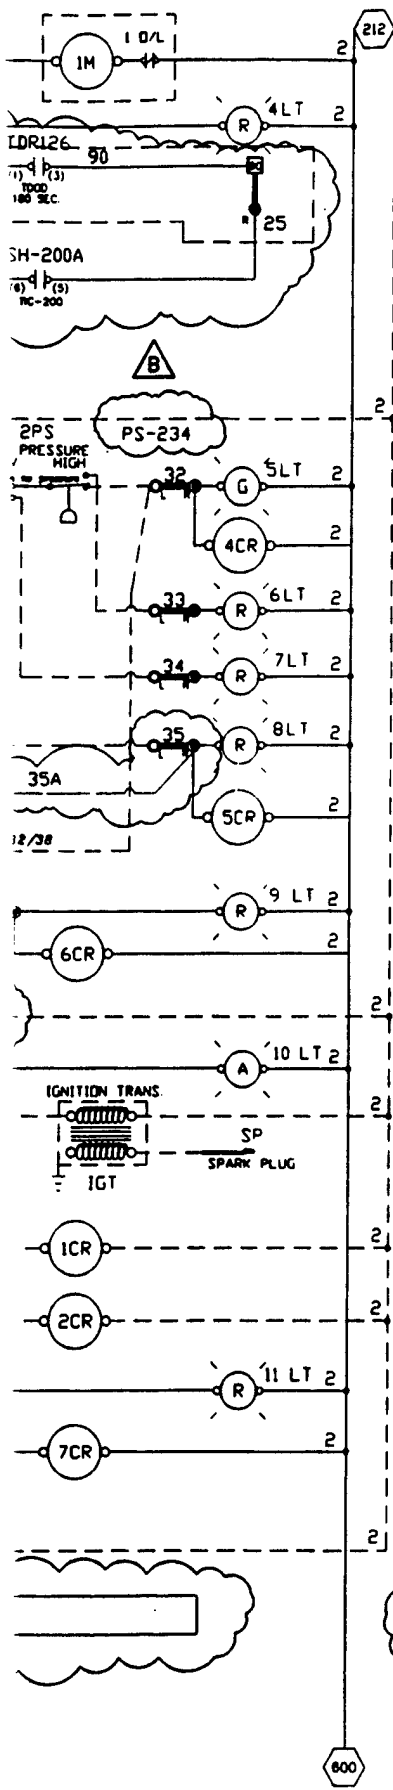

- BLOWER MOTOR CONTACTOR (390)
- AFTERBURNER OFF-LINE LIGHT
AFTERBURNER PERMISSIVES SATISFIED
Contacts from Afterburner
Dwg. ES-120-2 Line 128 to 133 **B**
- LOCAL ON/OFF 030
- OVERTEMP THERMOCOUPLE
- OVERTEMP CONTROL
- INTERLOCKS OK
- ALARM RELAY (600)
- GAS PRESSURE HIGH
- GAS PRESSURE LOW
- FURNACE TEMPERATURE HIGH
HIGH LIMIT OR CONTROL. **B**
- ALARM RELAY (610)
- GAS SAFETY INTERLOCKS
- COMBUSTION AIR LOW
- ALARM RELAY (620)
- PILOT VALVE
- PILOT ON LIGHT
- SPARK IGNITION
- MAIN VALVE (140, 150, 160)
- LOW FIRE RELAY (110)
- SAFETY TIMED OUT
- ALARM RELAY (630)
- CONTROL NEUTRAL
- FLAME SAFETY RESET
- FLAME SENSOR **B**

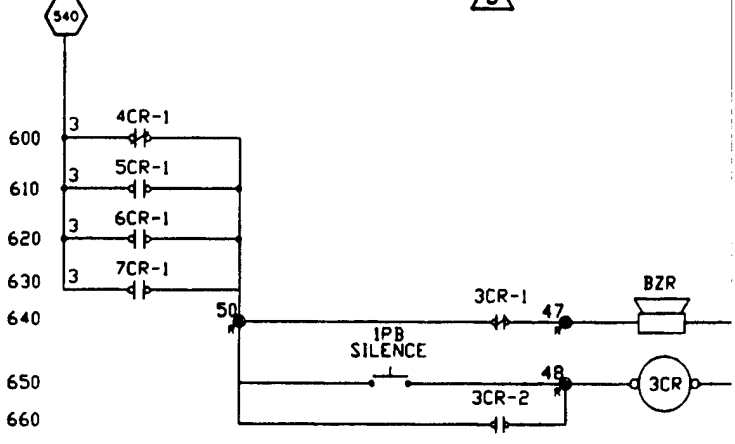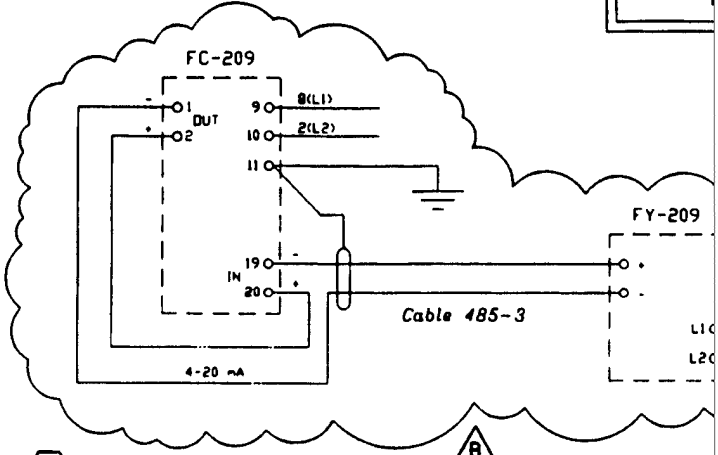

FOR JOB
DATE :
APPROV

DO
PERS
IT WA

B	B/1/8
A	B.25.9
REV#	DATE
	1988-5
Model	
DRAWN BY	
DATE 5/25/9	
JOB NO. WES-FB	
FILE NAME	


dual Part Specification


2

CERTIFIED FOR CONSTRUCTION






FOR JOB # WES-FBG5610-1 (1294LL)
 DATE : 9/28/94 BY : S.N.L.
 APPROVED BY : COLLEEN A. PARKER
 DATE : 8/1/96 (CUSTOMER)

This is proprietary information of
 L&L SPECIAL FURNACE Co., INC.,
 which is provided in confidence.
 DO NOT DIVULGE OR TRANSFER THIS TO
 PERSONS OUTSIDE THE COMPANY TO WHICH
 IT WAS PROVIDED, OR IN ANY WAY INJURIOUS
 TO L&L SPECIAL FURNACE CO., INC.

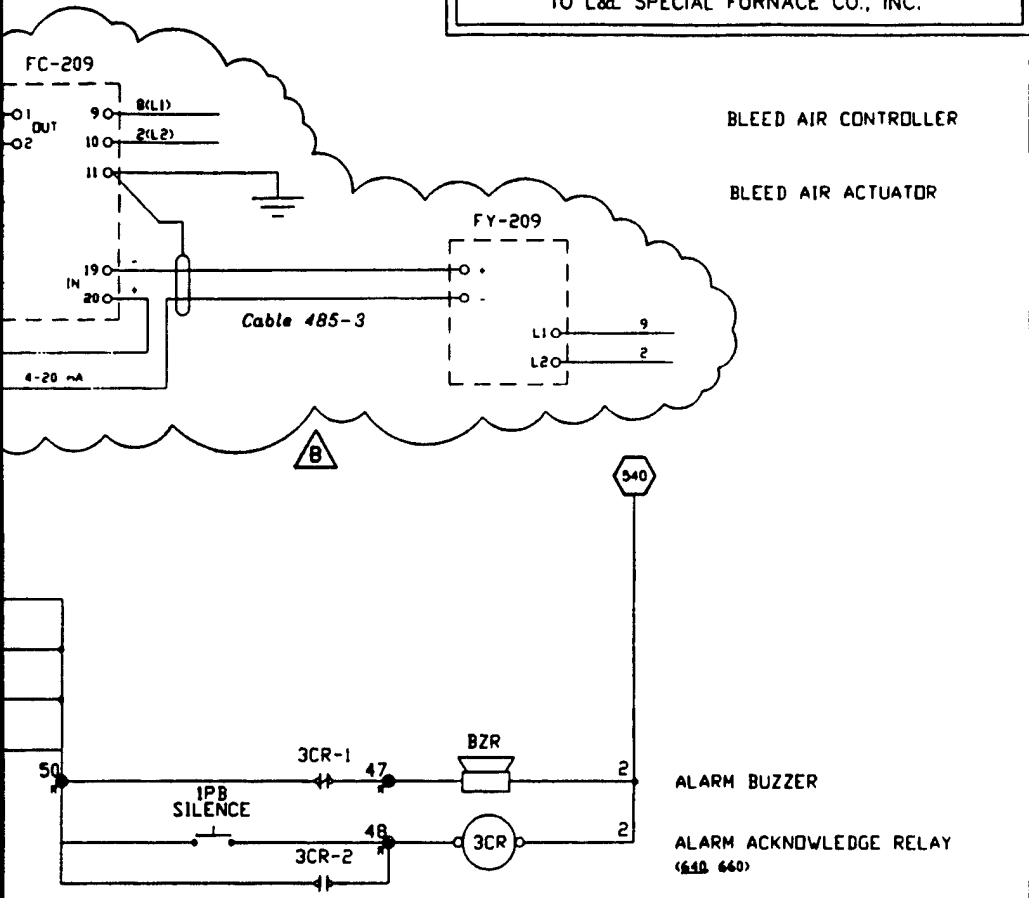


REV#	DATE	REVISION DESCRIPTION
B	8/1/96	FIELD MODIFICATIONS
A	5.25.95	AS BUILT
 L & L SPECIAL FURNACE CO., INC. 20 KENT RD. P.O. BOX 2128 ASTON, PA. 19014		
WIRING DIAGRAM Model FBG5610 Gas Fired Furnace		
DRAWN BY	S.N.L.	REV. CODE
DATE	5/25/95	SCALE .125
CHK		APP
JOB NO.	WES-FBG5610	SER NO. 1294LL
FILE NAME	F:\A\WESTON\F928-01.DWG	MADE FROM F928-01 (Hamilton Standard)
DRAWING NO. B F928-01		SHEET NO. 2 OF 4

3

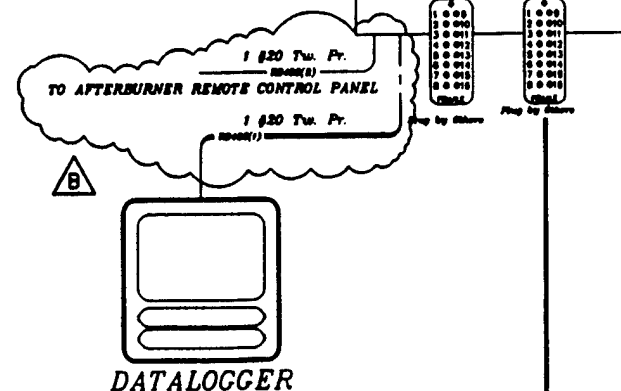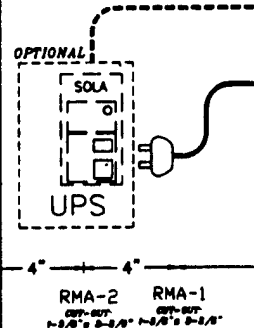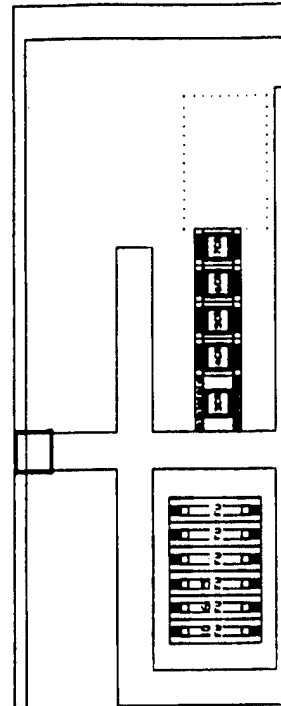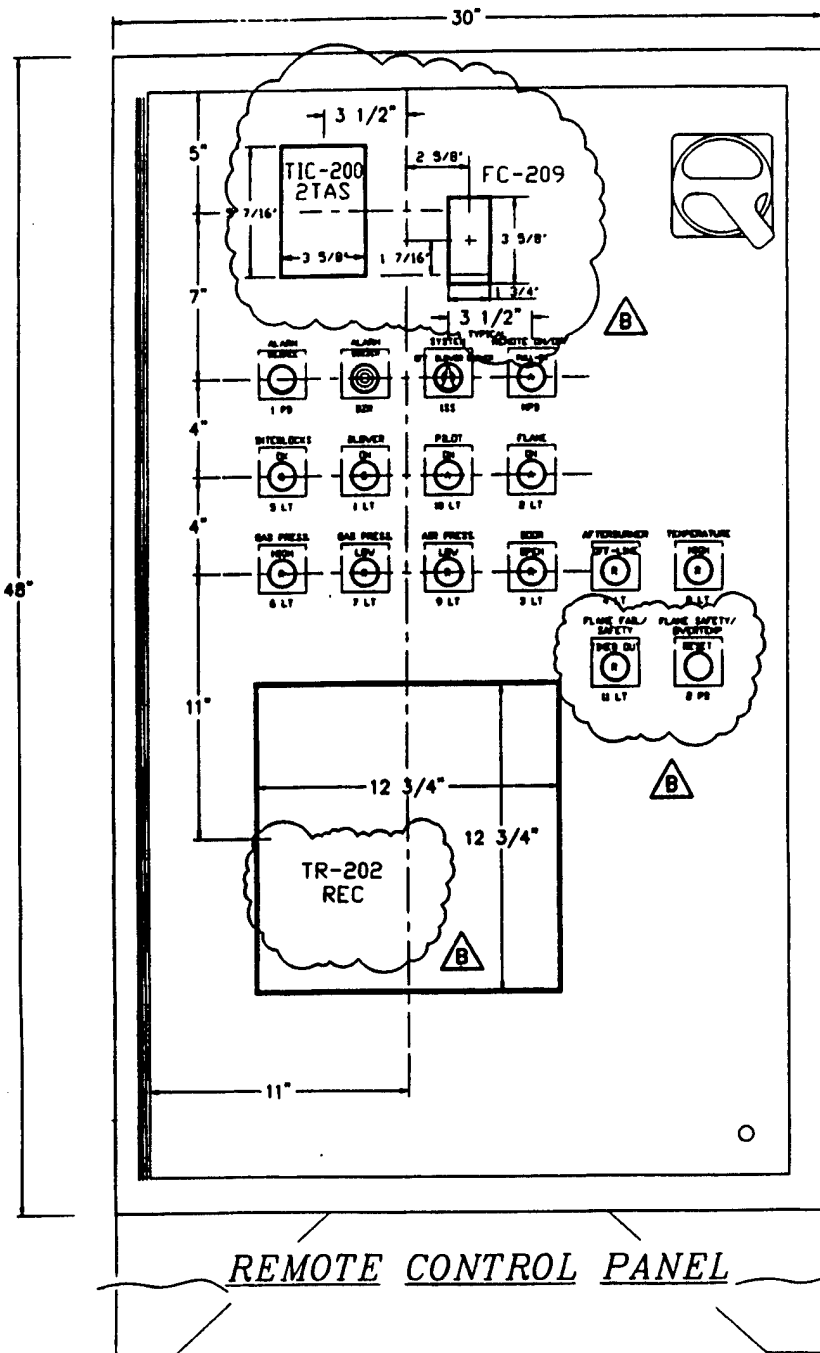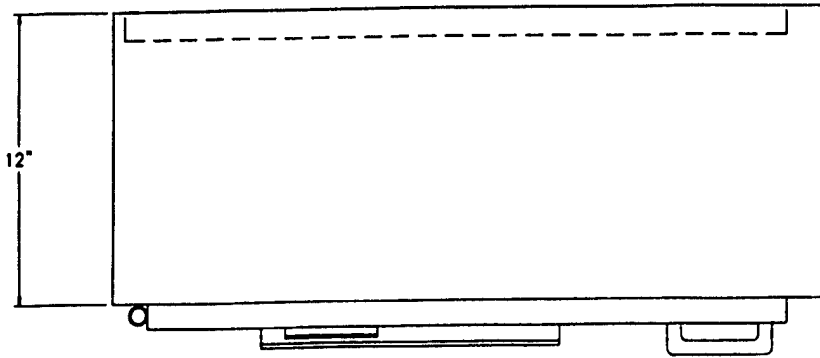

Refer to Master Parts List 350 Series Numbers for individual Part Specification

7

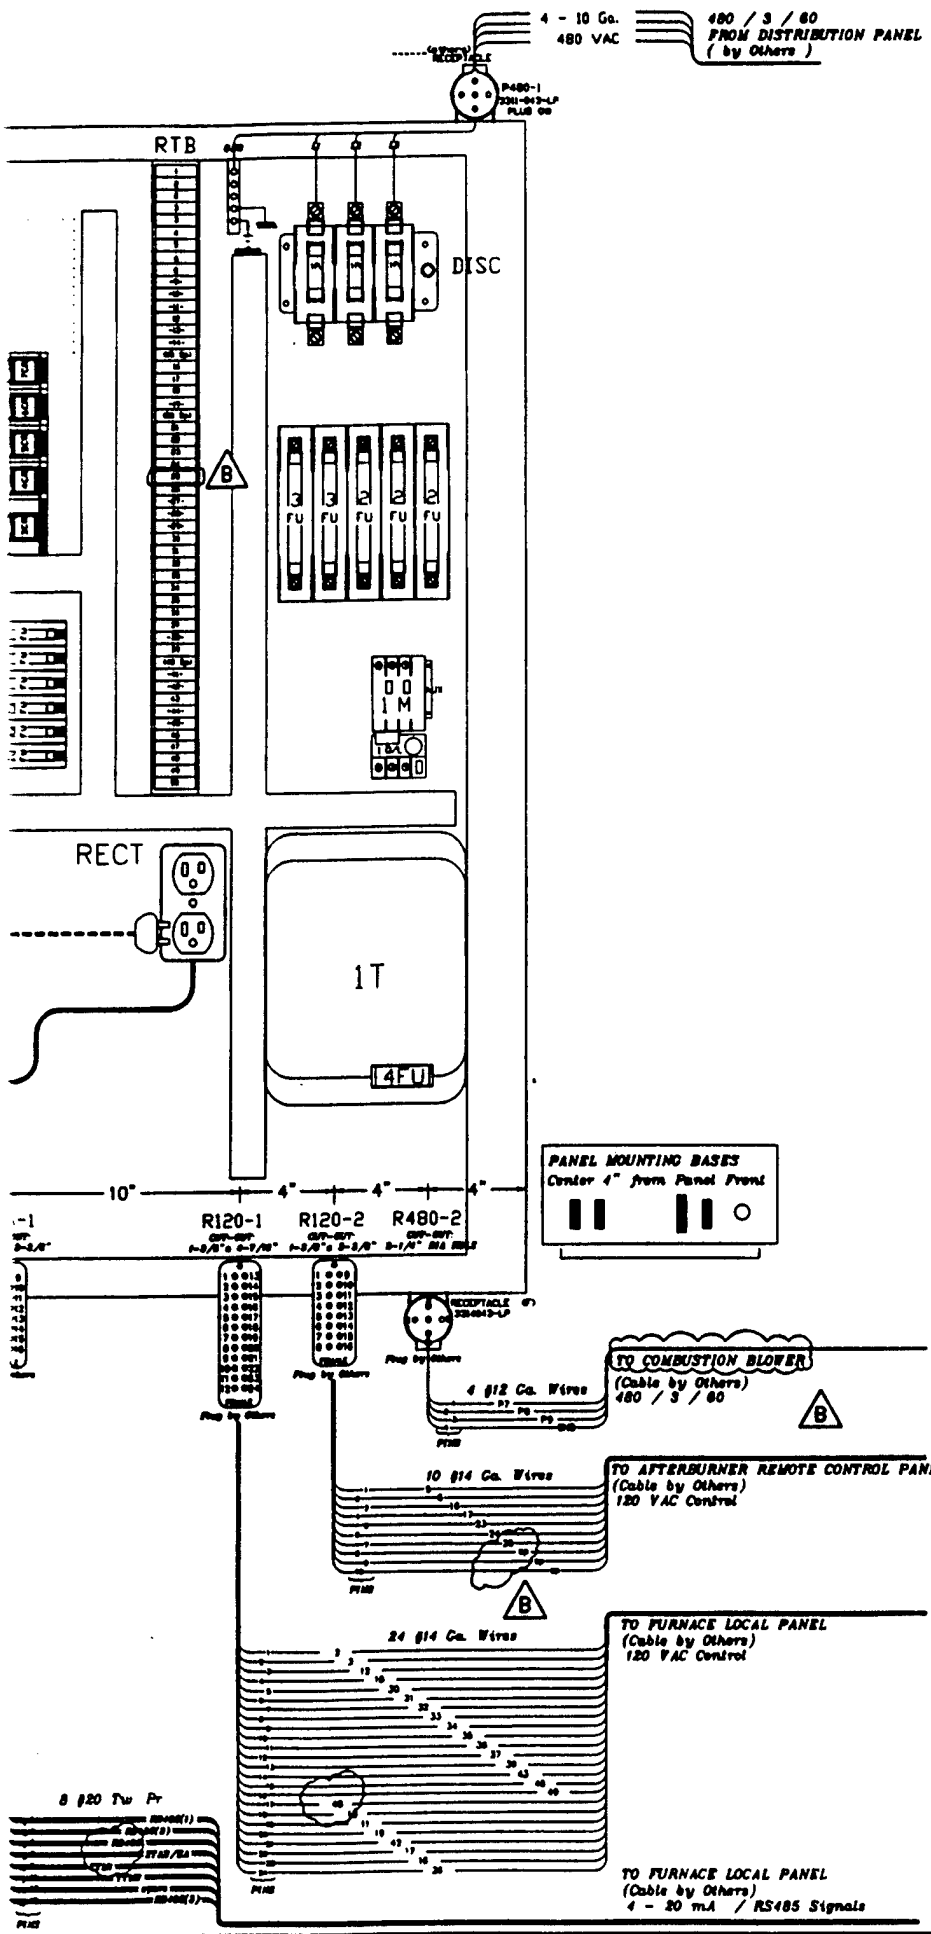

CERTIFIED FOR CONSTRUCTION

FOR JOB # WES-FBG5610-1 (1294LL)
 DATE : 9/28/94 BY : S.N.L.
 APPROVED BY : COLLEEN A. PARKER
 DATE : 8/1/96 (CUSTOMER)

This is proprietary information of L&L SPECIAL FURNACE Co., INC., which is provided in confidence. DO NOT DIVULGE OR TRANSFER THIS TO PERSONS OUTSIDE THE COMPANY TO WHICH IT WAS PROVIDED, OR IN ANY WAY INJURIOUS TO L&L SPECIAL FURNACE CO., INC.

REV#	DATE	REVISION DESCRIPTION
B	8/1/96	FIELD MODIFICATIONS
A	5.25.95	AS BUILT


L & L SPECIAL FURNACE CO., INC.
 20 KENT RD. P.O. BOX 2129 ASTON, PA. 19014

WIRING DIAGRAM
 Model FBG5610 Gas Fired Furnace

DRAWN BY <u>S.N.L.</u>	REV. CODE <u>B</u>	DRAWING NO. <u>F928-01</u>
DATE <u>5/25/95</u>	SCALE <u>.25</u>	
CHECK	APP	
JOB NO. <u>WES-FBG5610</u>	SER NO. <u>1294LL</u>	SHEET NO. <u>3 of 4</u>
FILE NAME <u>F:\C\W\WESTON\F928-01.DWG</u>	MADE FROM <u>F878-01 (Hamilton Standard)</u>	


(2)

LOCAL FURNACE MOUNTED CABINET

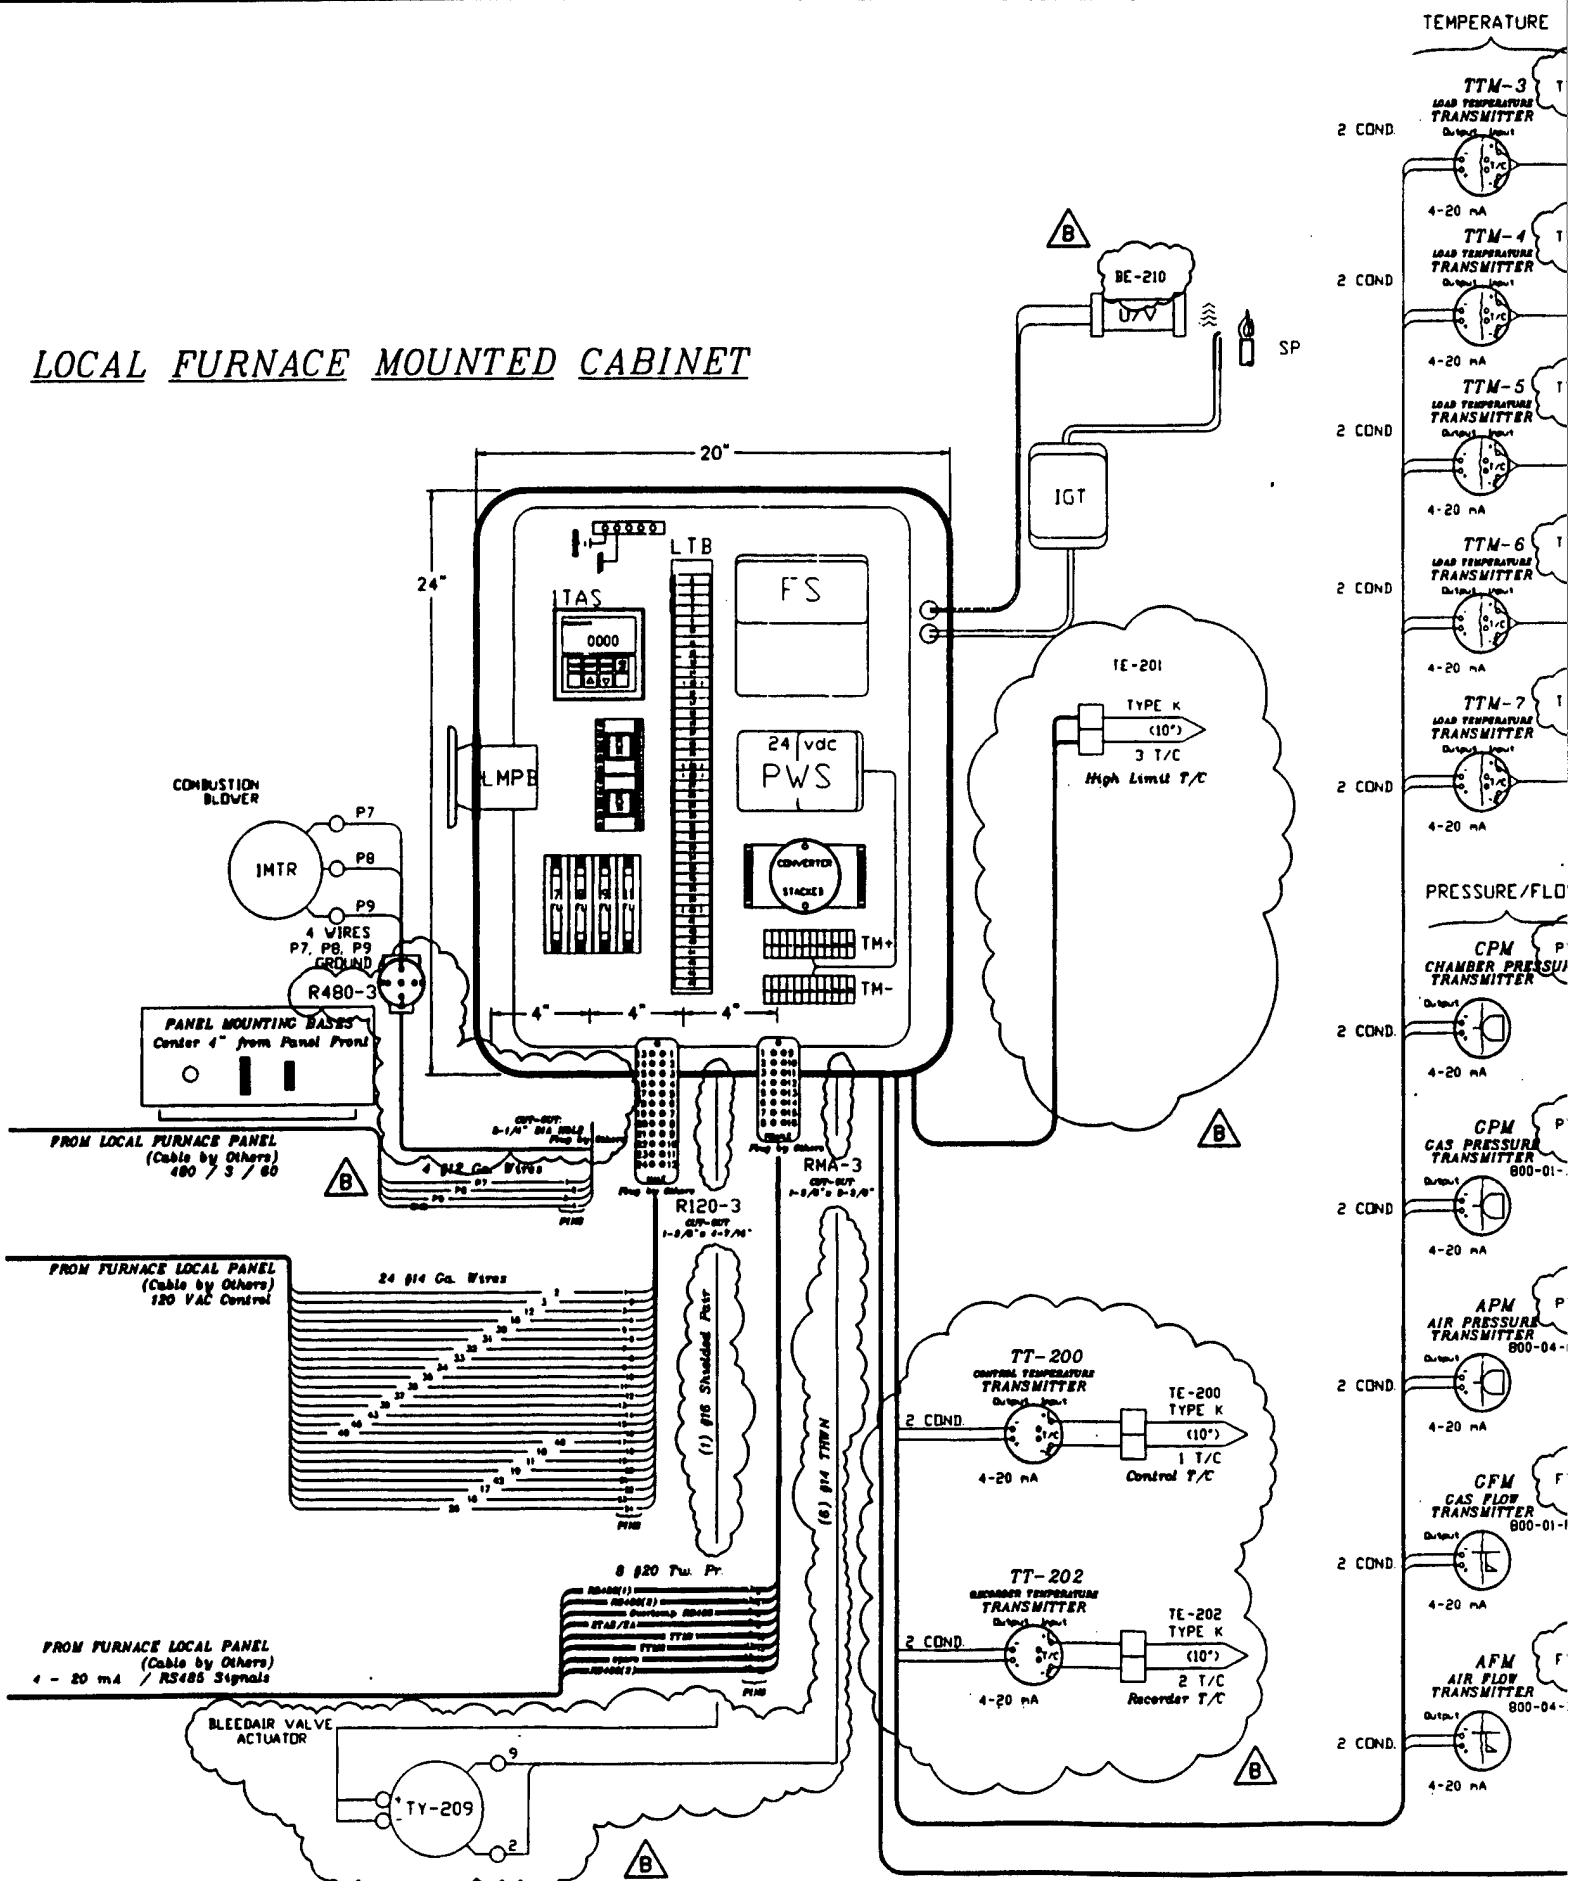

Refer to Master Parts List 350 Series Numbers for individual Part Specification

①

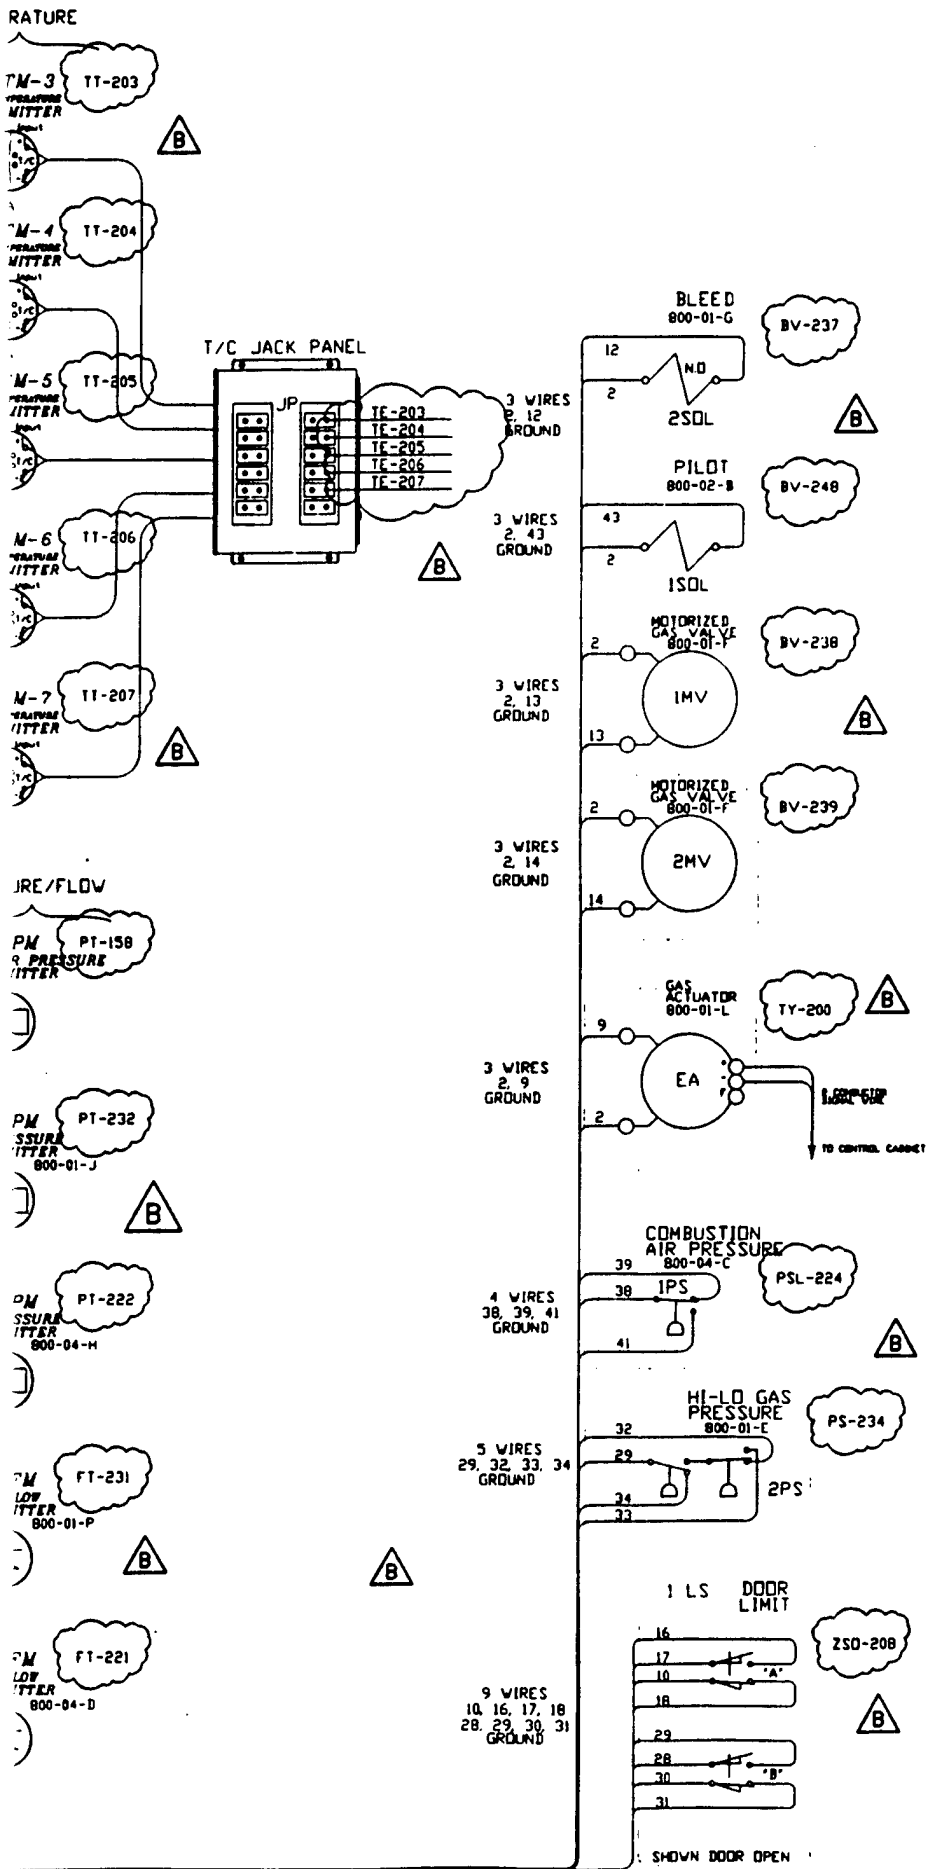

CERTIFIED FOR CONSTRUCTION

FOR JOB # WES-FBG5610-1 (1294LL)
 DATE: 9/28/94 BY: S.N.L.
 APPROVED BY: COLLEEN A. PARKER (CUSTOMER)
 DATE: 8/1/96

This is proprietary information of
 L&L SPECIAL FURNACE Co., INC.
 which is provided in confidence
 DO NOT DIVULGE OR TRANSFER THIS TO
 PERSONS OUTSIDE THE COMPANY TO WHICH
 IT WAS PROVIDED, OR IN ANY WAY INJURIOUS
 TO L&L SPECIAL FURNACE CO., INC.

REV#	DATE	REVISION DESCRIPTION
B	8/1/96	FIELD MODIFICATIONS
A	5.25.95	




L & L SPECIAL FURNACE CO., INC.
 20 KENT RD. P.O. BOX 2129 ASTON, PA. 19014

WIRING DIAGRAM
 Model FBG5610 Gas Fired Furnace

DRAWN BY: <u>S.N.L.</u>	REV. CODE: <u>B</u>	DRAWING NO. <u>F928-01</u>
DATE: <u>5/25/95</u>	SCALE: <u>.125</u>	
CHK: <u>APP</u>		
JOB NO. <u>WES-FBG5610</u>	SER NO. <u>1294LL</u>	SHEET NO. <u>4</u> OF <u>4</u>
FILE NAME: <u>FA01WESFBG5610-01.DWG</u>	MADE FROM: <u>FBG5610-01 (MAGNIFICENT)</u>	


2

CASE SEAL
1" THICK 2300°F
CERAMICS BOARD

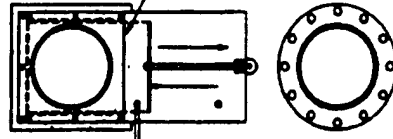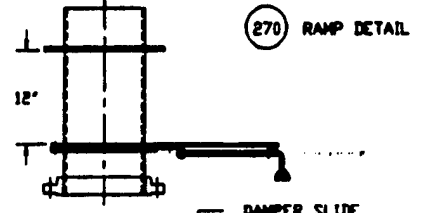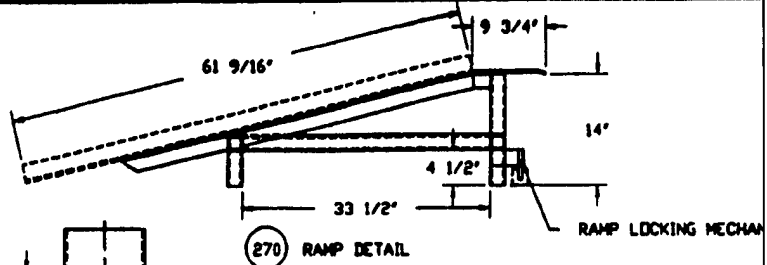


PADLOCK DAMPER
IN CLOSED POSITION

(210) AIR INLET PIPE AND DAMPER DETAIL

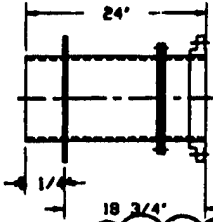

DOOR CLAMPS
(6) REQ'D.

DOOR HINGE POINT

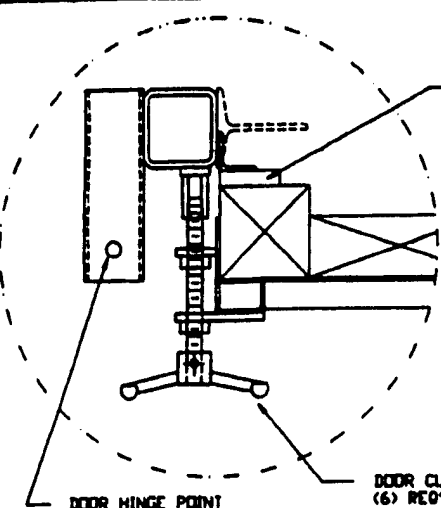

CASE
(119)

SEAL COVER

INSULATION
4" THICK 2300°F, 10 LBS DENSITY
THERMAL CERAMICS PYROBLOCK

AIR INLET PIPE
(210)

CASE
(119)


SEAL COVER

SEE NOTE 1
10" Sch 40 304 SS PIPE
150 LBS S.S. FLANGE
TO AFTERBURNER

CASE
(119)

CAGE HANGER

(110 04)

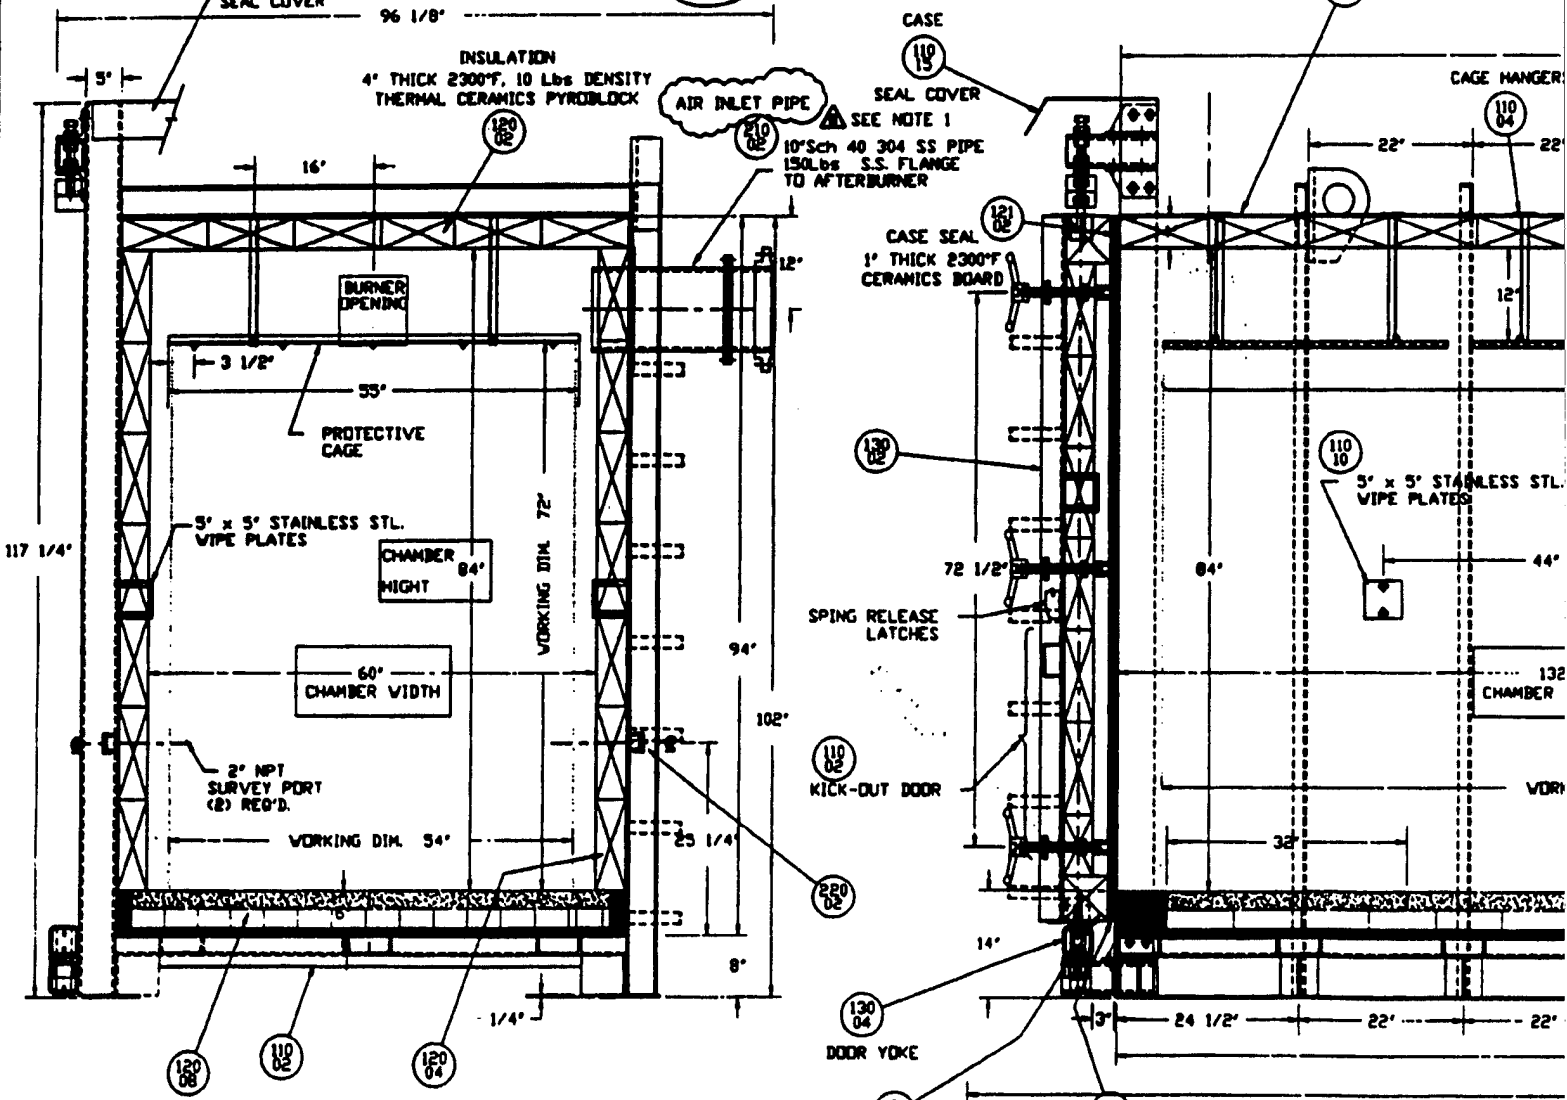


FRONT VIEW

DOOR SEAL
6" THICK 2300°F, 8 LBS DENSITY
THERMAL CERAMICS PYROBLOCK


CASE SEAL
1" THICK 2300°F
CERAMICS BOARD

SIDE

MECHANISM

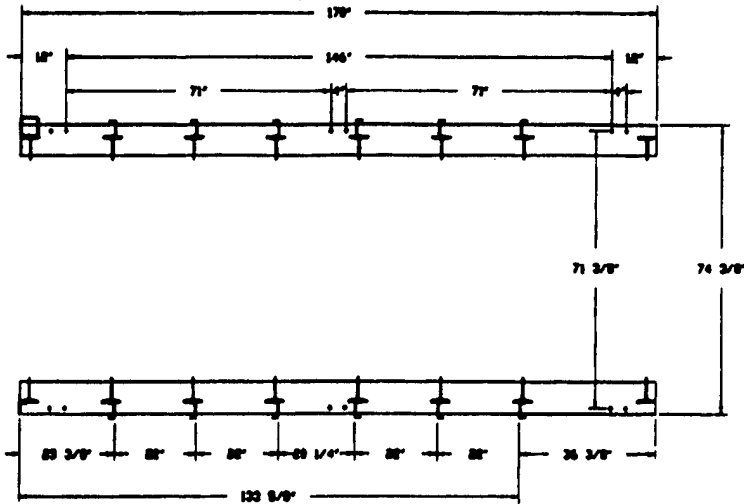

FOUNDATION LAYOUT

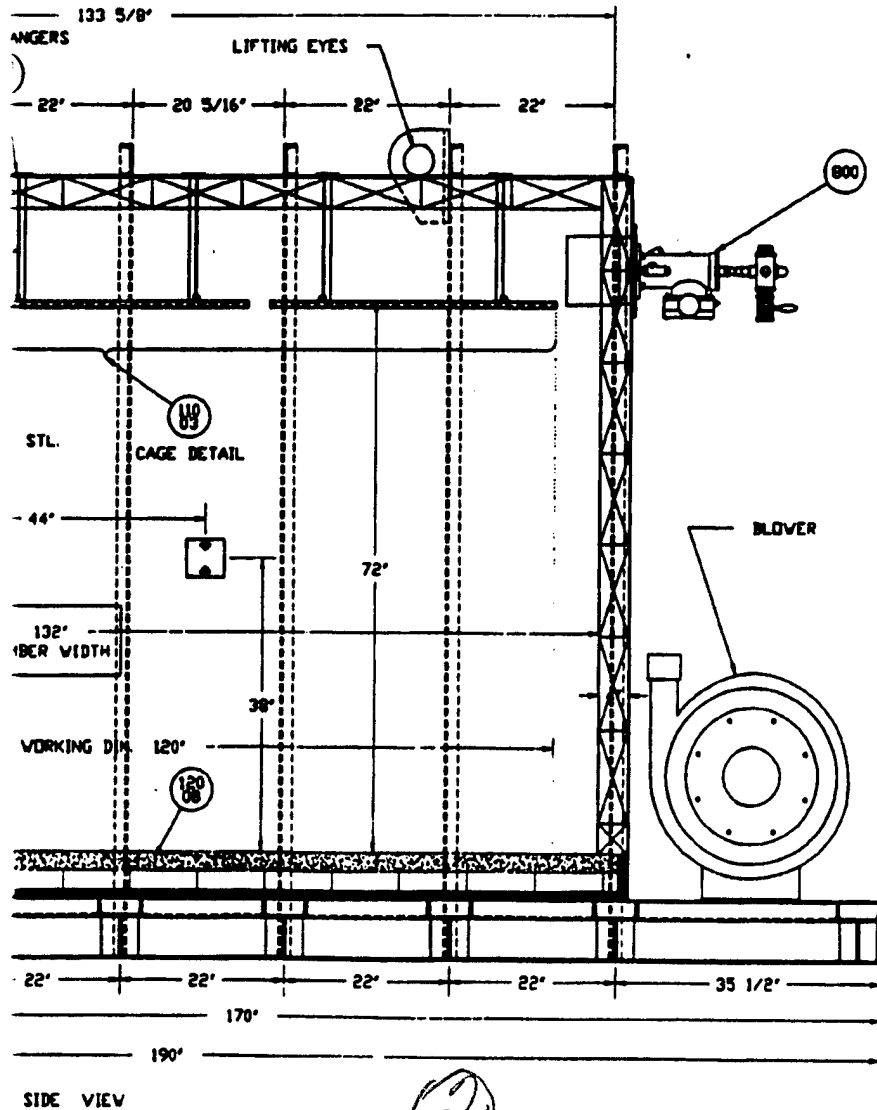

SIDE VIEW

MAJOR SPECIFICATIONS

VOLTAGE	480 VAC/ 3/ 60
HP / AMPS	2 HP / 10 AMPS
MAXIMUM BTUS/HR	1,000,000
GAS INLET PRESSURE	5 PSI
MAX TEMP	1200°F
WORKING DIMENSIONS	54' V x 72' H x 120' D
CHAMBER DIMENSIONS	60' V x 84' H x 132' D
HEARTH	CASTABLE SECTIONS
MAX LOAD	3000 Lbs
GAS BURNER SYSTEM	ECLIPSE HVTA 104
ATMOSPHERE	AIR
CIRCULATION	BURNER VELOCITY
DOOR	DOUBLE PIVOTED HORIZONTAL
PAINT / FINISH	BLACK HIGH TEMP PRIMER WITH GREY-GREEN ENAMEL

CERTIFIED FOR CONSTRUCTION

FOR JOB # WES-FBG5610-1
 SERIAL NO: S/N 1294LL
 DATE: 10.11.94 BY: Gregory D. Lewicki
 APPROVED BY: COLLEEN A. PARKER
 DATE: 8/1/98 (CUSTOMER)

NOTES:

- SEE WESTON DRAWINGS 1300-01, 02, & 03 FOR EXHAUST DUCT MODIFICATIONS.

DO NOT SCALE THIS DRAWING. REFERENCED SCALE WAS CHANGED IN ORDER TO FIT THE DRAWING ON THE STANDARD SIZE DRAWING SHEET

This is proprietary information of L&L SPECIAL FURNACE CO., INC., which is provided in confidence. DO NOT DIVULGE OR TRANSFER THIS TO PERSONS OUTSIDE THE COMPANY TO WHICH IT WAS PROVIDED, OR IN ANY WAY INJURIOUS TO L&L SPECIAL FURNACE CO., INC.


REV#	DATE	REVISION DESCRIPTION
B	8/1/98	FIELD MODIFICATIONS
A	8/1/98	AS BUILT

L & L SPECIAL FURNACE CO, INC
 20 KIDIT RD. P.O. BOX 2129 ASTON, PA. 19014

MODEL FBG5610
 GENERAL DIMENSION
 AND
 ASSEMBLY

DRAWN BY	Andre Merdjanian	REV CODE	B	DRAWING NO.	F928-02
DATE	9-28-94	SCALE	-		
CHK		APP			


JOB NO.	WES-FBG5610-1	SER NO.	1294LL	SHEET NO.	1 of 2
FILE NAME	C:\DRAWING\WES\FBG5610\F928-02			MADE FROM	SCRATCH

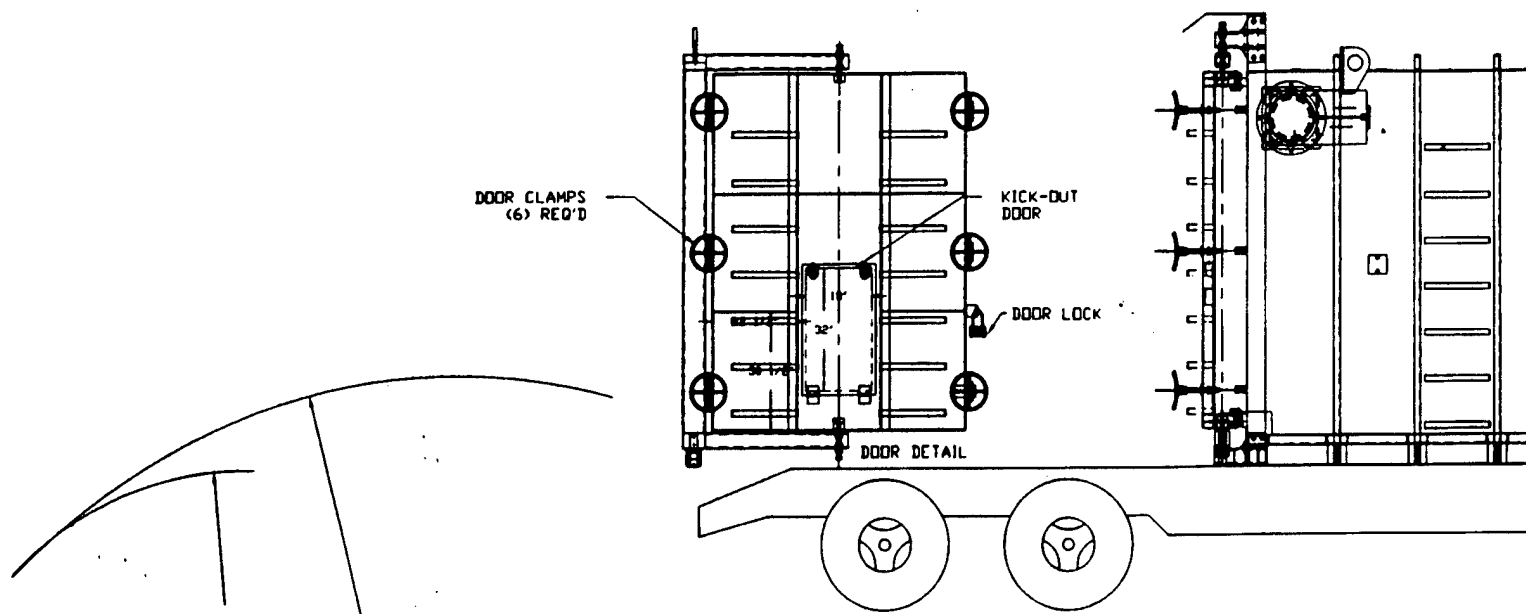


R41 29/32"

R82 57/64"

GAS TRAIN

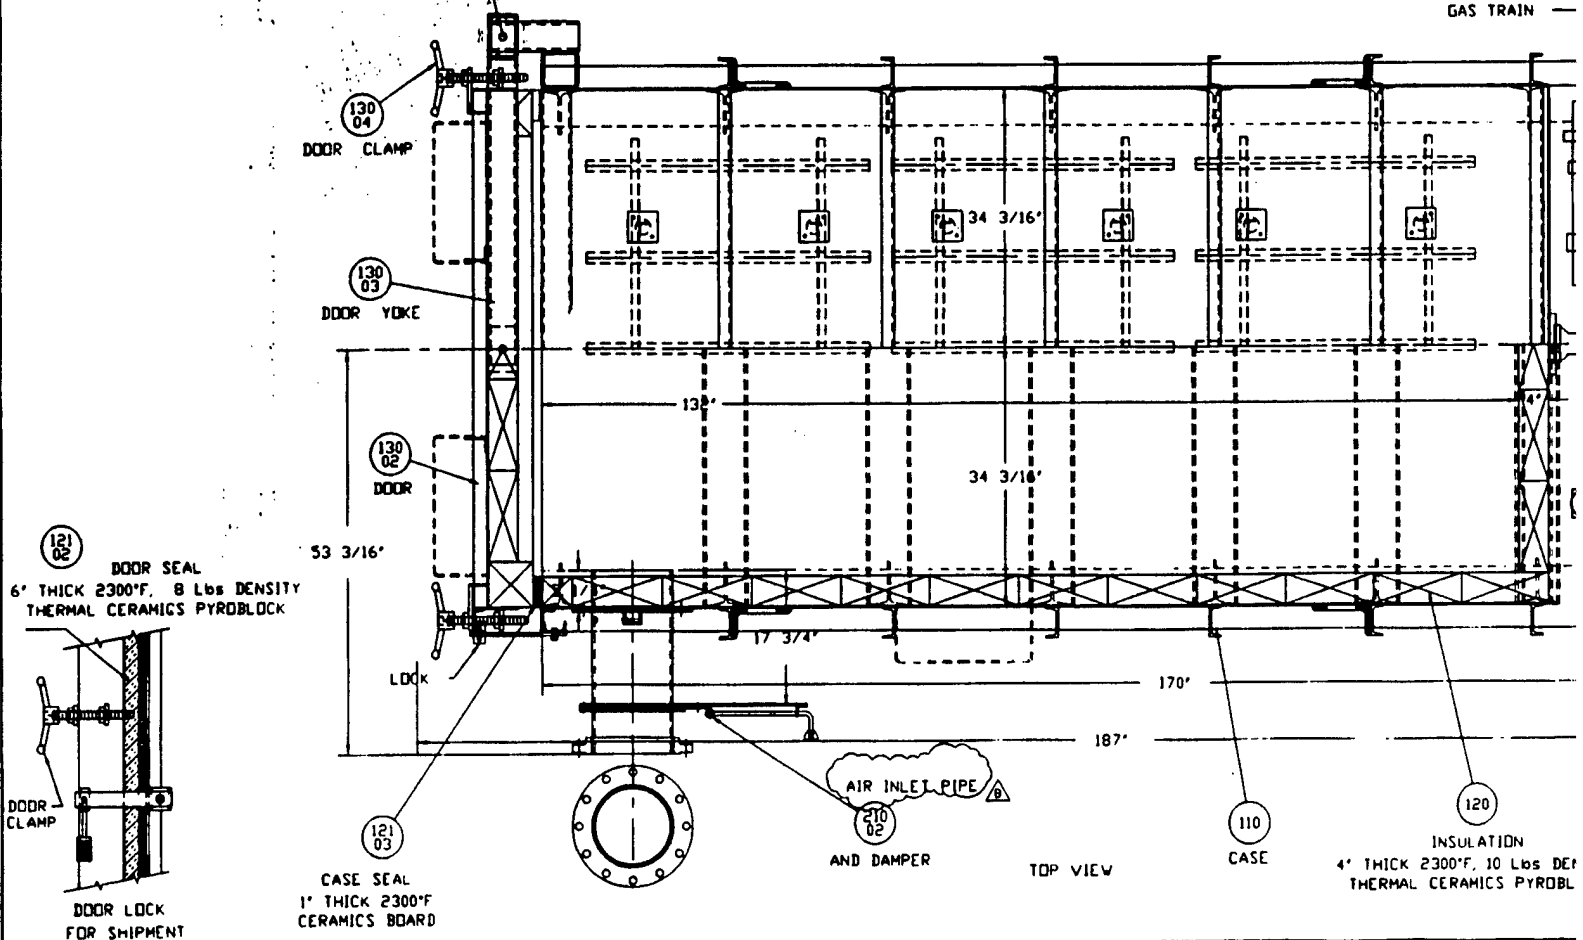

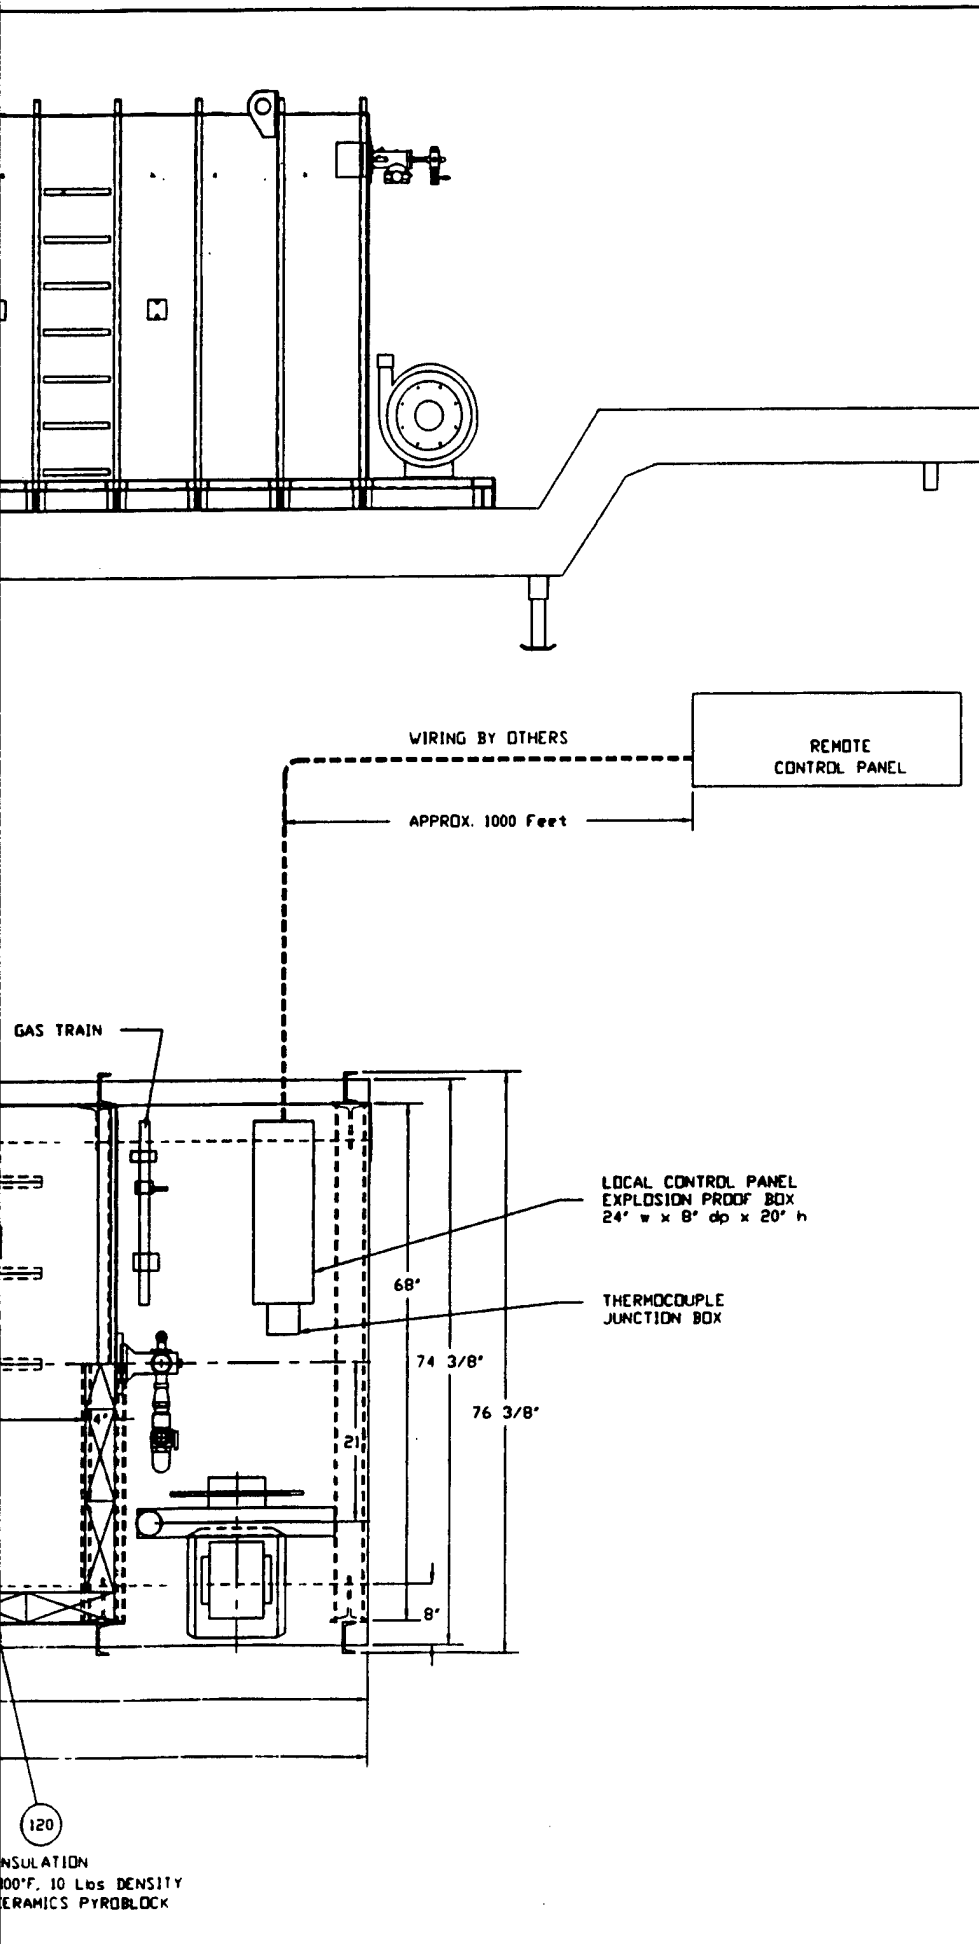

MAJOR SPECIFICATIONS	
VOLTAGE	480 VAC / 3 / 60
HP / AMPS	2 HP / 10 AMPS
MAXIMUM BTUS/HOUR	1,000,000
GAS INLET PRESSURE	5 PSI
MAX TEMP	1200°F
WORKING DIMENSIONS	54" W x 72" H x 120" D
CHAMBER DIMENSIONS	60" W x 84" H x 132" D
HEARTH	CASTABLE SECTIONS
MAX LOAD	3000 Lbs
GAS BURNER SYSTEM	ECLIPSE HVTA 104
ATMOSPHERE	AIR
CIRCULATION	BURNER VELOCITY
DOOR	DOUBLE PIVOTED HORIZONTAL
PAINT / FINISH	BLACK HIGH TEMP PRIMER WITH GREY-GREEN ENAMEL

CERTIFIED FOR CONSTRUCTION

FOR JOB # WES-FBG5610-1

SERIAL NO. S/N 1294LL

DATE 10.11.94 BY Gregory D Lewicki

APPROVED BY [Signature]

DATE 8/1/96 (CUSTOMER)

This is proprietary information of L&L SPECIAL FURNACE CO., INC., which is provided in confidence. DO NOT DIVULGE OR TRANSFER THIS TO PERSONS OUTSIDE THE COMPANY TO WHICH IT WAS PROVIDED, OR IN ANY WAY INJURIOUS TO L&L SPECIAL FURNACE CO., INC



REV#	DATE	REVISION DESCRIPTION
B	8/1/96	FIELD MODIFICATIONS
A	5/1/95	AS BUILT

L & L SPECIAL FURNACE CO, INC
 20 KENT RD. P.O. BOX 2129 ASTON, PA. 19014

MODEL FBG5610
 GENERAL DIMENSION
 AND
 ASSEMBLY

DRAWN BY <u>Andre Merdjanian</u>	REV CODE	DRAWING NO
DATE <u>9-28-94</u>	SCALE <u>-</u>	B F928-02
CHK	APP	
JOB NO <u>WES-FBG5610-1</u>	SER NO <u>1294LL</u>	SHEET NO <u>2 of 2</u>
FILE NAME <u>F:\V\WESTON\FBG5610\F928-02</u>	MADE FROM	SCRATCH

20

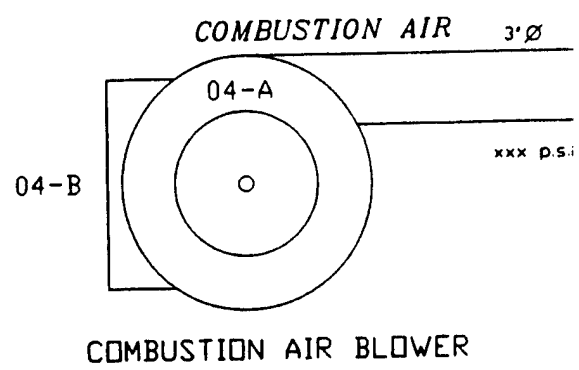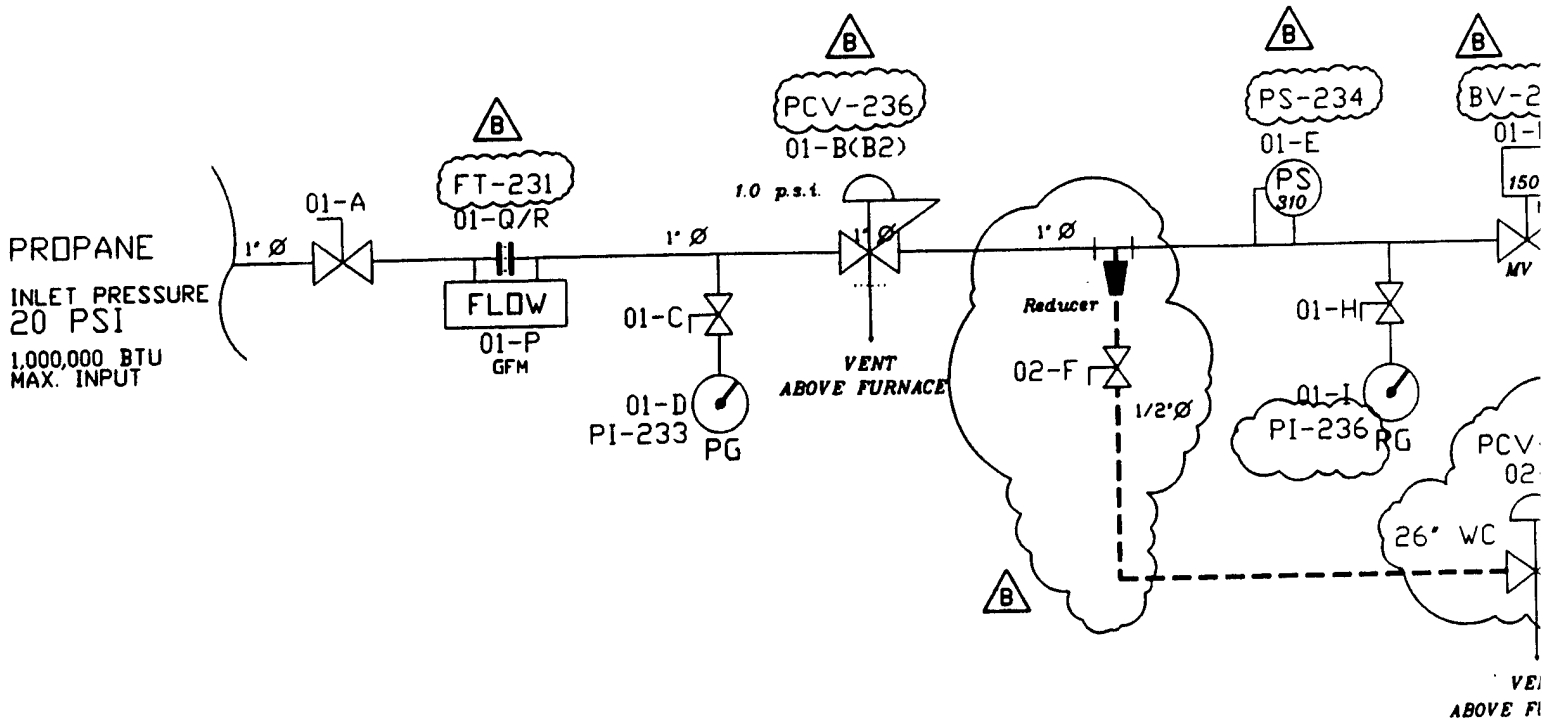

LEGEND:

- 800-01-..... ----- MAIN GAS TRAIN
- 800-02-..... ----- PILOT GAS TRAIN
- 800-03-..... ----- HVTA SYSTEM
- 800-04-..... ----- COMBUSTION AIR SYSTEM
- 800-05-..... ----- FLAME SAFETY & IGNITION SYSTEM

150 } Cross Reference to Electrical Drawing (F928-01)
 GFM }


1


This is proprietary information of
 L&L SPECIAL FURNACE Co., INC.,
 which is provided in confidence.
 DO NOT DIVULGE OR TRANSFER THIS TO
 PERSONS OUTSIDE THE COMPANY TO WHICH
 IT WAS PROVIDED, OR IN ANY WAY INJURIOUS
 TO L&L SPECIAL FURNACE CO., INC.

CERTIFIED FOR CONSTRUCTION





FOR JOB # WES-FBG5610-1 (1294LL)
 DATE : 9/28/94 BY : S.N.L.

APPROVED BY : _____ (CUSTOMER)
 DATE : _____

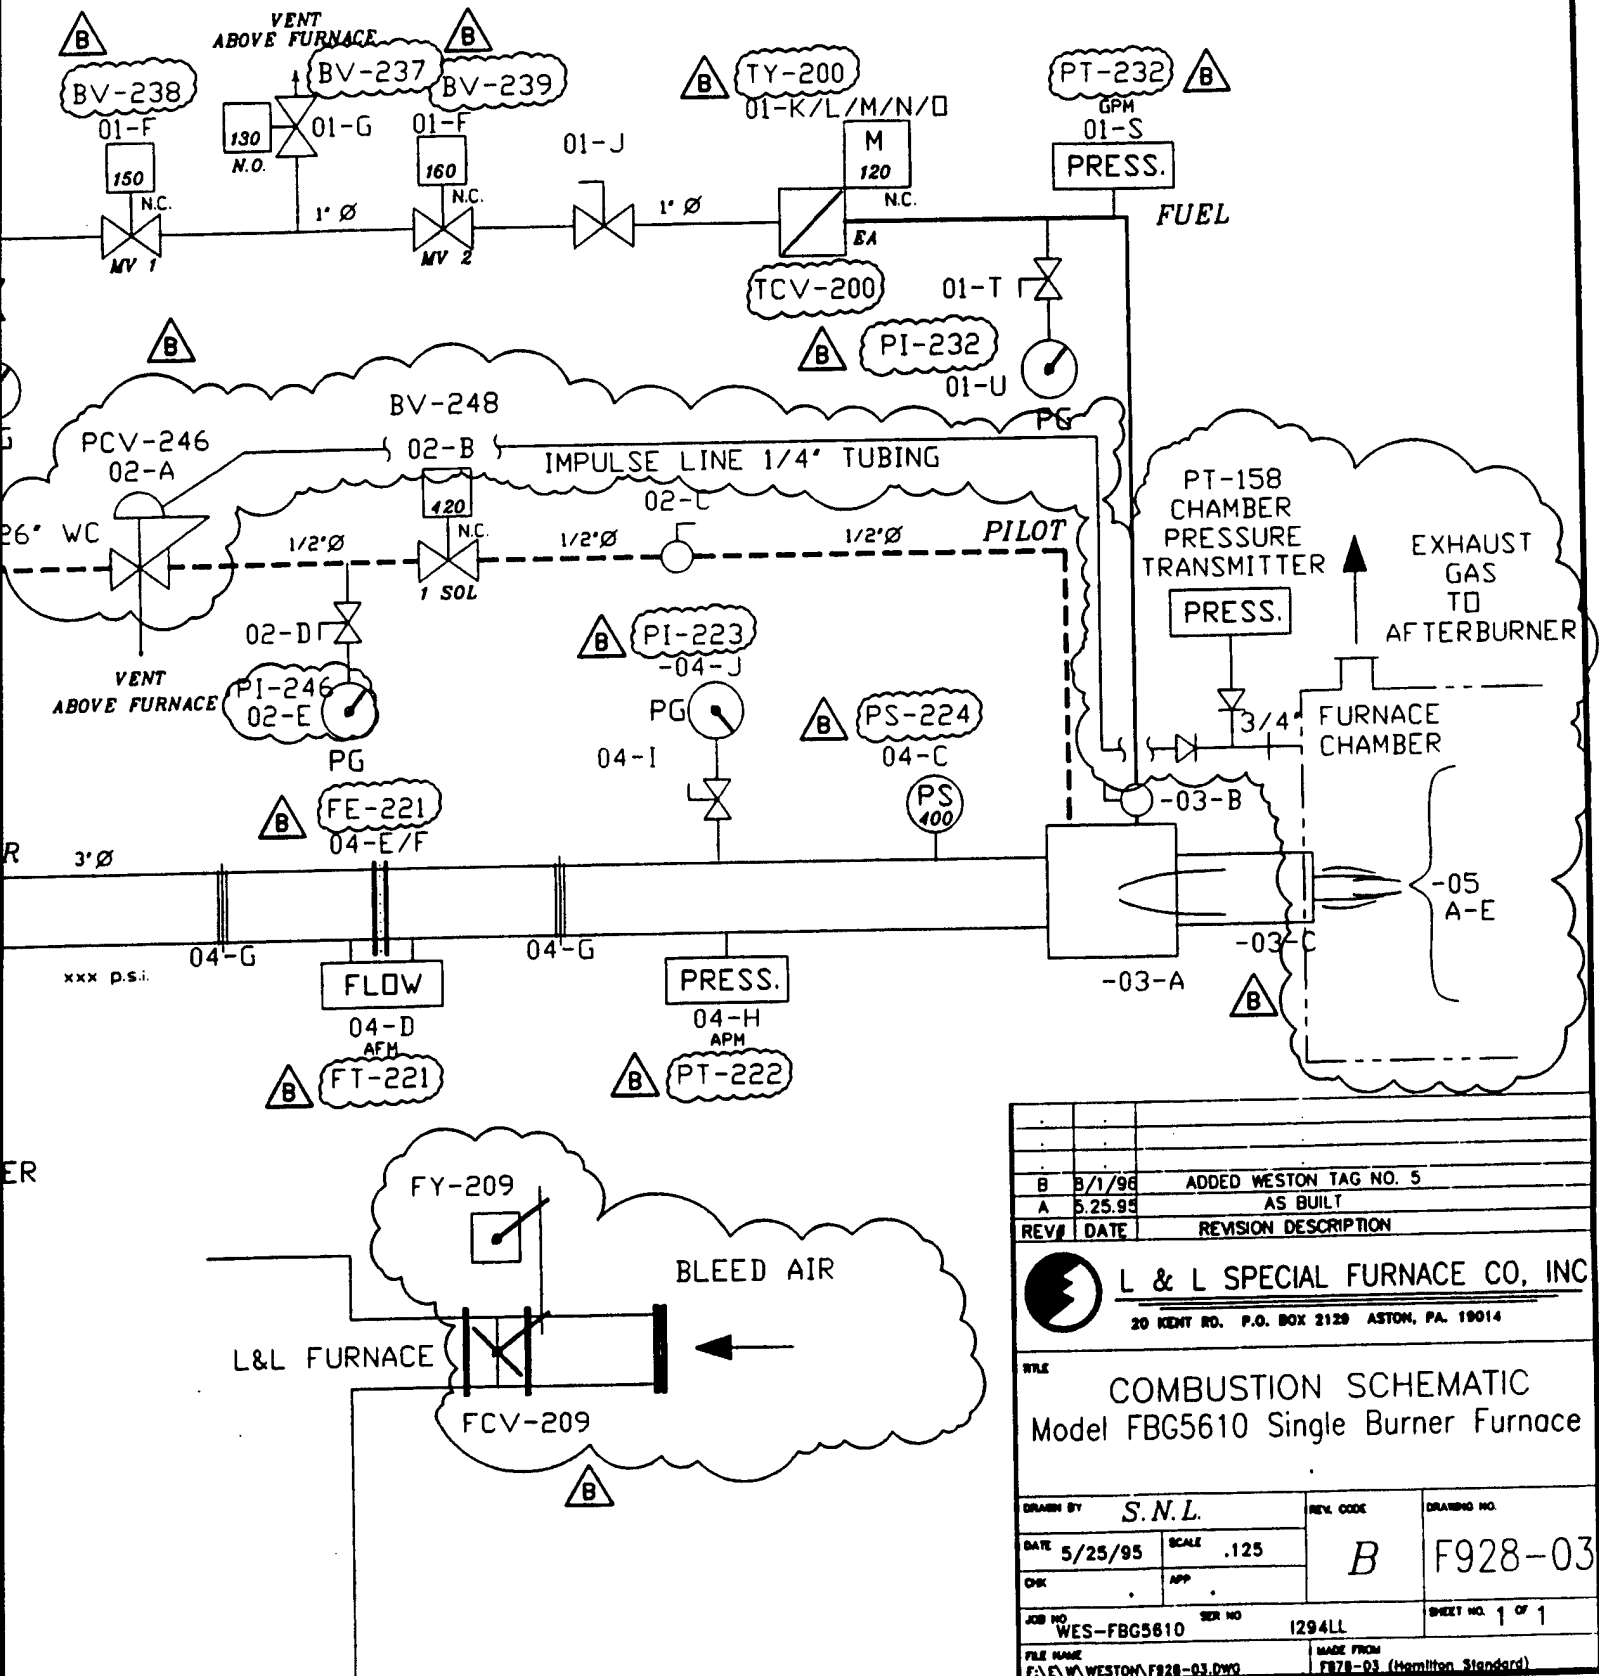



REV#	DATE	REVISION DESCRIPTION
B	8/1/98	ADDED WESTON TAG NO. 5
A	5.25.95	AS BUILT
 L & L SPECIAL FURNACE CO., INC 20 KENT RD. P.O. BOX 2129 ASTON, PA. 19014		
COMBUSTION SCHEMATIC Model FBG5610 Single Burner Furnace		
DRAWN BY <u>S.N.L.</u> DATE <u>5/25/95</u> CHK <u>APP</u>	REVISION CODE <u>B</u> SCALE <u>.125</u>	DRAWING NO. <u>F928-03</u> SHEET NO. <u>1</u> OF <u>1</u>
JOB NO. <u>WES-FBG5610</u> SER NO. <u>1294LL</u>		MADE FROM <u>F928-03 (Hamilton Standard)</u>
FILE NAME <u>F:\V\WESTON\F928-03.PWG</u>		

(2)

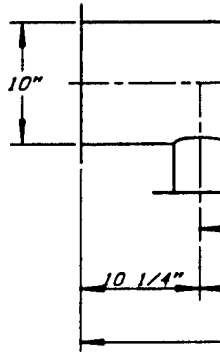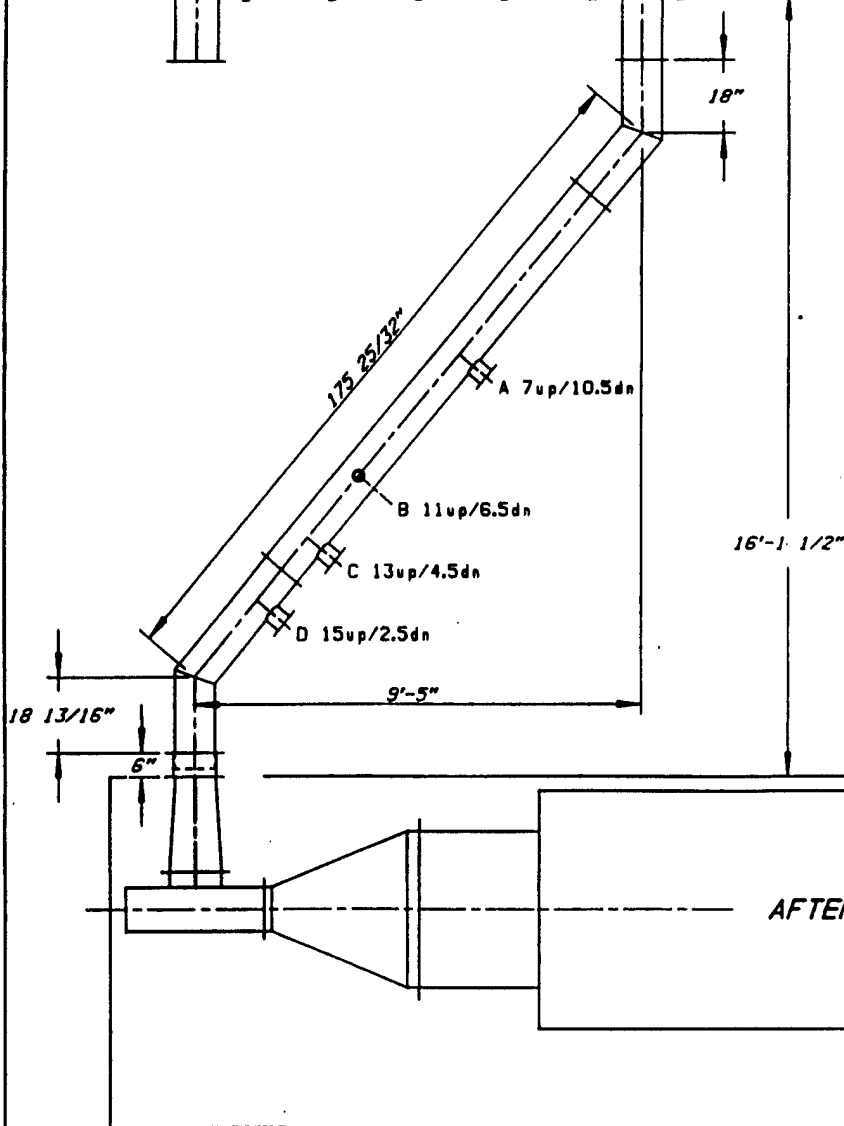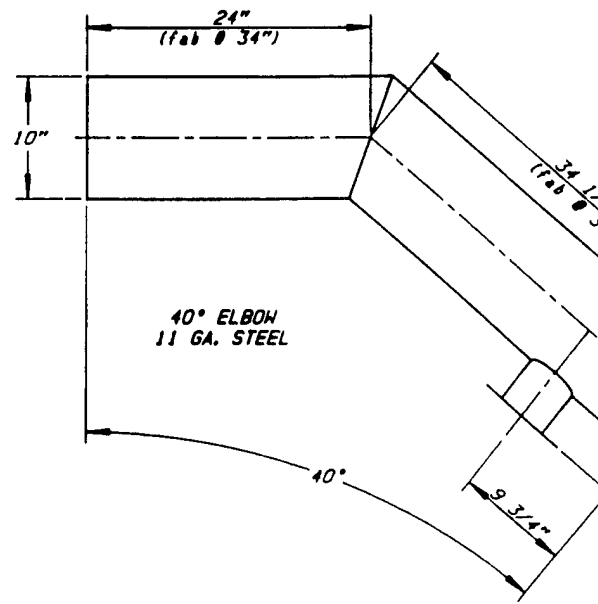
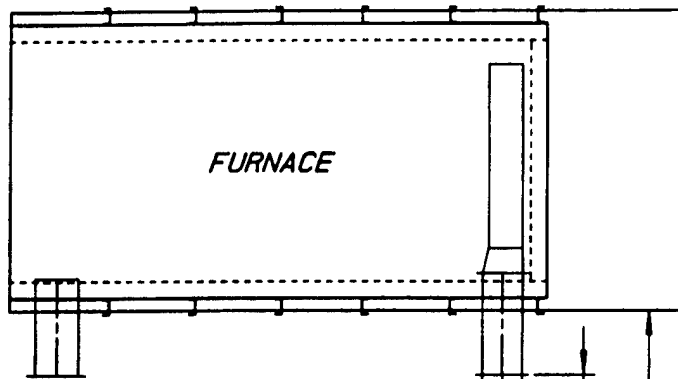


(1)

NO.	DATE

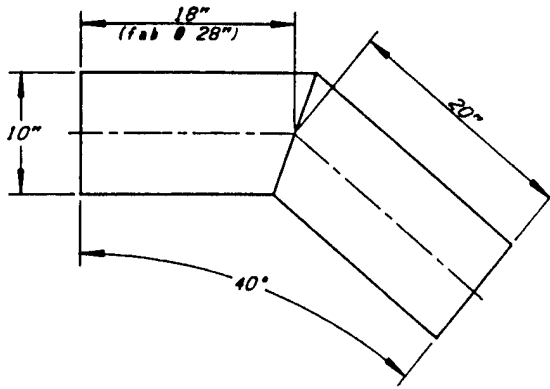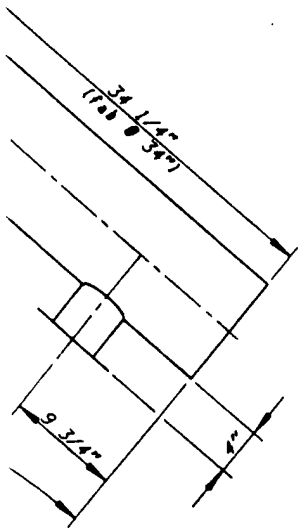

40° ELBOW
11 GA. STEEL

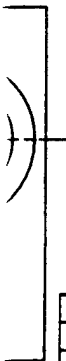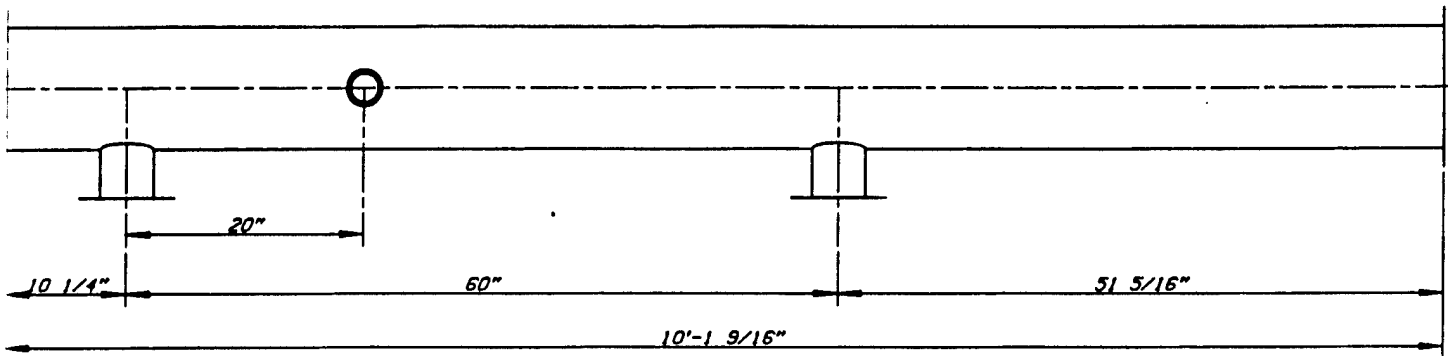

NO.	DATE	APPR.	REVISION
-	12/7/95		AS-BUILT DRAWING



HOT-GAS DECONTAMINATION SYSTEM


WESTON

WEST CHESTER PENNSYLVANIA

INTERCONNECT DUCT

DESIGN	J. HYRE	DATE	12/27/95	DWG. NO.	1300-01	REV. NO.	-
SCALE	1/2" = 1'-0"	W.D. NO.	02281-012-012	Sheet 1 of 1			

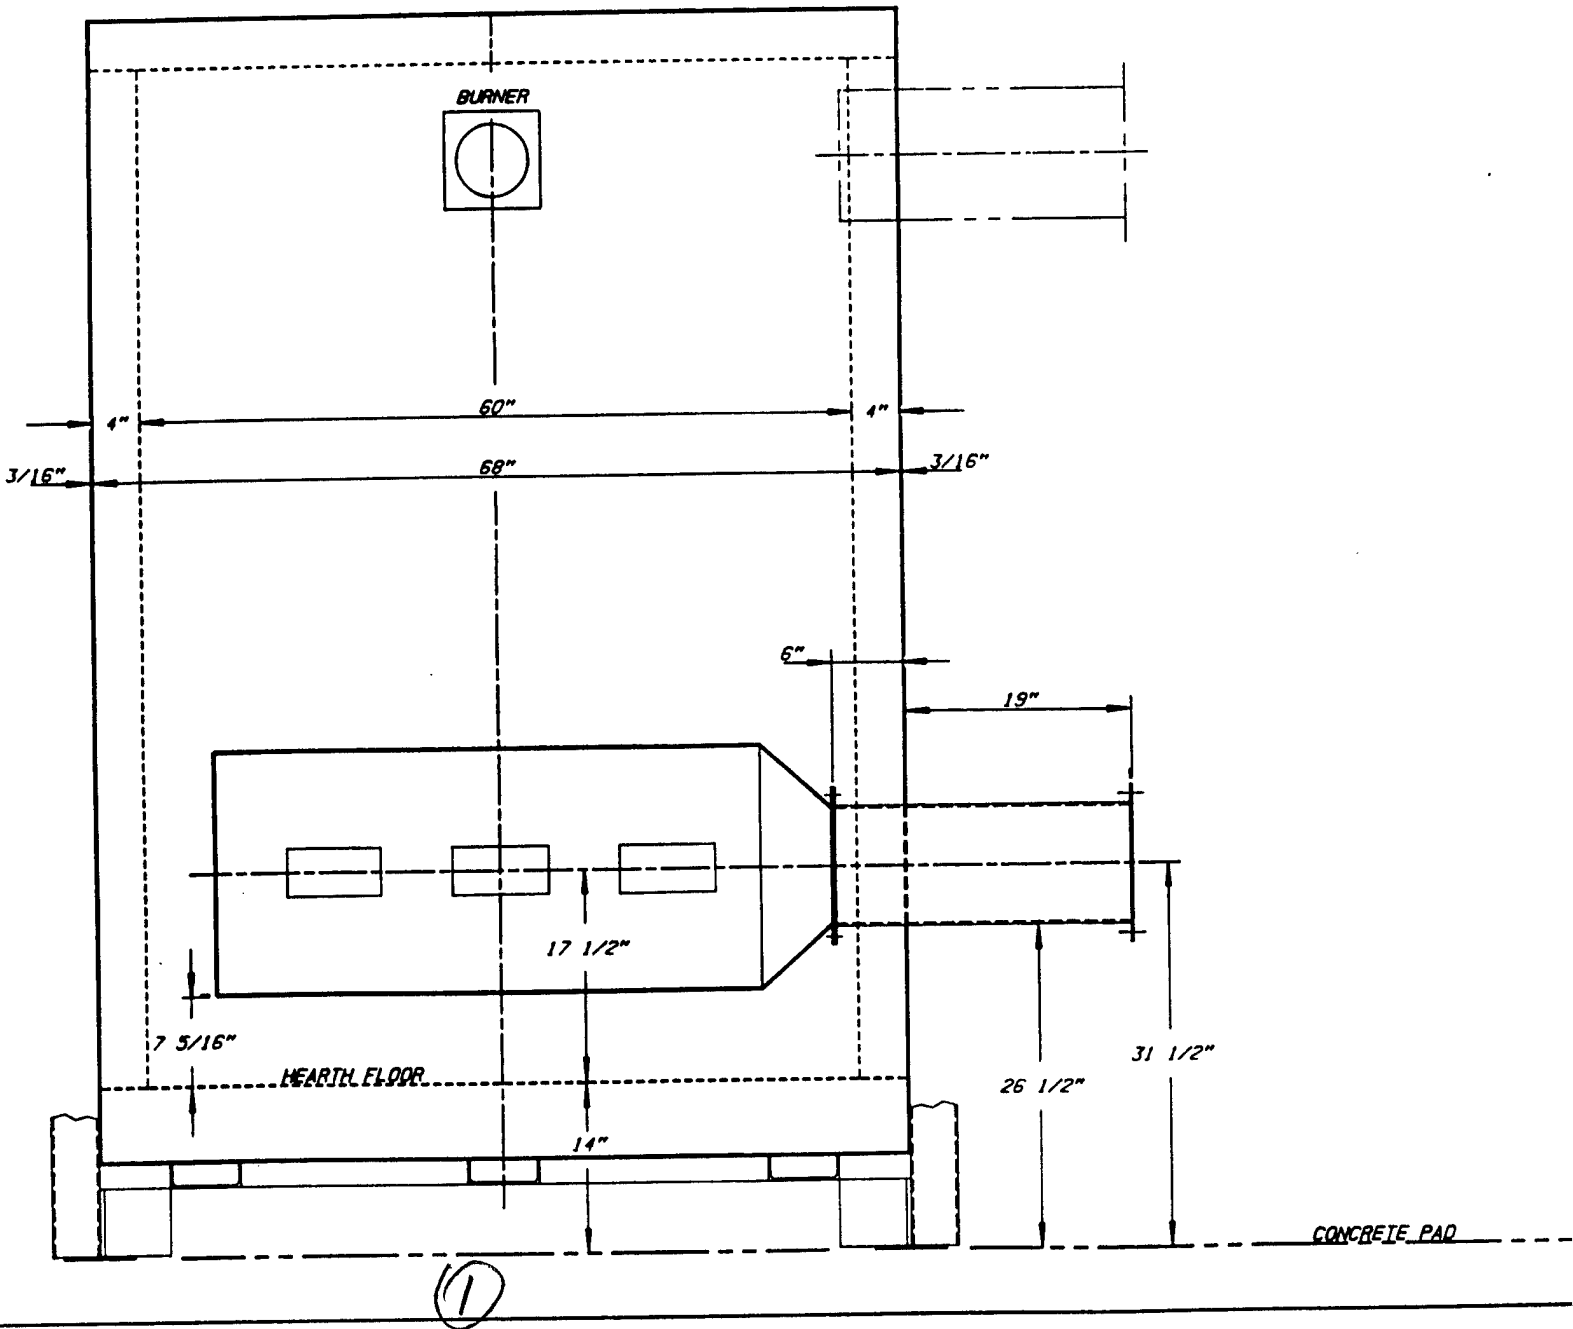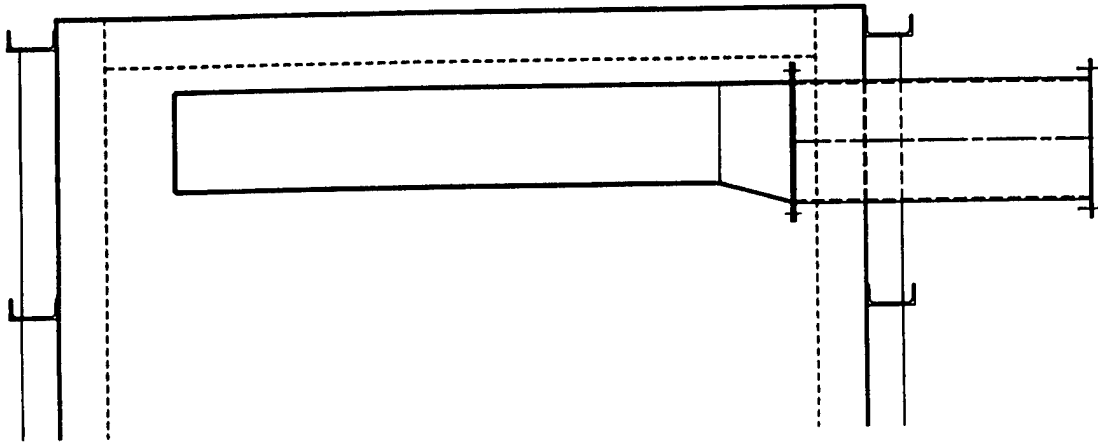

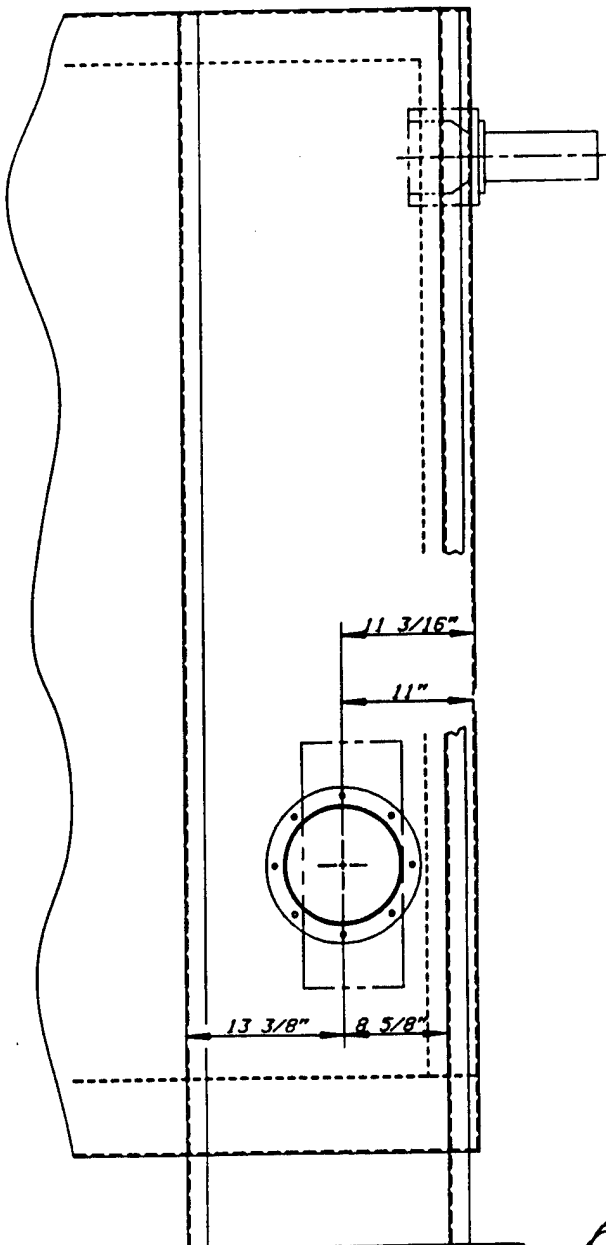

HOT-GAS DECONTAMINATION SYSTEM



NEW CHESTER

PENNSYLVANIA


EXHAUST PLENUM ASSEMBLY

DESIGNER	J. HYRE	DATE	1/1/96	DWG. NO.	1300-02	REV. NO.	-
SCALE	$1/8" = 1"$	DWG. NO.	02281-012-012	Sheet 1 of 1			

NO.	DATE	APPR.	REVISION
-	1/1/96		AS-BUILT DRAWING


CRETE PAD

2

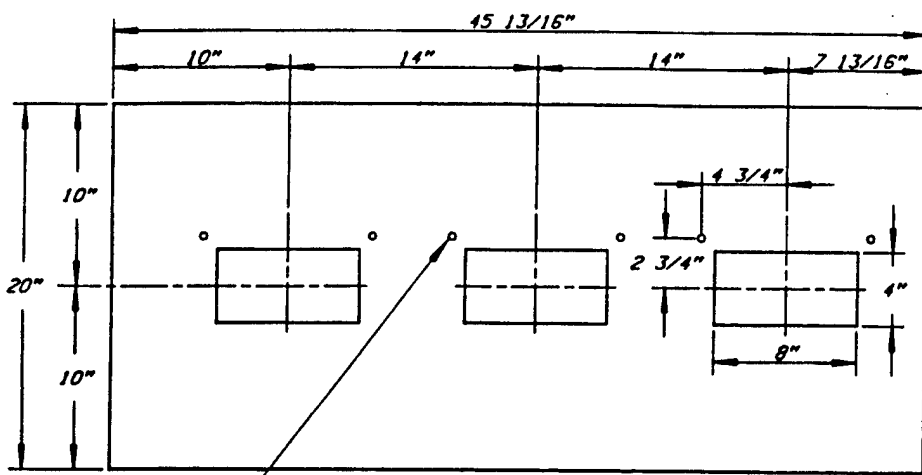




(16) $13/32$ " DIA. HOLES, DRILL THRU

DETAIL ITEM 2
(1) REQ'D

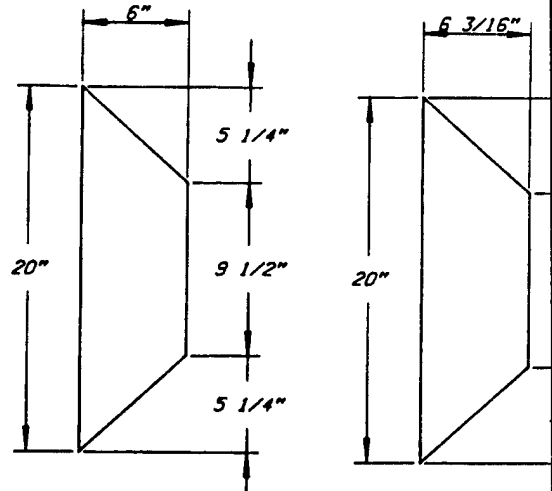


DETAIL ITEM 5
(1) REQ'D

DETAIL ITEM
(1) REQ'D

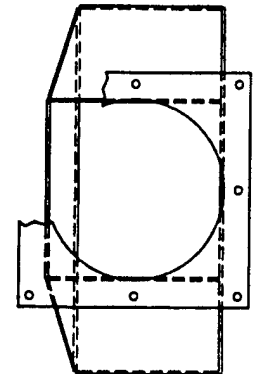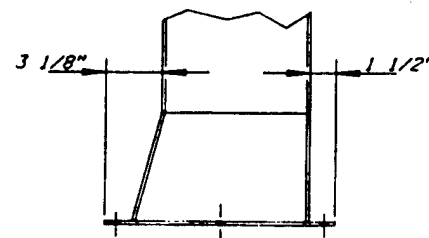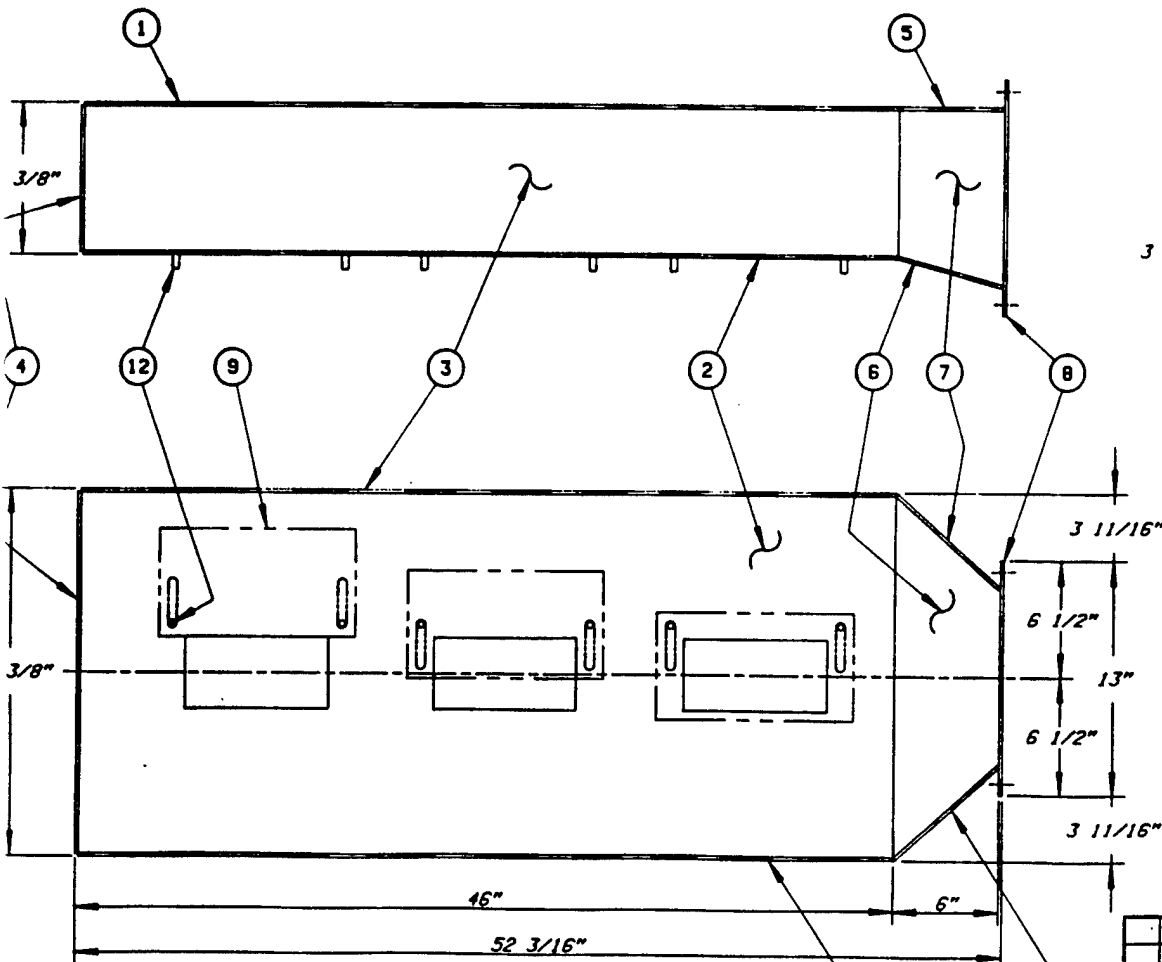

EXHAUST PLENUM WELDMENT


NO	DATE	APPR.	REVISION
-	1/1/76		AS-BUILT DRAWING

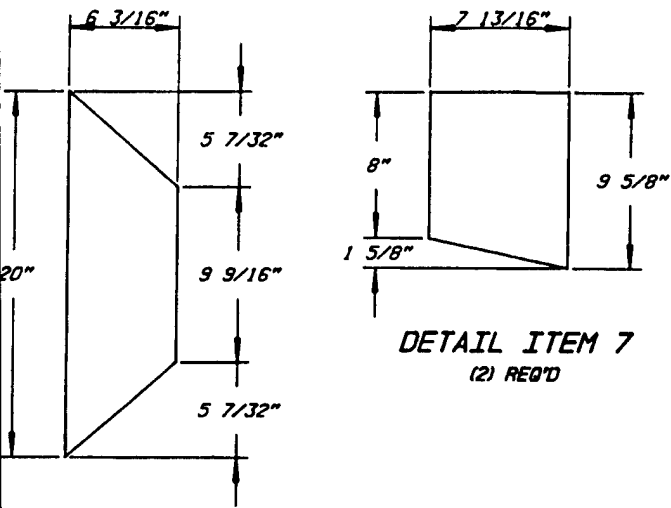


DETAIL ITEM 7
(2) REQ'D

BILL OF MATERIAL			
ITEM	REQD	DESCRIPTION	WGT
1	1	3/16" X 20" X 45 13/16" LG, HRS PLATE, A-36	
2	1	3/16" X 20" X 45 13/16" LG, HRS PLATE, A-36,(SEE DETAIL)	
3	2	3/16" X 8" X 45 13/16" LG, HRS PLATE, A-36	
4	1	3/16" X 8" X 20" LG, HRS PLATE, A-36	
5	1	3/16" X 6" X 20" LG, HRS PLATE, A-36,(SEE DETAIL)	
6	1	3/16" X 6 3/16" X 20" LG, HRS PLATE, A-36,(SEE DETAIL)	
7	2	3/16" X 7 13/16" X 9 5/8" LG,HRS PLATE,A-36,(SEE DETAIL)	
8	2	3/16" X 13" X 13" LG, HRS PLATE, A-36,(SEE DETAIL)	
9	3	3/16" X 6" X 11" LG, HRS PLATE, A-36,(SEE DETAIL)	
10	1	3/16" X 10"ID X 13"OD, HRS PLATE, A-36,(SEE DETAIL)	
11	1	9 5/8"ID X 10"OD X 25" LG,ROLLED DUCT, HRS PLATE, A-36	
12	6	3/8-16 X 1" LG, SS HEX BOLTS w/NUTS	
13	8	3/8-16 X 1 1/2" LG, SS HEX BOLTS w/NUTS	
TOTAL			


DETAIL ITEM 6
(1) REQ'D

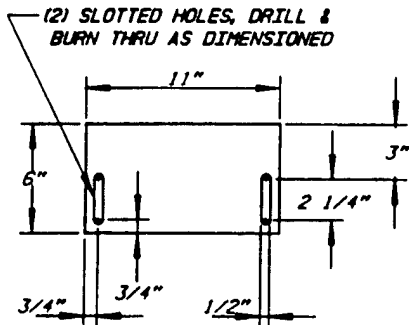





DETAIL ITEM 9
(3) REQ'D

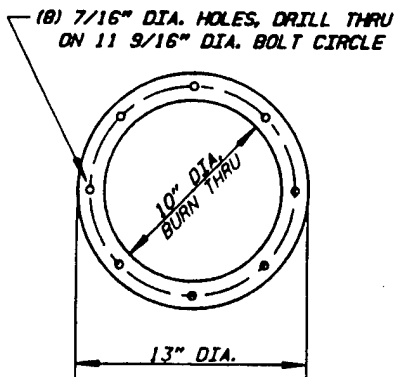

DETAIL ITEM 10
(1) REQ'D

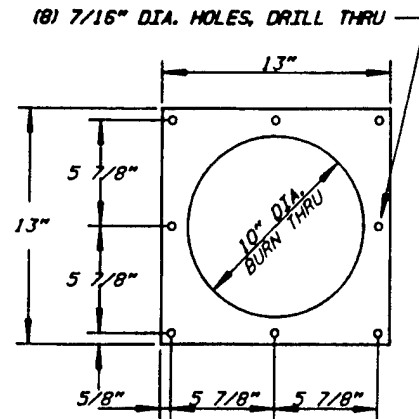

DETAIL ITEM 8
(2) REQ'D

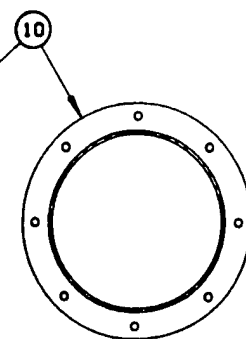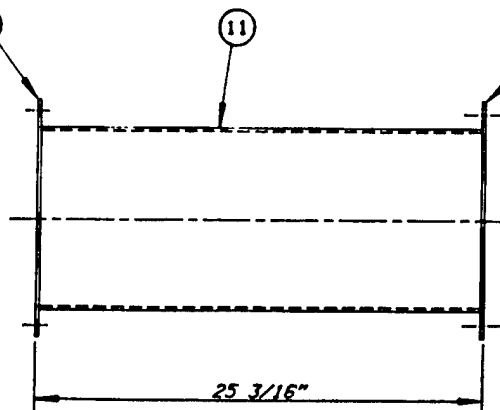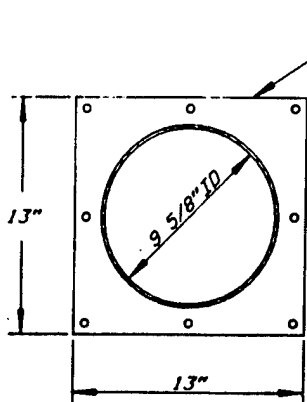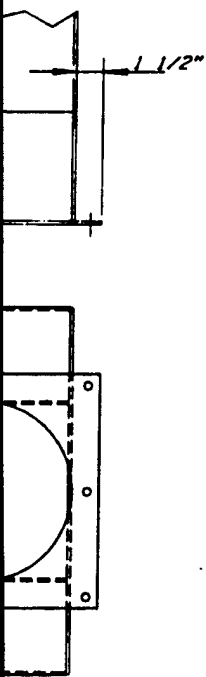

WELDMENT ITEMS 8, 10, & 11

REVISION	

HOT-GAS DECONTAMINATION SYSTEM

WESTON
MANUFACTURING CORPORATION

WEST CHESTER PENNSYLVANIA

EXHAUST PLENUM DETAILS			
DESIGN	J. HYRE	DATE	1/6/96
SCALE	3/16" = 1"	REV NO	1300-03
P.O. NO. 02281-012-012		REV NO. -	

THERMAL OXIDIZER EQUIPMENT

<u>DRAWING NO.:</u>	<u>REV. NO.:</u>	<u>DRAWING DATE</u>	<u>DRAWING DESCRIP</u>
OA	4	8/1/96	COVER SHEET
1X	2	3/10/95	SHIPPING CLEARAN
2X	1	3/10/95	SHIPPING CLEARAN
1A	3	8/17/96	GENERAL ARRANGE
1B	2	8/17/96	GENERAL ARRANGE
1SA	1	3/10/95	STEEL ARRANGEME
1SB	2	6/1/96	STEEL ARRANGEME
1SC	2	5/26/95	STEEL ARRANGEME
1SD	1	3/10/95	STEEL ARRANGEME
2A	2	3/10/95	FOUNDATION PLAN
FTA120-1	3	8/1/96	FUEL TRAIN ASSEMI
FTA120-2	3	8/1/96	FUEL TRAIN ASSEMI
AES -5-53	0	1/11/95	SIGHT PORT w/ VAL

①

THERMAL OXIDIZER EQUIPMENT

ER EQUIPMENT

DRAWING DESCRIPTION

COVER SHEET

SHIPPING CLEARANCES

SHIPPING CLEARANCES

GENERAL ARRANGEMENT: PLAN & ELEV.

GENERAL ARRANGEMENT: SECTIONS

STEEL ARRANGEMENT: AFTERBURNER

STEEL ARRANGEMENT: STACK & DETAIL

STEEL ARRANGEMENT: DETAILS

STEEL ARRANGEMENT: SKID & DETAILS

FOUNDATION PLAN

FUEL TRAIN ASSEMBLY - AFTERBURNER

FUEL TRAIN ASSEMBLY - AFTERBURNER

RIGHT PORT w/ VALVE - 4" DIAMETER

2

JOB: IJ-

SERVICE: AFTER

CUSTOMER: ROY I

LOCATION: ALP

DRAWING INDEX

STANDARD DRAWING INI

AES-5-53

4" x 6" SIGHT PORT W

DWG. NO.	REV	TITLE
0A	3	COVER SHEET
1X	2	SHIPPING CLEARANCE
2X	1	SHIPPING CLEARANCE
1A	2	GENERAL ARRANGEMENT - PLAN & ELEV.
1B	1	GENERAL ARRANGEMENT - SECTIONS
1SA	1	STEEL ARRANGEMENT - AFTER BURNER
1SB	1	STEEL ARRANGEMENT - STACK & DETAILS
1SC	1	STEEL ARRANGEMENT - DETAILS
1SD	1	STEEL ARRANGEMENT - SKID & DETAILS
2A	2	FOUNDATION PLAN
PID120	0	P & I D AFTERBURNER
LCP120-1	0	LOCAL CONTROL PANEL ASSEMBLY
LCP120-2	0	LOCAL CONTROL PANEL ASSEMBLY
LCP120-3	0	LOCAL CONTROL PANEL ASSEMBLY
RCP120-1	0	REMOTE CONTROL PANEL ASSEMBLY
RCP120-2	0	REMOTE CONTROL PANEL ASSEMBLY
ES120-1	0	ELECTRICAL SCHEMATIC AFTERBURNER
ES120-2	0	ELECTRICAL SCHEMATIC AFTERBURNER
ES120-3	0	ELECTRICAL SCHEMATIC AFTERBURNER
ES120-4	0	ELECTRICAL SCHEMATIC AFTERBURNER
ES120-5	0	ELECTRICAL SCHEMATIC AFTERBURNER
IC120-1	0	INTERCONNECTION DIAGRAM AFTERBURNER
IC120-2	0	INTERCONNECTION DIAGRAM AFTERBURNER
IC120-3	0	INTERCONNECTION DIAGRAM AFTERBURNER
FTA120-1	3	FUEL TRAIN ASSEMBLY AFTERBURNER
FTA120-2	3	FUEL TRAIN ASSEMBLY AFTERBURNER
FTF120	0	FUEL RACK FABRICATION

9			
8			
7			
6			
5			
4	CAP	8/1/96	JLB
3	OU	3/17/96	JLB
2	OU	2/15/95	JLB
1	OU	1/11/95	JLB
NO	BY	DATE	CHK'D

(1)

IJ-120

R BURNER SYSTEM

ROY F. WESTON, INC.

ALPINE, ALABAMA


DRAWING INDEX

4" SIGHT PORT W/VALVE

GENERAL NOTES

1. ALL STRUCTURAL STEEL TO BE ASTM A36 UNLESS NOTED.
2. FABRICATE PER AISC 9TH. EDITION
3. ALL STRUCTURAL WELDING TO BE PER AWS D1.1

JOB INFORMATION			
CUSTOMER: ROY F. WESTON, INC			
P O NO: 43366			
JOBSITE: ALPINE, AL			
END USER: U.S. ARMY ENVIRONMENTAL CENTER			
SERVICE: AFTER BURNER SYSTEM			
ARRTECH JOB NO.: U-120			
CAP 8/1/96		JLB	AS-BUILT DRAWINGS
OU 3/17/96		JLB	REVISED LOCATION & ADDED DWG'S FTA120-1.2
OU 2/15/95		JLB	ADDED DWG FRF120 & ADDED REV NUMBERS
OU 1/11/95		JLB	REVISED DRAWING LIST
BY	DATE	CHK'D	REVISION DESCRIPTION




Arrtech
ENVIRONMENTAL SYSTEMS, INCORPORATED

TULSA OKLAHOMA BLOOMINGTON MINNESOTA

COVER SHEET


DRAWN BY	OU	DATE	10/13/94	JOB NO	U-120
CHK'D BY	JLB	DATE	1/11/95	DRAWING NO	0A
APPR'D BY		DATE		REVISION NO	4

(2)

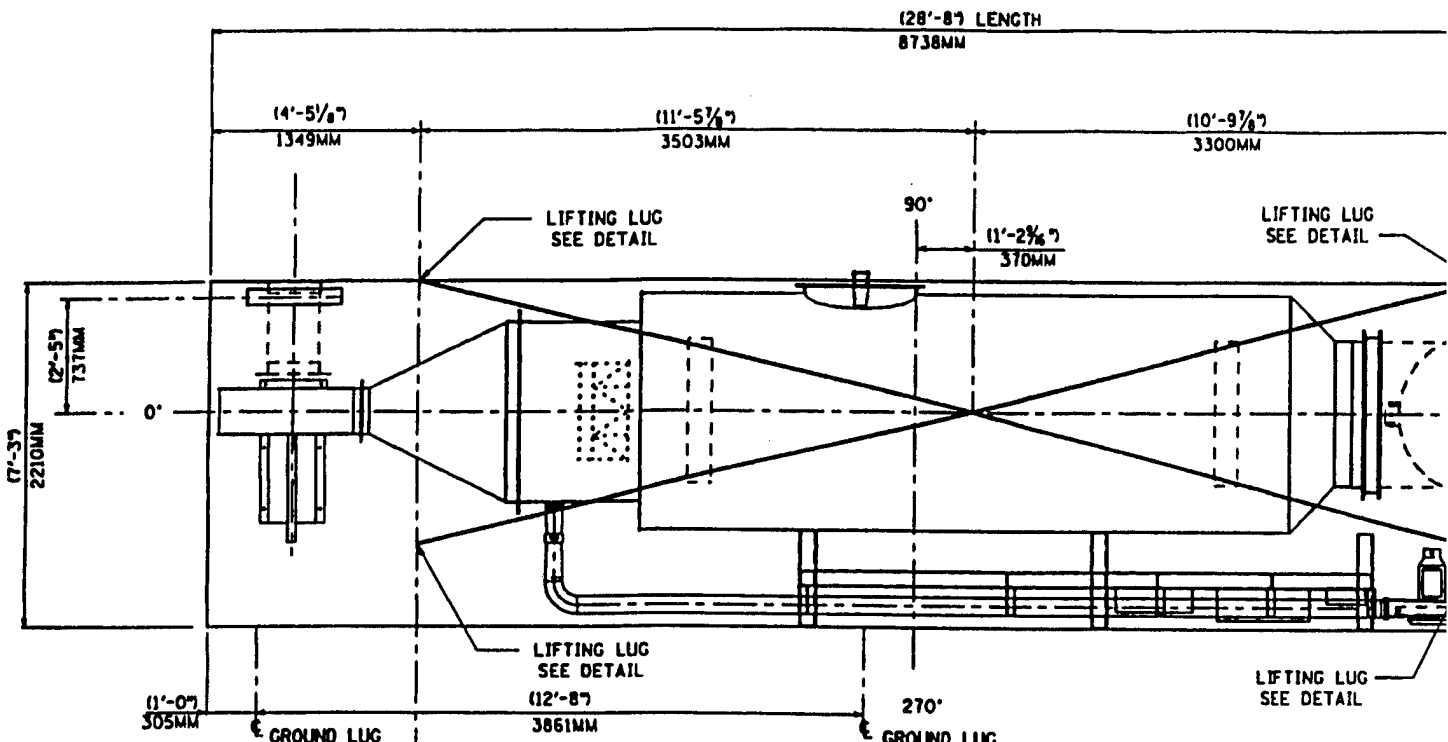

PLAN VIEW

ESTIMATED SHIPPING WEIGHT
(9,000 *)

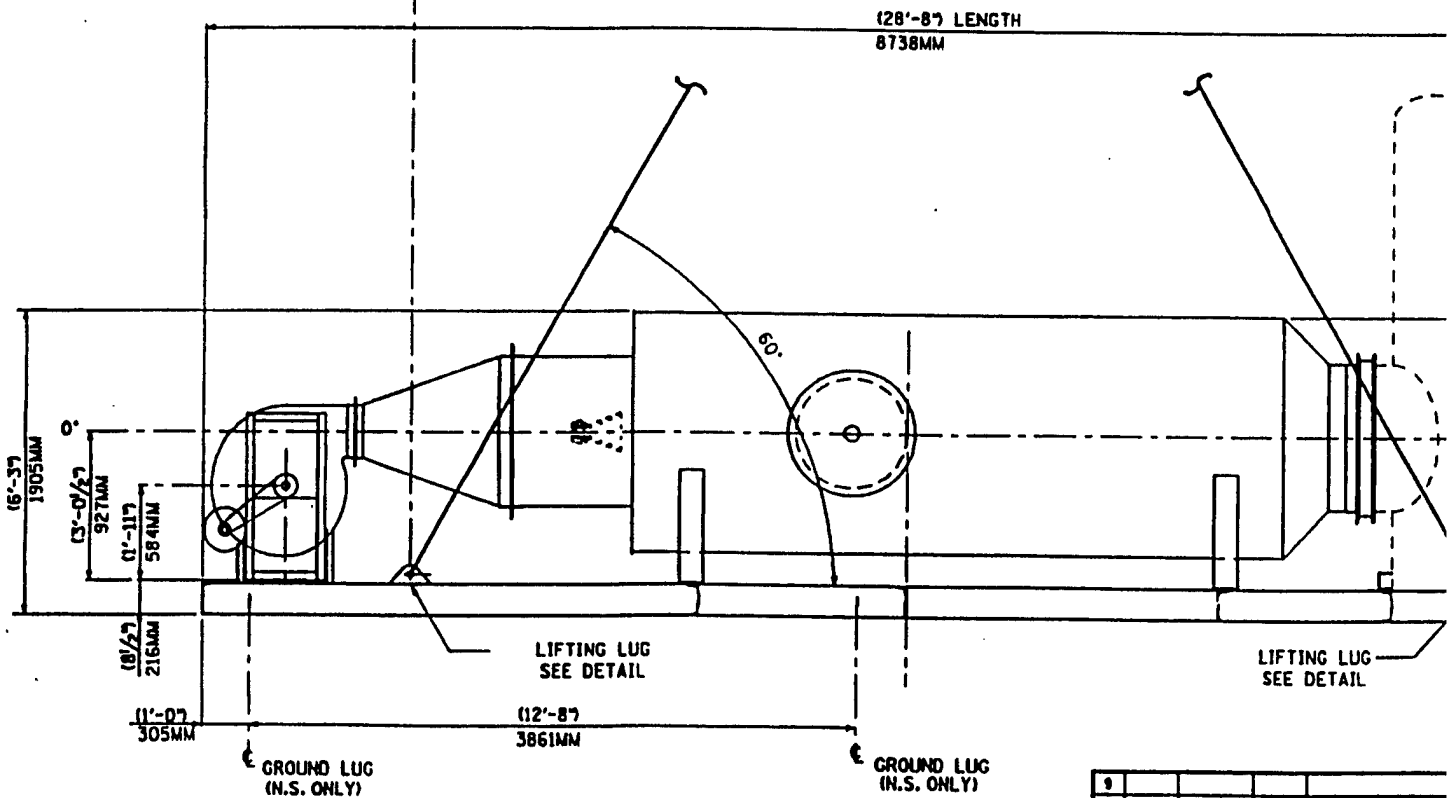



ELEVATION VIEW

(270°)

NOTE:
(N.S.) INDICATES NEAR SIDE
(F.S.) INDICATES FAR SIDE



9				
8				
7				
6				
5				
4				
3				
2	OU	3/10/95	J.B	REVISED INLET DU
1	OU	1/10/95	J.B	REVISED PER CUSI
NO.	BY	DATE	CHK 'D	

①

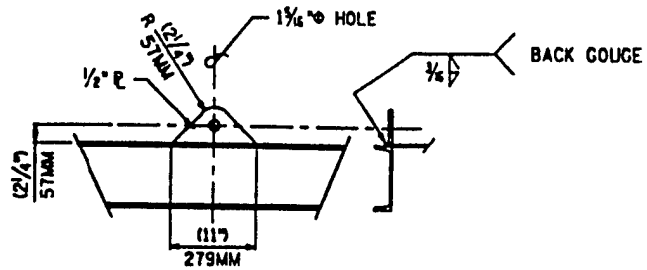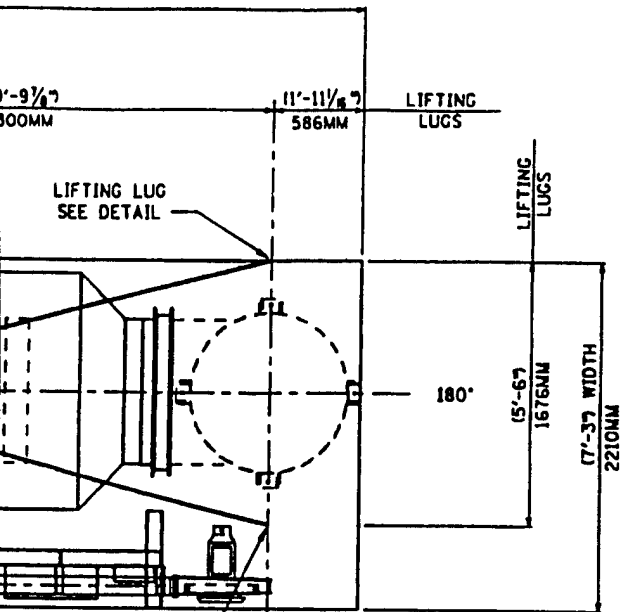

LIFTING LUG

(4 THUS)

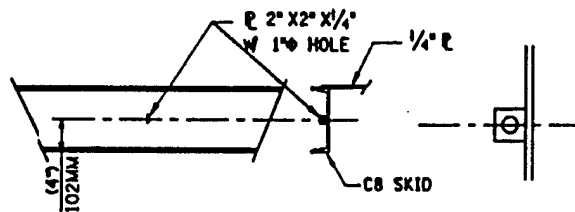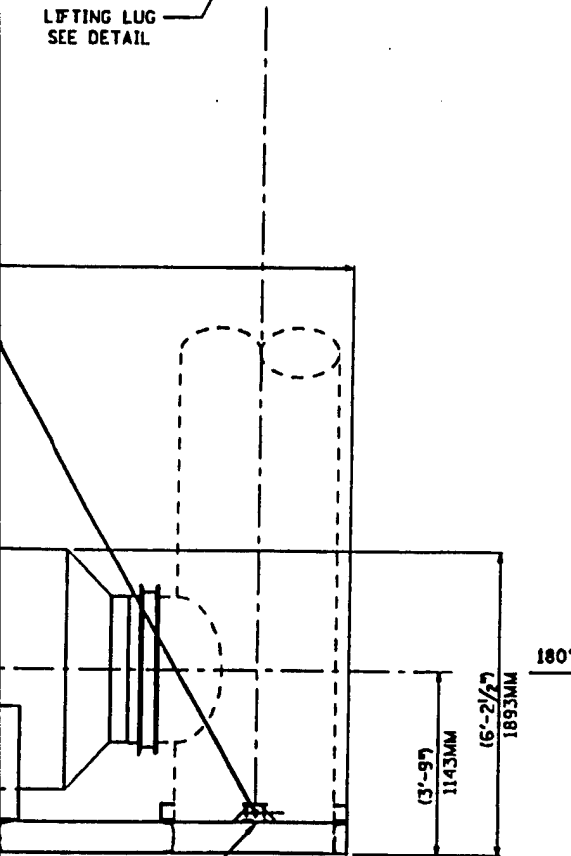

GROUND LUG


(2 THUS)

NOTES:

1. FOR LIFTING PURPOSES, WEIGHTS OF SECTIONS SHALL BE AS SHIPPED WEIGHT TAKEN FROM THE FREIGHT BILL OF LADING FOR THE PARTICULAR SECTION. ALL OTHER WEIGHTS ARE TO BE CONSIDERED ESTIMATES ONLY AND NOT SUITABLE FOR THIS PURPOSE. IF THE BILL OF LADING DOES NOT INCLUDE THIS WEIGHT, ARRTECH ENGINEERING MUST BE CONTACTED FOR THE AS SHIPPED WEIGHT.
2. LENGTH, WIDTH AND HEIGHT SHOWN ARE APPROXIMATE DIMENSIONS. ACTUAL SHIPPING DIMENSIONS ARE TO BE VERIFIED BY SHIPPING AGENT AT FINAL FABRICATION SITE. OVERALL DIMENSIONS FOR PERMITS SHALL BE MEASURED BY THE SHIPPING AGENT AFTER SECTIONS ARE LOADED FOR SHIPMENT.
3. ESTIMATED WEIGHTS INCLUDE ALL SHOP INSTALLED REFRACTORY.

NO.	DATE	BY	REVISION DESCRIPTION
95		J.B	REVISED INLET DUCT / ADD PANEL LOCATION & GROUND LUGS
95		J.B	REVISED PER CUSTOMER COMMENTS
		CHK'D	

JOB INFORMATION	
CUSTOMER:	ROY F. WESTON, INC.
P.O. NO.:	43366
JOB SITE:	ALPINE, AL.
END USER:	U.S. ARMY ENVIRONMENTAL CENTER
SERVICE:	AFTER BURNER SYSTEM
ARRTECH JOB NO.:	IJ-120



Arrtech
 ENVIRONMENTAL SYSTEMS, INCORPORATED
 TULSA, OKLAHOMA BLOOMINGTON, MINNESOTA

SHIPPING CLEARANCES

DRAWN BY	OU	DATE	12/13/94	JOB NO.	IJ-120
CHK'D BY	J.B	DATE	1/10/95	DRAWING NO.	1X
APPR'D BY		DATE	/ /	REVISION NO.	2

CADD #WQ IJ120-1X.DCN


(2)

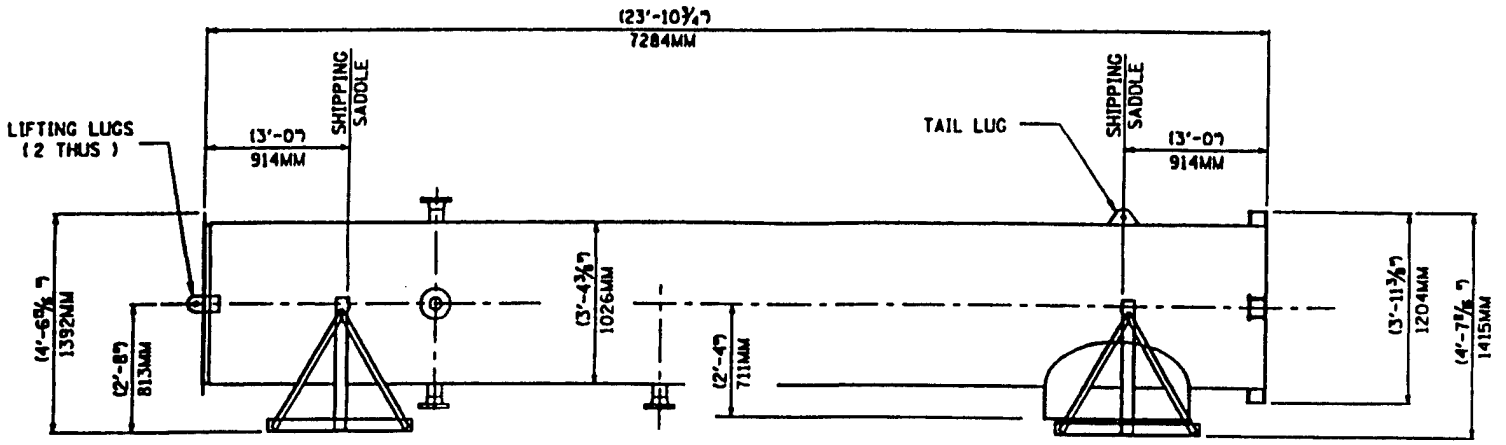

STACK SECTION
 ESTIMATED SHIPPING WEIGHT
 (4,500 •)

9				
8				
7				
6				
5				
4				
3				
2				
1	OU	3/10/95	JLB	REL
NO.	BY	DATE	CHK'D	

①

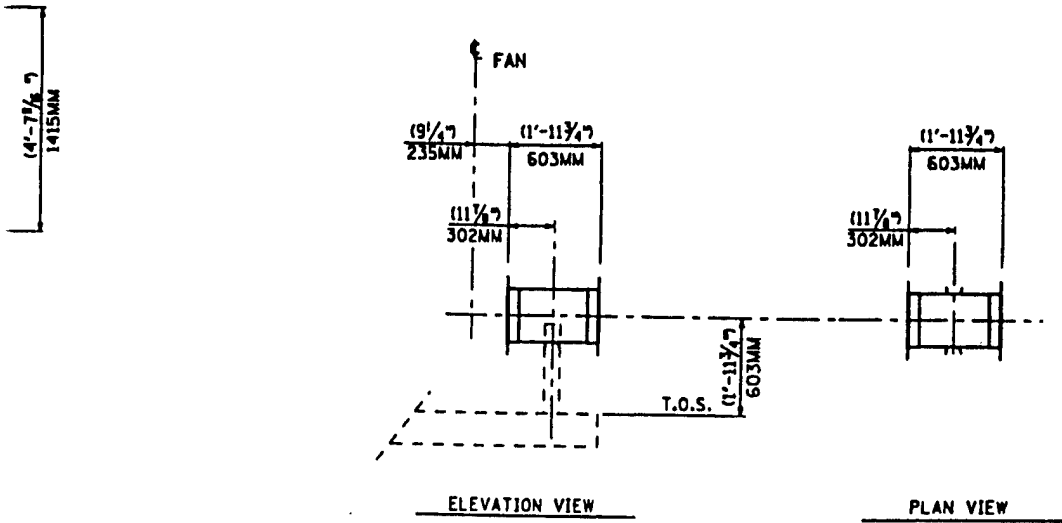

AIR INLET DUCT
ESTIMATED SHIPPING WEIGHT
(175 •)


NOTES:

1. FOR LIFTING PURPOSES, WEIGHTS OF SECTIONS SHALL BE AS SHIPPED WEIGHT TAKEN FROM THE FREIGHT BILL OF LADING FOR THE PARTICULAR SECTION. ALL OTHER WEIGHTS ARE TO BE CONSIDERED ESTIMATES ONLY AND NOT SUITABLE FOR THIS PURPOSE. IF THE BILL OF LADING DOES NOT INCLUDE THIS WEIGHT, ARRTECH ENGINEERING MUST BE CONTACTED FOR THE AS SHIPPED WEIGHT.
2. LENGTH, WIDTH AND HEIGHT SHOWN ARE APPROXIMATE DIMENSIONS. ACTUAL SHIPPING DIMENSIONS ARE TO BE VERIFIED BY SHIPPING AGENT AT FINAL FABRICATION SITE. OVERALL DIMENSIONS FOR PERMITS SHALL BE MEASURED BY THE SHIPPING AGENT AFTER SECTIONS ARE LOADED FOR SHIPMENT.
3. ESTIMATED WEIGHTS INCLUDE ALL SHOP INSTALLED REFRACTORY.

		JOB INFORMATION		Arrtech	
		CUSTOMER: ROY F. WESTON, INC.		TULSA, OKLAHOMA	
		P.O. NO.: 43364		ENVIRONMENTAL SYSTEMS, INCORPORATED	
		JOB SITE: ALPINE, AL.		BLOOMINGTON, MINNESOTA	
		END USER: U.S. ARMY ENVIRONMENTAL CENTER		DRAWING TITLE	
		SERVICE: AFTER BURNER SYSTEM		SHIPPING CLEARANCES	
		ARRTECH JOB NO.: 1J-120		DRAWN BY: DJ	DATE: 1/10/95
JLB REMOVED ACCESS DOOR & REVISED INLET DUCT				CHK'D BY: JLB	DATE: 1/11/95
CHK'D REVISION DESCRIPTION				APPR'D BY:	DATE: / /
				JOB NO.: 1J-120	REVISION NO.: 2X
					REVISION NO.: (1)


2

(C15) MOUNTED IN CUSTOMER DUCT

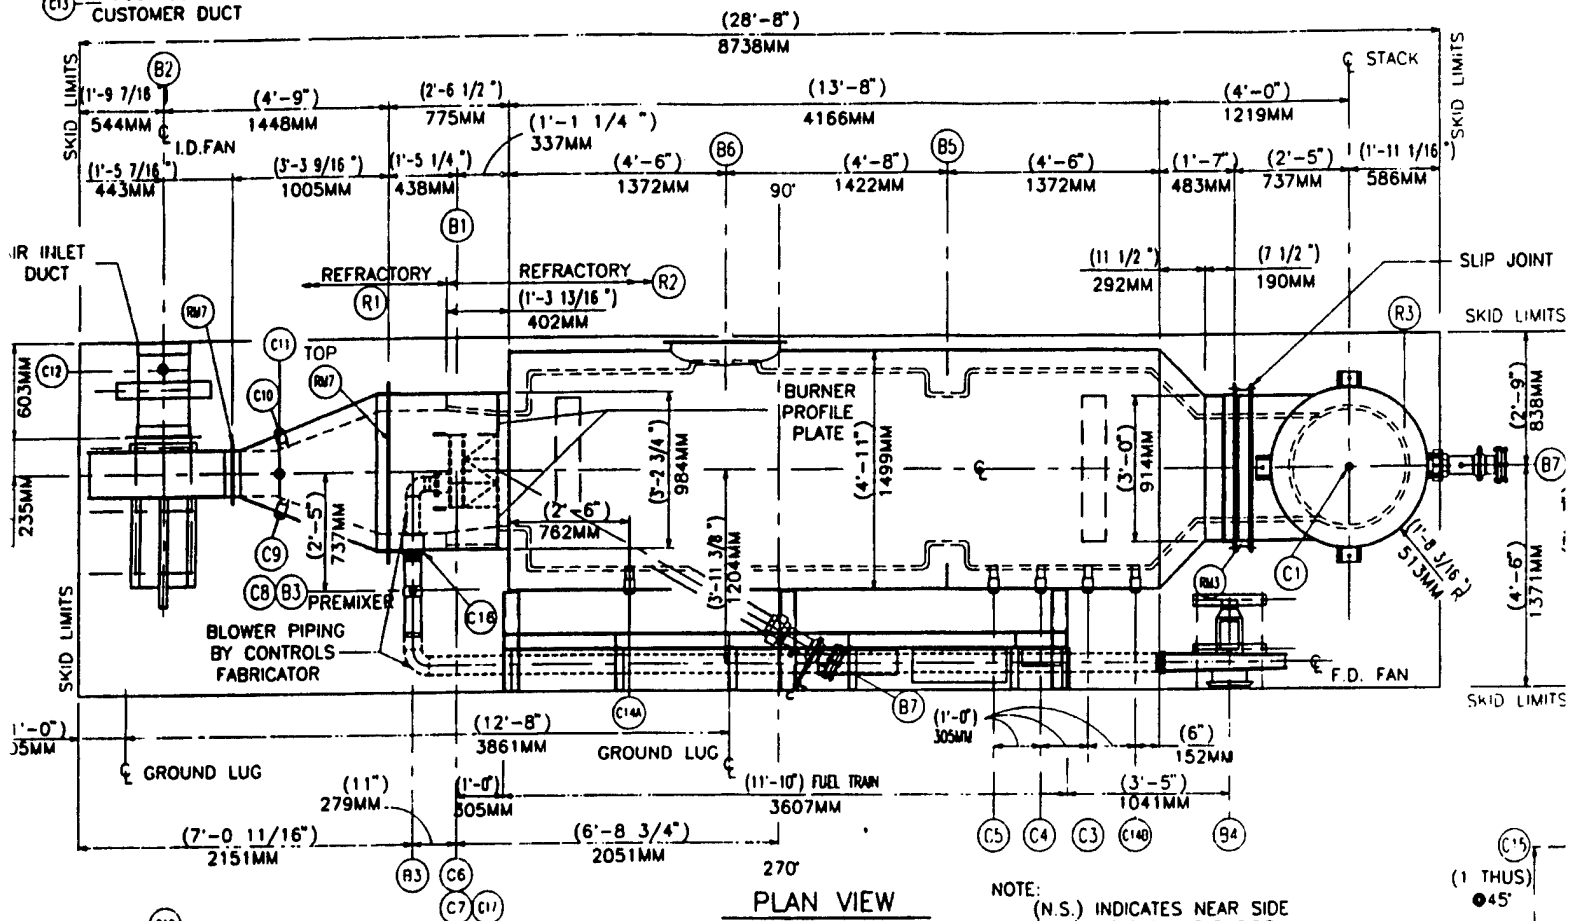

NOTE:
(N.S.) INDICATES NEAR SIDE
(F.S.) INDICATES FAR SIDE

(1 THUS)
●45°

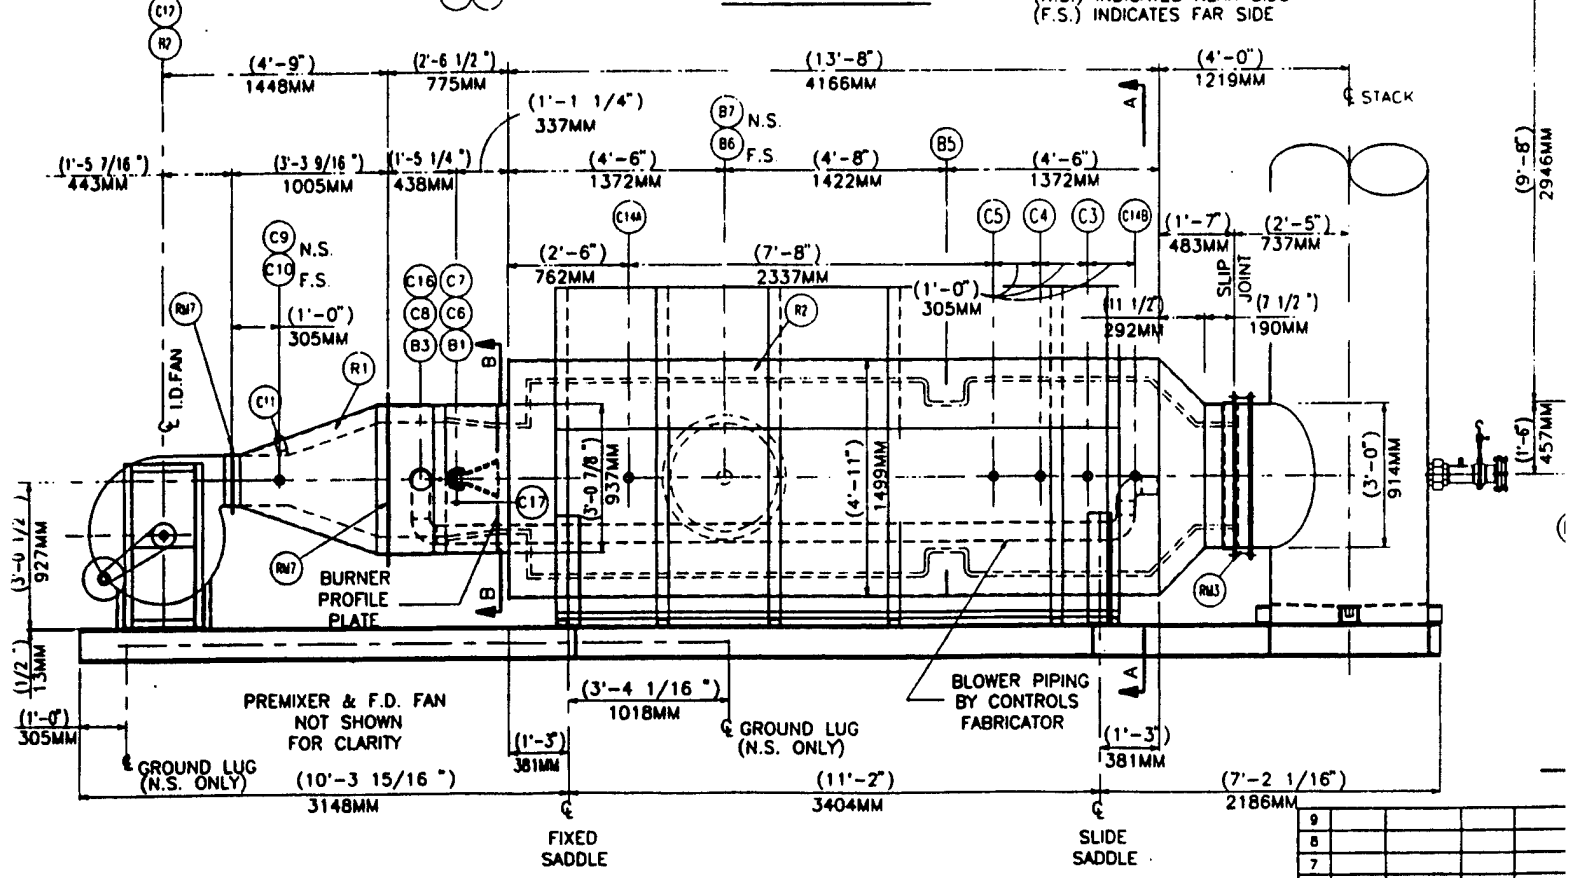


NOTE:
(N.S.) INDICATES NEAR SIDE
(F.S.) INDICATES FAR SIDE

ELEVATION VIEW
(270°)

9					
8					
7					
6					
5					
4					
3	AH	8/17/98	RLP	FIELD	
2	OU	3/10/95	JLB	ADDED	
1	OU	1/10/95	JLB	REVISED	
NO.	BY	DATE	CHK'D		

1

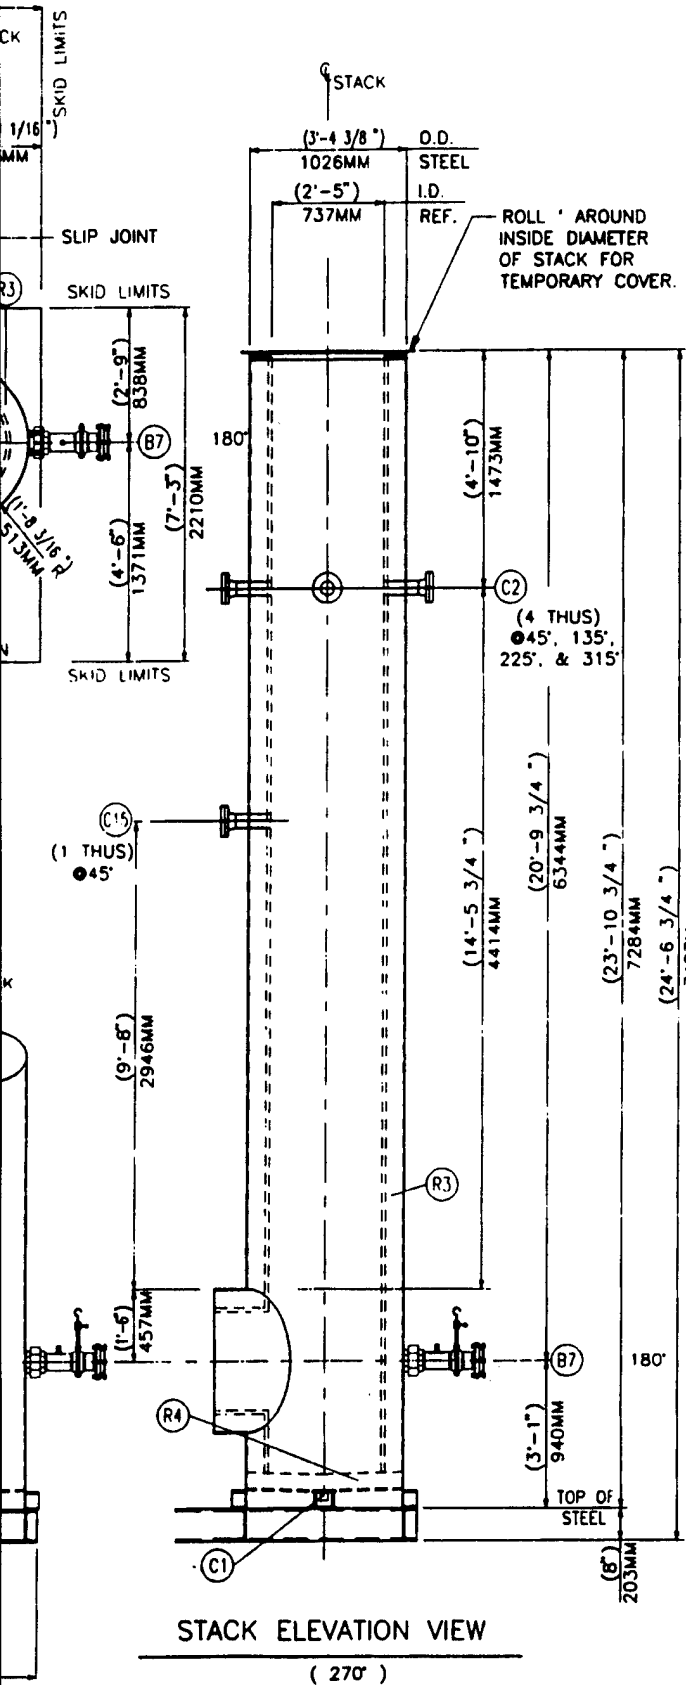

MISCELLANEOUS COMPONENTS

MK	QTY	DESCRIPTION
B1	ONE	MAXON AIRFLO BURNER - LV5-B-24-120
		W/1 - 12' & 1 - 6' STRAIGHT SECTIONS (SEE DATA SHEETS)
B2	ONE	I.D. FAN - CHICAGO BLOWER - SIZE "13D" (SEE DATA SHEETS)
B3	ONE	MAXON - PREMIXING TUBE - HG SERIES - SIZE 4" (SEE DATA SHEETS)
B4	ONE	F.D. FAN - MAXON FG SERIES - C-1450-12 (SEE DATA SHEETS)
B5	ONE	10 GA. CORBEL (304SS)
B6	ONE	27" BOLTED ACCESS DOOR - AFTER BURNER
B7	2	4" SIGHT PORT - AES-5-53
B8	ONE	3/16" DISTRIBUTION PLATE

MISCELLANEOUS CONNECTIONS

MK	QTY	DESCRIPTION	
C1	ONE	1 1/2" (SCH 20) PIPE (304SS)	STACK FLOOR DRAIN
C2	4	4" - 300# RFWN W/BLIND & 310SS PIPE	EPA SAMPLE PORTS
C3	ONE	1" 3000# CPLG W/PLUG & 310SS PIPE	TW-(145) ⚠
C4	ONE	1 1/2" 3000# CPLG W/PLUG & 310SS PIPE	SPARE
C5	ONE	1" 3000# CPLG W/PLUG & 310SS PIPE	TW-(131) ⚠
C6	ONE	3/8" 3000# CPLG W/PLUG & 310SS PIPE	PILOT IGNITOR
C7	ONE	1" 3000# CPLG W/PLUG & 310SS PIPE	UV SCANNER
C8	ONE	1 1/2" NPT ON PREMIXER	FUEL GAS
C9	ONE	1/2" 3000# CPLG W/PLUG & 310SS PIPE	PSH 153
C10	ONE	1/2" 3000# CPLG W/PLUG & 310SS PIPE	PSL 155
C11	ONE	1/2" 3000# CPLG W/PLUG & 310SS PIPE	PT 151
C12	ONE	1 1/2" 300# RFWN (BY SENSOR SUPPLIER)	⚠
C13	ONE	CONNECTION INCLUDED IN CUSTOMER PIPING	PT 158
C14A	ONE	1/2" 3000# CPLG W/PLUG & 310SS PIPE	⚠
C14B	ONE	1/2" 3000# CPLG W/PLUG & 310SS PIPE	⚠
C15	ONE	4" - 300# RFWN W/BLIND & 310SS PIPE	CEM SAMPLE PORT
C16	ONE	4" x 3" 3000# REDUCING CPLG	PREMIXER
C17	ONE	3/8" 3000# CPLG	PILOT GAS

REFRACTORIES

NO.	AREA	MATERIAL	INSTALLED
R1	INLET DUCT	4"-6# C.F.B. < 304SS PINS & CLIPS (WET PACK)	SHOP
R2	COMBUSTOR	1"-8# & 4 1/2" -6# C.F.B. < 310SS PINS & CLIPS	SHOP
R3	STACK	1"-8# & 4 1/2" -6# C.F.B. < 310SS PINS & CLIPS	SHOP
R4	STACK FLOOR	1"-8# & 4 1/2" -6# C.F.B. < 310SS PINS & CLIPS	SHOP
RM3	SLIP JOINT	1" - 8# C.F.N.B	FIELD
RM7	BOLTED JOINT	0.065" THK GASKET, "GORE-TEX" OR EQUAL TAPE	SHOP

NOTES:

- SANDBLAST EXTERIOR SURFACE PER SSPC-SP6.
- PAINT EXTERIOR HTR. SURFACES W/(1) COAT (3 - 4) MILS DFT CARBOZINC 11. FINISH W/(2) COATS (4 MILS EACH) DFT "SHERMAN WILLIAMS - ALL WEATHER EPOXY"
- ALL CASING MAT'L A36 W/MINIMUM THK. AS FOLLOWS :
COMBUSTOR WALLS : 3/16" THK.
STACK : 3/16" THK.
DUCT WALLS : 3/16" THK.
- ALL LIFTING LUGS LIFT STRAIGHT UP UNLESS NOTED OTHERWISE.
- SEE BURNER DRAWINGS FOR BURNER INFORMATION.
- SKID FLOOR PLATE - 1/4" GALV. CHK'D PLATE.
- STACK & AIR INLET DUCT SHIPPED SEPARATE

STACK ELEVATION VIEW

(270°)


DATE	CHK'D	REVISION DESCRIPTION
10/95	JLB	REVISED PER CUSTOMER COMMENTS
10/95	JLB	ADDED FUEL TRAIN & BURNER INLET PIPING
1/17/96	JLB	FIELD MODIFICATIONS

JOB INFORMATION	
CUSTOMER:	ROY F. WESTON, INC.
P.O. NO.:	43366
JOB SITE:	ALPINE, AL.
END USER:	U.S. ARMY ENVIRONMENTAL CENTER
SERVICE:	AFTER BURNER SYSTEM
ARRTECH JOB NO.:	U-120


TULSA OKLAHOMA BLOOMINGTON MINNESOTA

DRAWING TITLE: GENERAL ARRANGEMENT - PLAN & ELEV.


DRAWN BY	OU	DATE	9/25/94	JOB NO.	U-120
CHK'D BY	JLB	DATE	1/11/95	DRAWING NO.	1A
APPR'D BY		DATE		REVISION NO.	3

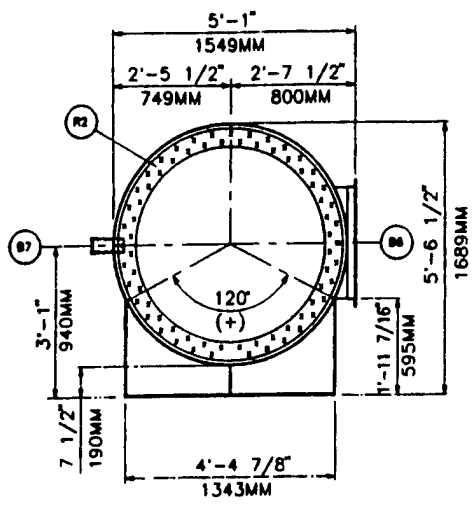


SECTION A-A

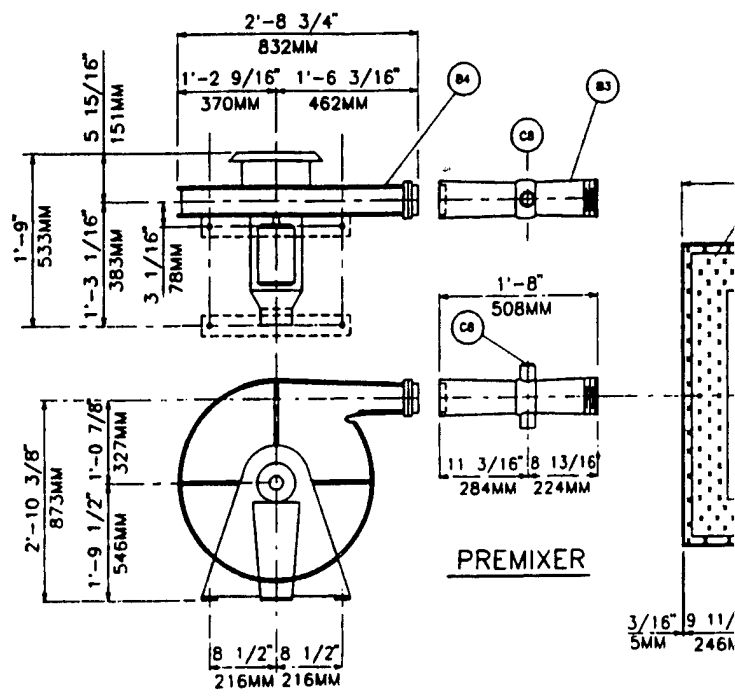


F.D. FAN

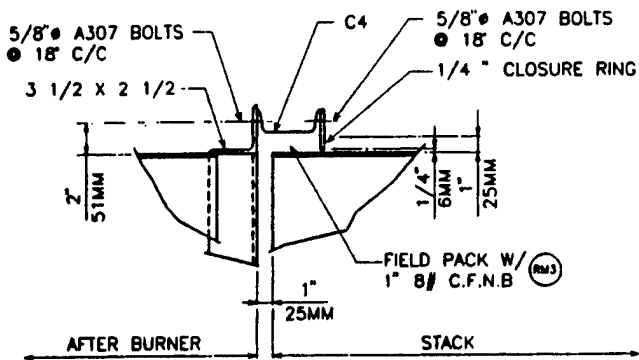

SLIP JOINT DETAIL

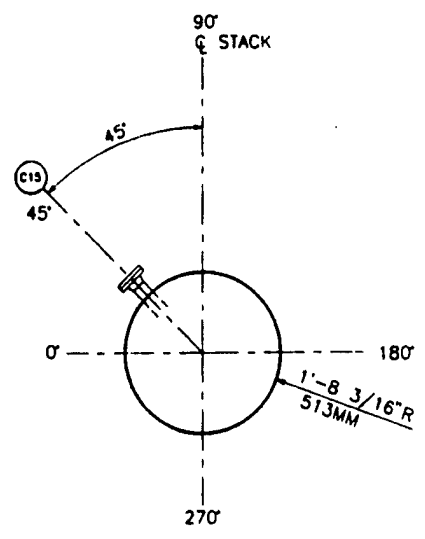


CEM SAMPLE PORT

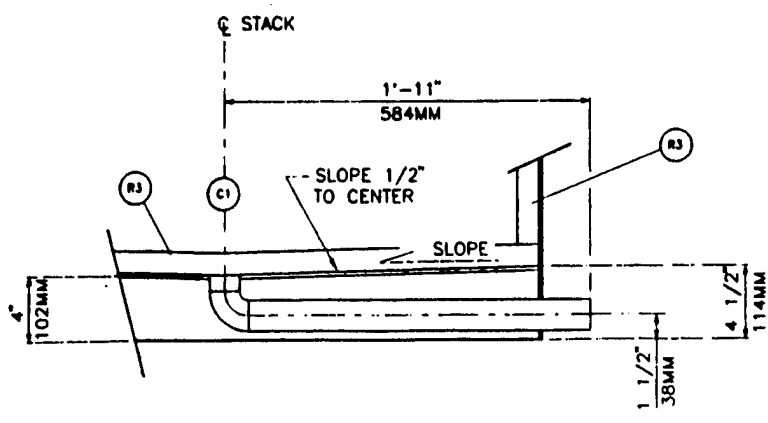


STACK FLOOR DRAIN DETAIL

9					
8					
7					
6					
5					
4					
3					
2	AH	8/17/96	CPD	FIELD	
1	DU	3/10/95	JLB	ADDE	
NO	BY	DATE	CHK'D		




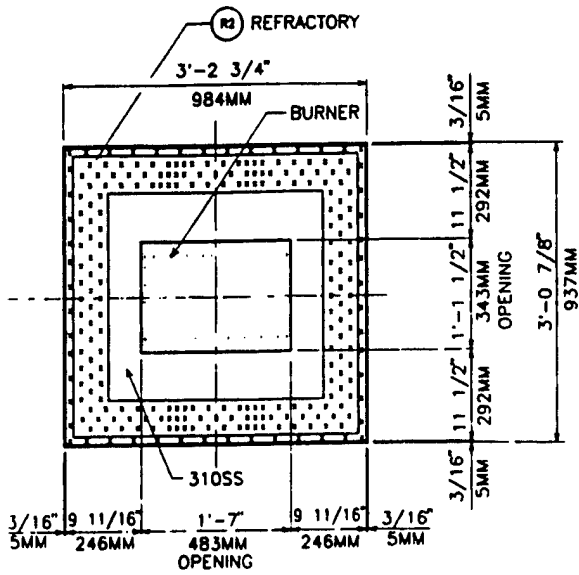


BURNER PROFILE PLATE
SECTION B-B

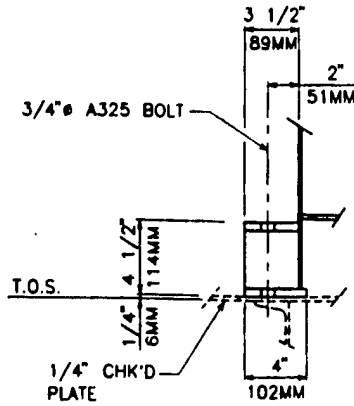


STACK BASE DETAIL

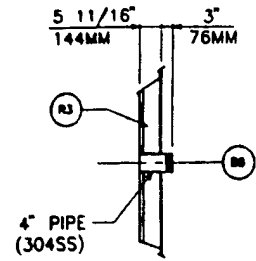


SITE PORT DETAIL
IN STACK

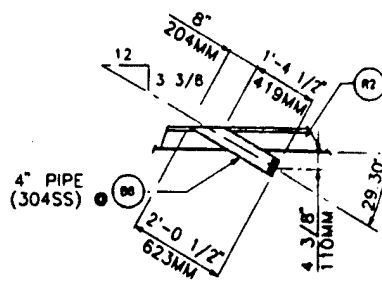


SITE PORT DETAIL
IN COMBUSTION CHAMBER

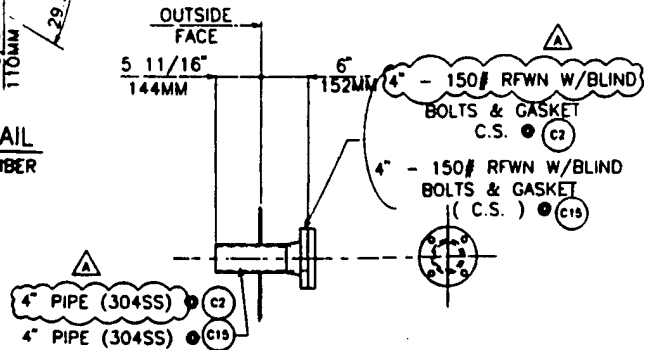


FLANGED CONNECTION DETAIL (TYPICAL)

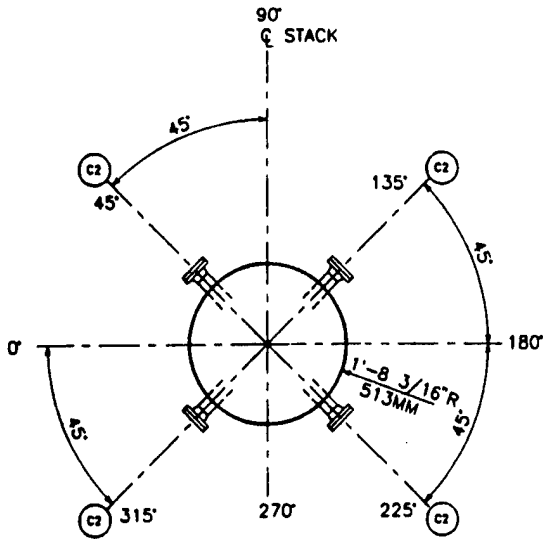



EPA SAMPLE PORTS

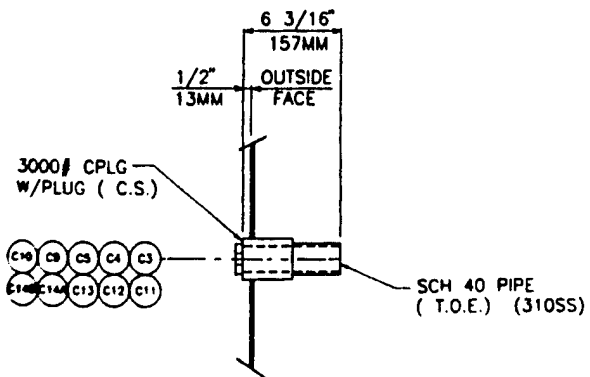


CONNECTION DETAIL (TYPICAL)

JOB INFORMATION		
CUSTOMER: ROY F WESTON, INC.		
P.O. NO: 43366		
JOBSITE: ALPINE, AL		
END USER: U.S. ARMY ENVIRONMENTAL CENTER		
SERVICE: AFTER BURNER SYSTEM		
ARRITECH JOB NO: U-120		
 8508 S. Lewis, Suite 230 Tulsa, OK 74136 ENVIRONMENTAL SYSTEMS, INCORPORATED		
DRAWING TITLE		
GENERAL ARRANGEMENTS - SECTIONS		
DRAWN BY: OJ	DATE: 1/10/95	JOB NO: U-120
CHK'D BY: JLB	DATE: 1/11/95	DRAWING NO: 1B
APPR'D BY:	DATE:	REVISION NO: 2


2

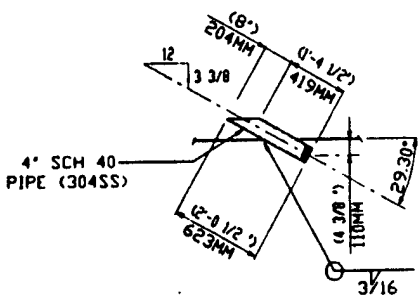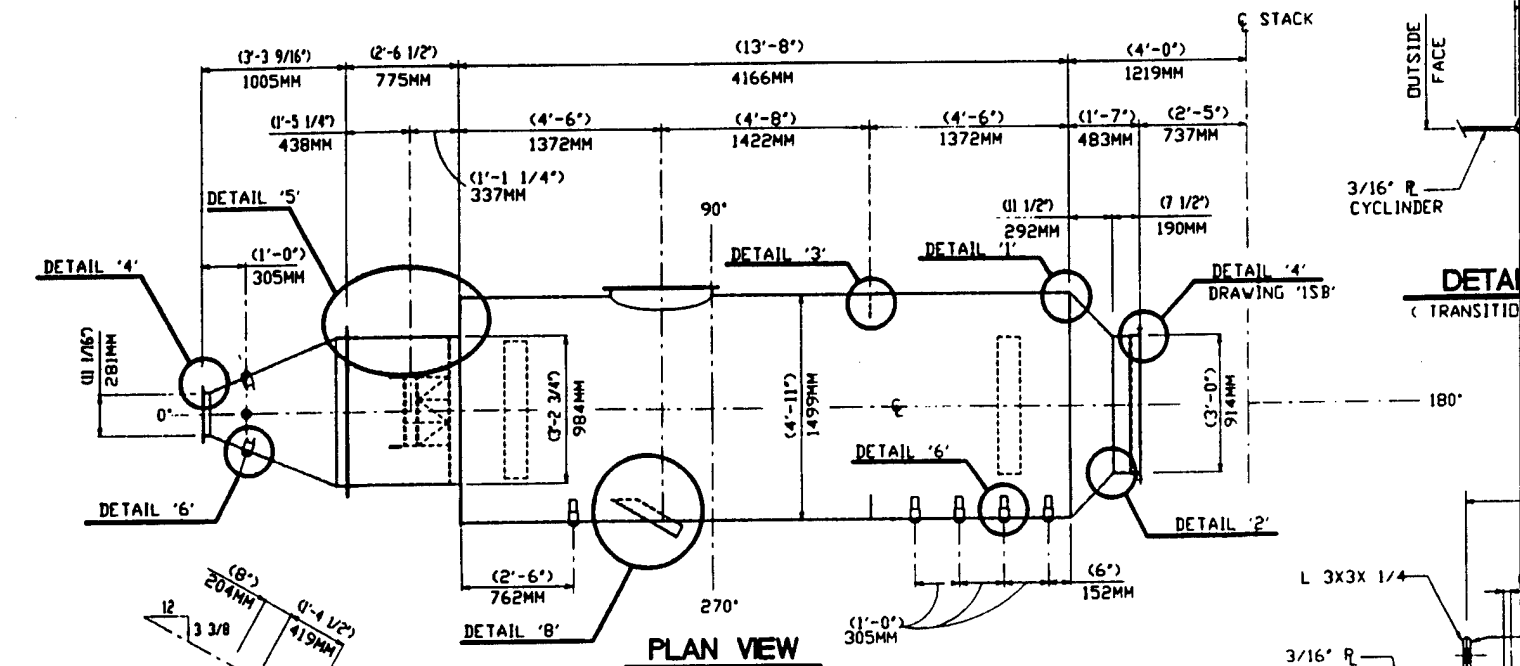

DETAIL '8'

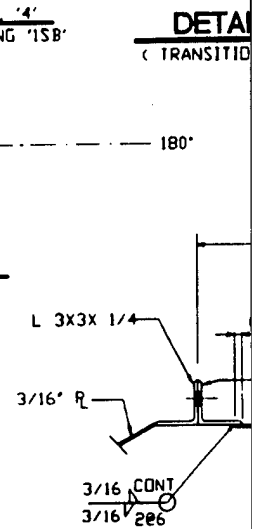




DETAIL '4'
DRAWING '15B'

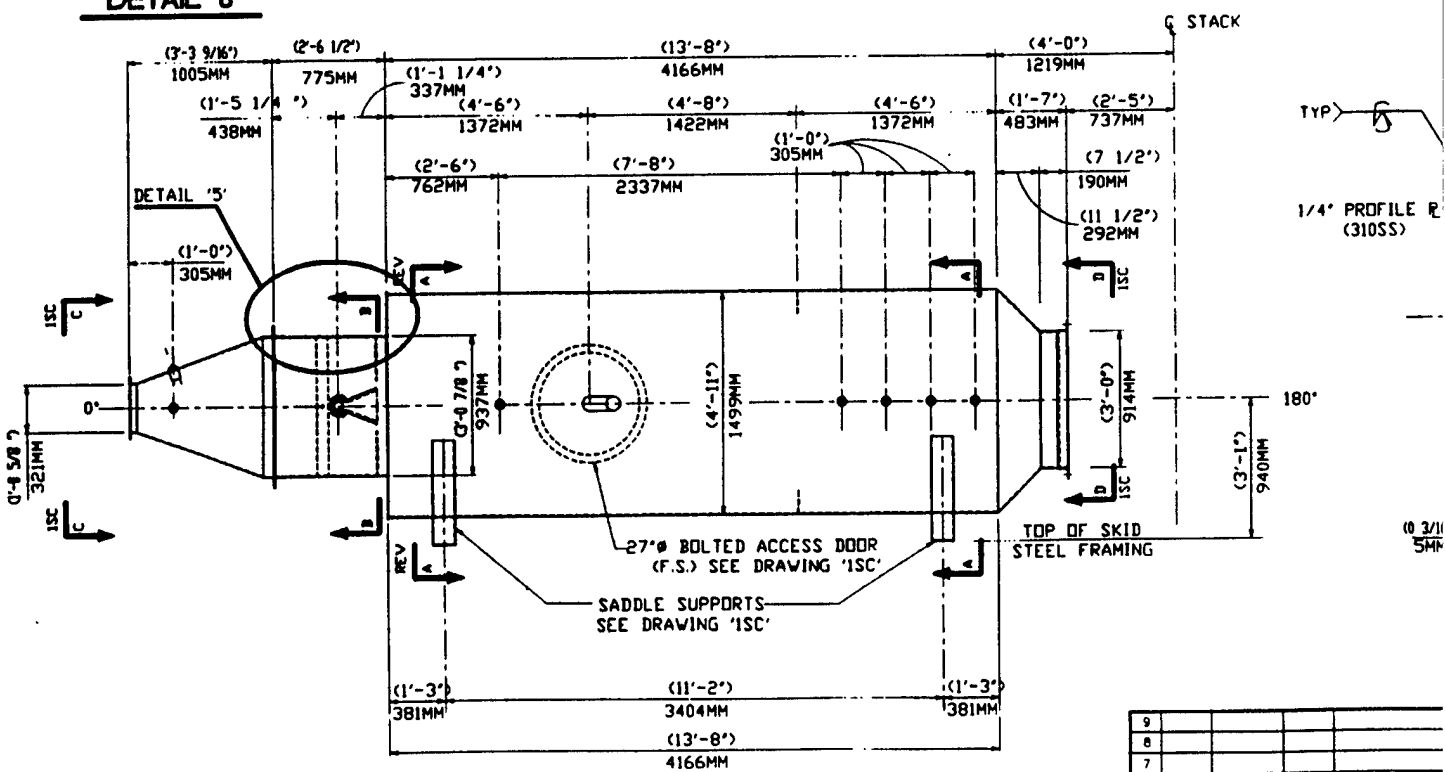

ELEVATION VIEW
(270°)

9			
8			
7			
6			
5			
4			
3			
2			
1	Du	3/10/95	JL B REVISED P.L.R
NO	BY	DAIL	CHK'D

①

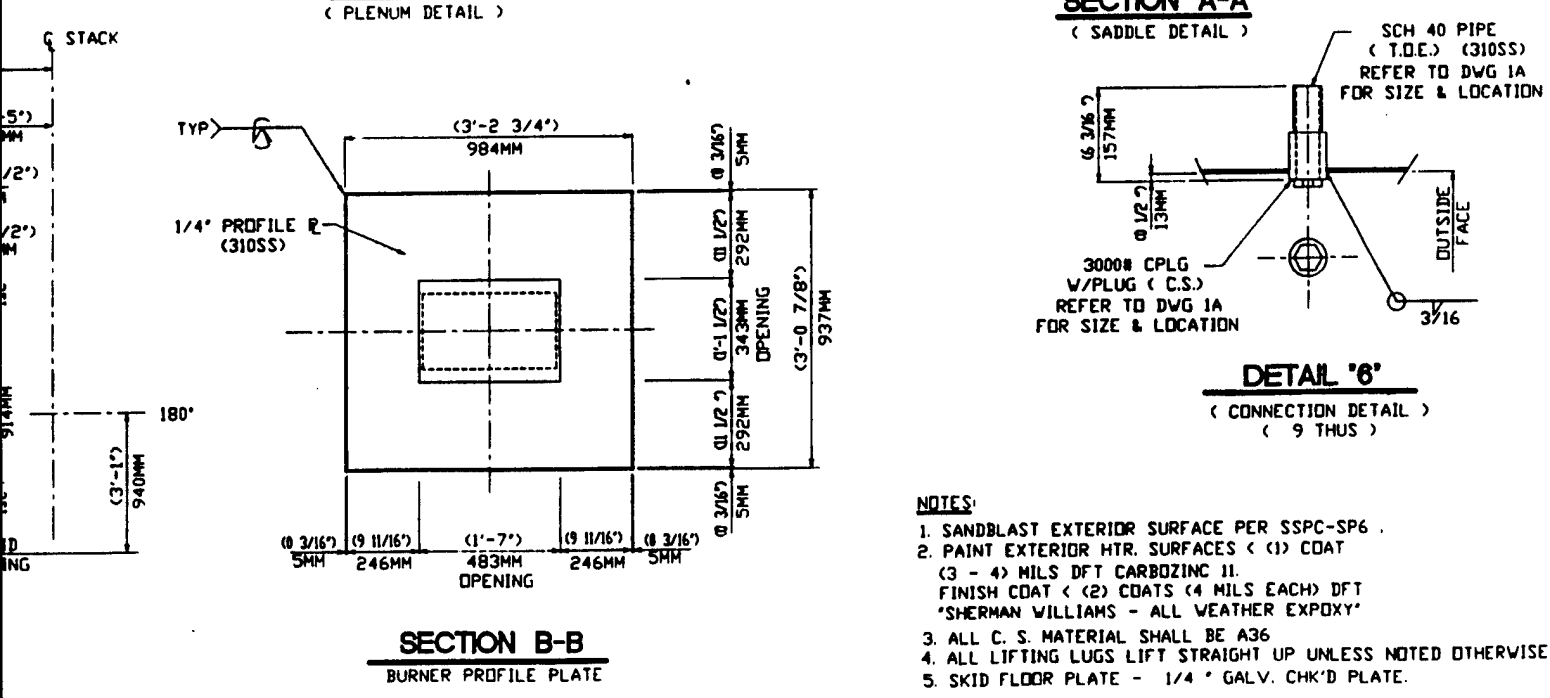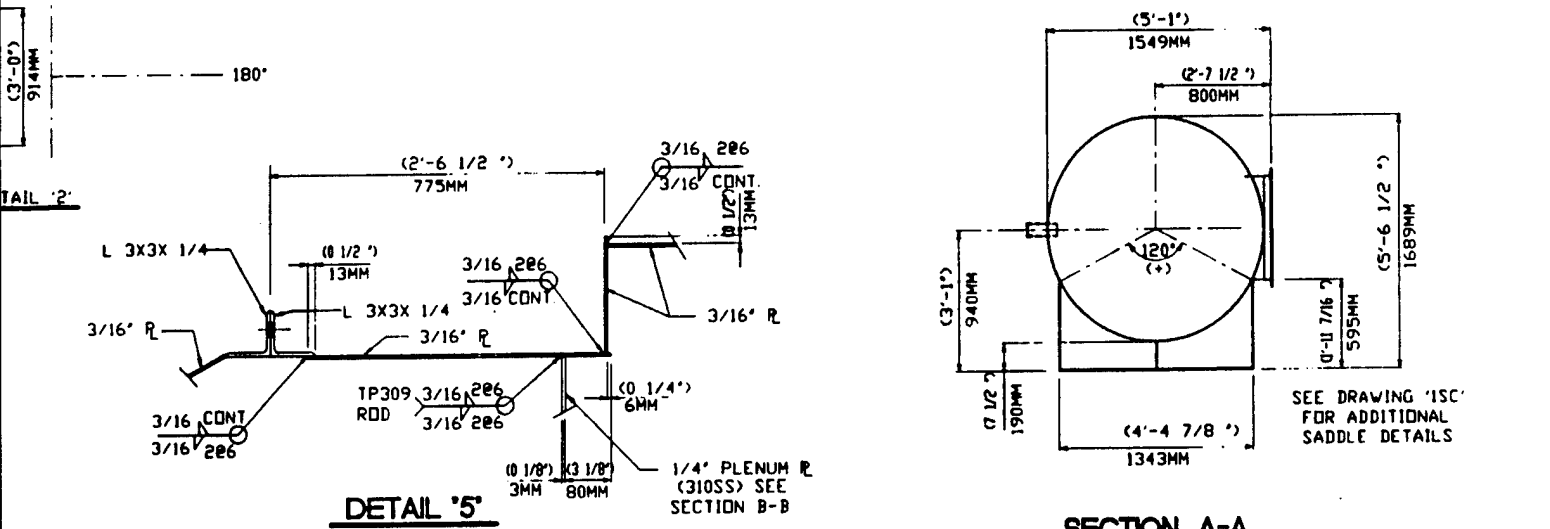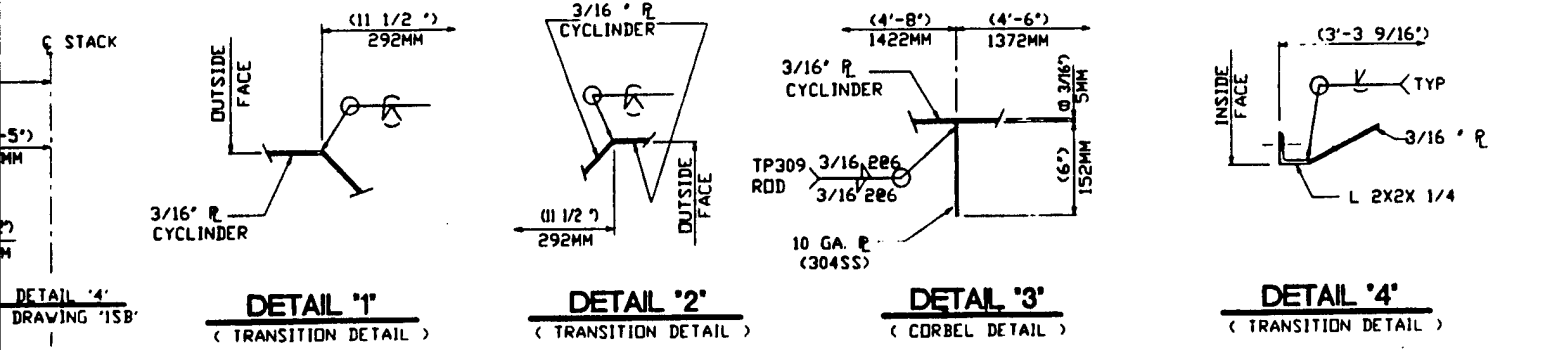

- NOTES:**
- SANDBLAST EXTERIOR SURFACE PER SSPC-SP6 .
 - PAINT EXTERIOR HTR. SURFACES < (1) COAT (3 - 4) MILS DFT CARBOZINC II. FINISH COAT < (2) COATS (4 MILS EACH) DFT 'SHERMAN WILLIAMS - ALL WEATHER EXPOXY'
 - ALL C. S. MATERIAL SHALL BE A36
 - ALL LIFTING LUGS LEFT STRAIGHT UP UNLESS NOTED OTHERWISE.
 - SKID FLOOR PLATE - 1/4" GALV. CHK'D PLATE.

REVISION				JOB INFORMATION	
9				CUSTOMER:	RDY F WESTON, INC
8				P.O. NO.	43366
7				JOB SITE:	ALPINE, AL
6				END USER:	U.S. ARMY ENVIRONMENTAL CENTER
5				SERVICE:	AFTER BURNER SYSTEM
4				ARKTECH JOB NO.	1J-120
3					
2					
1	DU	3/10/95	J.B.	REVISION DESCRIPTION	REVISED PER CUSTOMER COMMENTS
NO	BY	DATE	CHK'D	REVISION DESCRIPTION	

Artech ENVIRONMENTAL SYSTEMS, INCORPORATED


6506 S. Lewis, Suite 230
Luiso, OK 74136

DRAWING TITLE: STEEL ARRANGEMENT AFTER BURNER

DRAWN BY: DU	DATE: 12.14/94	JOB NO: 1J-120
CHK'D BY: J.B.	DATE: 1/12/95	DRAWING NO: 15A
APPR'D BY:	DATE: / /	REVISION NO: 1


CADD DWG: 1J12015A.DWG
CADD DWG: 1J12015A.DWG

2

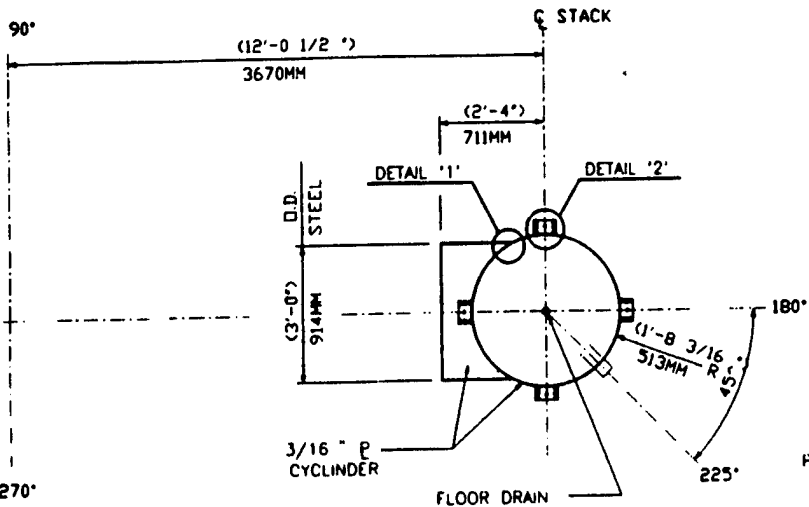


SECTION C-C
● STACK FLOOR


- NOTES:**
- SANDBLAST EXTERIOR SURFACE PER SSPC-SP6.
 - PAINT EXTERIOR HTR. SURFACES WITH (1) COAT (3 - 4) MILS DFT CARBOZINC 11. FINISH COAT WITH (2) COATS (4 MILS EACH) DFT "SHERMAN WILLIAMS - ALL WEATHER EPOXY".
 - ALL C. S. MATERIAL SHALL BE A36
 - ALL LIFTING LUGS LIFT STRAIGHT UP UNLESS NOTED OTHERWISE.
 - SKID FLOOR PLATE - 1/4" GALV. CHK'D PLATE.

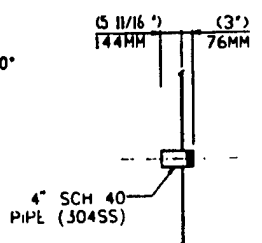


DETAIL '8'
● SITE PORT

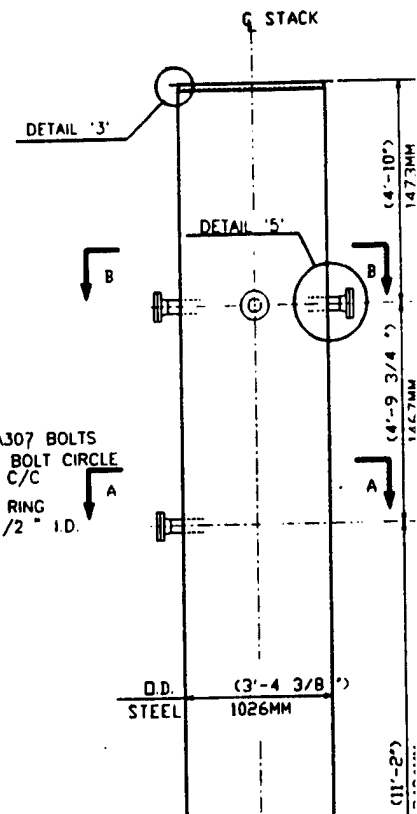


ELEVATION VIEW
(270°)

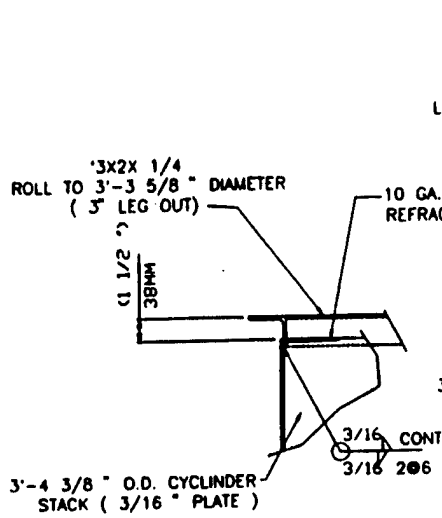


DETAIL '3'
(STACK CAP RING)

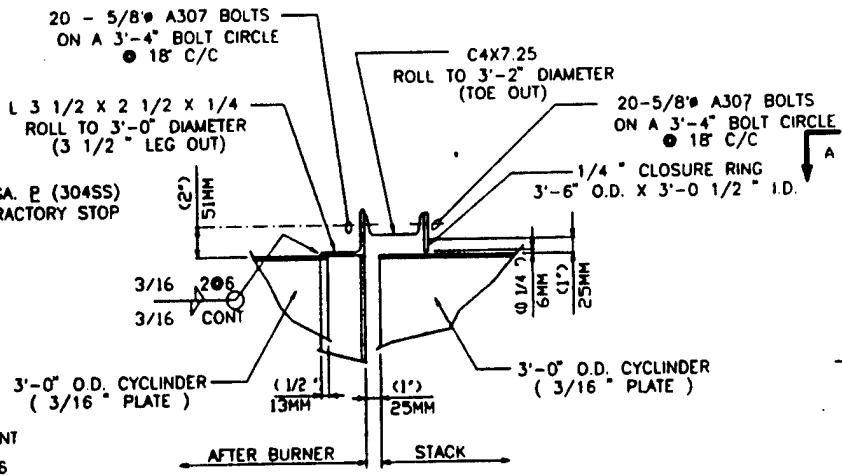


DETAIL '4'
(SLIP JOINT)

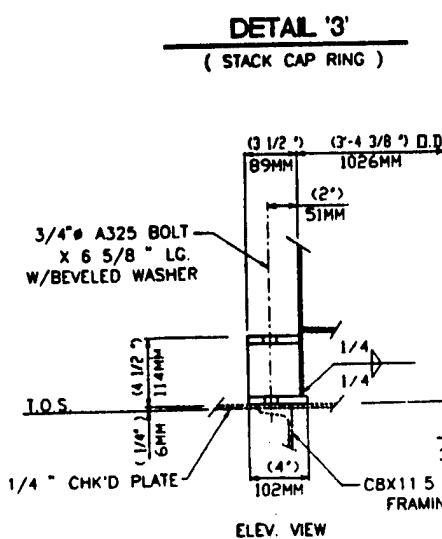

ELEV. VIEW

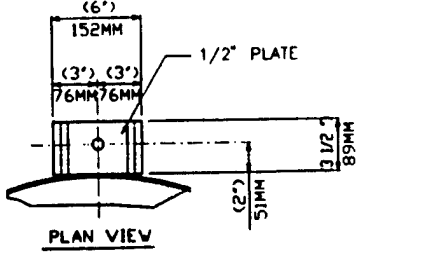


PLAN VIEW

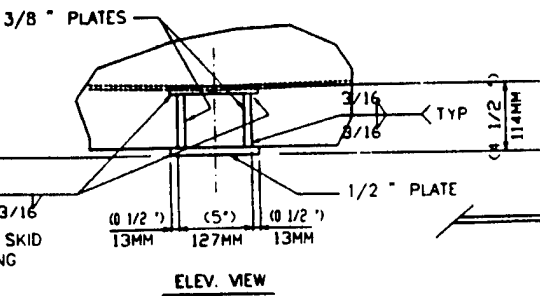

ELEV. VIEW



DETAIL '2'
(BASE DETAIL)

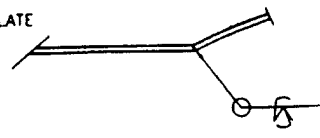


DETAIL '1'
(CYLINDER DETAIL)

9				
8				
7				
6				
5				
4				
3				
2	AH	6/11/96	W	FIELD MODIFICA
1	DJ	3/10/95	LB	REMOVED BOLTS
NO	BY	DATE	CHK'D	



1

HERWISE.



STACK

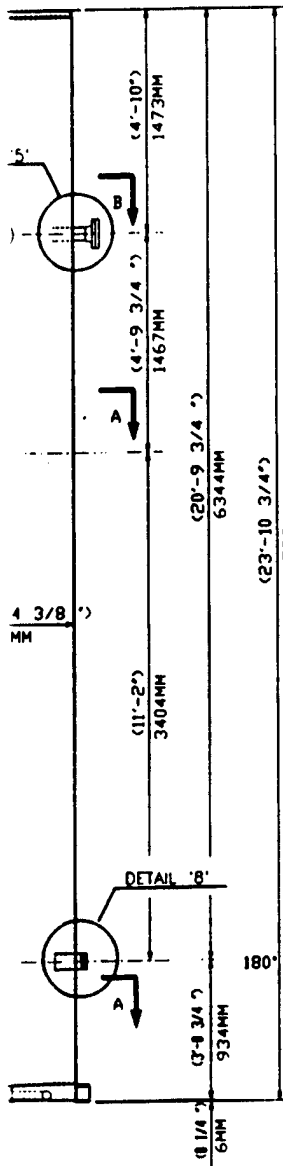

SECTION VIEW
270°

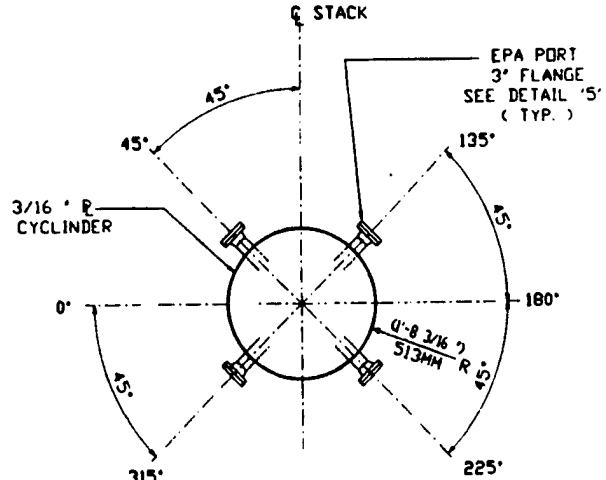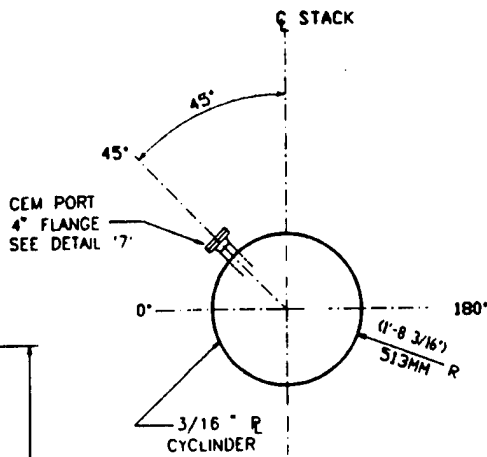


SAMPLE PORTS PLAN VIEW

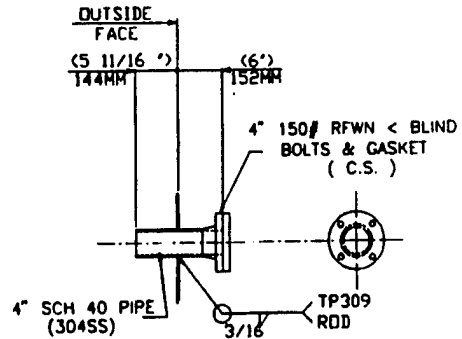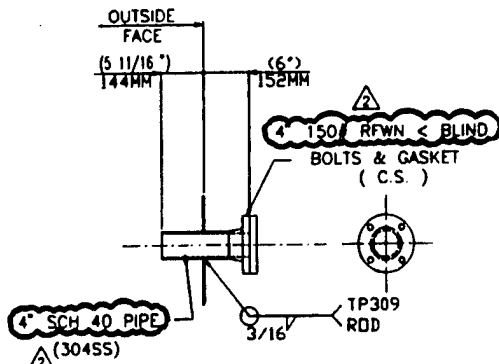

TP309 ROD (3/16)

1 1/2 inch S.R. ELBOW (SCH 40) (304SS)


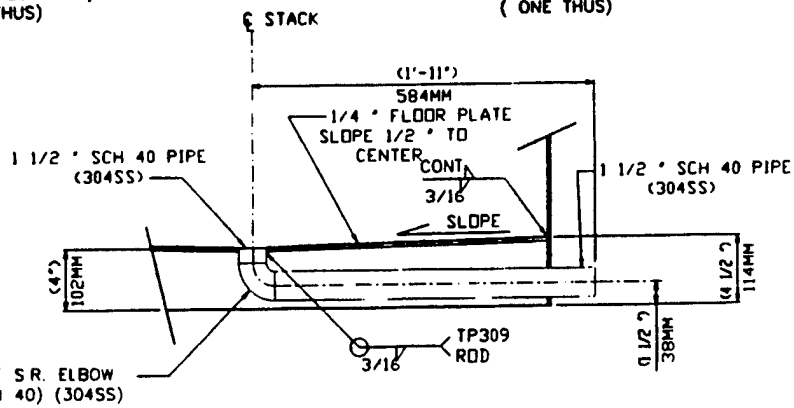


JOB INFORMATION	
CUSTOMER	ROY F WESTON, INC
P.O. NO.	43366
JOBSITE	ALPINE, AL
END USER	U.S. ARMY ENVIRONMENTAL CENTER
SERVICE	AFTER BURNER SYSTEM
ARRTECH JOB NO.	1J-120
FIELD MODIFICATIONS	
B	REMOVED BOLTED ACCESS DOOR & ADDED SITE PORT
D	REVISION DESCRIPTION


6506 S. Lewis, Suite 230 Tulsa, OK 74136		
DRAWING TITLE		
STEEL ARRANGEMENT - STACK & DETAIL		
DRAWN BY	DATE	JOB NO.
CHK'D BY	DATE	DRAWING NO.
APPR'D BY	DATE	REVISION NO.

CADD DWG: U12015B.DGN
CADD DWG: U1205B.DGN

(2)

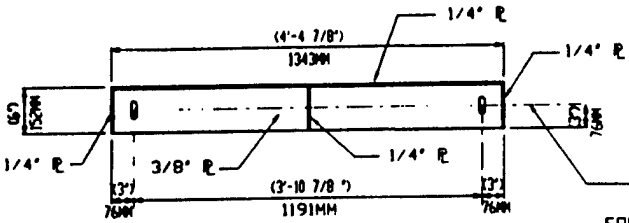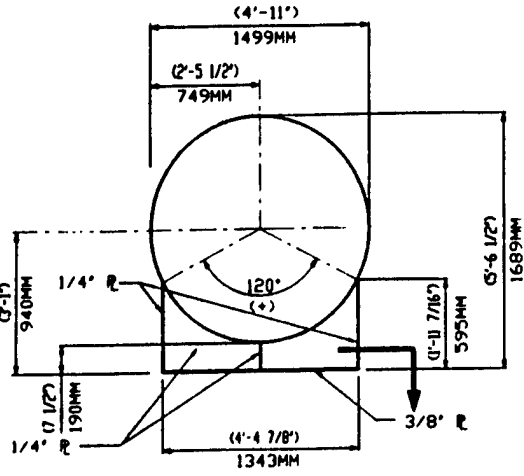


SADDLE DETAILS

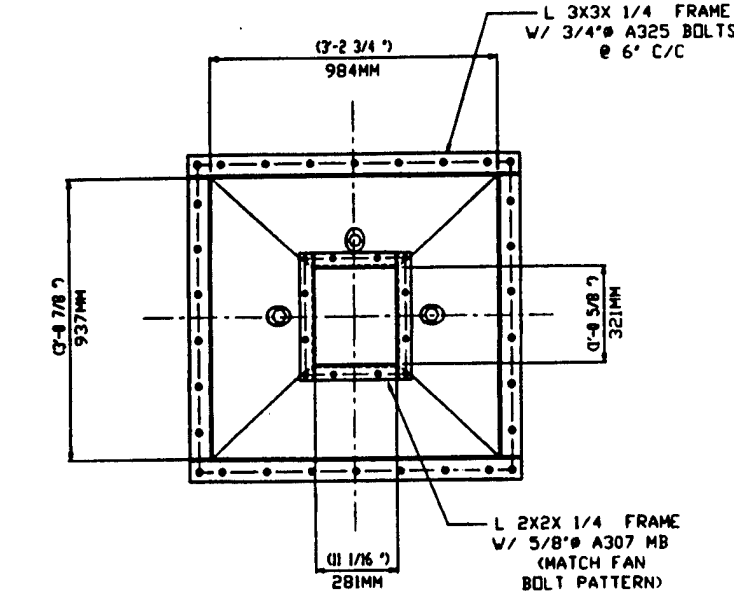


INLET TRANSITION



SECTION C-C
FROM DWG. ISA

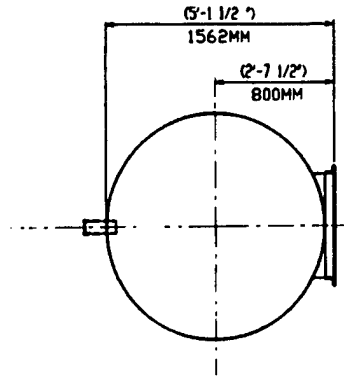

27\" BOLTED ACCESS
CROSS-SECTION

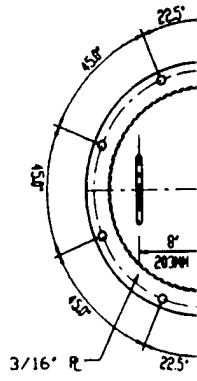

L 2 1/2 X 2 1/2 X 1/4
ROLL TO 2'-3\" ID
(TOE OUT)

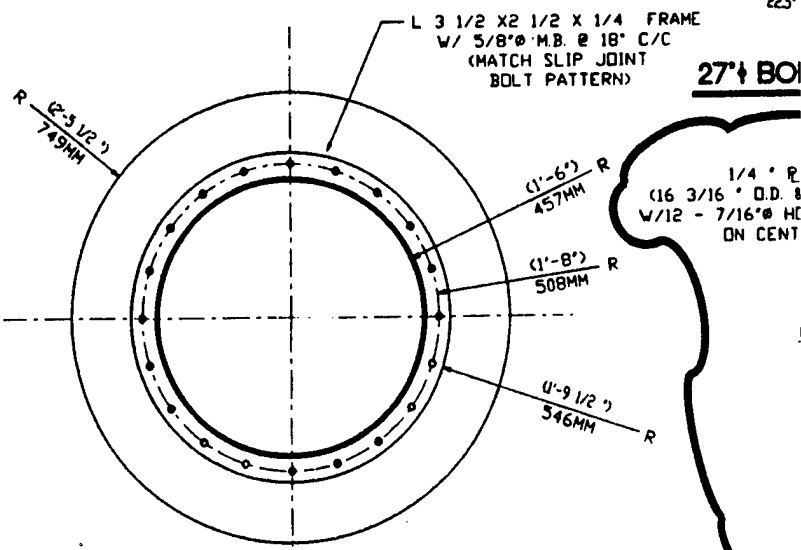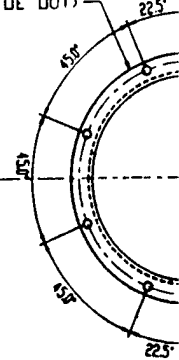




OUTLET TRANSITION

SECTION D-D
FROM DWG. ISA



- NOTES:**
- SANDBLAST EXTERIOR SURFACE PER SSPC-SP6.
 - PAIN EXTERIOR HTR. SURFACES W/ (1) COAT (3 - 4) MILS DFT CARBOZINC 11. FINISH COAT W/ (2) COATS (4 MILS EACH) DFT 'SHERMAN WILLIAMS - ALL WEATHER EPOXY'.
 - ALL C. S. MATERIAL SHALL BE A36.
 - ALL LIFTING LUGS LIFT STRAIGHT UP UNLESS NOTED OTHERWISE.
 - SKID FLOOR PLATE - 1/4\" GALV. CHK'D PLATE.

9				
8				
7				
6				
5				
4				
3				
2	DL	5/26/95	JLH	REVISED INLET
1	JU	7/13/95	JLB	REMOVED 18\" A
NO	BY	DATE	CHK'D	

(1)

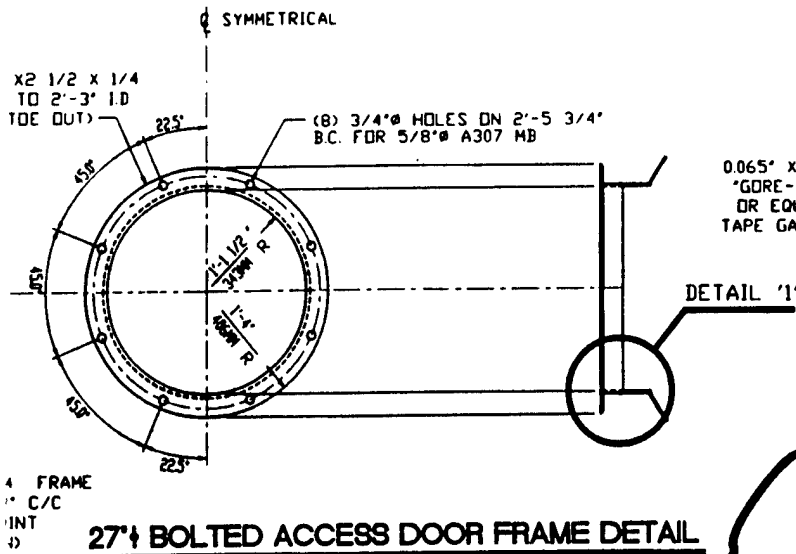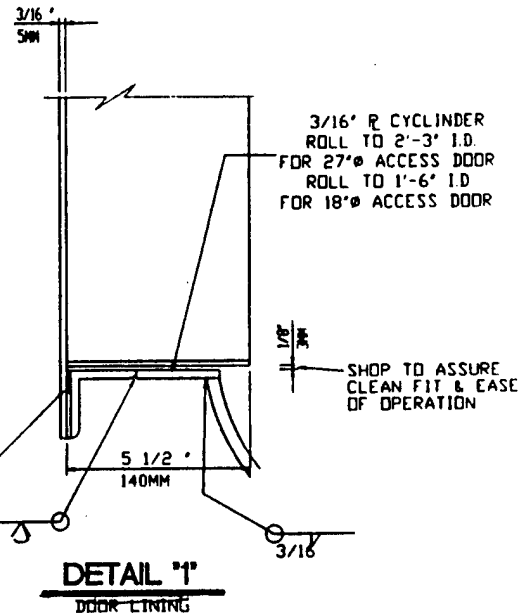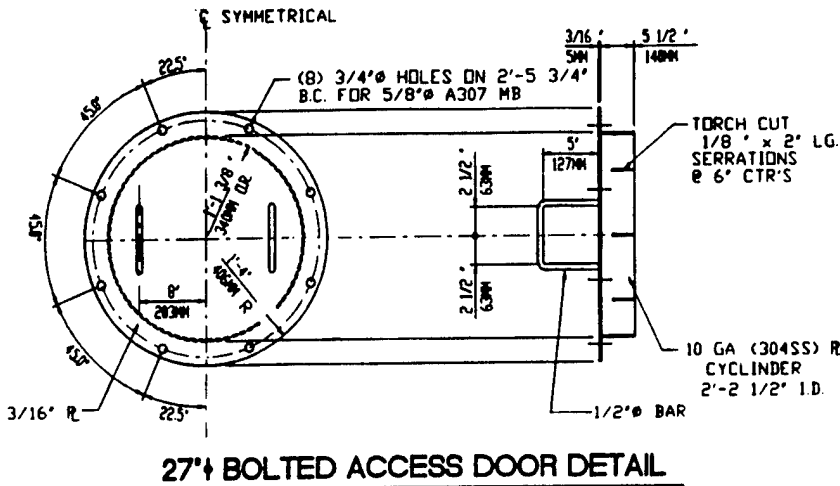

4 FRAME
 * C/C
 INT
 D)

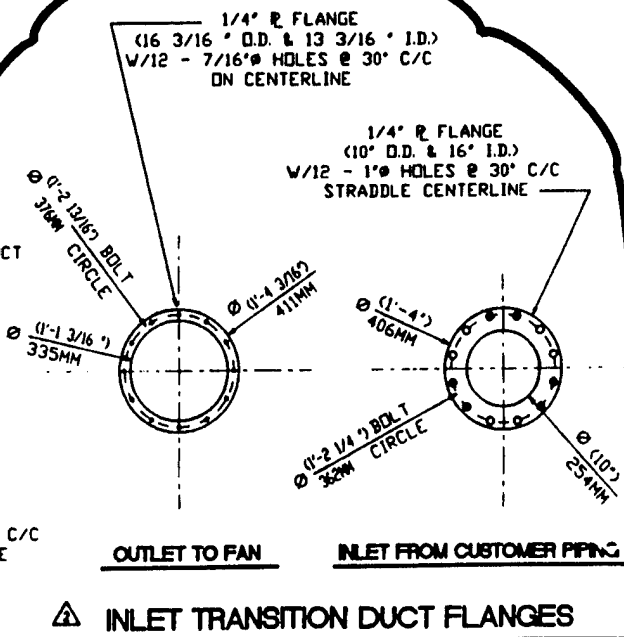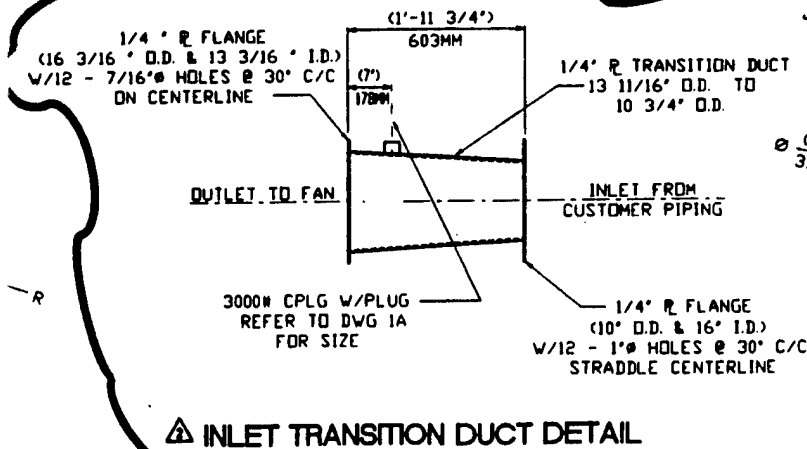


REV	DESCRIPTION
1	REVISED INLET DUCT SIZE & FLANGES
2	REMOVED 18" ACCESS DOOR & ADDED INLET DUCT
3	REVISION DESCRIPTION

JOB INFORMATION	
CUSTOMER	RDY F WESTON, INC
P.O. NO.	4336A
JOB SITE	ALPINE, AL
END USER	US ARMY ENVIRONMENTAL CENTER
SERVICE	AFTER BUMMER SYSTEM
ARITECH JOB NO.	1J-120


DRAWING TITLE		
STEEL ARRANGEMENT - DETAILS		
DRAWN BY	DATE	JOB NO.
CHK'D BY	DATE	DRAWING NO.
APPR'D BY	DATE	REVISION NO.

CADD DWG: 1J120ISC.DWG
 CADD DWG: 1J120SC.DWG

2

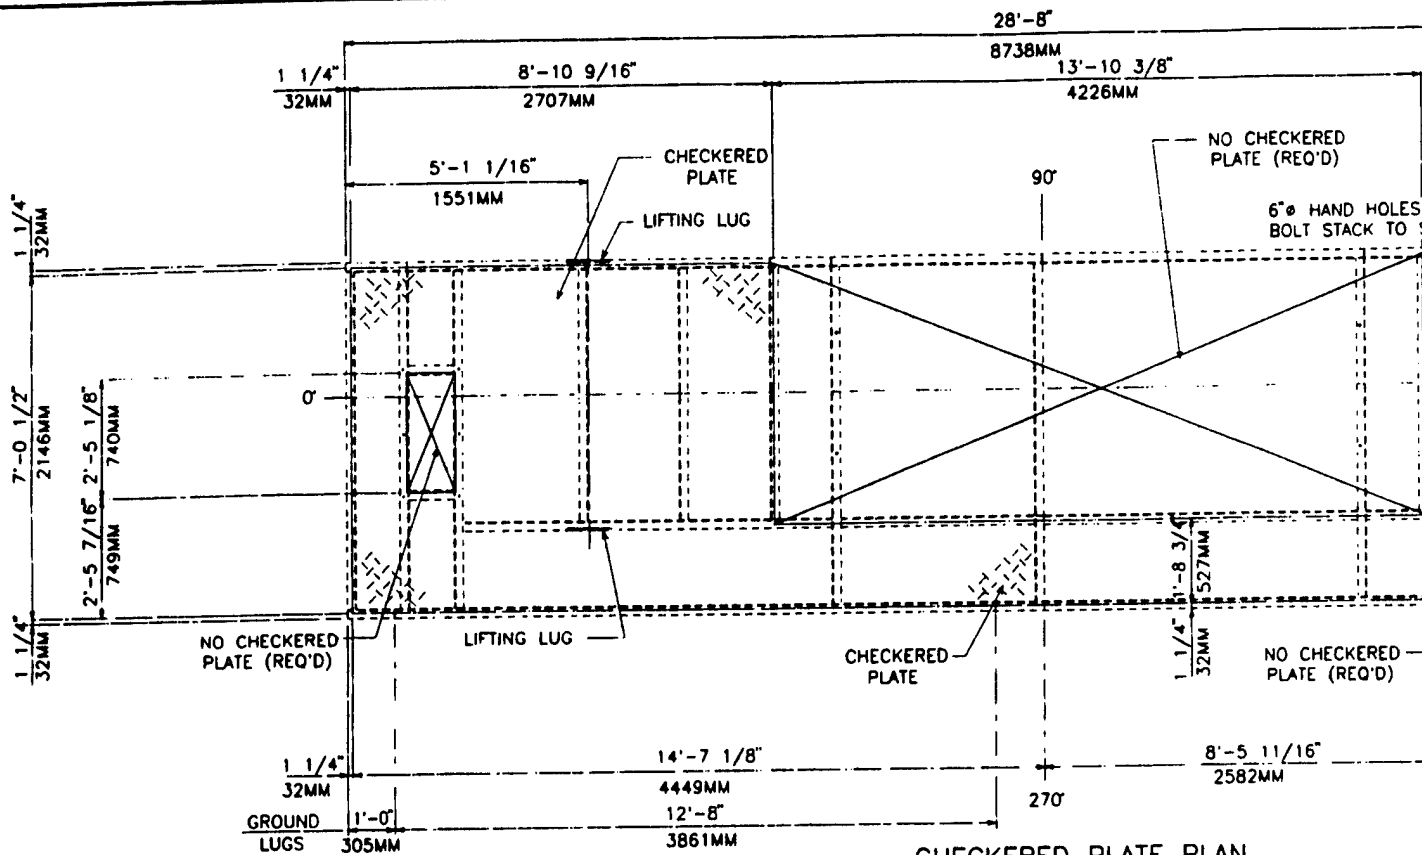

CHECKERED PLATE PLAN
SKID FRAMING PLAN

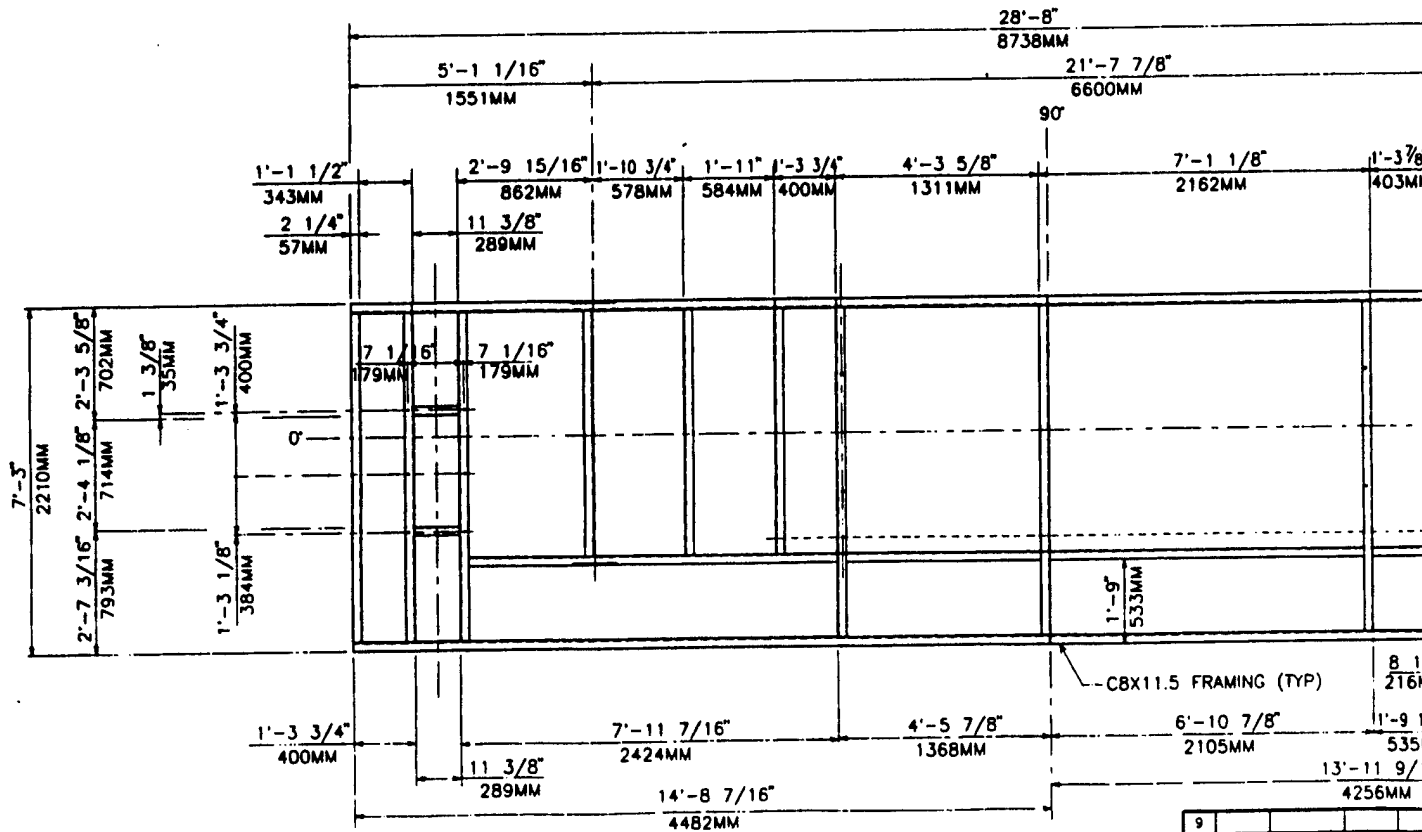



SKID STEEL PLAN
SKID FRAMING PLAN

NOTES:


1. SANDBLAST EXTERIOR SURFACE PER SSPC-SP6
2. PAINT EXTERIOR HTR. SURFACES W/(1) COAT
(3 - 4) MILS DFT CARBOZINC 11,
FINISH COAT W/(2) COATS (4 MILS EACH) DFT
"SHERMAN WILLIAMS - ALL WEATHER EXPOXY"
3. ALL C. S. MATERIAL SHALL BE A36
4. ALL LIFTING LUGS LIFT STRAIGHT UP UNLESS NOTED OTHERWISE.
5. SKID FLOOR PLATE - 1/4" GALV. CHK'D PLATE.

9				
8				
7				
6				
5				
4				
3				
2				
1	OU	3/10/95	JLB	R
NO.	BY	DATE	CHK'D	



①

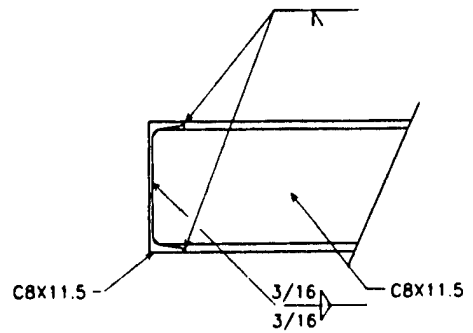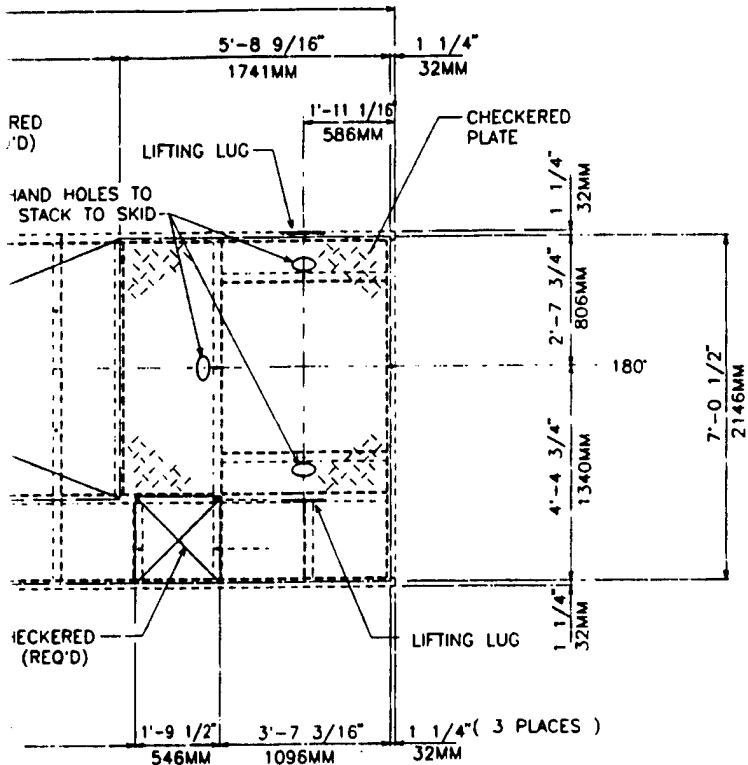


DETAIL '1'

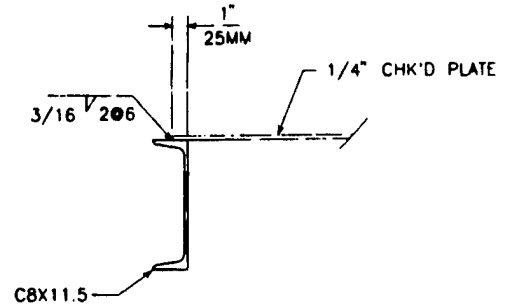

DETAIL '2'

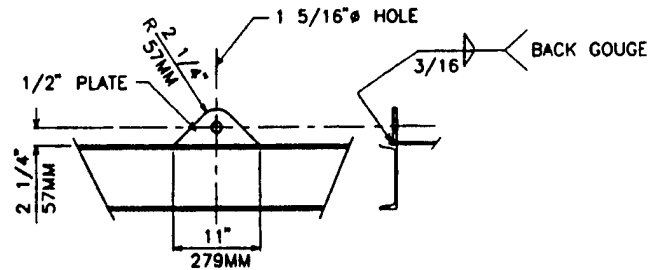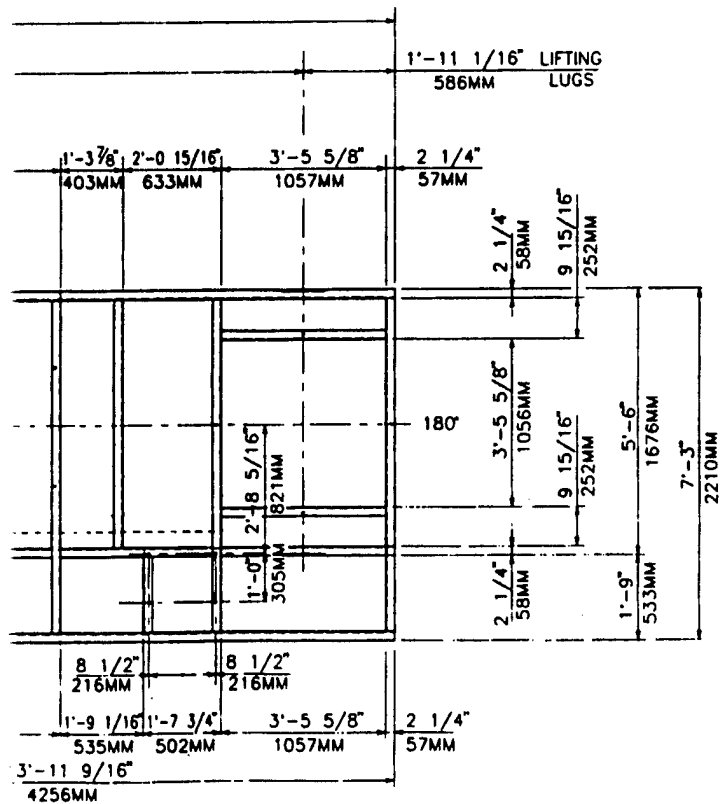

LIFTING LUG
(4 THUS)

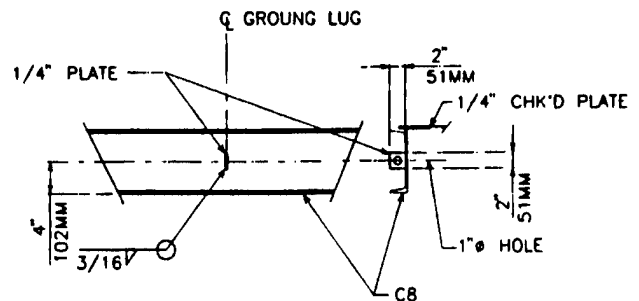


GROUND LUGS
(2 THUS)

NO.	CHK'D	REVISION DESCRIPTION
1	JLB	REVISED SKID & ADDED GROUND LUGS
2	CHK'D	


JOB INFORMATION	
CUSTOMER:	ROY F WESTON, INC
P.O. NO.:	43366
JOB SITE:	ALPINE, AL.
END USER:	U.S. ARMY ENVIRONMENTAL CENTER
SERVICE:	AFTER BURNER SYSTEM
ARRTECH JOB NO.:	U-120

DRAWING TITLE		
STEEL ARRANGEMENT - SKID & DETAILS		
DRAWN BY	DATE	JOB NO.
OU	12/14/94	U-120
CHK'D BY	DATE	DRAWING NO.
JLB	1/12/95	1SD
APPR'D BY	DATE	REVISION NO.
		1

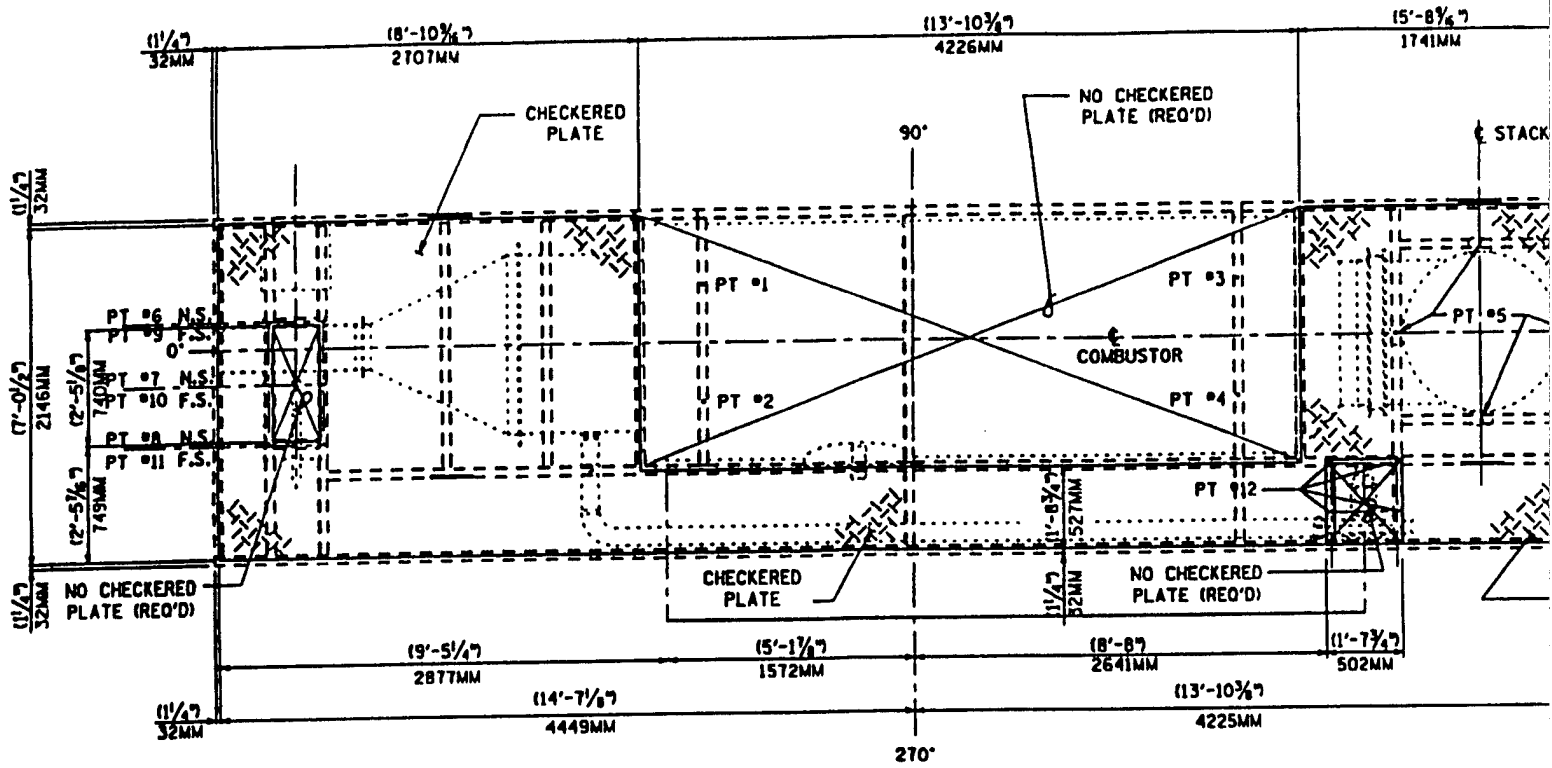

NOTE:
 (N.S.) INDICATES NEAR SIDE
 (F.S.) INDICATES FAR SIDE


FOUNDATION PLAN

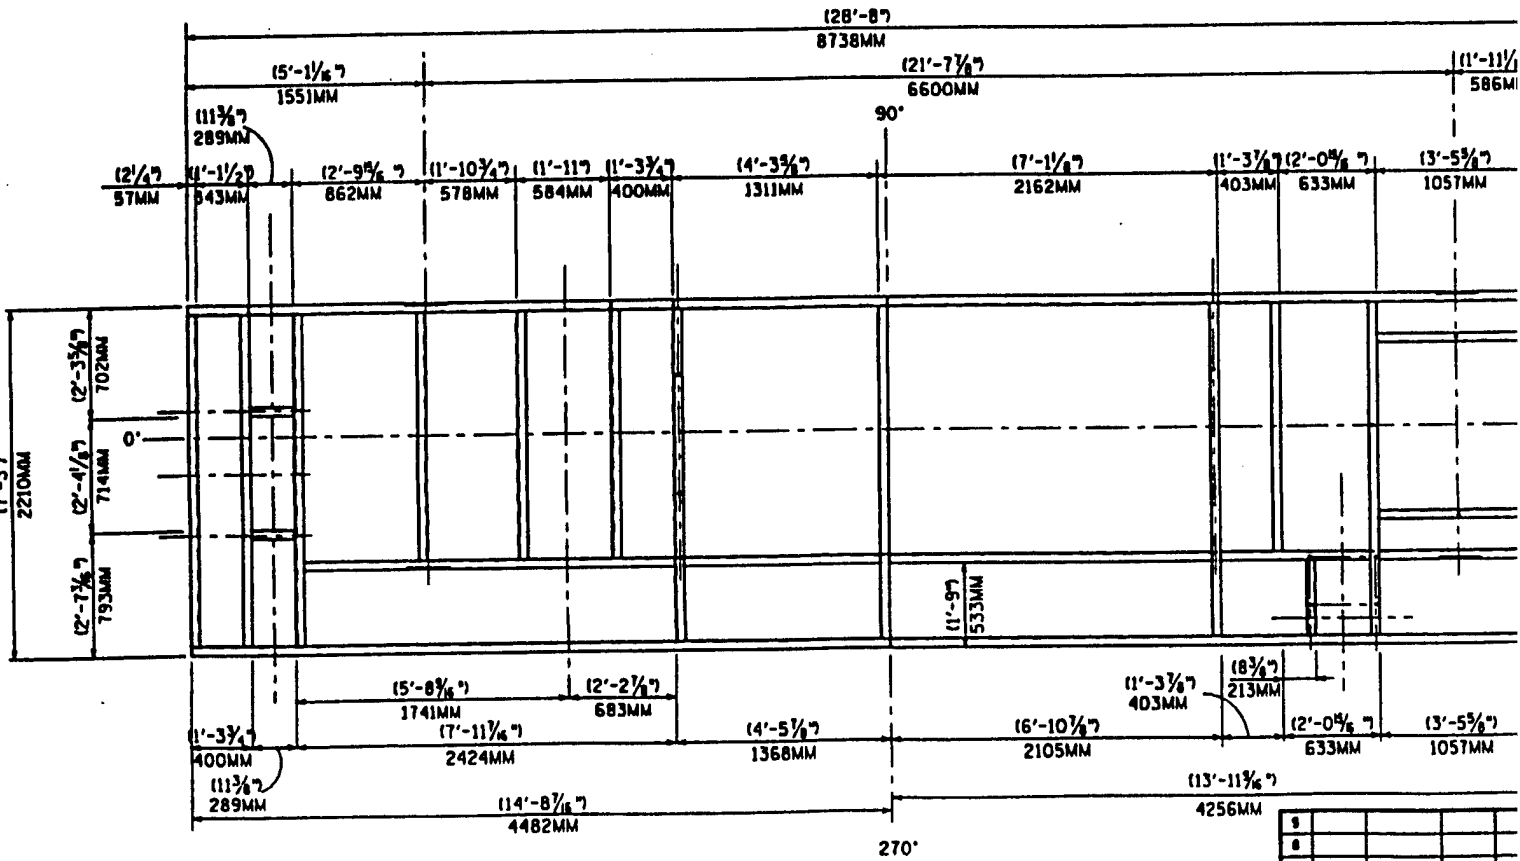

SKID FRAMING PLAN

9			
8			
7			
6			
5			
4			
3			
2	OU	3/10/95	J.B. R
1	OU	1/12/95	J.B. R
NO.	BY	DATE	CHK'D

①

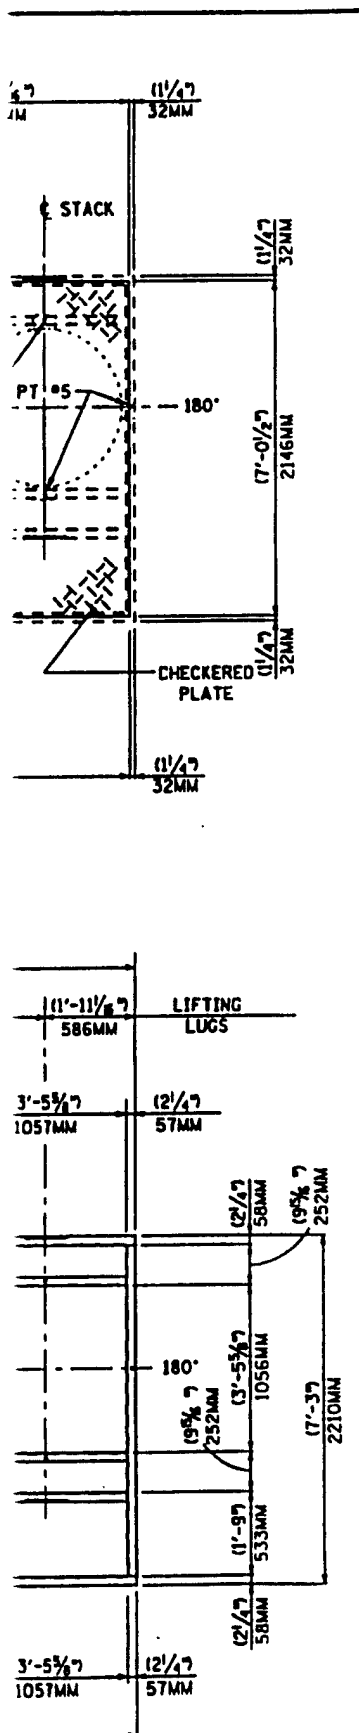

FOUNDATION LOADS										
	DEAD LOAD	WIND (0° - 180°)			WIND (90°-270°)			EARTHQUAKE (ALL)		
		SHEAR	OTM	P _v	SHEAR	OTM	P _v	SHEAR	OTM	P _v
AFTER BURNER										
TOTAL	5,500	1,194	6,567		284	1,930		1,205	6,628	
FIXED BEARING	3,582	712	3,916	(+) 1,003	142	965	(+) 87	785	4,318	(+) 387
MAXIMUM = DL + P _v		PT #1, #2	2,794		PT #1, #2	1,780		PT #1, #2		2,178
MINIMUM = 90%DL - P _v		PT #1, #2	609		PT #1, #2	1,519		PT #1, #2		1,225
SLIDE BEARING	1,918	482	2,651	(+) 679	142	965	(+) 87	420	2,310	(+) 207
MAXIMUM = DL + P _v		PT #3, #4	1,638		PT #3, #4	1,057		PT #3, #4		1,166
MINIMUM = 90%DL - P _v		PT #3, #4	184		PT #3, #4	869		PT #3, #4		656
STACK										
TOTAL	4,352	1,356	16,161		1,356	16,161		954	15,198	
PER BOLT	1,088	339		(+) 4,370	339		(+) 4,370	477		(+) 4,110
MAXIMUM = DL + P _v		PT #5	6,458		PT #5	5,458		PT #5		5,198
MINIMUM = 90%DL - P _v		PT #5	-3,391		PT #5	-3,391		PT #5		-3,131
FANS										
ID FAN	360	152	310		60	120	(+) 70	79	237	(+) 139
PER BOLT	60	25		(+) 59	10		(+) 18	13		(+) 70
MAXIMUM = DL + P _v		PT #6, #8, #9, #11	119		PT #7, #10	130		PT #6, #8, #9, #11		130
MINIMUM = 90%DL - P _v		PT #6, #8, #9, #11	-5		PT #7, #10	-16		PT #6, #8, #9, #11		-16
		PT #7, #10	60		PT #6, #8, #9, #11	78		PT #7, #10		199
FD FAN	300	230	345		115	173		66	132	
PER BOLT	75	58		(+) 173	29		(+) 60	16		66
MAXIMUM = DL + P _v		PT #12	248		PT #12	135		PT #12		141
MINIMUM = 90%DL - P _v		PT #12	-106		PT #12	7		PT #12		1
SKID										
TOTAL	3,300									

ALL LOADS IN POUNDS (LBS) EXCEPT OTM FOOT-POUNDS (FT-LBS)

(-) INDICATES UPLIFT
 OTM = OVERTURNING MOMENT
 P_v = VERTICAL LOAD DUE TO OTM

CODE:
 ANSI A58.1, 1982
 WIND VELOCITY = 90 MPH
 IMPORTANCE FACTOR = 1.07
 EARTHQUAKE ZONE = 4
 IMPORTANCE FACTOR = 1.25

- NOTES:**
- SANDBLAST EXTERIOR SURFACE PER SSPC-SP6 .
 - PAINT EXTERIOR HTR. SURFACES W (1) COAT (3 - 4) MILS DFT CARBOZINC 11. FINISH COAT W (2) COATS (4 MILS EACH) DFT 'SHERMAN WILLIAMS - ALL WEATHER EXPOXY'.
 - ALL C. S. MATERIAL SHALL BE A36
 - ALL LIFTING LUGS LIFT STRAIGHT UP UNLESS NOTED OTHERWISE.
 - SKID FLOOR PLATE - 1/4" GALV. CHK'D PLATE.

CHK'D	REVISION DESCRIPTION
J.B	REVISED WIND VELOCITY & ADDED EARTHQUAKE LOADING
J.B	REVISED STACK LOADING

JOB INFORMATION
 CUSTOMER: ROY F. WESTON, INC.
 P.O. NO. 1 43366
 JOBSITE: ALPINE, AL.
 END USER: U.S. ARMY ENVIRONMENTAL CENTER
 SERVICE: AFTER BURNER SYSTEM
 ARRTech JOB NO. 1 J-120

Artech
 TULSA, OKLAHOMA
 ENVIRONMENTAL SYSTEMS, INCORPORATED
 BLOOMINGTON, MINNESOTA


FOUNDATION PLAN

DRAWING TITLE

DRAWN BY DU DATE 10/13/94 JOB NO. J-120 As Built
 CHK'D BY J.B DATE 1/12/95 DRAWING NO. 2A / 10/11/96
 APPR'D BY DATE / / REVISION NO. (2)

CADD DWG: J120-2A.DCH

2

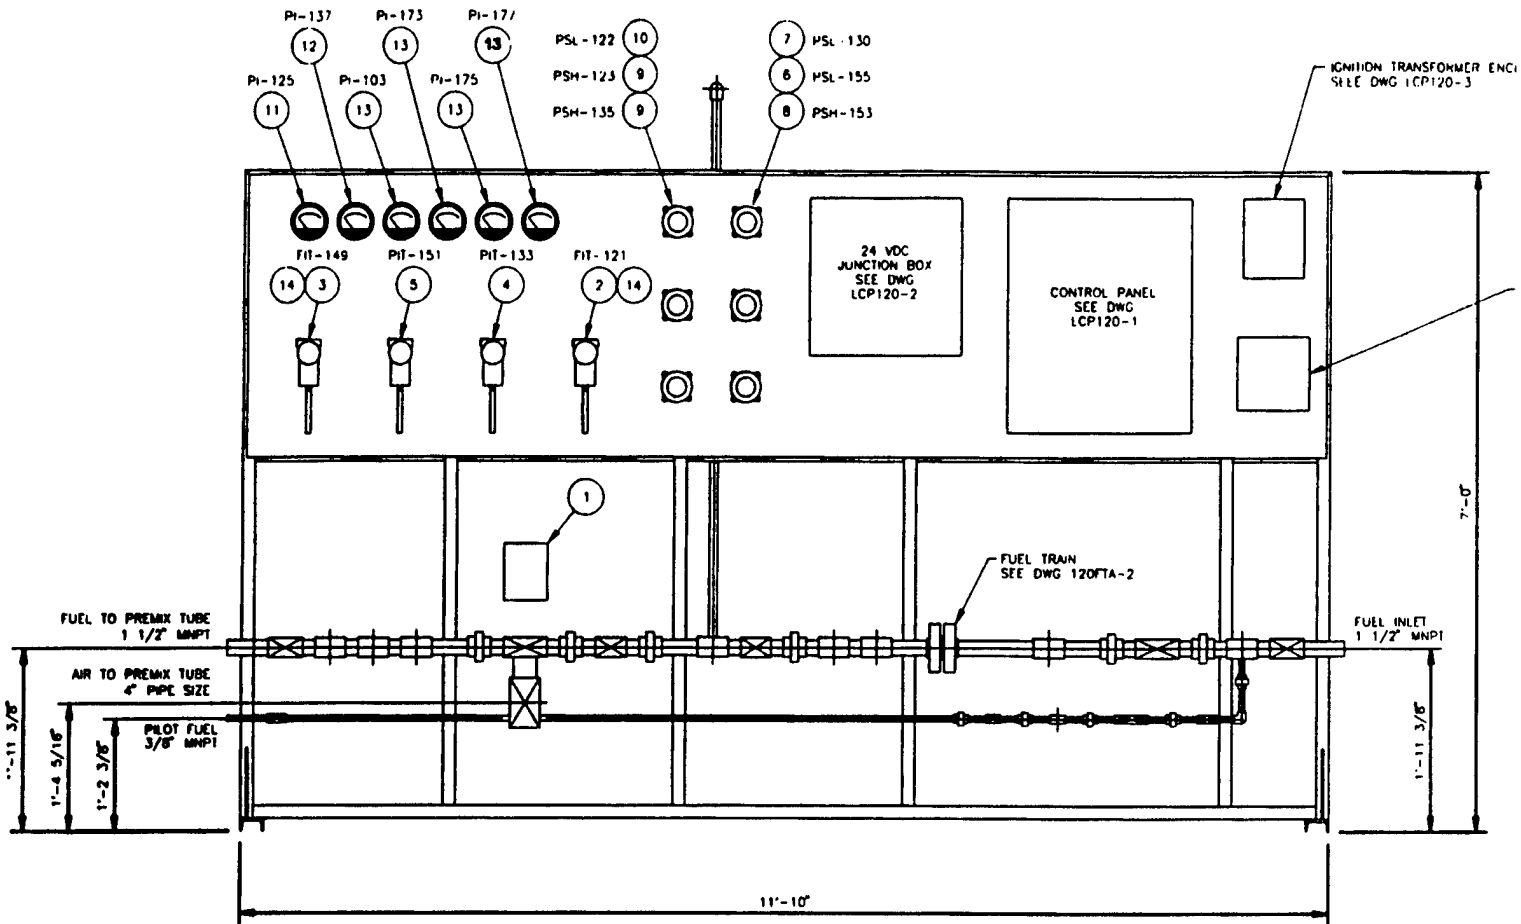

FRONT ELEVATION

GENERAL NOTES



- 1 FUEL RACK FINISH: GREY ENAMEL
- 2 TUBING SHALL BE COPPER WITH BRASS FITTINGS
- 3 CONDUIT SHALL BE RIGID GALVANIZED STEEL (3/4" MINIMUM). INSTALL FLEXIBLE CONDUIT AS REQUIRED FOR MAINTENANCE PURPOSES (18" MINIMUM). CONDUIT FITTINGS SHALL BE CROUSE-HINDS FORM 7 OR EQUAL. INSTALL CONDUIT SEALS AS REQUIRED FOR CLASS 1, DIVISION 2, GROUP D AREA.
- 4 ITEMS 15 & 16 SHALL BE INSTALLED IN PRESSURE TAPS ON FF-121

REFERENCE DRAWINGS

NUMBER	T.T.L.
PID120	PIPING & INSTRUMENT DIAGRAM
LCP120	LOCAL CONTROL PANEL ASSEMBLY
FR120	FUEL RACK FABRICATION

11

IGNITION TRANSFORMER ENCLOSURE
SEE DWG LCP120-3

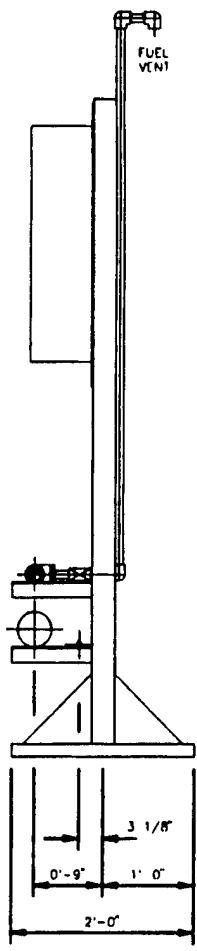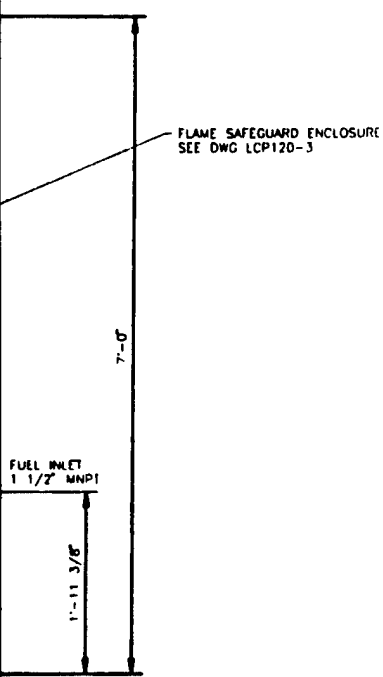

SIDE ELEVATION

BILL OF MATERIAL


ITEM	QTY	DESCRIPTION
1	1	MOTOR, FIRING RATE CONTROL, SEE Aritech SPECIFICATION 120-5
2	1	TRANSMITTER, DP, SEE Aritech SPECIFICATION 120-7
3	1	TRANSMITTER, DP, SEE Aritech SPECIFICATION 120-16
4	1	TRANSMITTER, PRESSURE, SEE Aritech SPECIFICATION 120-8
5	1	TRANSMITTER, PRESSURE, SEE Aritech SPECIFICATION 120-11
6	1	SWITCH, PRESSURE, SEE Aritech SPECIFICATION 120-10
7	1	SWITCH, PRESSURE, SEE Aritech SPECIFICATION 120-12
8	1	SWITCH, PRESSURE, SEE Aritech SPECIFICATION 120-15
9	2	SWITCH, PRESSURE, SEE Aritech SPECIFICATION 120-17
10	1	SWITCH, PRESSURE, SEE Aritech SPECIFICATION 120-18
11	1	GAUGE, PRESSURE, DWYER 2210 (0-10 PSI)
12	1	GAUGE, PRESSURE, DWYER 2205 (0-5 PSI)
13	4	GAUGE, PRESSURE, DWYER 2030 (0-30\"/>

3


REVISIONS					ENGINEERING RECORD				
NO	DESCRIPTION	BY	DATE	CHKD	DATE	SCALE	1\"/>		
0	FOR CONSTRUCTION	JW	3-6-95			1\"/>			
1	REVISED AIR & PILOT PIPE ELEVATION	JW	4-7-95			1\"/>			
2	RECORD	JW	7-4-95			1\"/>			
3	FIELD MODIFICATIONS	CLP	8/1/96			1\"/>			

	PREPARED FOR ROY F. WESTON, INC
	CLIENT JOB
<h3>FUEL TRAIN ASSEMBLY AFTERBURNER</h3>	
APPROVED	DWG. #: FTA120-1 REVISION 3


2

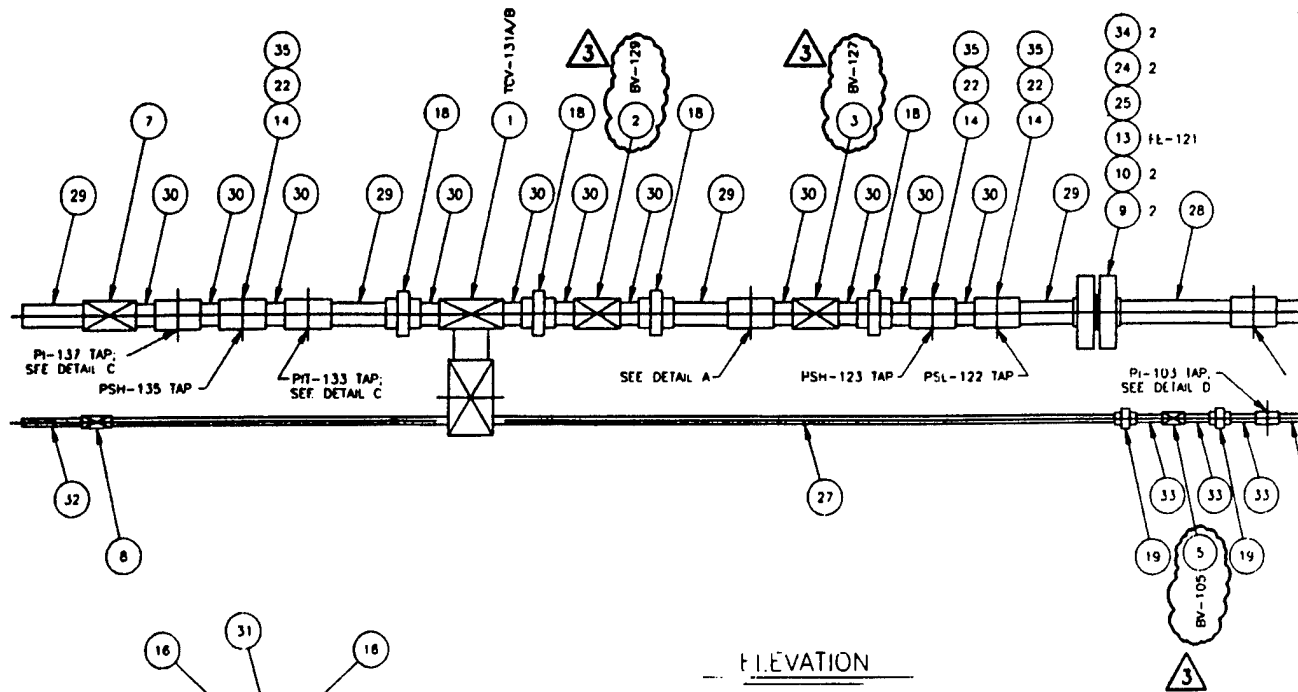


ELEVATION

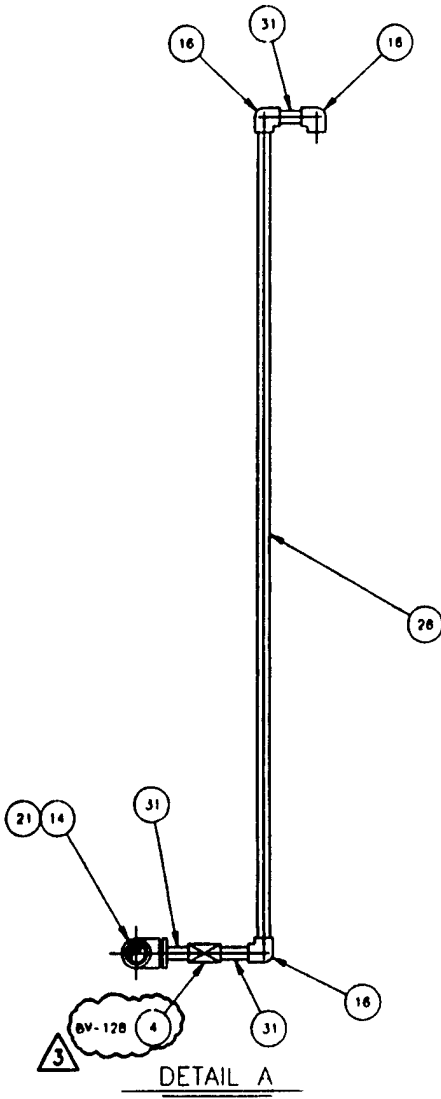

DETAIL A

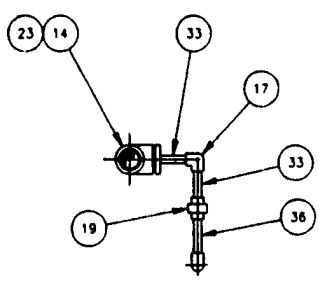

DETAIL B

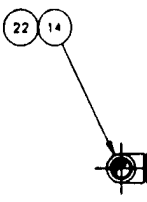

DETAIL C

TYPICAL


GENERAL NOTES

- 1 FINISH: ALL PIPE, NIPPLES AND PIPE FITTINGS SHALL BE PAINTED WITH GREY ENAMEL.
- 2 TWO (2) EACH OF IILMS 9, 10 & 24 ARE MOUNTED ON PREMIX AIR DUCT

REFERENCE DRAWINGS



NUMBER	TITLE
PID120	PIPING & INSTRUMENT DIAGRAM

1

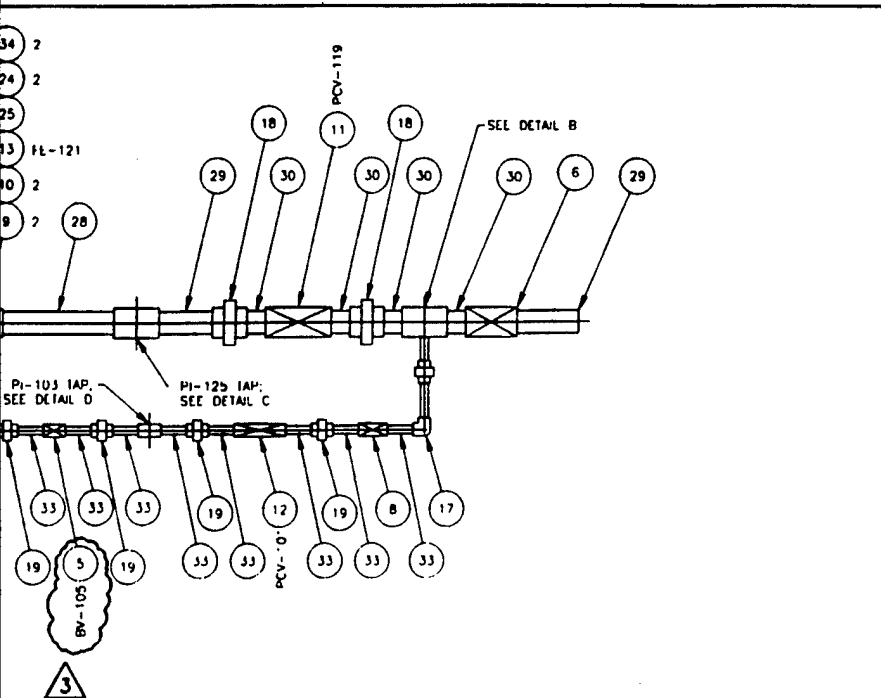

BILL OF MATERIAL

ITEM	QTY	DESCRIPTION
1	1	VALVES, CONTROL; MAXON M-4 x 1 1/2-P w/ CB & L
2	1	VALVE, SHUTOFF; MAXON 1 1/2-5100-HS w/ VCS-1 SW
3	1	VALVE, SHUTOFF; MAXON 1 1/2-5100-HS
4	1	VALVE, SOLENOID; ASCO EF8210C35, 3/4"
5	1	VALVE, SOLENOID; ASCO EF803068, 3/8"
6	1	VALVE, BALL; WORCESTER 1 1/2"-K411BSE
7	1	VALV, BALL; WORCESTER 1 1/2"-411BSE
8	2	VALVE, BALL; WORCESTER 3/8"-411BSE
9	6	VALVE, GAUGE; AGCO M5VDC-44
10	6	PLUG, BLEED; AGCO VAC-4
11	1	REGULATOR, PRFSSURF; MAXON 1 1/2" 234 B-1
12	1	REGULATOR, PRESSURE; MAXON 3/8" 043-180
13	1	PLATE, ORIFICE; SEE ArrTech SPECIFICATION 120-6
14	8	TEE, THD; 1 1/2" 2000#, CS1L
15	1	TEE, THD; 3/8" 2000#, CS1L
16	3	ELBOW, 90° THD; 3/4" 2000#, CS1L
17	2	ELBOW, 90° THD; 3/8" 2000#, CS1L
18	6	UNION, THD; 1 1/2" 2000#, CS1L
19	5	UNION, THD; 3/8" 2000#, CS1L
20	1	COUPLING, THD REDUCING; 1/2" x 3/8", CS1L
21	1	BUSHING, THD REDUCING; 1 1/2" x 3/4", CS1L
22	7	BUSHING, THD REDUCING; 1 1/2" x 1/2", CS1L
23	1	BUSHING, THD REDUCING; 1 1/2" x 3/8", CS1L
24	6	PLUG, PIPE, 1/2", CS1L
25	1	SET, ORIFICE FLANGE, 1 1/2" 300# RF THD, CS1L
26	1	PIPE, TBC, 3/4" STD WT x 5'-10" LG, CS1L
27	1	PIPE, TBC, 3/8" EXSTG x 7' 4" LG, CS1L
28	1	NIPPLE, TBE; 1 1/2" STD WT x 11 1/8", CS1L
29	6	NIPPLE, TBE; 1 1/2" STD WT x 6" LG, CS1L
30	15	NIPPLE, TBE; 1 1/2" STD WT x 3" LG, CS1L
31	3	NIPPLE, TBE; 3/4" STD WT x 3" LG, CS1L
32	1	NIPPLE, TBE; 5/8" EXSTG x 6" LG, CS1L
33	11	NIPPLE, TBC; 3/8" EXSTG x 3" LG, CS1L
34	2	GASKET, FLC; 1 1/2" 300# RING TYPE x 1/8", BUNA-N
35	7	FITTING, TUBE; 3/8" TUBE x 1/2" MNPT, BRASS
36	1	NIPPLE, TBE; 3/8" EXSTG x 3 5/8" LG, CS1L

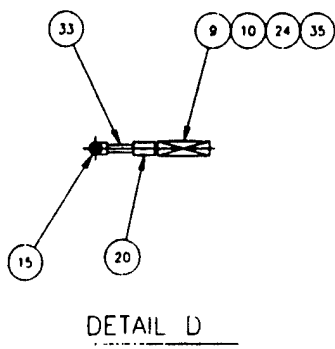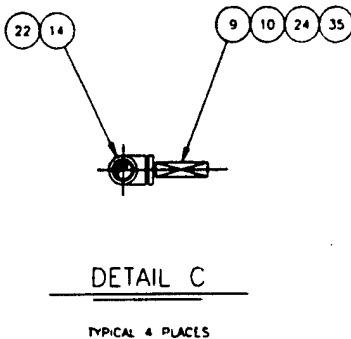

REVISIONS				ENGINEERING RECORD			
NO	DESCRIPTION	BY	DATE	CAD	DATE	SCALE	DATE
0	FOR CONSTRUCTION	JW	3-6-95			1 1/2" x 1'-0"	
1	REVISED AIR & PILQI PIPE LOCATION	JW	4-2-95				
2	RECORD	JW	7-4-95				
3	FIELD MODIFICATIONS	CAF	8/1/95				

Arrtech ENVIRONMENTAL SYSTEMS


PREPARED FOR
ROY F. WESTON, INC.

CLIENT JOB


FUEL TRAIN ASSEMBLY AFTERBURNER

APPROVED: [Signature] DWG. #: **FTA120-2** REVISION 3

2

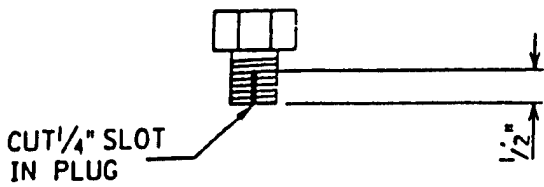

COUPLING PLUG

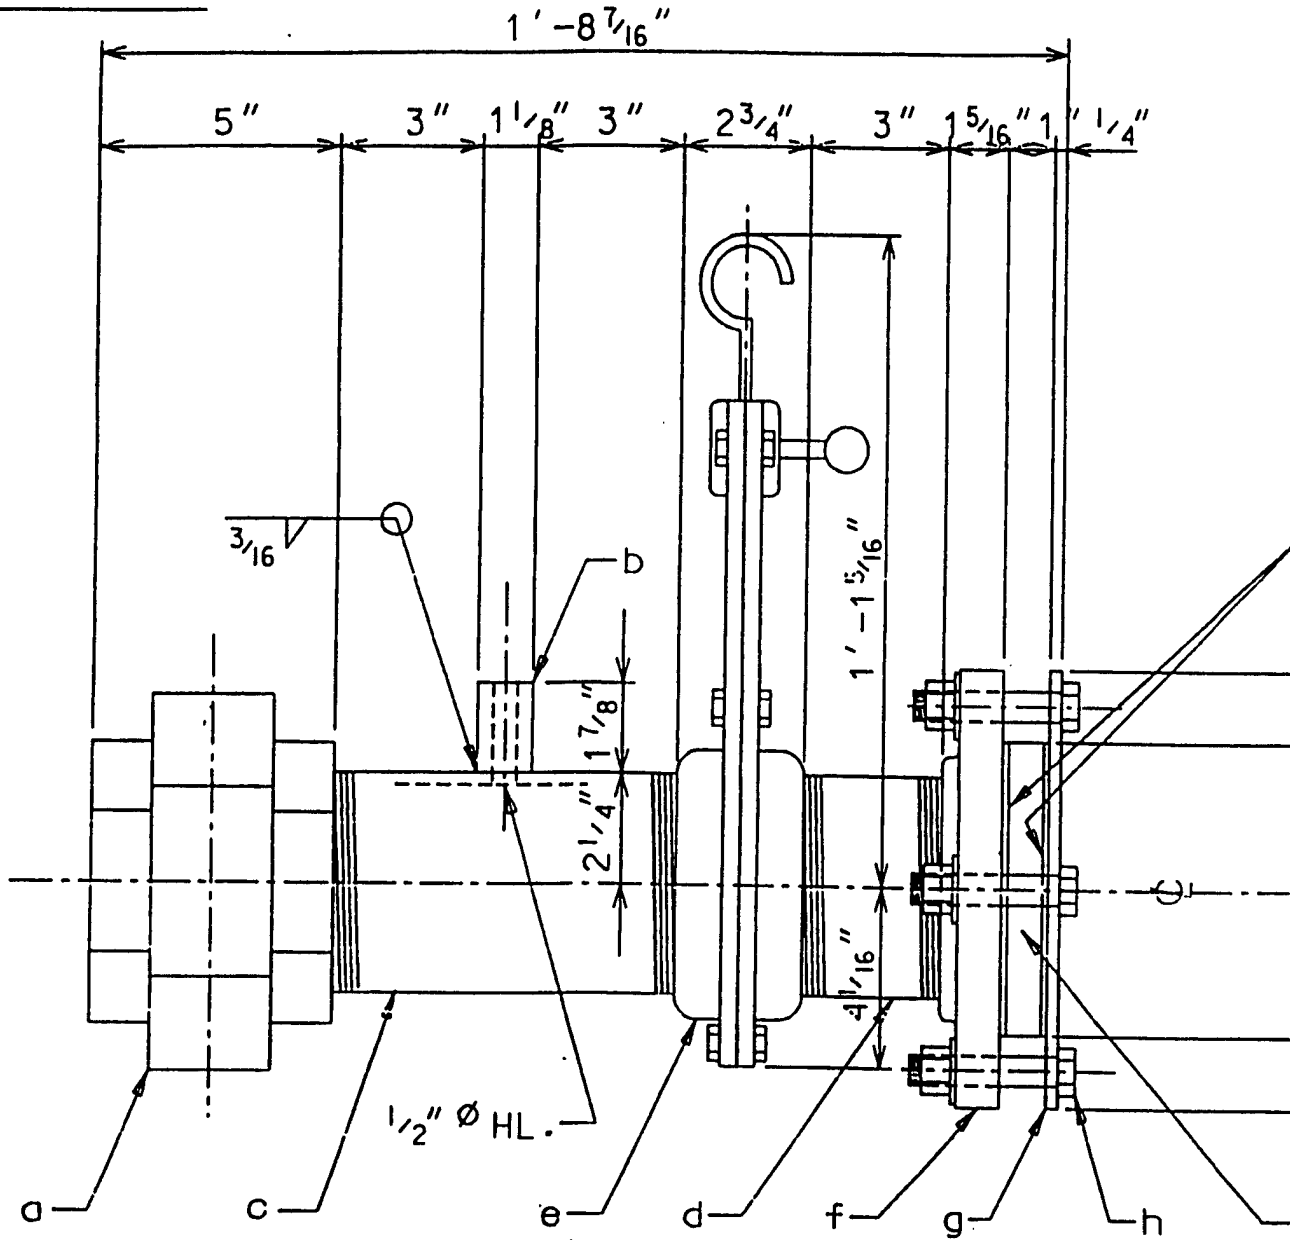

REV	DATE	BY	CKD	REVISION	REV	DATE	BY	CKD	REVISION
6					3				
5					2				
4					1				




①

BILL OF MATERIAL

MK.	QTY.	DESCRIPTION	LENGTH		MAT'L.	C.S. WT.	S.S. WT.
			FT	IN			
a	1	4" \varnothing 3000# THREADED PIPE UNION			A105	30	
b	1	1/2" \varnothing 3000# THREADED PIPE CPLG $\frac{1}{2}$ PLUG			A105	1	
c	1	4" \varnothing SCH40 PIPE (T.B.E.)	0	9 $\frac{3}{8}$	A106	8	
d	1	4" \varnothing SCH40 PIPE (T.B.E.)	0	5 $\frac{1}{4}$	A106	5	
e	1	4" MOSSER TYPE GT SLIDE VALVE					
f	1	4" \varnothing 150# R.F. THREADED FLANGE			A105	13	
g	1	R 1/4" x 4" I.D. x 9" O.D.			A36	4	
h	4	5/8" \varnothing H.S.B. $\frac{1}{2}$ NUT & WASH.	0	2 $\frac{1}{4}$	A325	1	
k	1	3/4" THK. x 6" \varnothing PYREX GLASS, P/N 692540					
m	2	1/8" THK. x 4" I.D. x 6" O.D.					
		COMPRESS. GASKET (KLINGER #C-4401)					

C.S. WT. 62

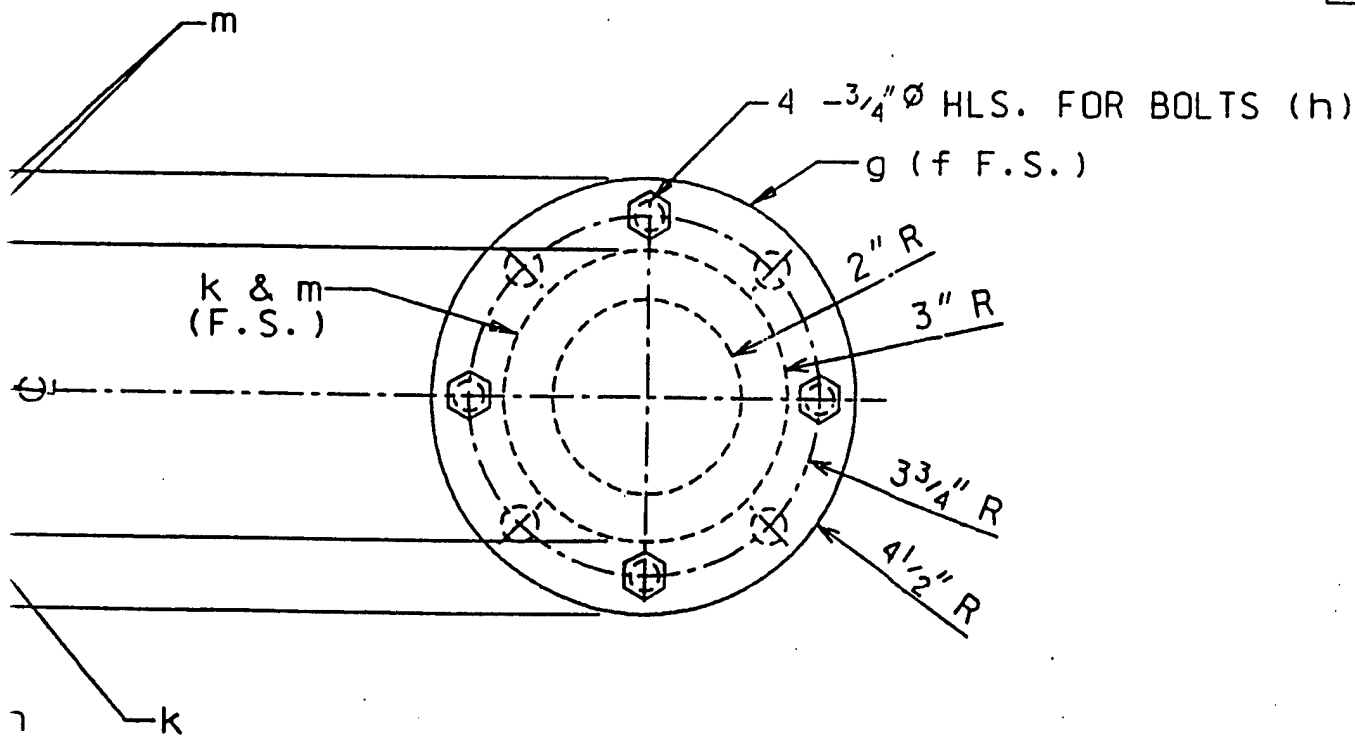

SIGHT PORT w/ VALVE - 4" \varnothing

DRAWN: OU	DATE: 1/10/95	JOB: STANDARD
CHECKED: JLB	DATE: 1/11/95	DWG NO: AES-5-53
CERTIFIED:	DATE: / /	REVISION: ① - As Built CPL 1/11/95

Arrlech

6506 S. Lewis, Suite, 230
Tulsa, OK 74136

ENVIRONMENTAL SYSTEMS, INCORPORATED



THERMAL OXIDIZER EQUIPMENT (CO

<u>DRAWING NO.:</u>	<u>REV. NO.:</u>	<u>DRAWING DATE</u>	<u>DRAWING DESCRIPTION</u>
ES120-1	3	8/1/96	ELECTRICAL SCHEMATIC
ES120-2	3	8/1/96	ELECTRICAL SCHEMATIC
ES120-3	3	8/1/96	ELECTRICAL SCHEMATIC
ES120-4	3	8/1/96	ELECTRICAL SCHEMATIC
ES120-5	3	8/1/96	ELECTRICAL SCHEMATIC
LCP120-1	2	8/1/96	LOCAL CONTROL PANEL
LCP120-2	3	8/1/96	LOCAL CONTROL PANEL
LCP120-3	2	8/1/96	LOCAL CONTROL PANEL
IC120-1	3	8/1/96	INTERCONNECTION DIA
IC120-2	3	8/1/96	INTERCONNECTION DIA
IC120-3	3	8/1/96	INTERCONNECTION DIA
PID120	4	8/1/96	PROCESS & INSTRUMENT
RCP120-1	3	8/1/96	REMOTE CONTROL PANI
RCP120-2	3	8/1/96	REMOTE CONTROL PANI

①

THERMAL OXIDIZER EQUIPMENT

(continued)

EQUIPMENT (CONTINUED)

DRAWING DESCRIPTION


ELECTRICAL SCHEMATIC - AFTERBURNER
ELECTRICAL SCHEMATIC - AFTERBURNER
LOCAL CONTROL PANEL ASSEMBLY - AFTERBURNER
LOCAL CONTROL PANEL ASSEMBLY - AFTERBURNER
LOCAL CONTROL PANEL ASSEMBLY - AFTERBURNER
INTERCONNECTION DIAGRAM - AFTERBURNER
INTERCONNECTION DIAGRAM - AFTERBURNER
INTERCONNECTION DIAGRAM - AFTERBURNER
PROCESS & INSTRUMENTATION DIAGRAM - AFTERBURNER

REMOTE CONTROL PANEL ASSEMBLY - AFTERBURNER
REMOTE CONTROL PANEL ASSEMBLY - AFTERBURNER

2

480V, 3 PH, 60 HZ POWER
BY OTHERS

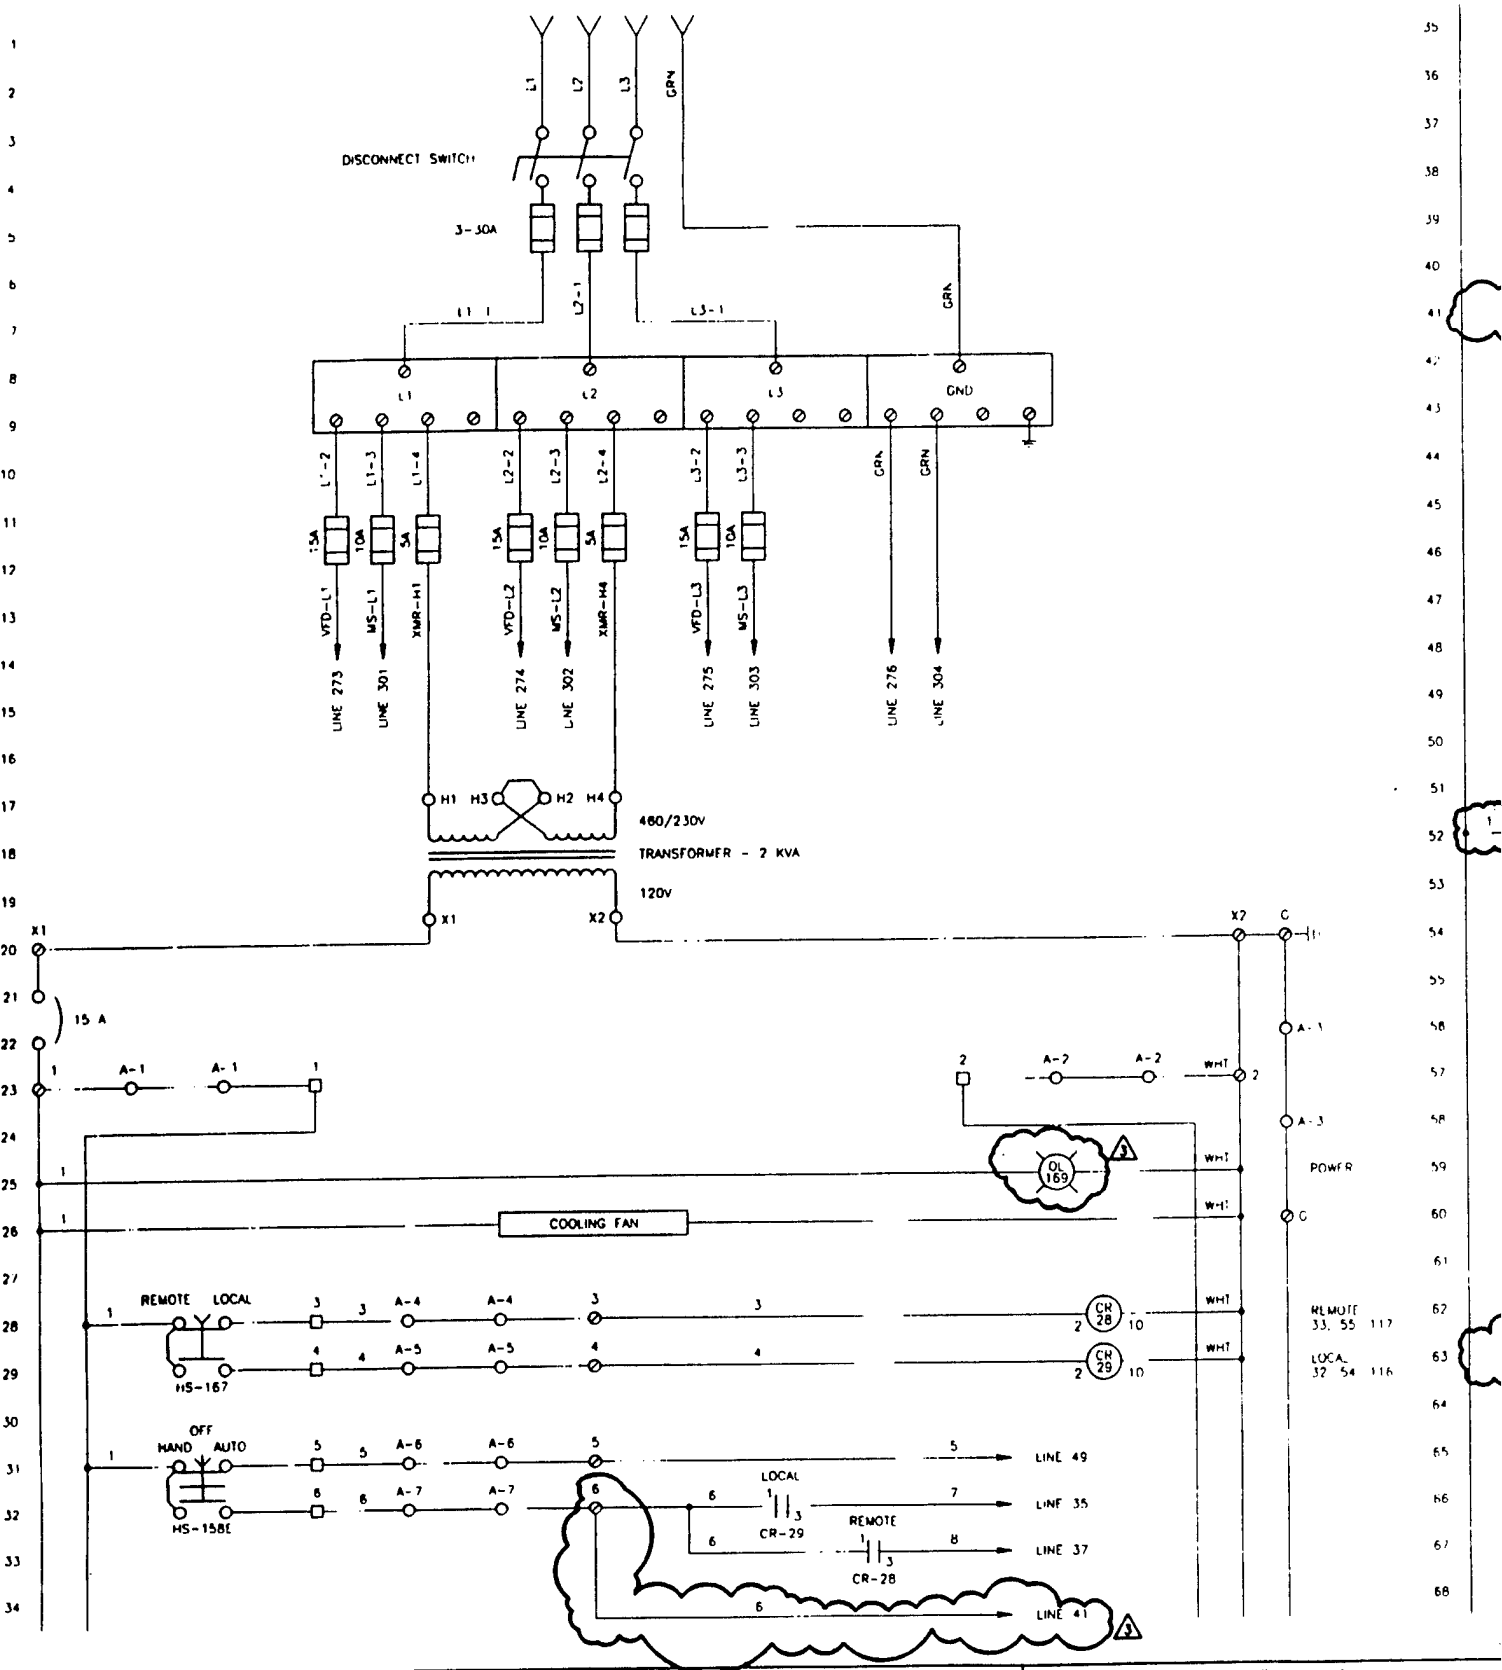

GENERAL NOTES


1 SEE LEGEND ON DWG ES120-5

REFERENCE DRAWINGS

NUMBER	TITLE
PID120	PIPING & INSTRUMENT DIAGRAM
IC120	INTERCONNECTION DIAGRAM
LCP120	LOCAL CONTROL PANEL ASSEMBLY
RCP120	REMOTE CONTROL PANEL ASSEMBLY
FTA120	FUEL TRASN ASSEMBLY

PLOTTED 08/02/96
PLT. SC. 1=1

(1)

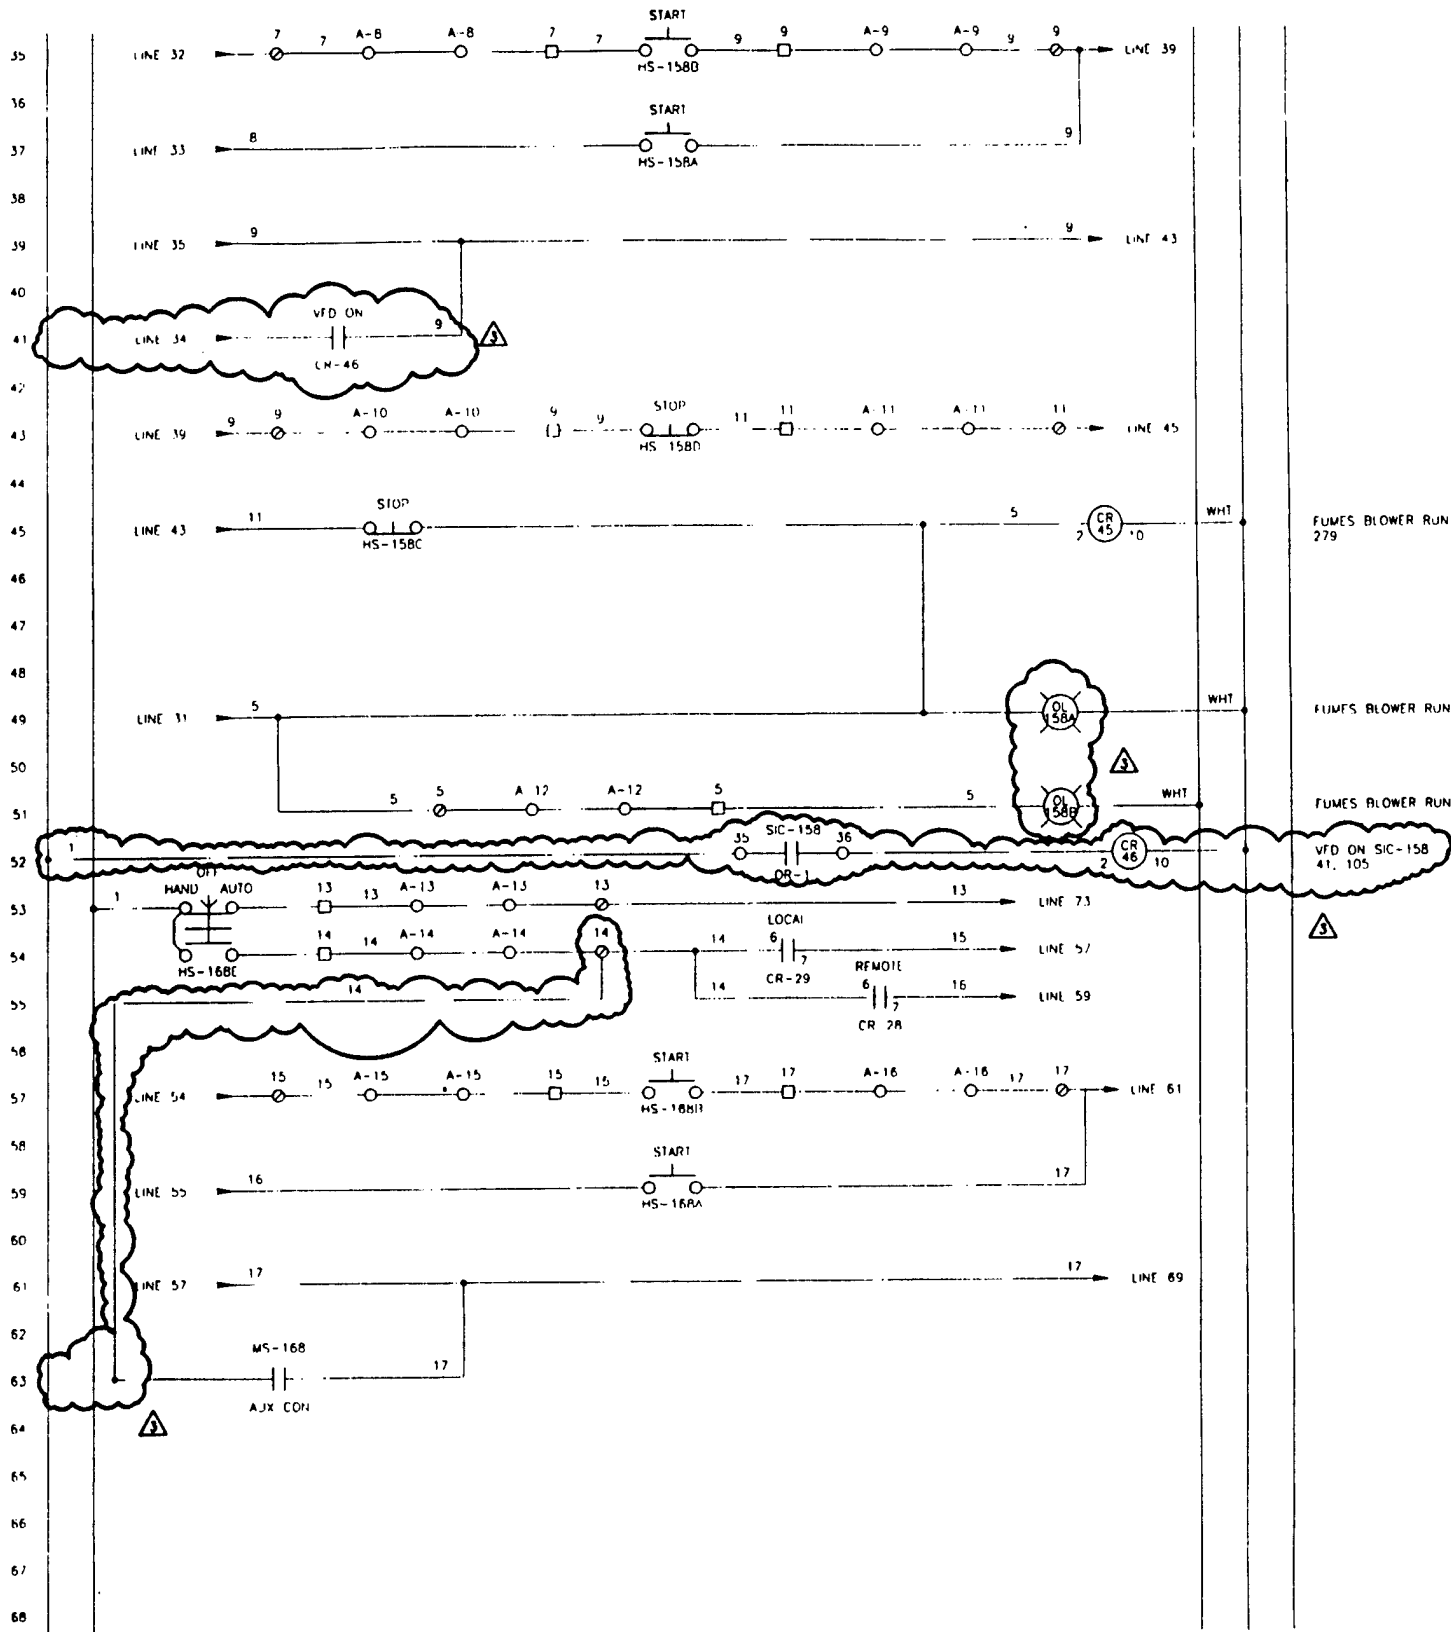


CONTINUED ON DWG ES120-2

REVISIONS				ENGINEERING RECORD			
NO	DESCRIPTION	BY	DATE	SCALE	DATE	DATE	DATE
0	FOR CONSTRUCTION	JW	3-4-95				
1	REVISED LINES 28 & 29	JW	4-28-95	JW	9-28-94		
2	RECORD	JW	7-5-95				
3	FIELD MODIFICATIONS	04p	8/1/96				

		PREPARED FOR ROY F. WESTON, INC.
APPROVED		CLIENT JOB
ELECTRICAL SCHEMATIC AFTERBURNER		DWG. #: ES120-1 REVISION 3

2

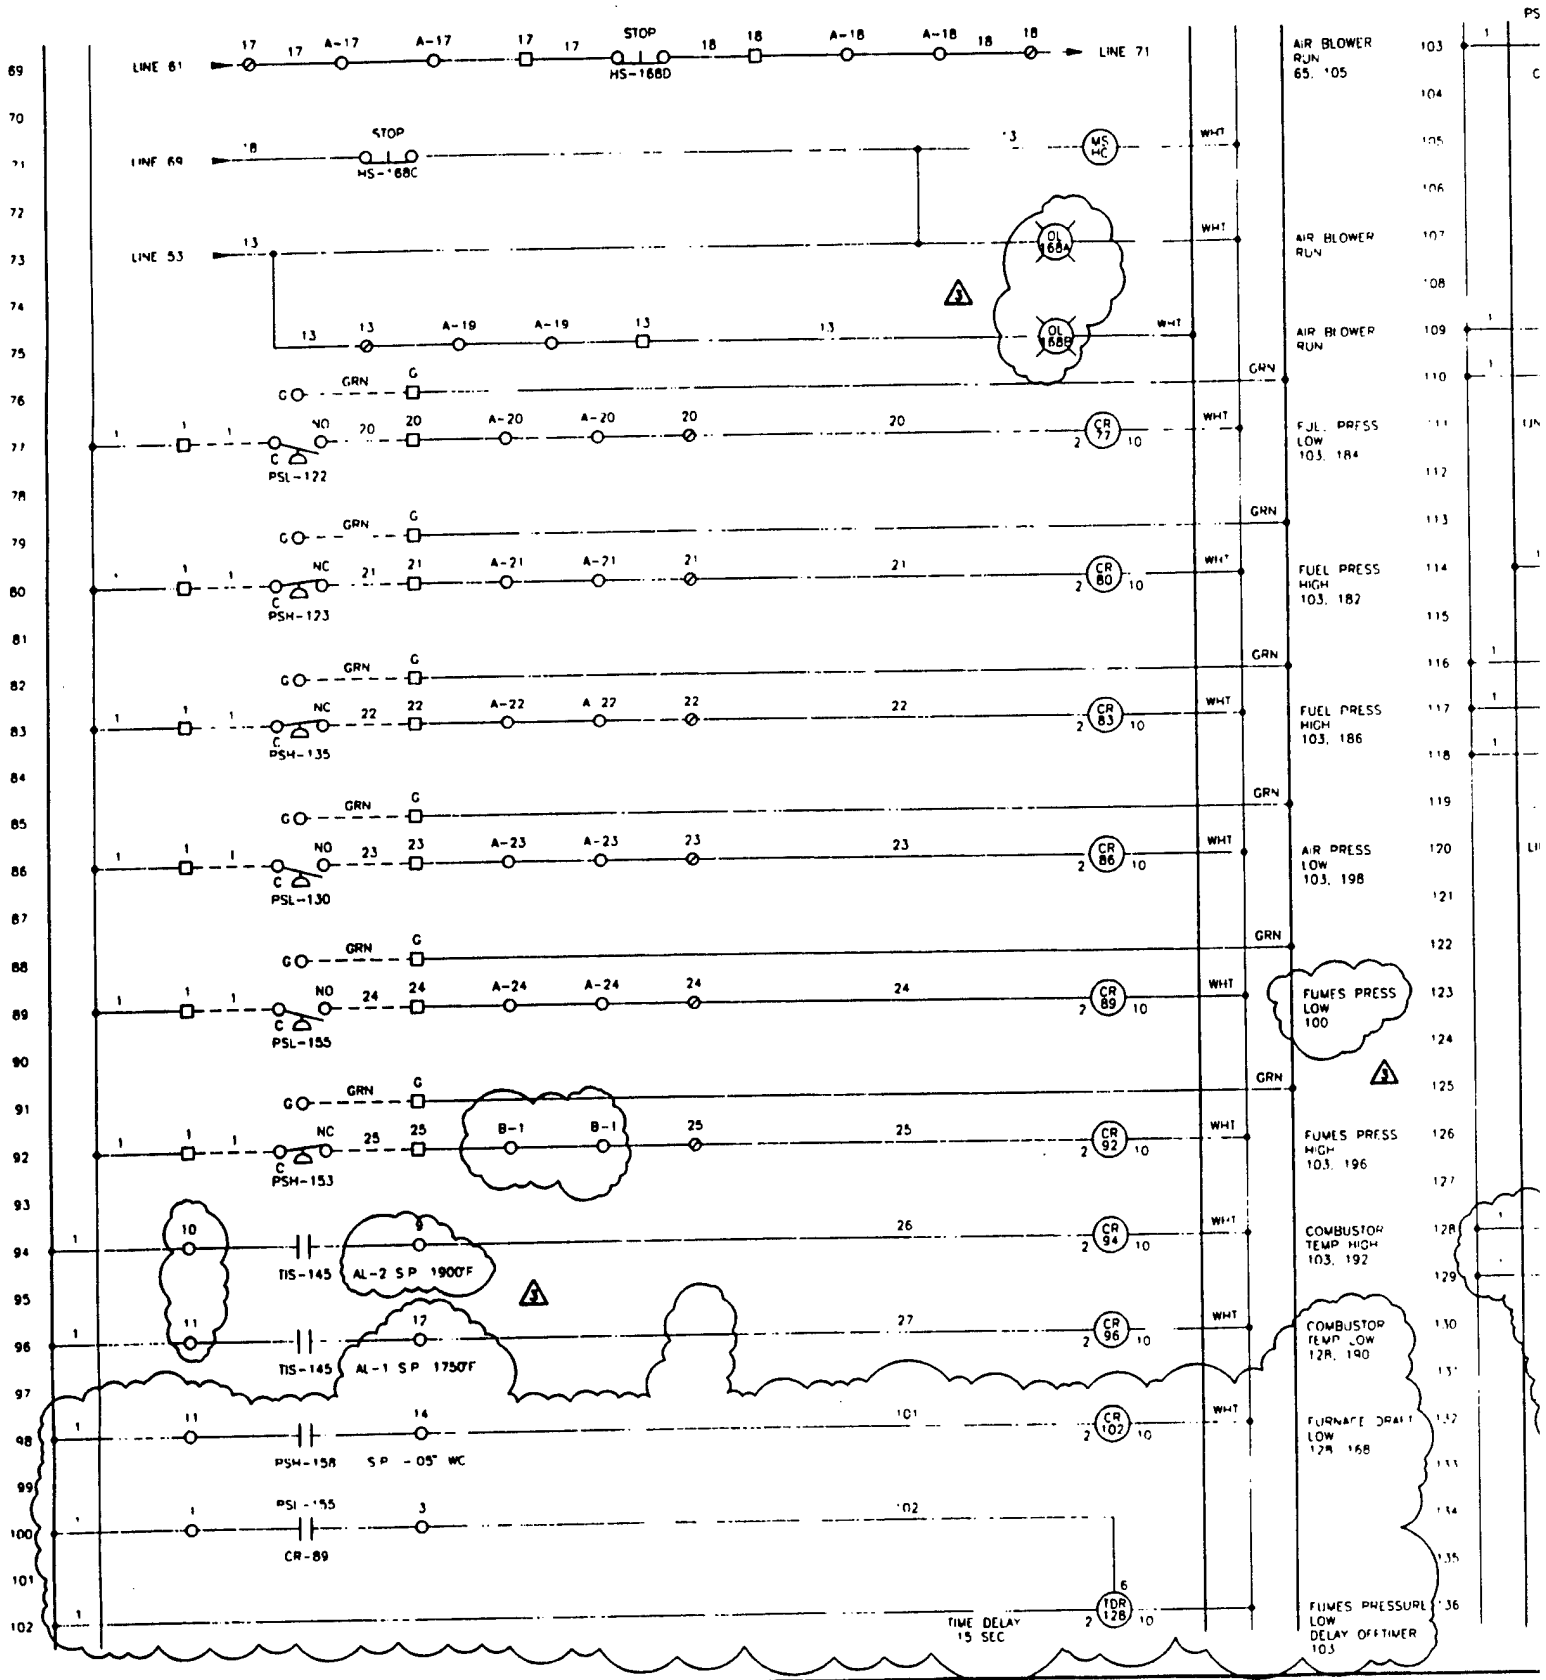


GENERAL NOTES

SEE LEGEND ON DWG ES120-5

REFERENCE DRAWINGS

NUMBER	TITLE
PID120	PIPING & INSTRUMENT DIAGRAM
IC120	INTERCONNECTION DIAGRAM
LCP120	LOCAL CONTROL PANEL ASSEMBLY
RCP120	REMOTE CONTROL PANEL ASSEMBLY
FTA120	FUEL TRAIN ASSEMBLY



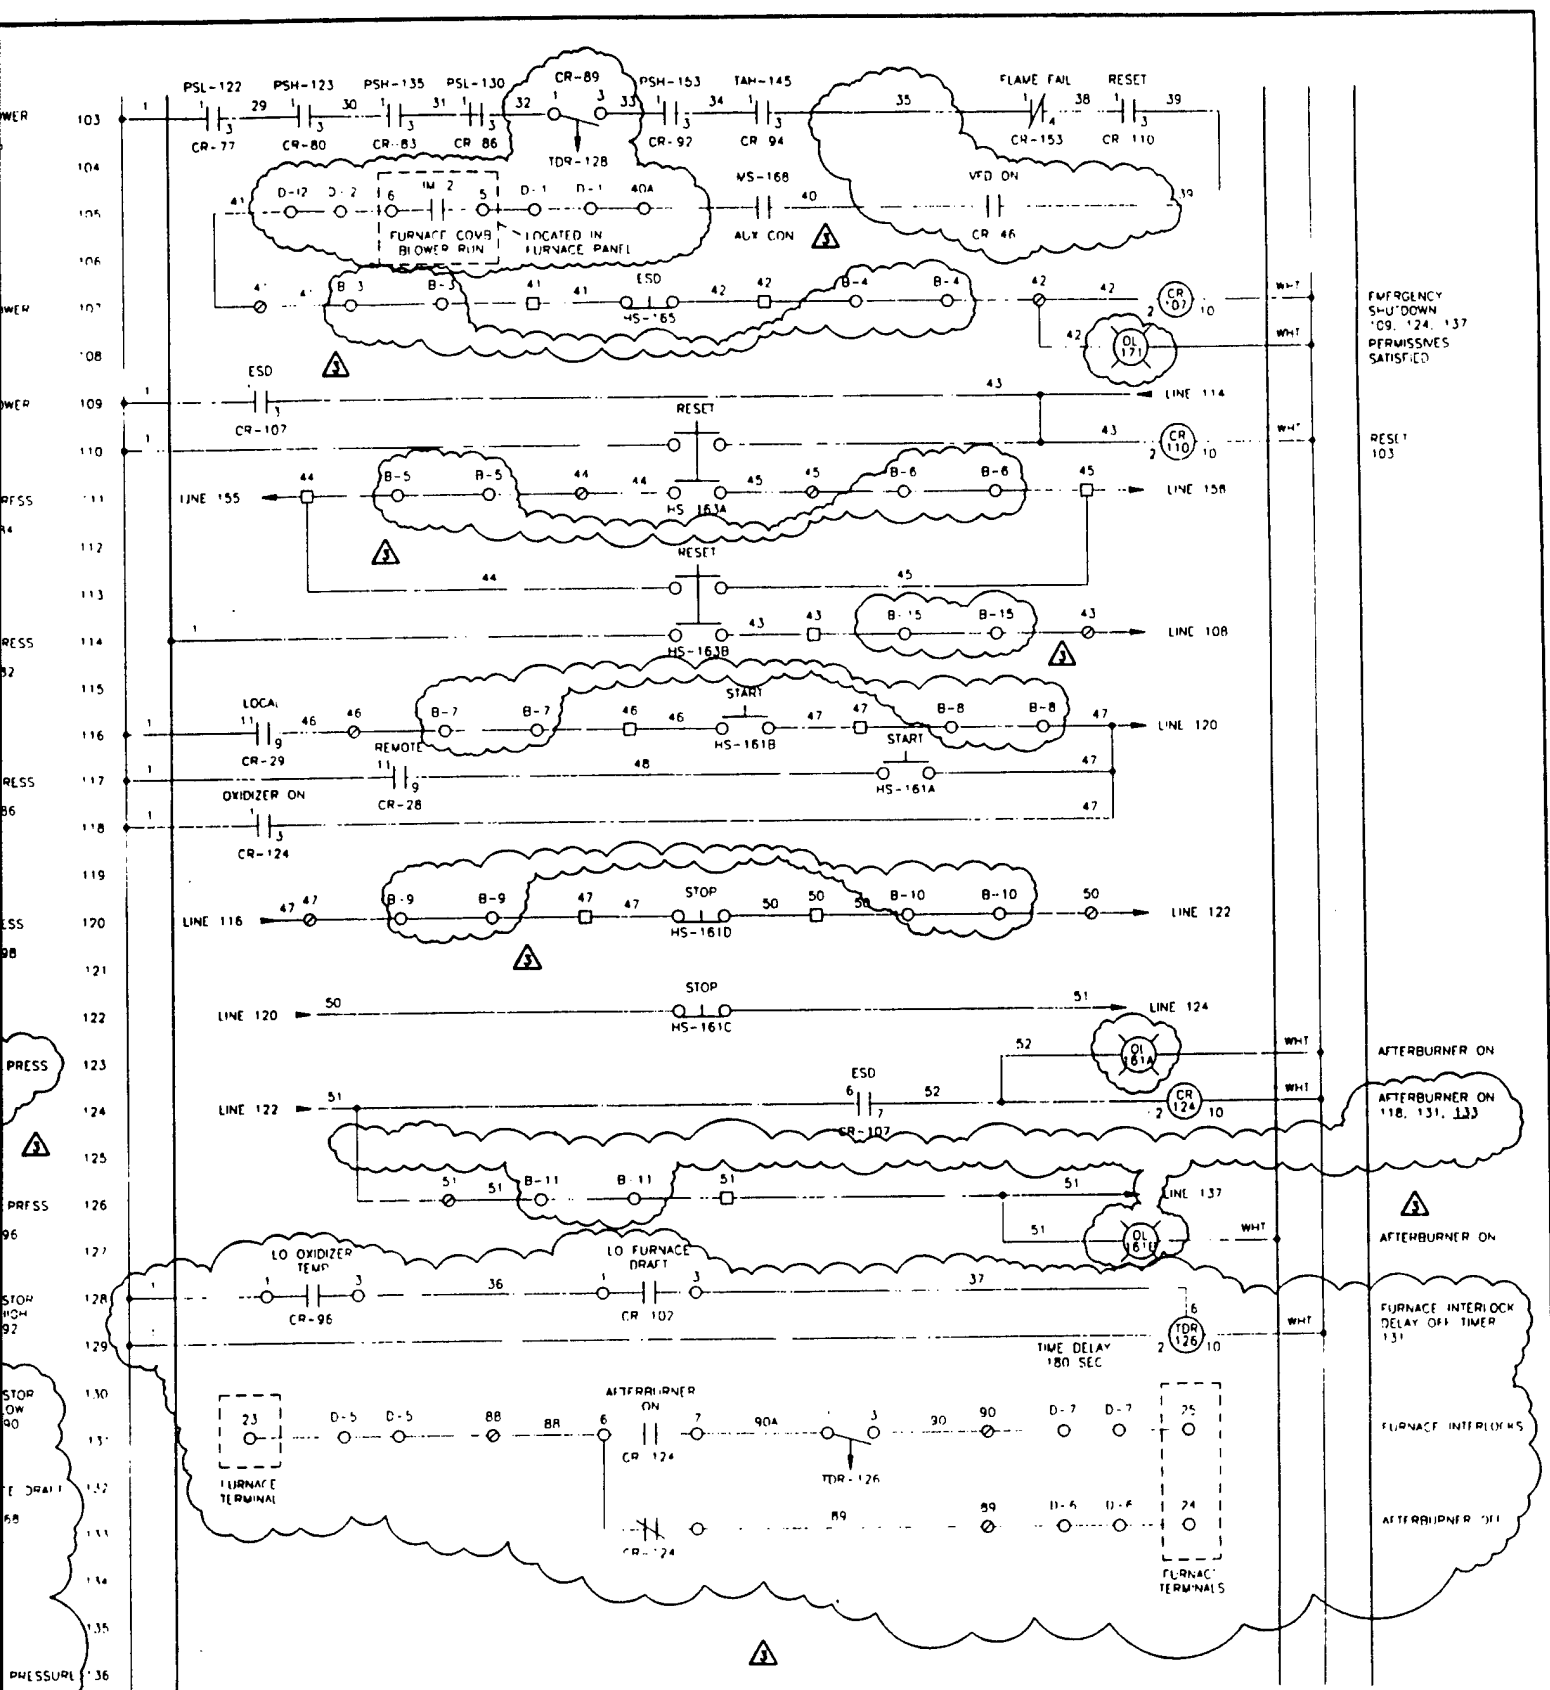

EMERGENCY
SHUT-DOWN
CR. 124, 137
PERMISSIVES
SATISFIED

RESET
103

AFTERBURNER ON
AFTERBURNER ON
118, 131, 133

AFTERBURNER ON

FURNACE INTERLOCK
DELAY OFF TIMER
131

FURNACE INTERLOCKS

AFTERBURNER OFF

CONTINUED ON DWG ES120-3

REVISIONS				ENGINEERING RECORD			
NO	DESCRIPTION	BY	DATE	CHKD	DATE	SCALE	NONE
0	FOR CONSTRUCTION	JW	3-4-95				
1	ADDED HS-163B	JW	4-28-95				
2	RECORD	JW	7-4-95				
3	FIELD MODIFICATIONS	WESTON	8-1-96	CP	8/2/96		




PREPARED FOR
ROY F. WESTON, INC.

ELECTRICAL SCHEMATIC AFTERBURNER

APPROVED _____ DWG. #: ES120-2 REVISION 3

2

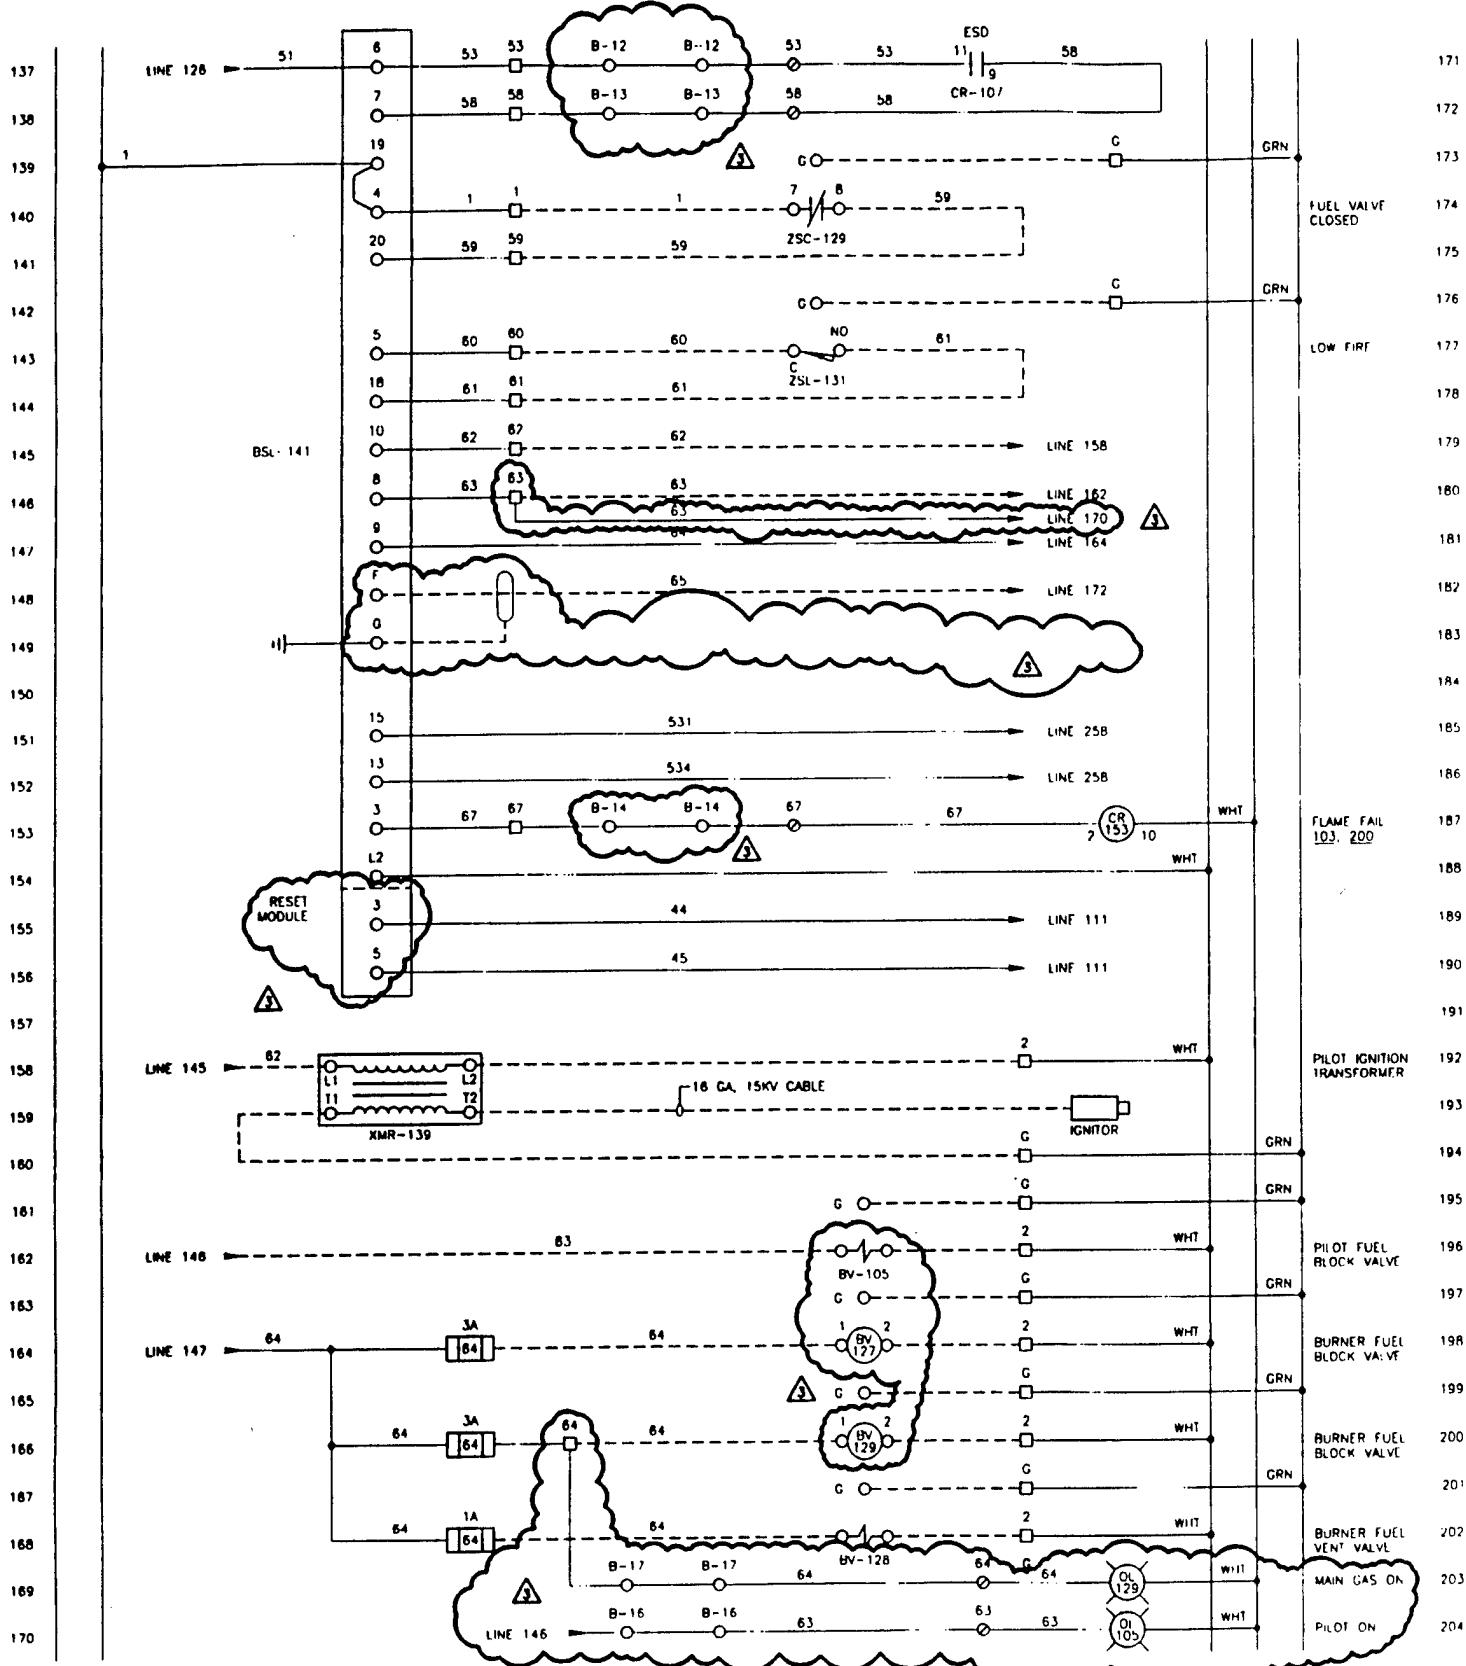

137
138
139
GENERAL NOTES


1 SEE LEGEND ON DWG ES120-5

REFERENCE DRAWINGS

NUMBER	TITLE
PID120	PIPING & INSTRUMENT DIAGRAM
IC120	INTERCONNECTING DIAGRAM
LCP120	LOCAL CONTROL PANEL ASSEMBLY
RCP120	REMOTE CONTROL PANEL ASSEMBLY
11A120	FUEL TRAIN ASSEMBLY


PLOTTED 08/02/96
 P.L.T. SC. 1-1

①

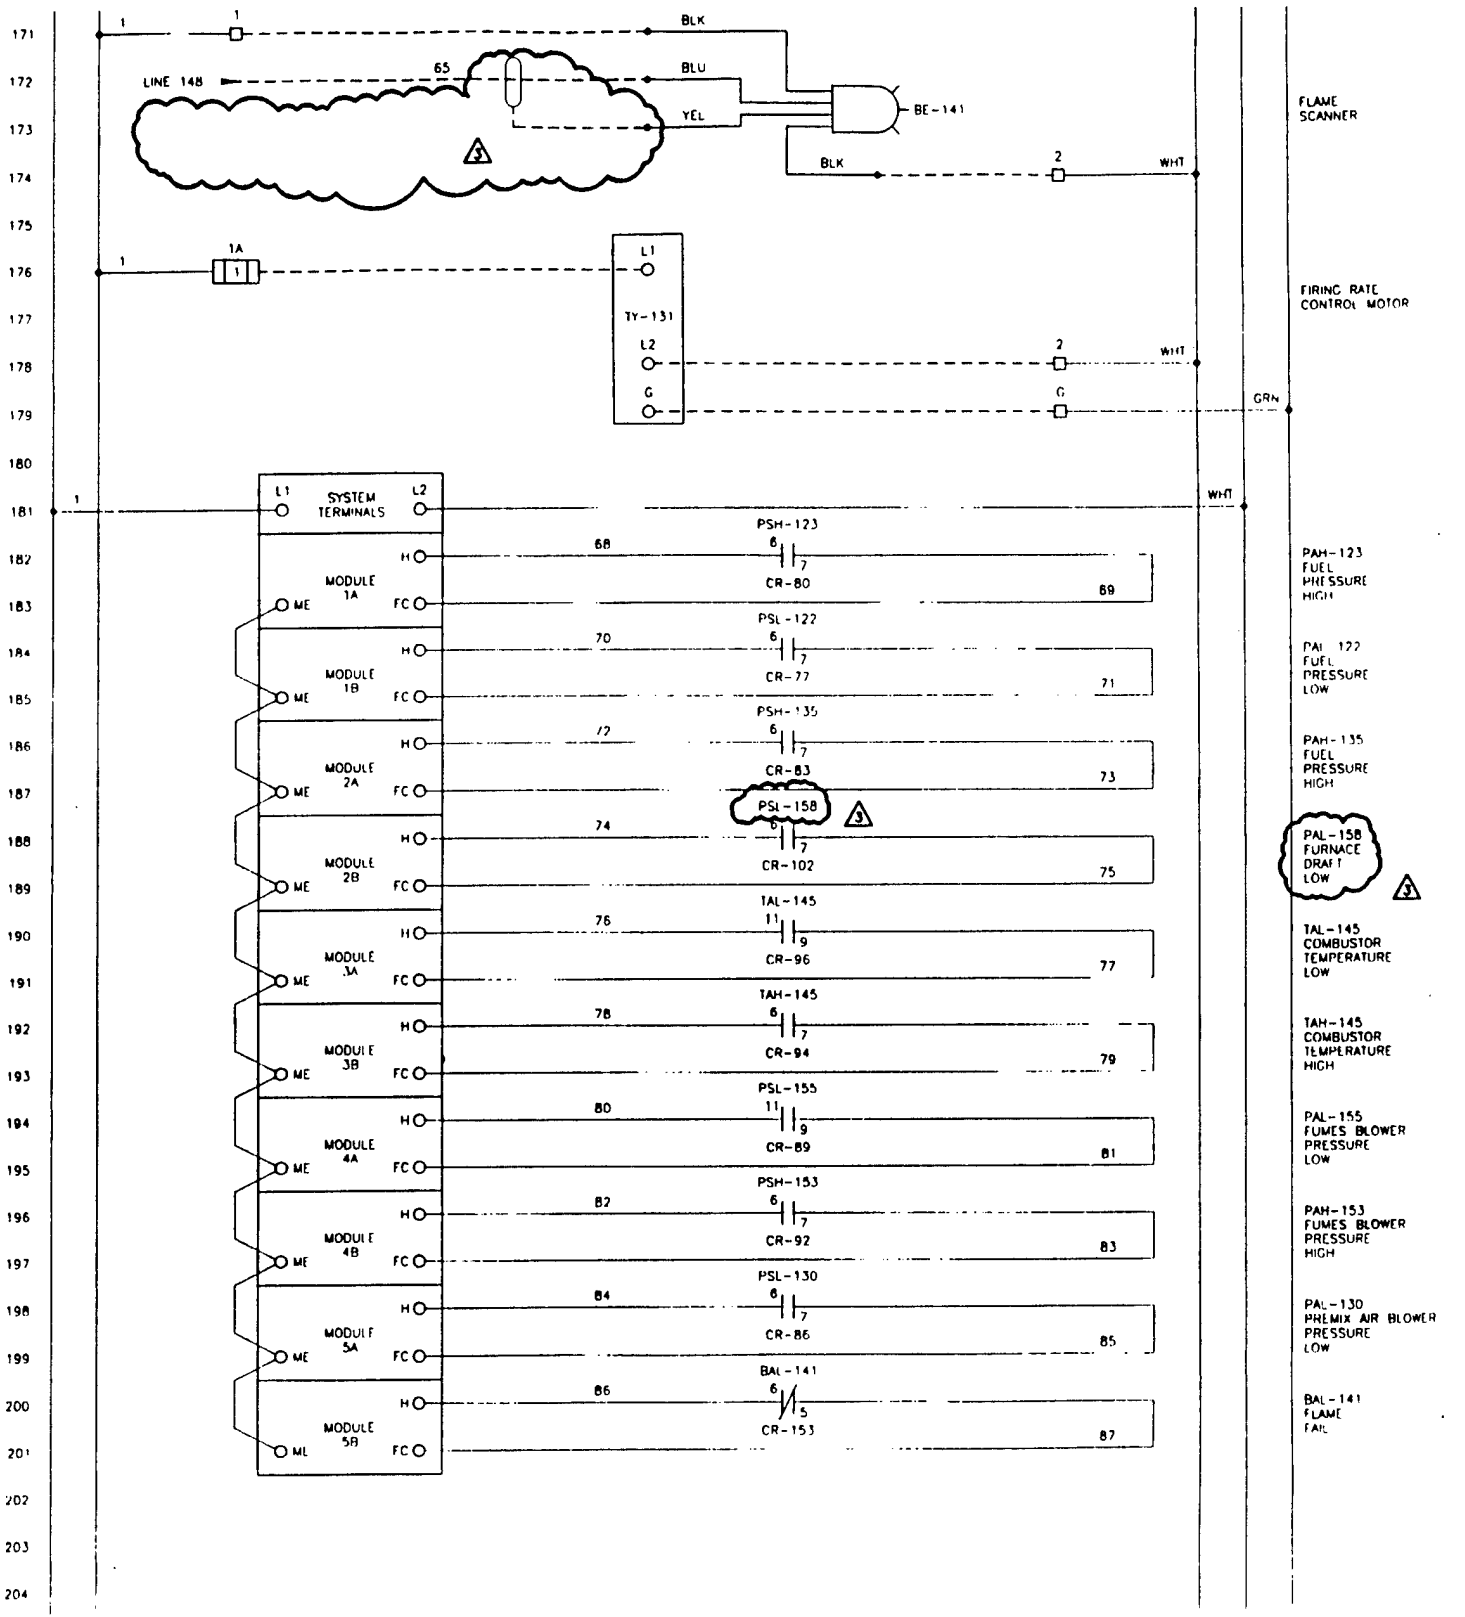

CONTINUED ON DWG ES120-4

REVISIONS					ENGINEERING RECORD				
NO	DESCRIPTION	BY	DATE	CHK	DATE	SCALE	NO	DATE	DATE
0	FRP CONSTRUCTION	JW	1-6-95				JW	12-31-94	
1	REVISED LINES 125 & 156	JW	4-8-95						
2	RECORDS	JW	7-6-95						
3	FIELD MODIFICATIONS	SWP	8/1/96						

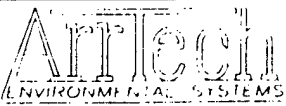


PREPARED FOR
ROY F WESTON, INC

CLIENT JOB

ELECTRICAL SCHEMATIC AFTERBURNER

APPROVED

DWG. #: ES120-3 REVISION 3

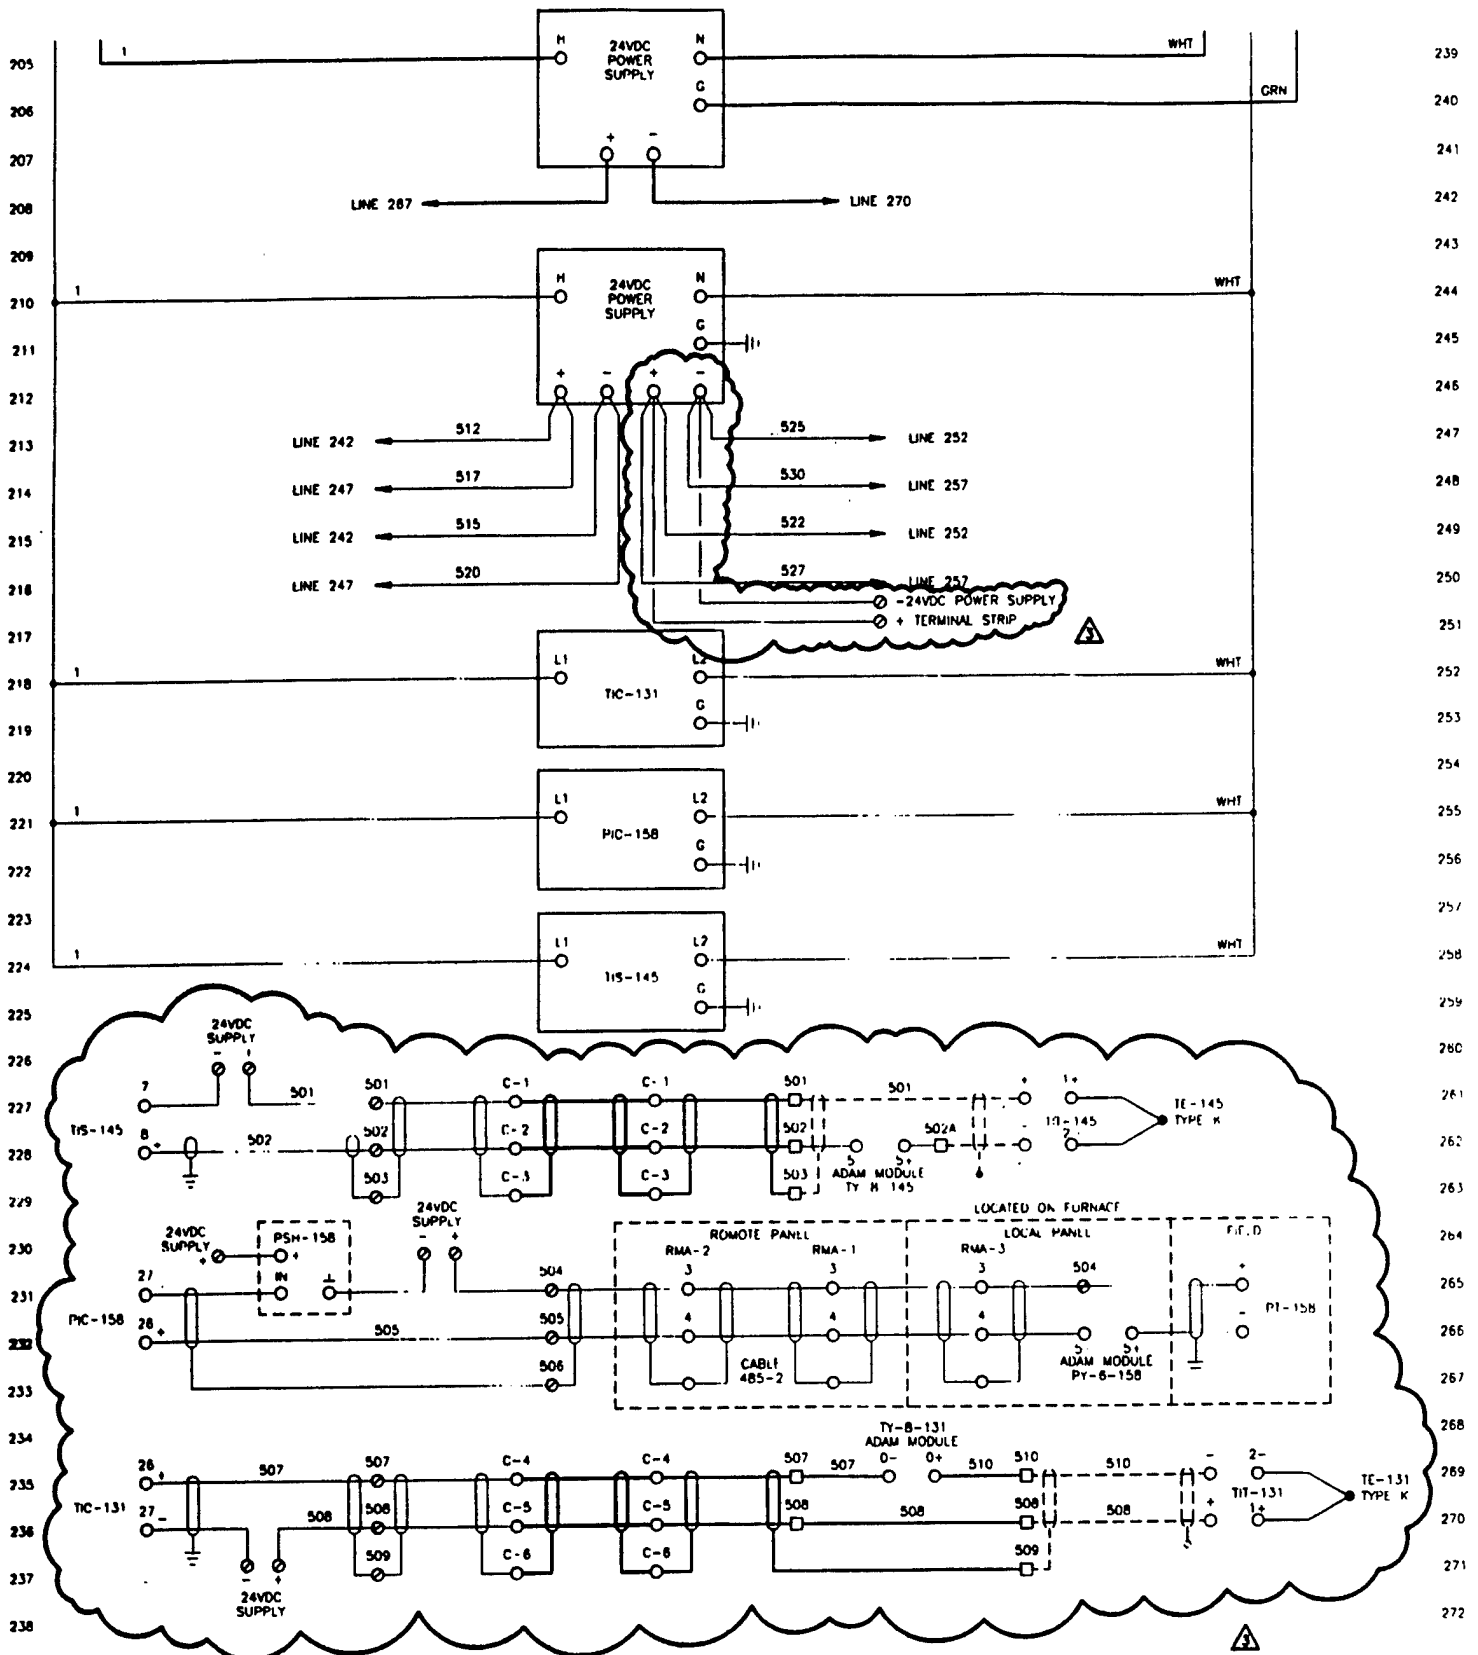


GENERAL NOTES

1 SEE LEGEND ON DWG ES120-5

REFERENCE DRAWINGS

NUMBER	TITLE
PID120	PIPING & INSTRUMENT DIAGRAM
IC120	INTERCONNECTION DIAGRAM
LCP120	LOCAL CONTROL PANEL ASSEMBLY
RCP120	REMOTE CONTROL PANEL ASSEMBLY
FTA120	FUEL TRAIN ASSEMBLY

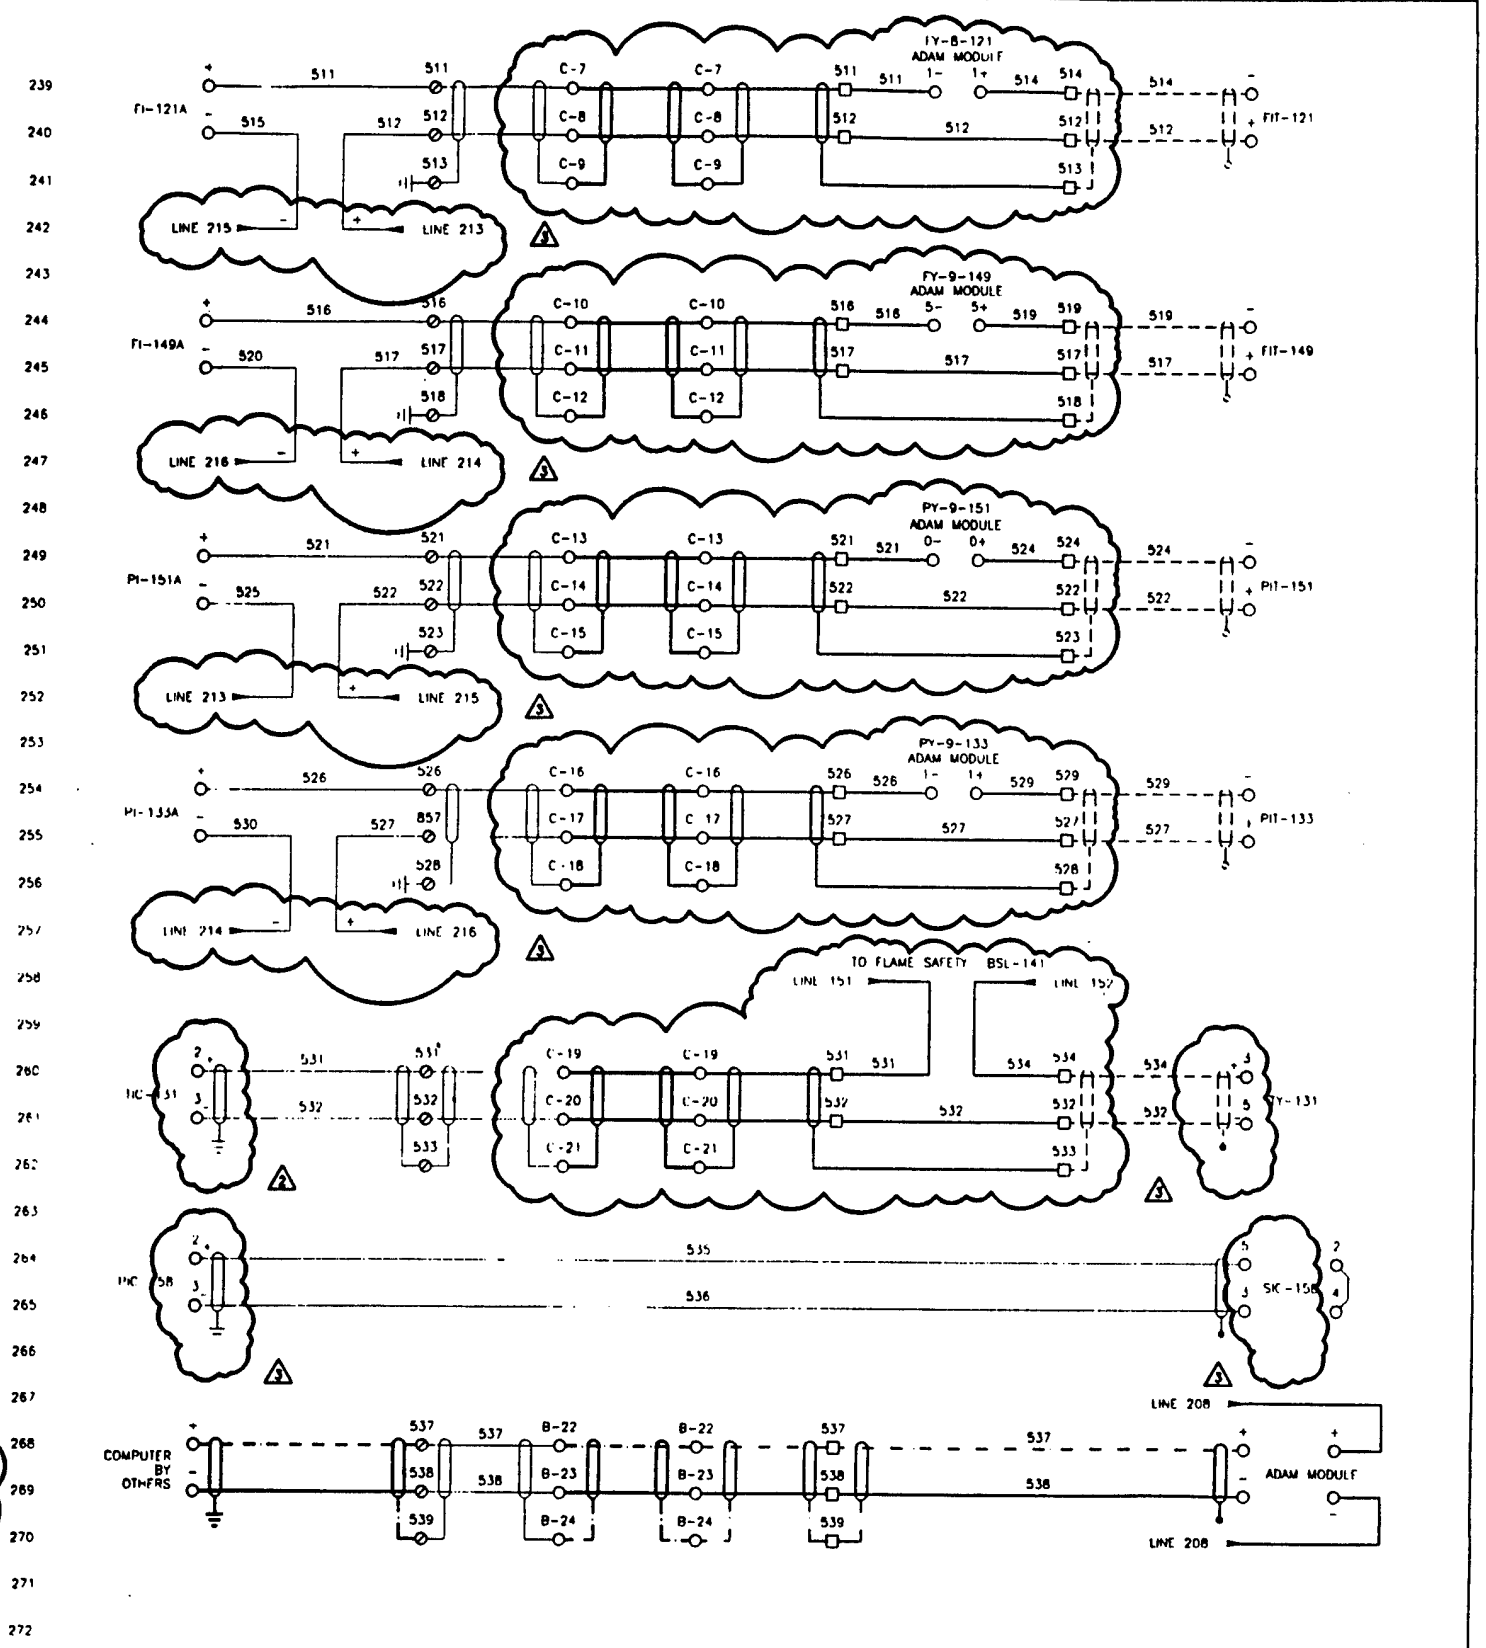

CONTINUED ON DWG ES120-5


REVISIONS				ENGINEERING RECORD			
NO	DESCRIPTION	BY	DATE	CHK	DATE	SCALE	NOTE
0	FOR CONSTRUCTION	JW	3-1-95				
1	REVISED ES120-1, 2, 3 & 5	JW	4-8-95				
2	RECORD	JW	7-4-95				
3	FIELD MODIFICATIONS	CLP	8/1/96				



PREPARED FOR
ROY F. WESTON, INC.

ELECTRICAL SCHEMATIC AFTERBURNER

APPROVED: _____ DWG. #: ES120-4 REVISION 3

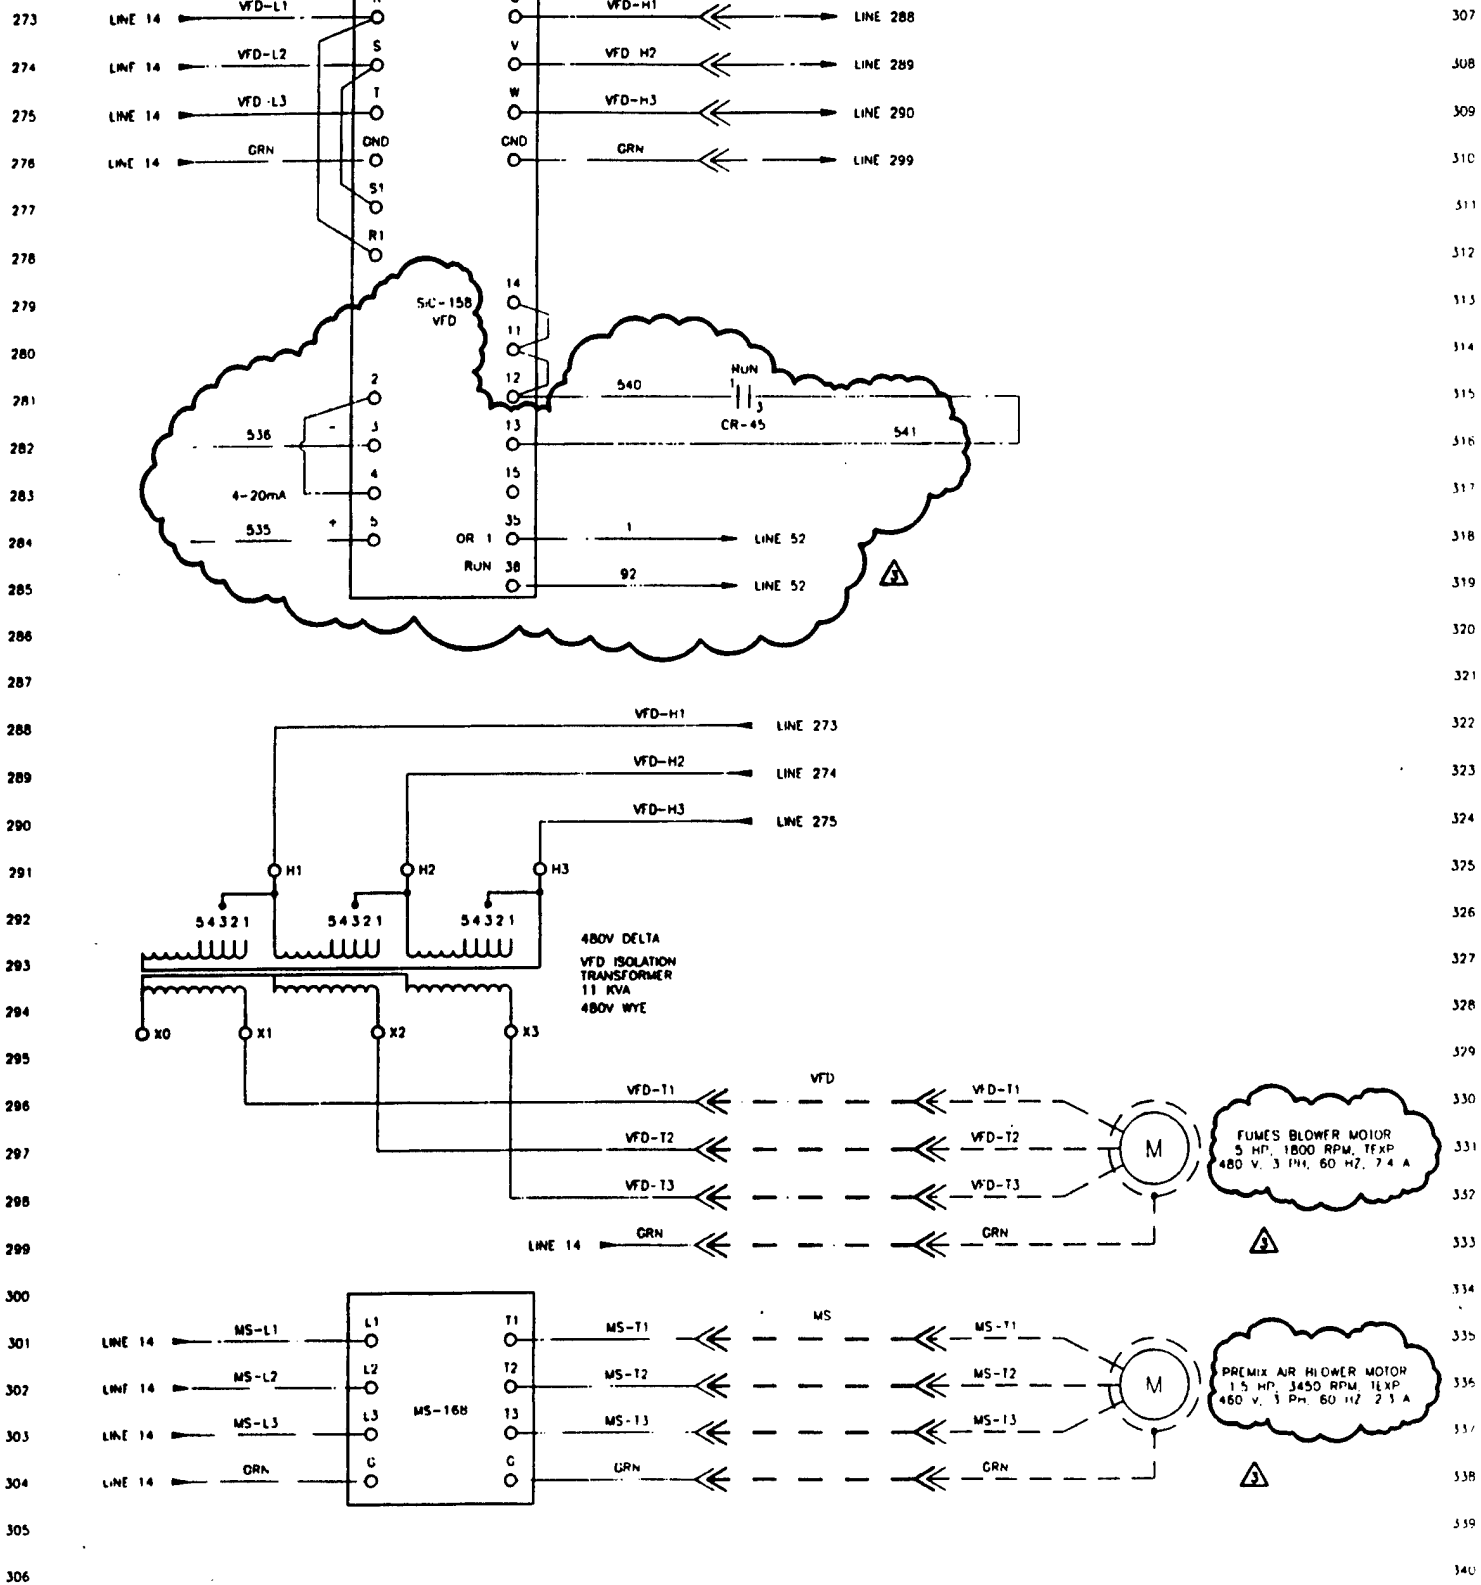

LAST WIRE USED 120VAC 90. 24VDC - 541

GENERAL NOTES



REFERENCE DRAWINGS

NUMBER	TITLE
PI0120	PIPING & INSTRUMENT DIAGRAM
IC120	INTERCONNECTION DIAGRAM
LCP120	LOCAL CONTROL PANEL ASSEMBLY
RCP120	REMOTE CONTROL PANEL ASSEMBLY
FTA120	FUEL TRAIN ASSEMBLY




PLOTTED 06/07/96 4:47 PM
PLT. SC. 1x1



307
308
309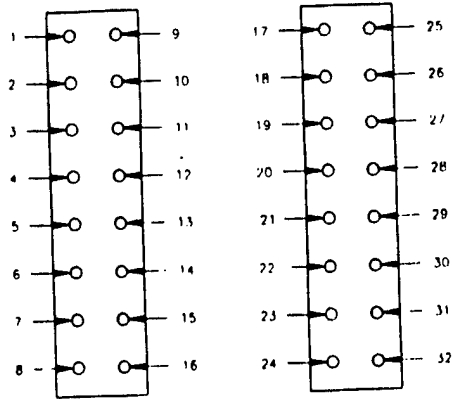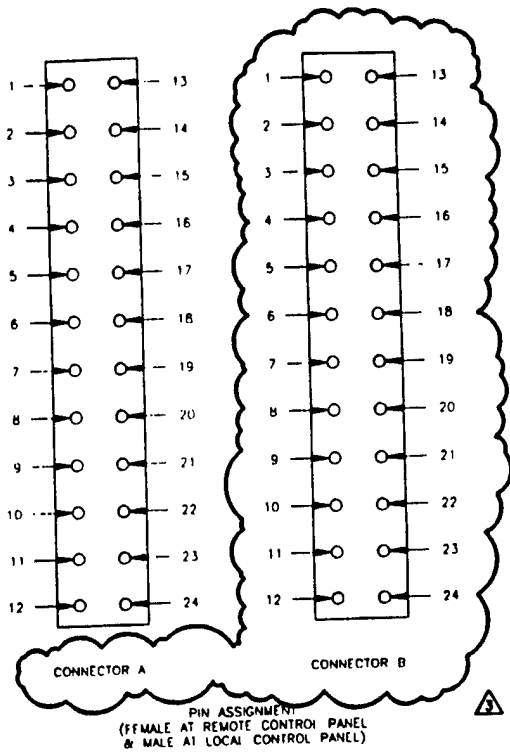
CONNECTOR C
PIN ASSIGNMENT
(FEMALE AT REMOTE CONTROL PANEL
& MALE AT LOCAL CONTROL PANEL)

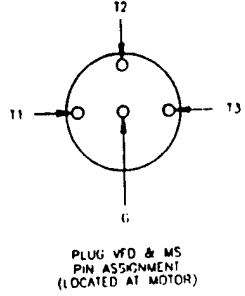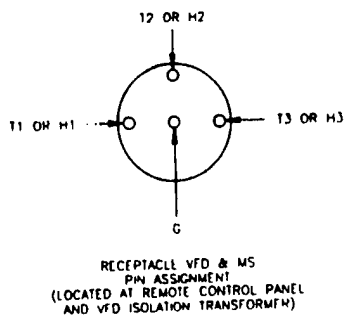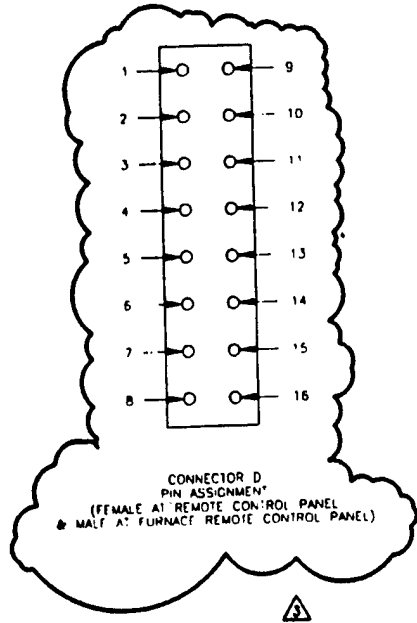

LEGEND

- INTERCONNECTING WIRING INSIDE REMOTE CONTROL PANEL
- ===== INTERCONNECTING WIRING INSIDE LOCAL CONTROL PANEL
- - - - - INTERCONNECTING WIRING ON AN AFTERBURNER SH-1
- _____ INTERCONNECTING WIRING BY OTHERS
- REMOTE CONTROL PANEL TERMINAL
- LOCAL CONTROL PANEL TERMINAL
- DEVICE PIN OR TERMINAL

MOTOR
PM, 1EXP
HZ 74 A

PER MOTOR
PM, 1EXP
HZ 21 A

REVISIONS				ENGINEERING RECORD			
NO	DESCRIPTION	BY	DATE	CHK	DATE	SCALE	NONF
0	FOR CONSTRUCTION	JW	3-4-95				
1	ADD'D VFD ISOLATION XMR	JW	4-27-95				
2	RECORD	JW	7-6-95				
3	FIELD MODIFICATIONS	CLP	8/1/96				

Artech
ENVIRONMENTAL SYSTEMS


PREPARED FOR
ROY F. WESTON, INC.

CLIENT JOB


**ELECTRICAL SCHEMATIC
AFTERBURNER**

APPROVED _____ DWG. #: ES120-5 REVISION 3


2

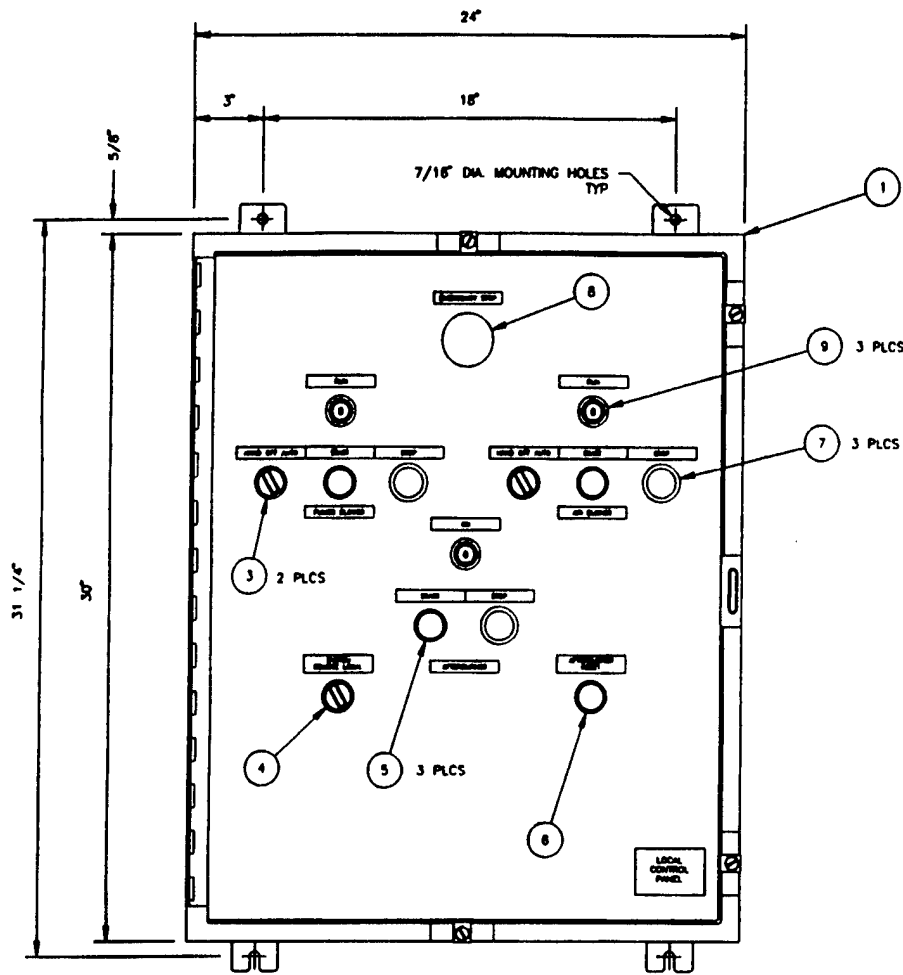

FRONT

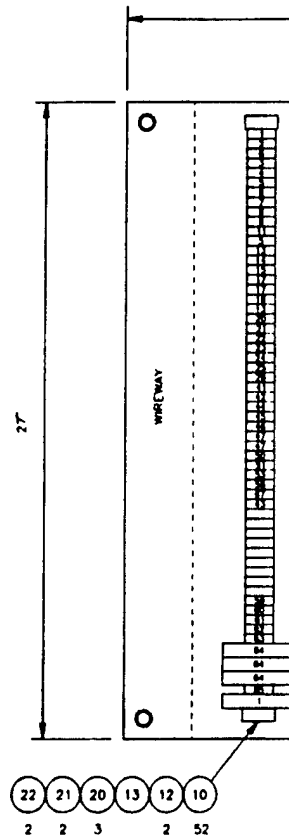

E

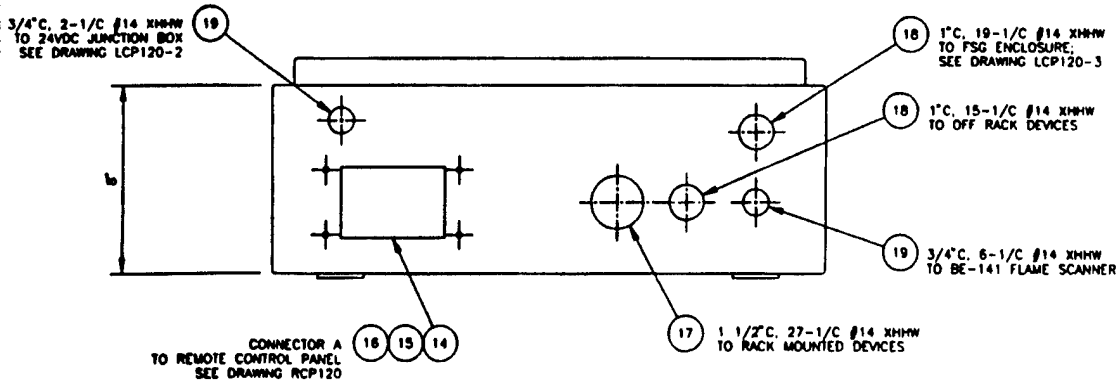

BOTTOM

LOCAL CONTROL PANEL

GENERAL NOTES

- 1 CONDUIT & CONNECTOR LOCATIONS ARE FOR REFERENCE ONLY. THE ACTUAL LOCATION MAY VARY FROM THAT SHOWN DUE TO INSTALLATION PARAMETERS.
- 2 ENCLOSURE FINISH: #61 GREY POLYESTER POWDER COATING.
- 3 NAMEPLATES TO BE WHITE PLASTIC LAMINATE WITH BLACK CHARACTERS.
- 4 WIRE TERMINATIONS TO TERMINAL BLOCKS TO BE BY HOOK FORK TYPE CONNECTORS


REFERENCE DRAWINGS

NUMBER	TITLE
ES120	ELECTRICAL SCHEMATIC
IC120	INTERCONNECTION DIAGRAM
RCP120	REMOTE CONTROL PANEL ASSEMBLY

1

BILL OF MATERIAL

ITEM	QTY	DESCRIPTION
1	1	ENCLOSURE; HOFFMAN A-30H24BLP
2	1	PANEL; HOFFMAN A-30P24
3	2	SWITCH, SELECTOR; ALLEN-BRADLEY 800H-JR4AP
4	1	SWITCH, SELECTOR; ALLEN-BRADLEY 800H-HR2AP
5	3	SWITCH, PUSHBUTTON; ALLEN-BRADLEY 800H-R2D1P
6	1	SWITCH, PUSHBUTTON; ALLEN-BRADLEY 800H-R2D1PD1P
7	3	SWITCH, PUSHBUTTON; ALLEN-BRADLEY 800H-FRXT2D2P
8	1	SWITCH, PUSHBUTTON; ALLEN-BRADLEY 800H-FRXT6D2P
9	3	INDICATOR; ALLEN-BRADLEY 800H-PR16G
10	9B	BLOCK, TERMINAL; ALLEN-BRADLEY 1492-F3
11	1	END BARRIER, TERMINAL; ALLEN-BRADLEY 1492-N18
12	4	END STOP, TERMINAL; ALLEN-BRADLEY 1492-N23
13	A/R	MOUNTING RAIL, TERMINAL; ALLEN-BRADLEY 1492-N22
14	1	BASE, CONNECTOR; T & B PB44B
15	1	CONNECTOR; T & B FS124 (1-24)
16	1	CONNECTOR; T & B FS148 (25-48)
17	1	HUB, CONDUIT; CROUSE-HINDS HUB5 (1 1/2")
18	2	HUB, CONDUIT; CROUSE-HINDS HUB3 (1")
19	1	HUB, CONDUIT; CROUSE-HINDS HUB2 (3/4")
20	3	BLOCK, FUSE; ALLEN-BRADLEY 1492-UF8
21	2	FUSE; 13/32" x 1 1/2", 3 AMP
22	2	FUSE; 13/32" x 1 1/2", 1 AMP

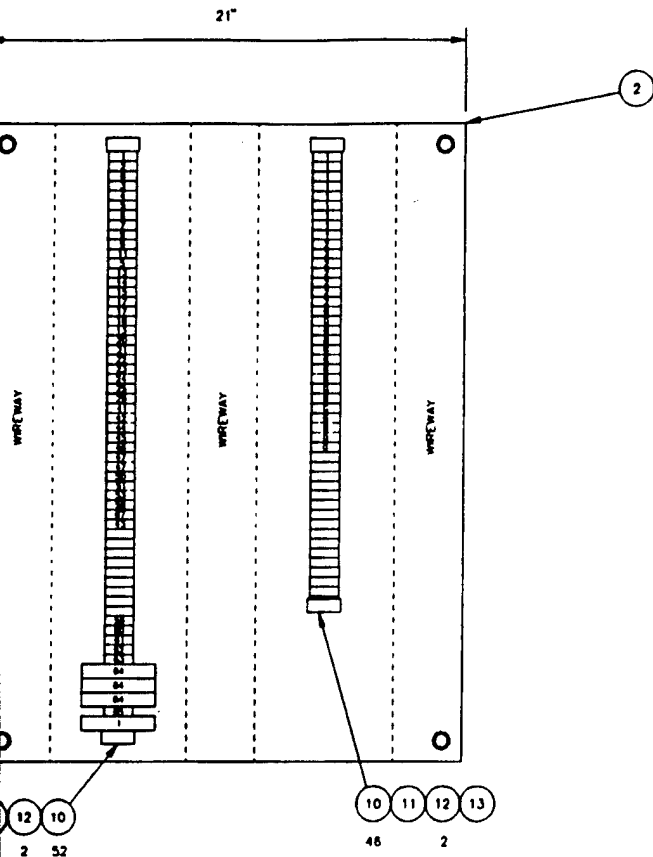

BACK PANEL

REVISIONS					ENGINEERING RECORD				
NO	DESCRIPTION	BY	DATE	CHK	DATE	SCALE	DATE	CHK	DATE
0	FOR CONSTRUCTION	JW	3-4-95			5" = 1'-0"			
1	ADDED RESET SWITCH	JW	4-7-95				10-2-94		
2	RECORD	JW	7-4-95						
2	As-Built	CLP	9/1/96						




PREPARED FOR
ROY F. WESTON, INC

CLIENT JOB


LOCAL CONTROL PANEL ASSY
AFTERBURNER

APPROVED


BWB: # LCP120-1 REVISION 2

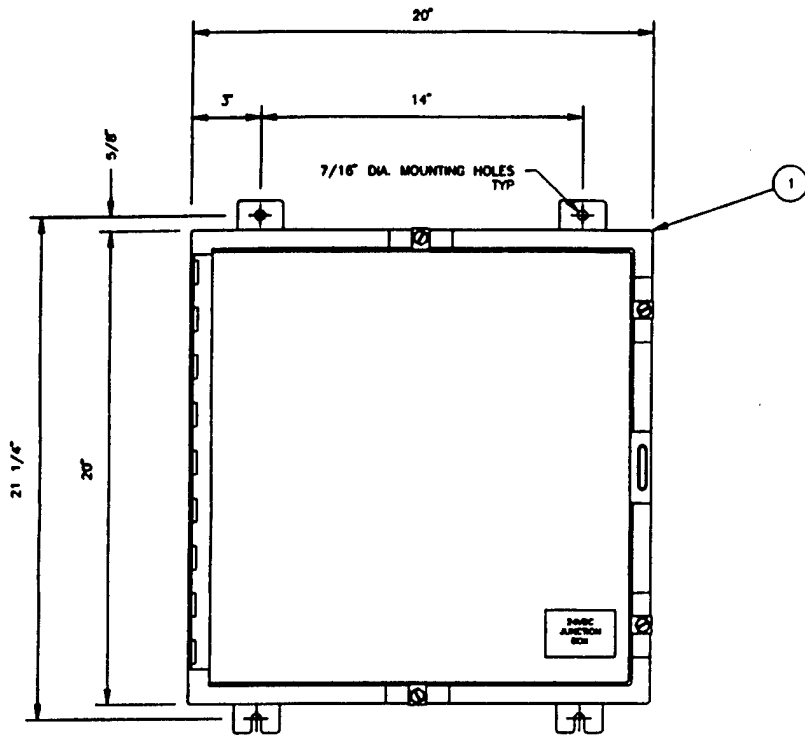

FRONT

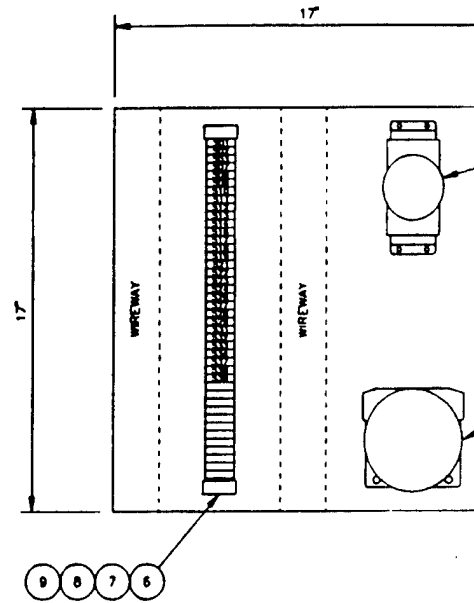

BACK PANEL

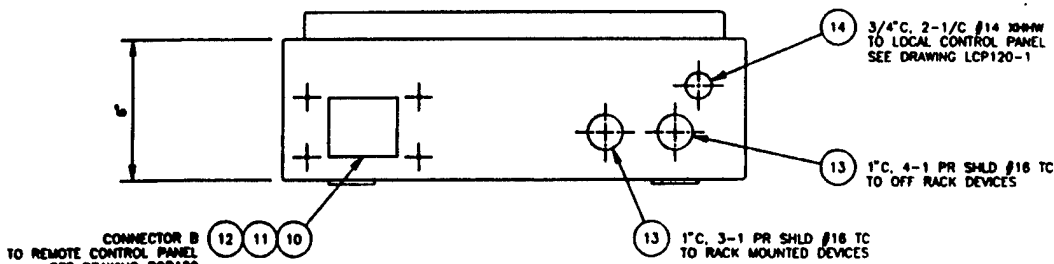

BOTTOM

24VDC JUNCTION BOX

GENERAL NOTES

1. CONDUIT & CONNECTOR LOCATIONS ARE FOR REFERENCE ONLY. THE ACTUAL LOCATION MAY VARY FROM THAT SHOWN DUE TO INSTALLATION PARAMETERS.
2. ENCLOSURE FINISH: #61 GREY POLYESTER POWDER COATING.
3. NAMEPLATES TO BE WHITE PLASTIC LAMINATE WITH BLACK CHARACTERS


REFERENCE DRAWINGS

NUMBER	TITLE
ES120	ELECTRICAL SCHEMATIC
IC120	INTERCONNECTION DIAGRAM
RCP120	REMOTE CONTROL PANEL ASSEMBLY

1

BILL OF MATERIAL

ITEM	QTY	DESCRIPTION
1	1	ENCLOSURE; HOFFMAN A-20H20ALP
2	1	PANEL; HOFFMAN A-20P20
3	1	SUPPLY, POWER; EIT MODEL RP1072-24 24VDC/3A
4	1	MODULE, INTERFACE; ADVANTECH ADAM 4017
5	1	BRACKET, PANEL MOUNTING; FOR ITEM 4
6	42	BLOCK, TERMINAL; ALLEN-BRADLEY 1492-F1
7	1	END BARRIER, TERMINAL; ALLEN-BRADLEY 1492-N18
8	2	END STOP, TERMINAL; ALLEN-BRADLEY 1492-N23
9	A/R	MOUNTING RAIL, TERMINAL; ALLEN-BRADLEY 1492-N22
10	1	BASE, CONNECTOR; T & B PB132
11	1	CONNECTOR; T & B FS116 (1-16)
12	1	CONNECTOR; T & B FS132 (17-32)
13	2	HUB, CONDUIT; CROUSE-HINDS HUB3 (1")
14	1	HUB, CONDUIT; CROUSE-HINDS HUB2 (3/4")

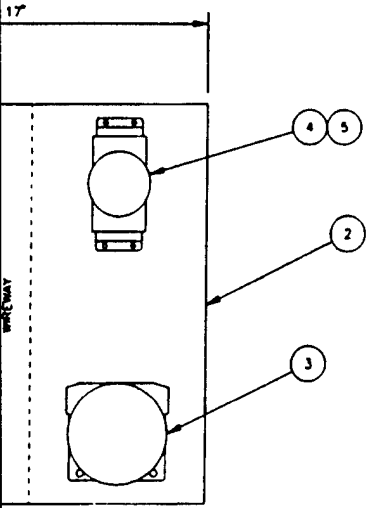

PANEL

REVISIONS					ENGINEERING RECORD				
NO	DESCRIPTION	BY	DATE	CHK	DATE	SCALE	DATE	CHK	DATE
0	FOR CONSTRUCTION	JW	3-6-95			5"=1'-0"			
1	REVISED LCP120-1	JW	4-7-95				1-7-95		
2	RECORD	JW	7-4-95						
3	FIELD MODIFICATIONS	UP	8-1-95						




PREPARED FOR
ROY F. WESTON, INC

LOCAL CONTROL PANEL ASSY AFTERBURNER

APPROVED


DWG. #: LCP120-2 REVISION 3

2

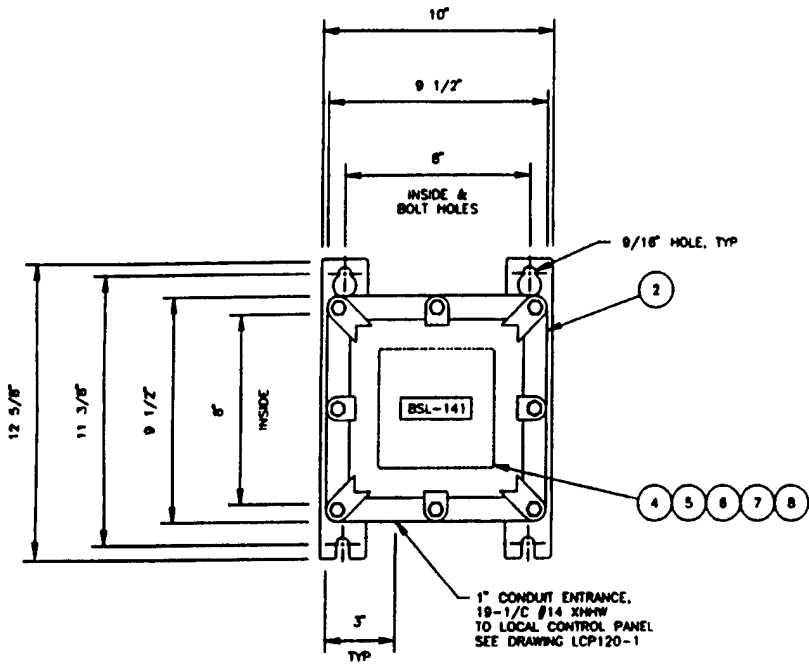


FLAME SAFEGUARD ENCLOSURE

NOTE: INSTALL VENT (C-H ECD13) IN TOP OF ENCLOSURE & DRAIN (C-H ECD11) IN BOTTOM OF ENCLOSURE

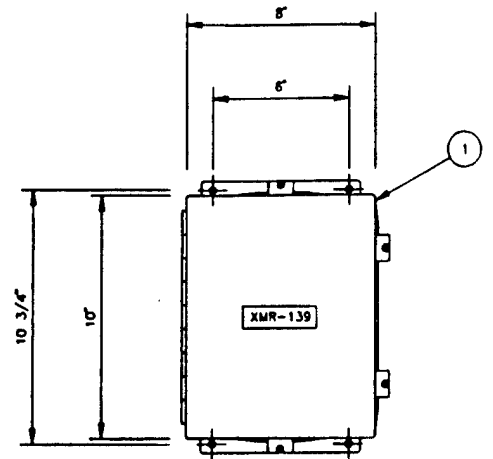

FRONT

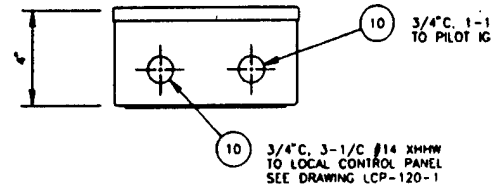

BOTTOM

IGNITION TRANSFORMER

GENERAL NOTES

1. CONDUIT LOCATIONS ARE FOR REFERENCE ONLY. THE ACTUAL LOCATION MAY VARY DUE TO INSTALLATION PARAMETERS.
2. FSG ENCLOSURE FINISH: NONE
3. TRANSFORMER FINISH: # 01 GREY POLYESTER POWDER COATING
4. NAMEPLATES TO BE WHITE LAMINATE PLASTIC WITH BLACK CHARACTERS.


REFERENCE DRAWINGS

NUMBER	TITLE
ES120	ELECTRICAL SCHEMATIC
IC120	INTERCONNECTION DIAGRAM
RCP120	REMOTE CONTROL PANEL ASSEMBLY

①

BILL OF MATERIAL

ITEM	QTY	DESCRIPTION
1	1	ENCLOSURE; HOFFMAN A-100BCHNF
2	1	ENCLOSURE; CROUSE-HINDS EJB886-SA
3	1	PANEL; HOFFMAN A-10PB
4	1	PROGRAMMER, FLAME; HONEYWELL RM7840L1018
5	1	AMPLIFIER, FLAME; HONEYWELL R7847A1033
6	1	CARD, PURGE TIMER; HONEYWELL ST7800A1039 (30 SEC)
7	1	MODULE, REMOTE RESET; HONEYWELL ST7820A1007
8	1	BASE, MOUNTING; HONEYWELL Q7800A1005
9	1	TRANSFORMER, IGNITION; HONEYWELL Q624A1014
10	2	HUB, CONDUIT; CROUSE-HINDS HUB2 (3/4")

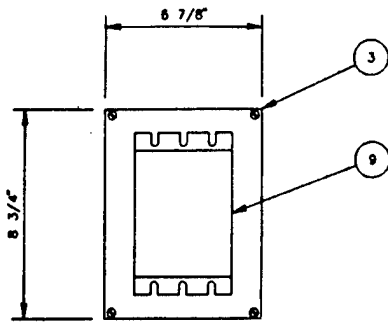

BACK PANEL

10 3/4" C. 1-1/2" Ø 16 15KV TO PILOT IGNITOR

3-1/2" Ø 14 XMMW LOCAL CONTROL PANEL DRAWING LCP-120-1

ON TRANSFORMER ENCLOSURE

REVISIONS					ENGINEERING RECORD				
NO	DESCRIPTION	BY	DATE	CHKD	DATE	SCALE	DATE	CHKD	DATE
0	FOR CONSTRUCTION	JW	1-1-95			3" = 1'-0"			
1	REVISED LCP120-1	JW	4-7-95						
2	RECORD	JW	7-4-95						
2	As Built	WP	8/1/96						



PREPARED FOR
ROY F. WESTON, INC


CLIENT JOB:

LOCAL CONTROL PANEL ASSY
AFTERBURNER


APPROVED

DWG. #: LCP120-3 REVISION 2

2

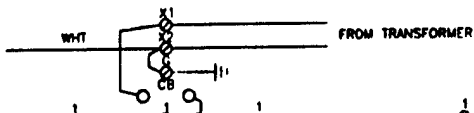

CONNECTOR A

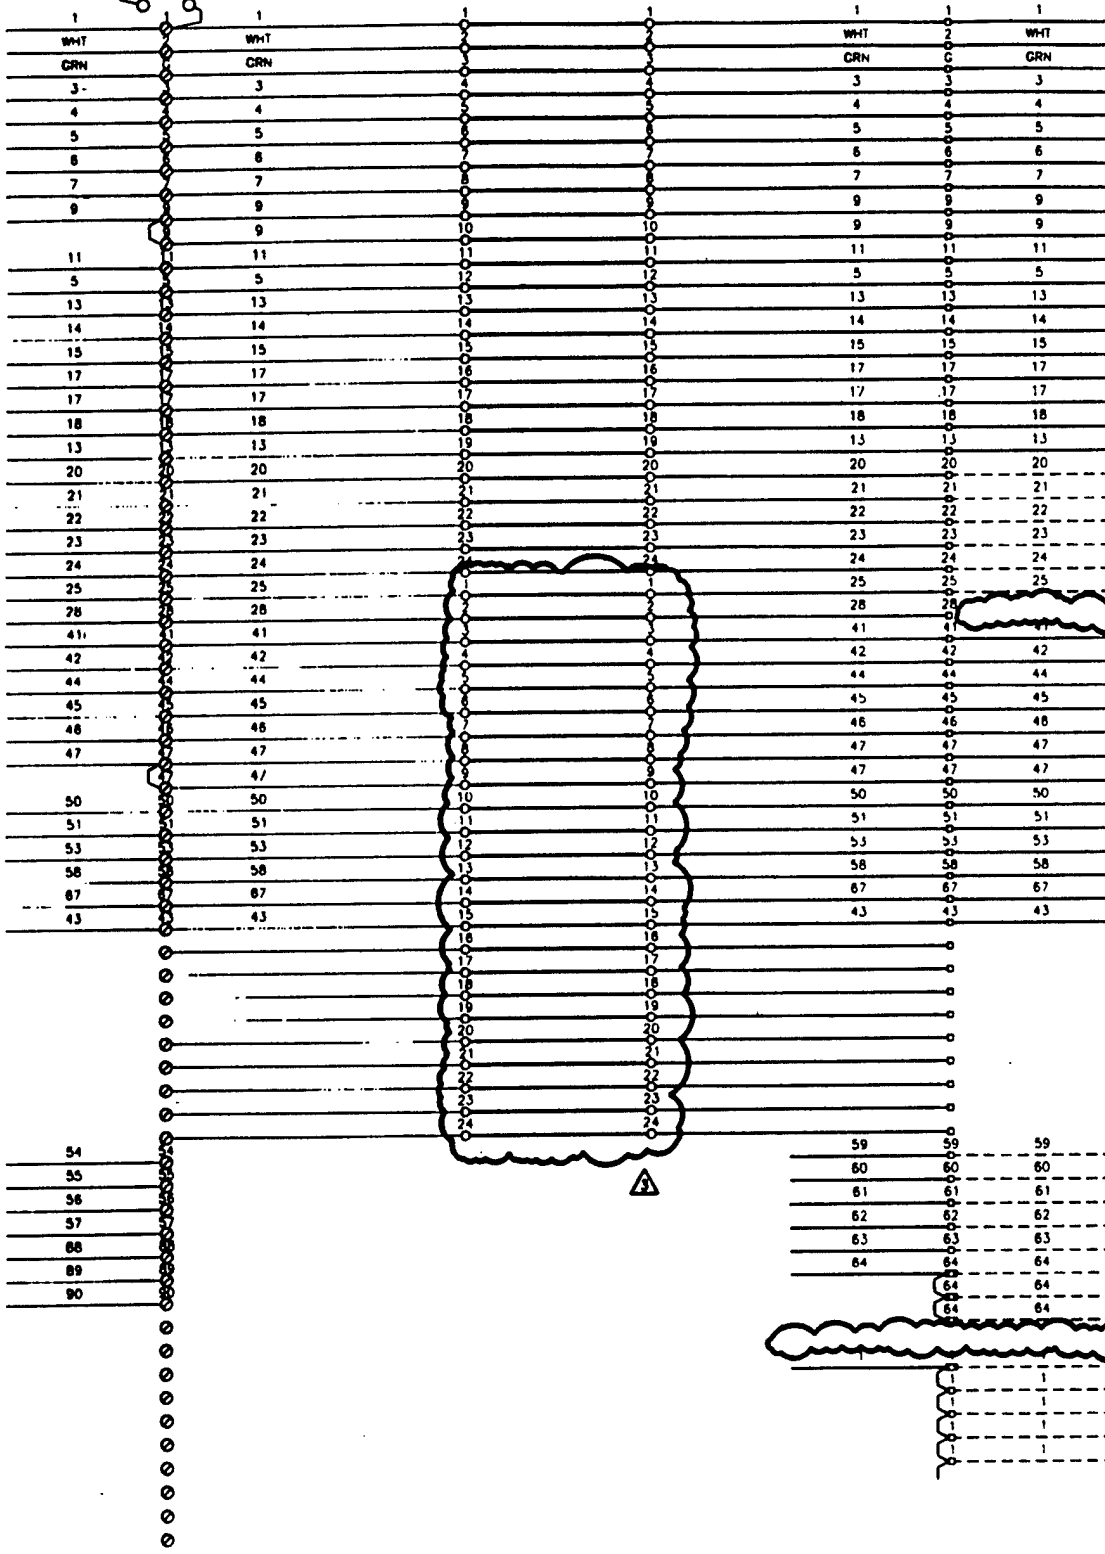

- TO PSL-122 FUEL PRESSURE LOW SWITCH (NO)
- TO PSH-123 FUEL PRESSURE HIGH SWITCH (NC)
- TO PSH-135 FUEL PRESSURE HIGH SWITCH (NC)
- TO PSL-130 AIR PRESSURE LOW SWITCH (NO)
- TO PSL-155 FUMES PRESSURE LOW SWITCH (NO)
- TO PSH-153 FUMES PRESSURE HIGH SWITCH (NC)

- TO ZSC-129 FUEL VALVE CLOSED SWITCH (B)
- TO ZSL-131 LOW FIRE SWITCH (C)
- TO ZSL-131 LOW FIRE SWITCH (NO)
- TO YMR-139 IGNITION TRANSFORMER (L1)
- TO BV-105 PILOT FUEL BLOCK VALVE
- TO BV-127 BURNER FUEL BLOCK VALVE (1)
- TO BV-129 BURNER FUEL BLOCK VALVE (2)
- TO BV-128 BURNER FUEL BLOCK VALVE
- TO TY-131 FUEL RATE CONTROL MOTOR (L1)
- TO PSL-122 FUEL PRESSURE LOW SWITCH (C)
- TO PSH-123 FUEL PRESSURE HIGH SWITCH (C)
- TO PSH-135 FUEL PRESSURE HIGH SWITCH (C)
- TO PSL-130 AIR PRESSURE LOW SWITCH (C)

GENERAL NOTES

REFERENCE DRAWINGS

NUMBER	TITLE
PD120	PIPING & INSTRUMENT DIAGRAM
LS120	ELECTRIC SCHEMATIC
ICP120	LOCAL CONTROL PANEL ASSEMBLY
RCP120	REMOTE CONTROL PANEL ASSEMBLY


PLOTTED 08/01/86 5:15 pm
 P.L.S. 1 of 1

①

SWITCH (NO)
 SWITCH (NC)
 SWITCH (NC)
 SWITCH (NO)
 SWITCH (NO)
 SWITCH (NC)

SWITCH (B)
)
 NO)
 ER (L1)
 VALVE
 VALVE (1)
 VALVE (1)
 VALVE
 MOTOR (L1)
 SWITCH (C)
 SWITCH (C)
 SWITCH (C)
 SWITCH (C)


120 VOLT WIRING

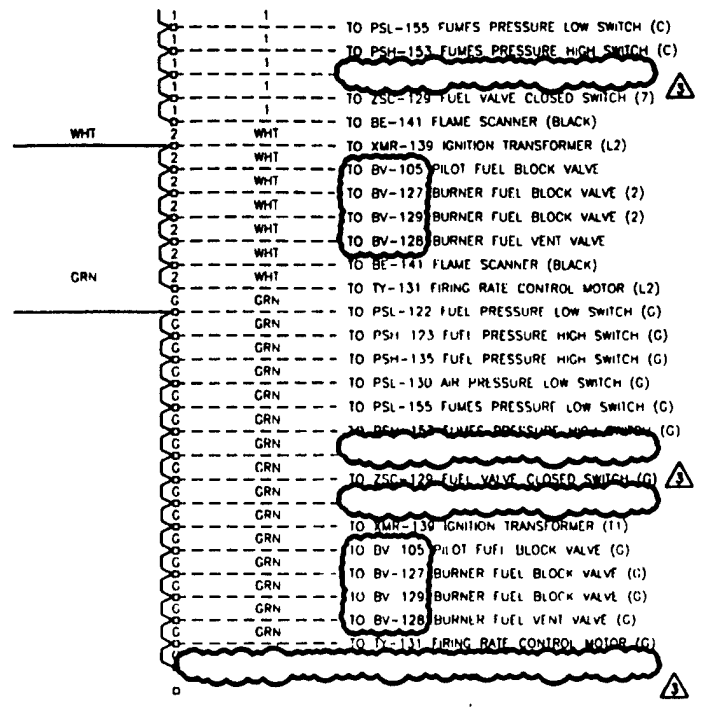

LEGEND

- INTERCONNECTING WIRING INSIDE REMOTE CONTROL PANEL
- ===== INTERCONNECTING WIRING INSIDE LOCAL CONTROL PANEL
- INTERCONNECTING WIRING ON AFTERBURNER SKID
- INTERCONNECTING WIRING BY OTHERS
- ⊙ REMOTE CONTROL PANEL TERMINAL
- LOCAL CONTROL PANEL TERMINAL
- DEVICE PIN OR TERMINAL

REVISIONS					ENGINEERING RECORD					
NO	DESCRIPTION	BY	DATE	CHK	DATE	SCALE	NO	DATE	CHK	DATE
0	FOR CONSTRUCTION	JW	3-8-95							
1	ADDED WIRE 43	JW	4-27-95							
2	RECORD	JW	7-6-95							
3	FIELD MODIFICATIONS	JW	8-15-95							



Artech
ENVIRONMENTAL SYSTEMS

PREPARED FOR
ROY F. WESTON, INC.


**INTERCONNECTION DIAGRAM
AFTERBURNER**

APPROVED

DWG. #: IC120-1

REVISED

(7)

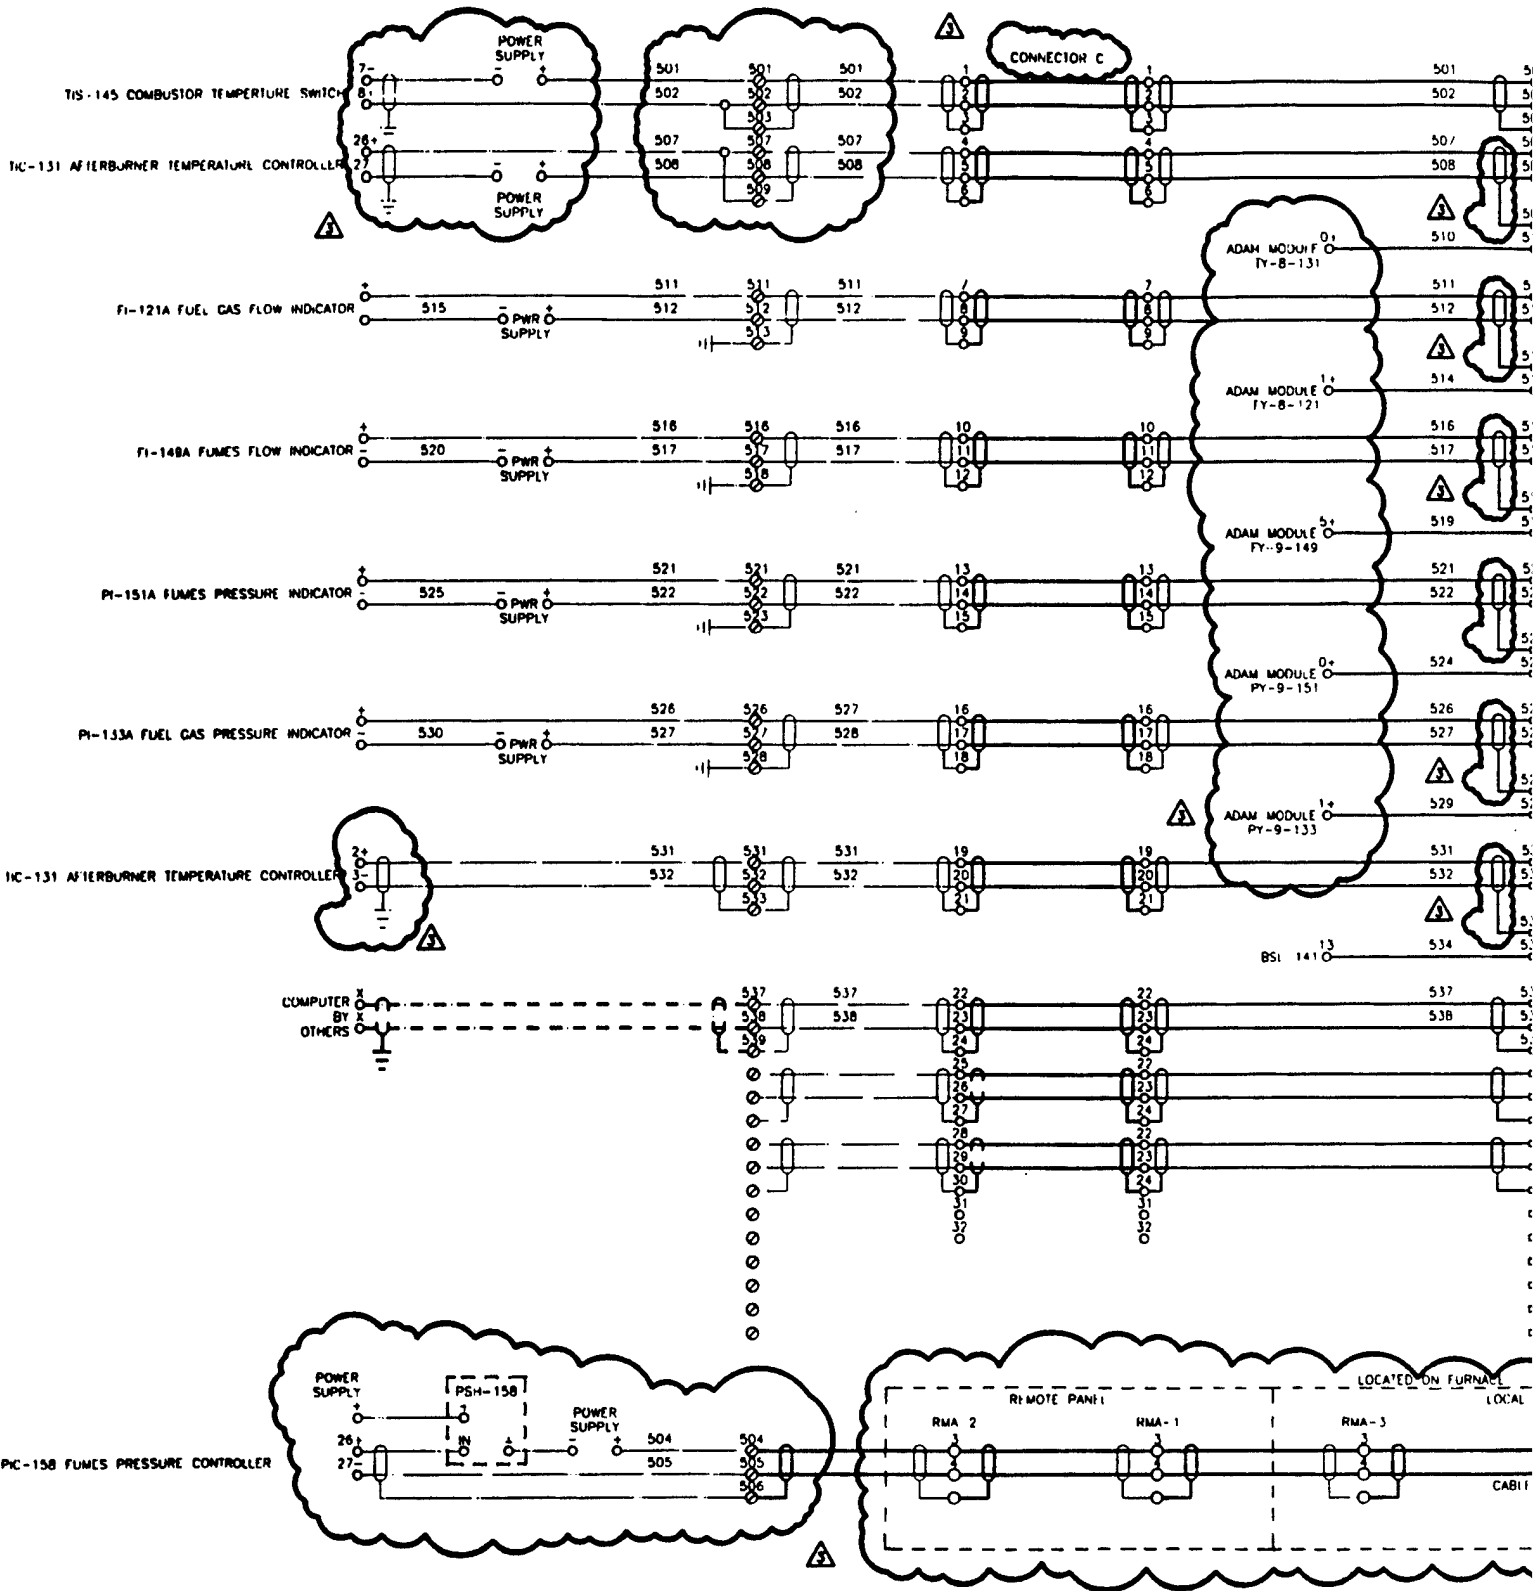

ANALOG WIRING



GENERAL NOTES

REFERENCE DRAWINGS

NUMBER	TITLE
PID120	PIPING & INSTRUMENT DIAGRAM
ES120	ELECTRIC SCHEMATIC
LCP120	LOCAL CONTROL PANEL ASSEMBLY
RCP120	REMOTE CONTROL PANEL ASSEMBLY

PLOTTED 08/02/86 9:33
 P.L. SC. 1st

①

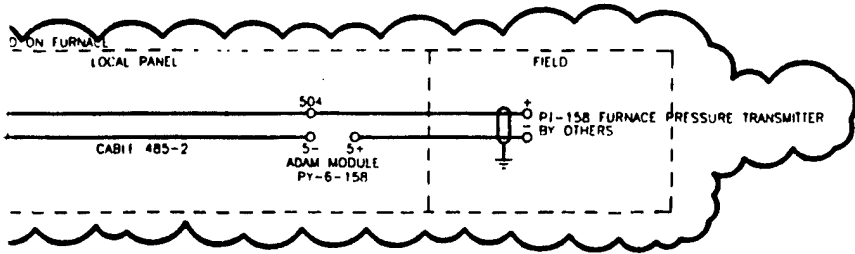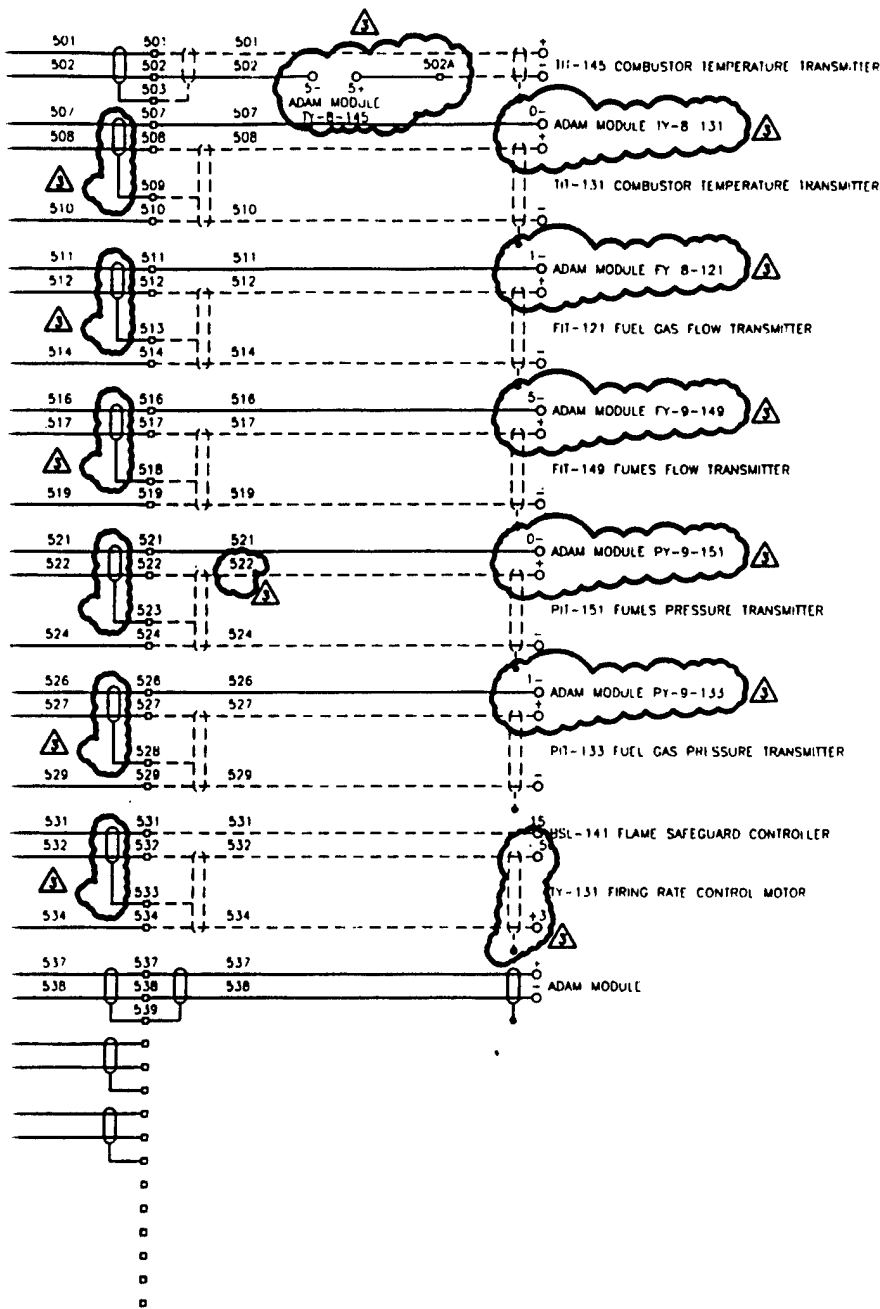

LEGEND

- INTERCONNECTING WIRING INSIDE REMOTE CONTROL PANEL
- INTERCONNECTING WIRING INSIDE LOCAL CONTROL PANEL
- INTERCONNECTING WIRING ON AFTERBURNER SKID
- INTERCONNECTING WIRING BY OTHERS
- REMOTE CONTROL PANEL TERMINAL
- LOCAL CONTROL PANEL TERMINAL
- DEVICE PIN OR TERMINAL

REVISIONS				ENGINEERING RECORD			
NO	DESCRIPTION	BY	DATE	CRD	DATE	SCALE	NONE
0	FOR CONSTRUCTION	JW	3-6-95				
1	REVISED IC120-1 & 3	JW	4-7-95				
2	RECORD	JW	7-4-95				
3	FIELD MODIFICATIONS	clp	9/1/96				



PREPARED FOR
ROY F. WESTON, INC.

CLIENT JOB

INTERCONNECTION DIAGRAM
AFTERBURNER

APPROVED
DWG. #: IC120-2
REVISION 3

480V, 3 PH, 60 HZ
POWER
BY
OTHERS

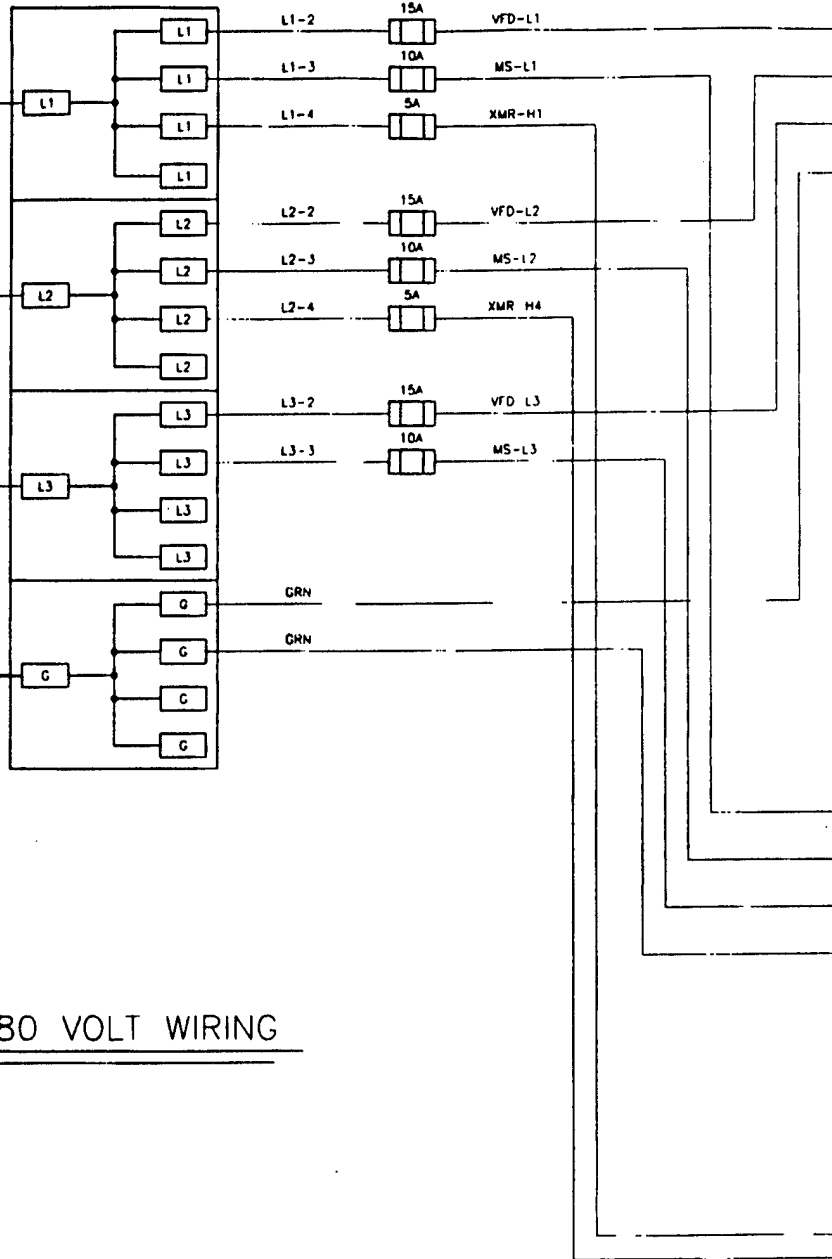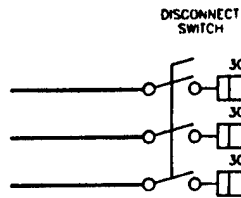

480 VOLT WIRING


GENERAL NOTES

REFERENCE DRAWINGS

NUMBER	TITLE
PI0120	PIPING & INSTRUMENT DIAGRAM
ES120	ELECTRIC SCHEMATIC
LCP120	LOCAL CONTROL PANEL ASSEMBLY
RCP120	REMOTE CONTROL PANEL ASSEMBLY

PLOTTED 08/02/98 9:35
 P.L.T. SC 1-1



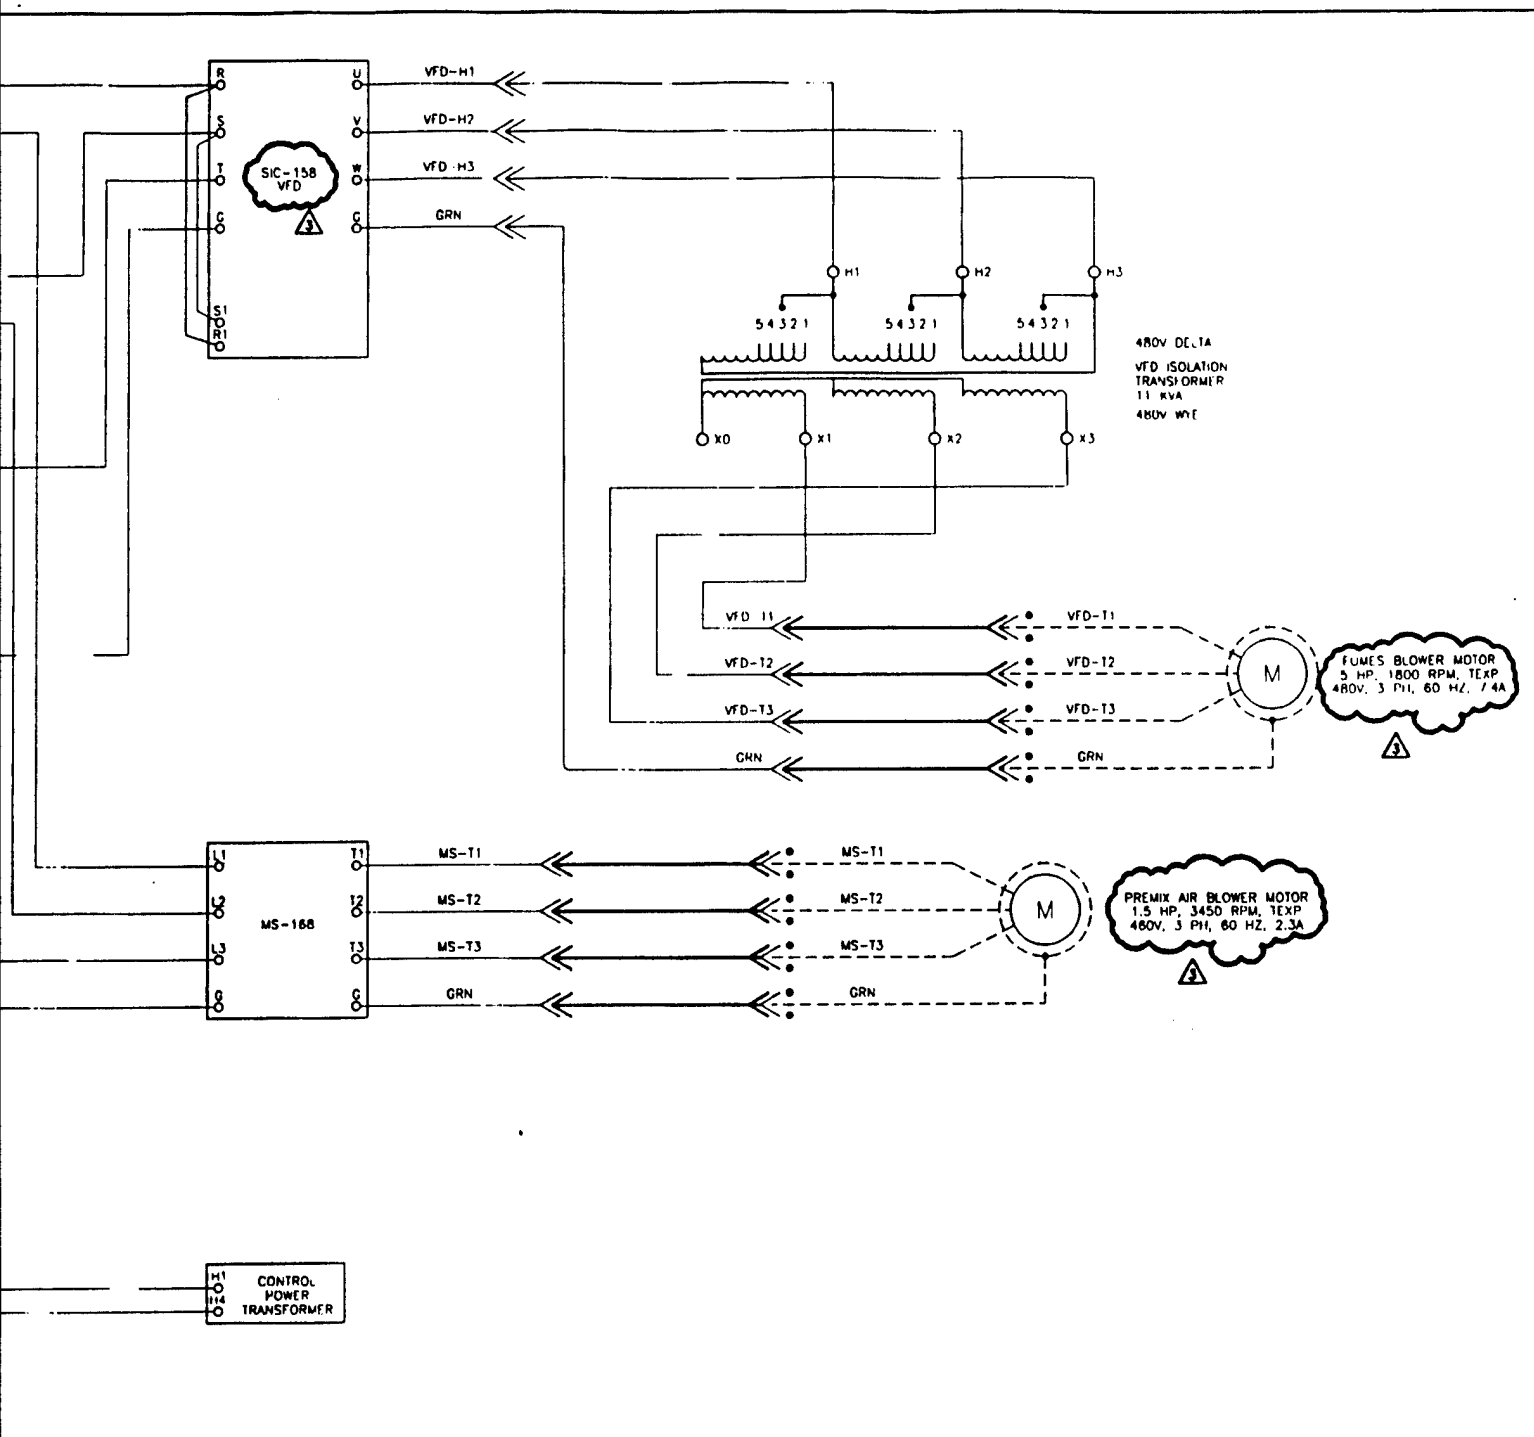

LEGEND

- INTERCONNECTING WIRING INSIDE REMOTE CONTROL PANEL
- INTERCONNECTING WIRING INSIDE LOCAL CONTROL PANEL
- INTERCONNECTING WIRING ON AFTERBURNER SKID
- INTERCONNECTING WIRING BY OTHERS
- ⊙ REMOTE CONTROL PANEL TERMINAL
- LOCAL CONTROL PANEL TERMINAL
- DEVICE PIN OR TERMINAL

REVISIONS					ENGINEERING RECORD				
NO	DESCRIPTION	BY	DATE	CAD	DATE	SCALE	NOTE	DATE	DATE
0	FOR CONSTRUCTION	JW	3-8-95						
1	ADDED VFD ISOLATION XMR	JW	4-27-95			JW	1-5-95		
2	RECORD	JW	7-6-95						
3	FIELD MODIFICATIONS	sp	8-7-95						


PREPARED FOR
ROY F. WESTON, INC.

CLIENT JOB

INTERCONNECTION DIAGRAM AFTERBURNER

APPROVED
DWG. #: IC120-3
REVISION 3

2

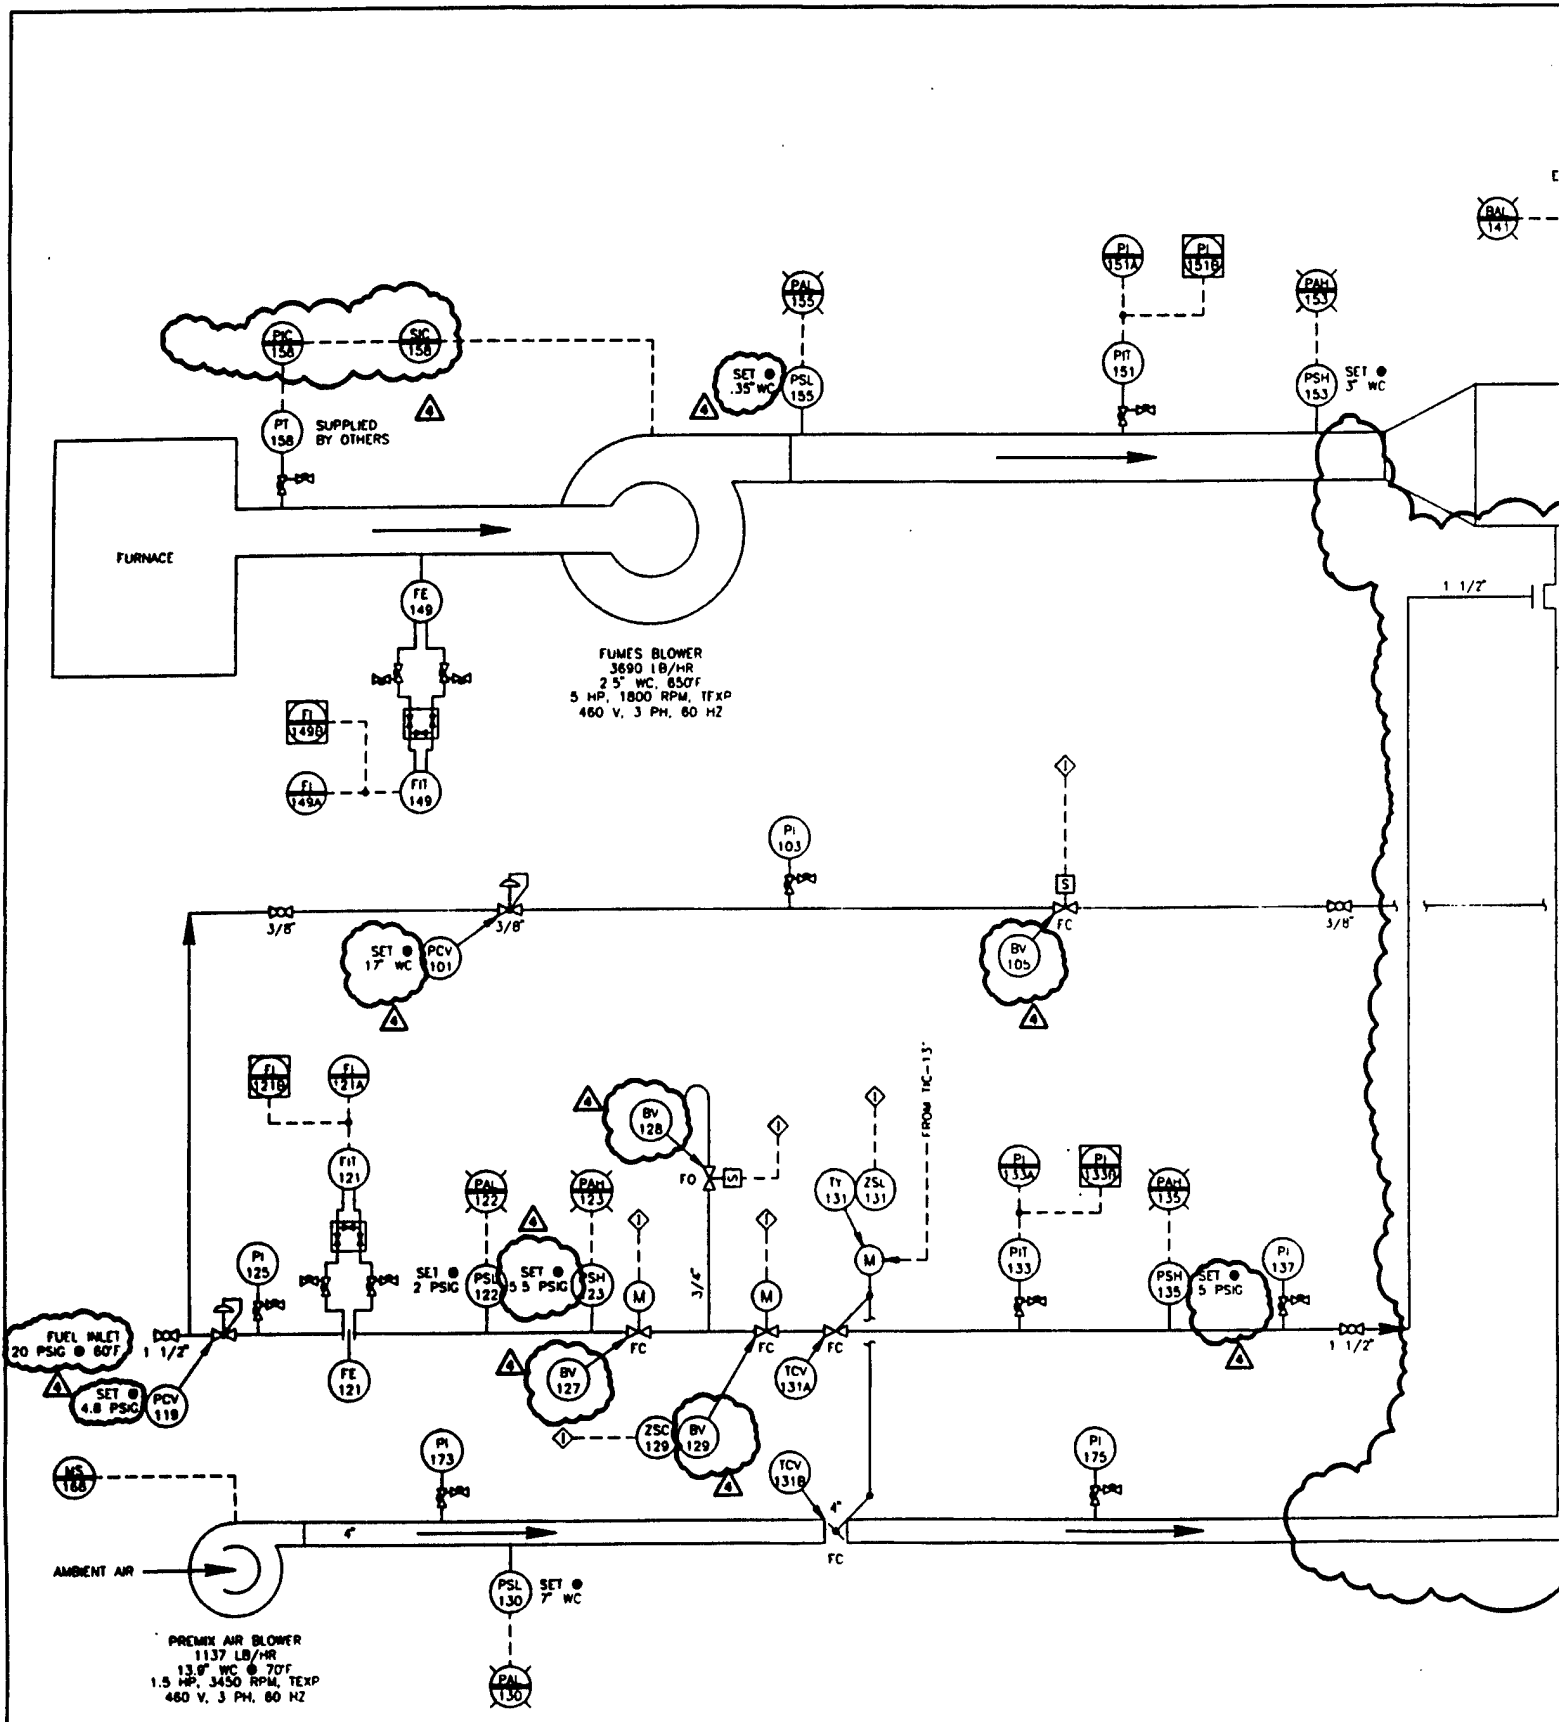

GENERAL NOTES


1. THE BURNER MANAGEMENT SYSTEM SHALL BE DESIGNED IN ACCORDANCE WITH THE INTENT OF IRI GUIDELINES.
2. EQUIPMENT AREA CLASSIFICATION LOCAL EQUIPMENT - CLASS 1, DIVISION 2, GROUP D; REMOTE EQUIPMENT - UNCLASSIFIED
3. ALL LOCAL ELECTRICAL ENCLOSURES SHALL BE SUITABLE FOR OUTDOOR INSTALLATION
4. ALL ELECTRICAL INTERCONNECTIONS BETWEEN THE LOCAL CONTROL PANEL AND THE REMOTE CONTROL PANEL SHALL BE BY OTHERS
5. ALL LOCAL INTERCONNECTIONS, ELECTRICAL AND MECHANICAL, SHALL BE BY AIRTECH

REFERENCE DRAWINGS

NUMBER	TITLE
LCP120	LOCAL CONTROL PANEL ASSEMBLY
RCP120	REMOTE CONTROL PANEL ASSEMBLY
ES120	ELECTRICAL SCHEMATIC
IC120	INTERCONNECTION DIAGRAM
ITA120	FUEL TRAIN ASSEMBLY

PLOTTER &
 P.L.T. S.C. 1-1



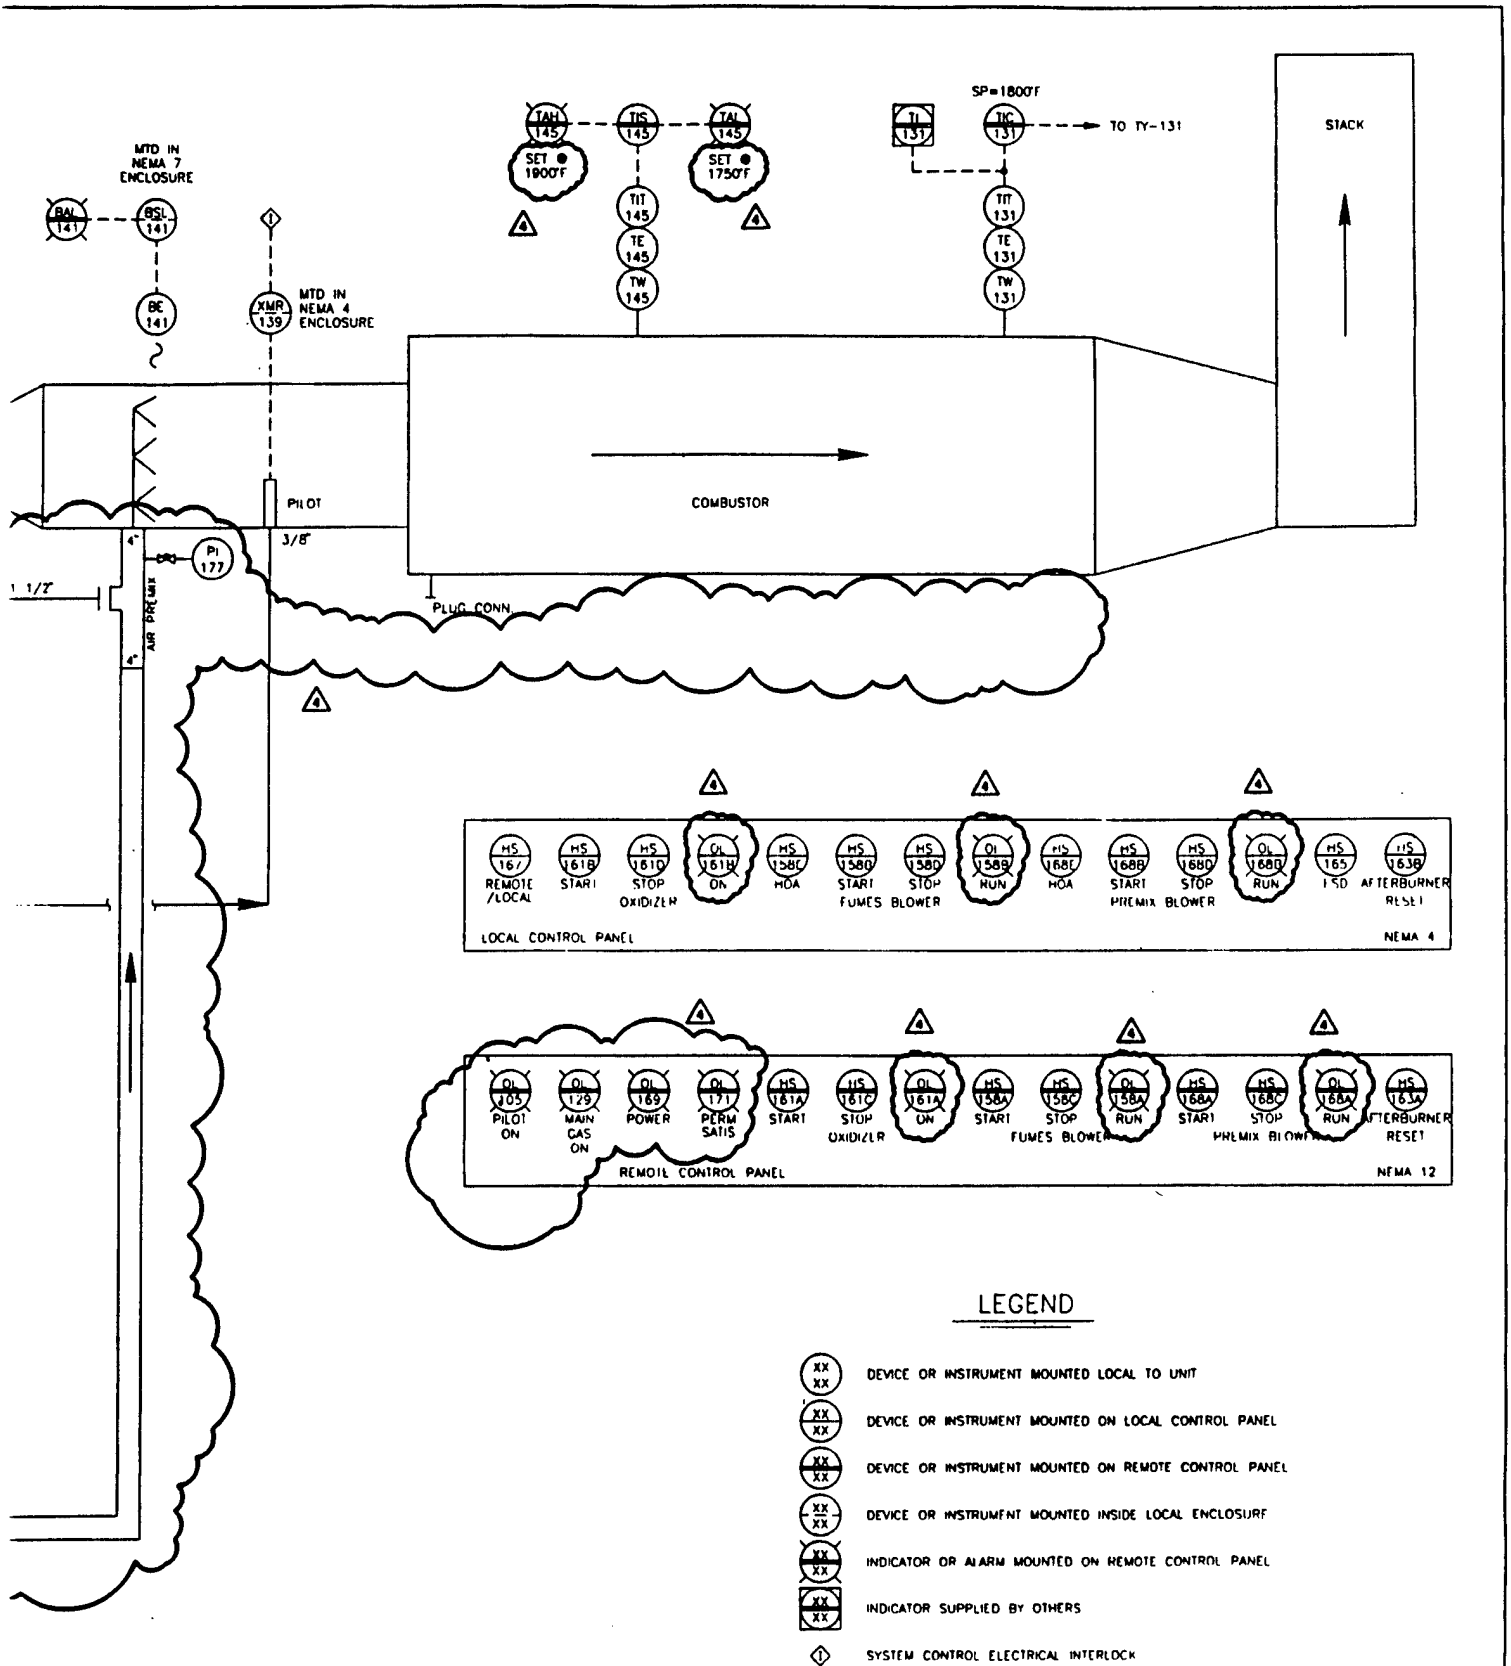

PREPARED FOR
ROY F. WESTON, INC


CLIENT JOB

P & ID
AFTERBURNER


APPROVED

DWG. #: PID120

REVISION 4

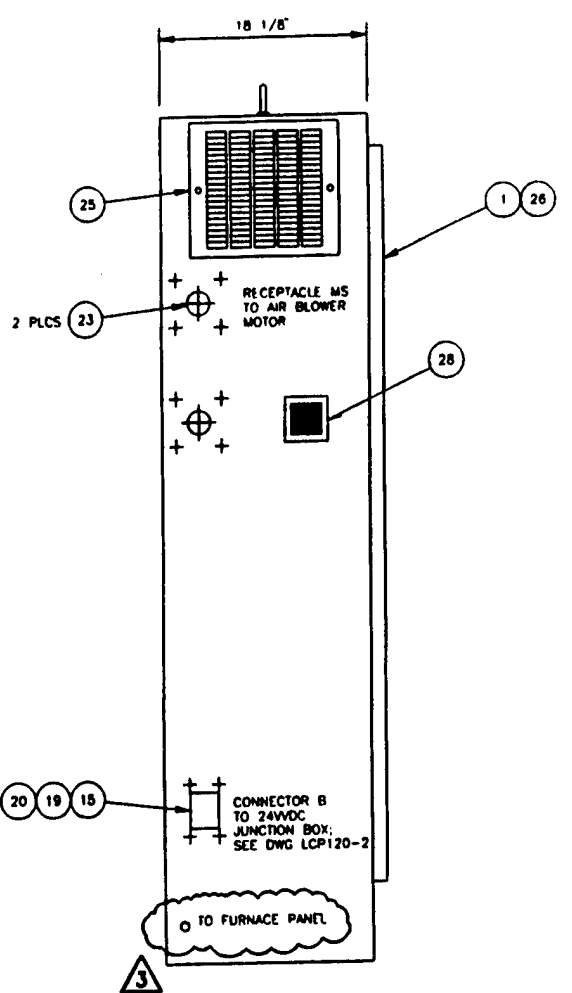

LEFT SIDE

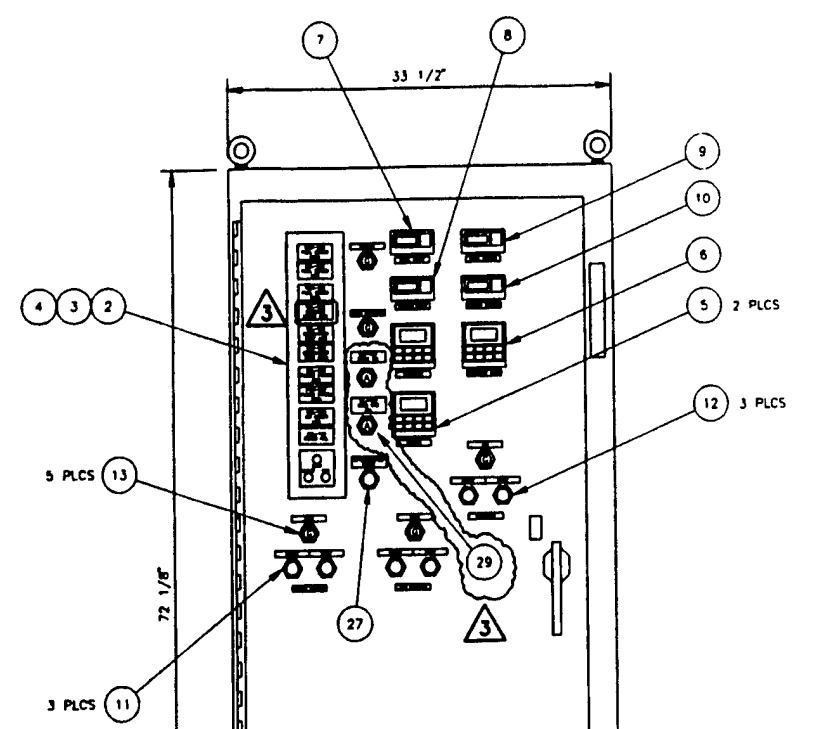

FRONT

REMOTE CONTROL PANEL

GENERAL NOTES


1. CONNECTOR & RECEPTACLE LOCATIONS ARE FOR REFERENCE ONLY. THE ACTUAL LOCATION MAY VARY FROM THAT SHOWN DUE TO INSTALLATION PARAMETERS.
2. ENCLOSURE FINISH: #61 GREY POLYESTER POWDER COATING.
3. NAMEPLATES TO BE WHITE PLASTIC LAMINATE WITH BLACK CHARACTERS.

REFERENCE DRAWINGS


NUMBER	TITLE
ES120	ELECTRICAL SCHEMATIC
IC120	INTERCONNECTION DIAGRAM
LCP120	LOCAL CONTROL PANEL



CS
CS

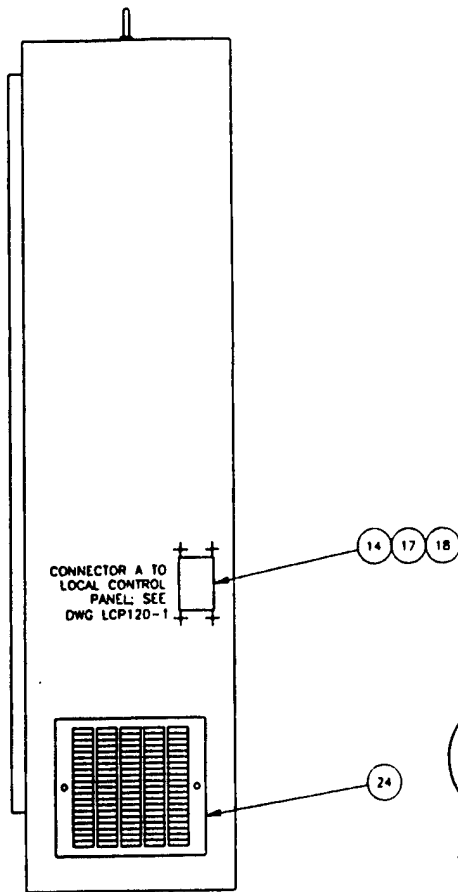

RIGHT SIDE

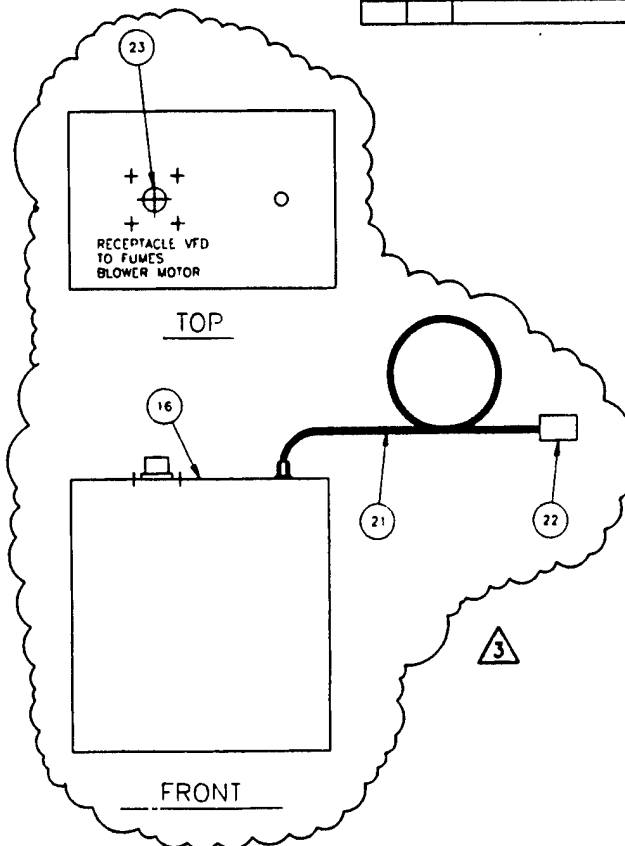

VFD ISOLATION TRANSFORMER

BILL OF MATERAIL

ITEM	QTY	DESCRIPTION
1	1	ENCLOSURE; HOFFMAN A-72XM3418
2	1	CABINET, ANNUNCIATOR; FONAN 1.6X3LR-2000
3	10	MODULE, ALARM; RONAN X3-2004GP-115VAC
4	1	MODULE, PB & FLASHER; RONAN X3-5002-115VAC
5	2	CONTROLLER; HONEYWELL DC300C-0-0A0-20-0000-0
6	1	SWITCH; HONEYWELL DC200I-2-000-100000-0
7	1	METER; MOORE IND DSX/4-20MA/0-1000/1.OVLP [P]
8	1	METER; MOORE IND DSX/4-20MA/0-4000/1.OVLP/DZ [P]
9	1	METER; MOORE IND DSX/4-20MA/0-6/1.OVLP [P]
10	1	METER; MOORE IND DSX/4-20MA/0-3/1.OVLP [P]
11	3	SWITCH, PUSHBUTTON; ALLEN-BRADLEY 800T-A2D1
12	3	SWITCH, PUSHBUTTON; ALLEN-BRADLEY 800T-FX2D4
13	5	INDICATOR; ALLEN-BRADLEY 800T-PL16G
14	1	BASE, CONNECTOR; T & B PB448
15	1	BASE, CONNECTOR; T & B PB132
16	1	TRANSFORMER, ISOLATION; SQUARE D 11T105HDIT
17	1	CONNECTOR; T & B MS224 (1-24)
18	1	CONNECTOR; T & B MS 248 (25-48)
19	1	CONNECTOR; T & B MS216 (1-16)
20	1	CONNECTOR; T & B MS232 (17-32)
21	1	CABLE; TYPE SO, 4-#8 AWG x 10' LG, 600V, 28 A
22	1	PLUG; MELTRIC 33-11043 (20 AMP)
23	3	RECEPTACLE; MELTRIC 33-14043 (20 AMP)
24	1	PACKAGE, COOLING FAN; HOFFMAN A-PA10AXFN
25	1	GRILLE, EXHAUST; HOFFMAN A-EXGR10
26	1	ADAPTER, OPERATOR; HOFFMAN A-21ABVA
27	1	SWITCH, PUSHBUTTON; ALLEN-BRADLEY 800T-A2A2
28	1	HORN, ALARM; EDWARDS 120VAC
29	2	INDICATOR; ALLEN BRADLEY 800T-PL16A

REVISIONS					ENGINEERING RECORD			
NO.	DESCRIPTION	BY	DATE	CHK	DATE	SCALE	1 1/2" = 1'-0"	DATE
0	FOR CONSTRUCTION	JW	3-4-95			DWG		
1	ADDED VFD ISOLATION XMR	JW	4-7-95			DWG	1-9-95	
2	RECORD	JW	7-4-95					
3	FIELD MODIFICATIONS	CAP	8-1-95					

Artech
ENVIRONMENTAL SYSTEMS

PREPARED FOR
ROY F. WESTON, INC.


CLIENT JOB:

REMOTE CONTROL PANEL ASSY AFTERBURNER

APPROVED

DWG. #: RCP120-1

REVISION 3

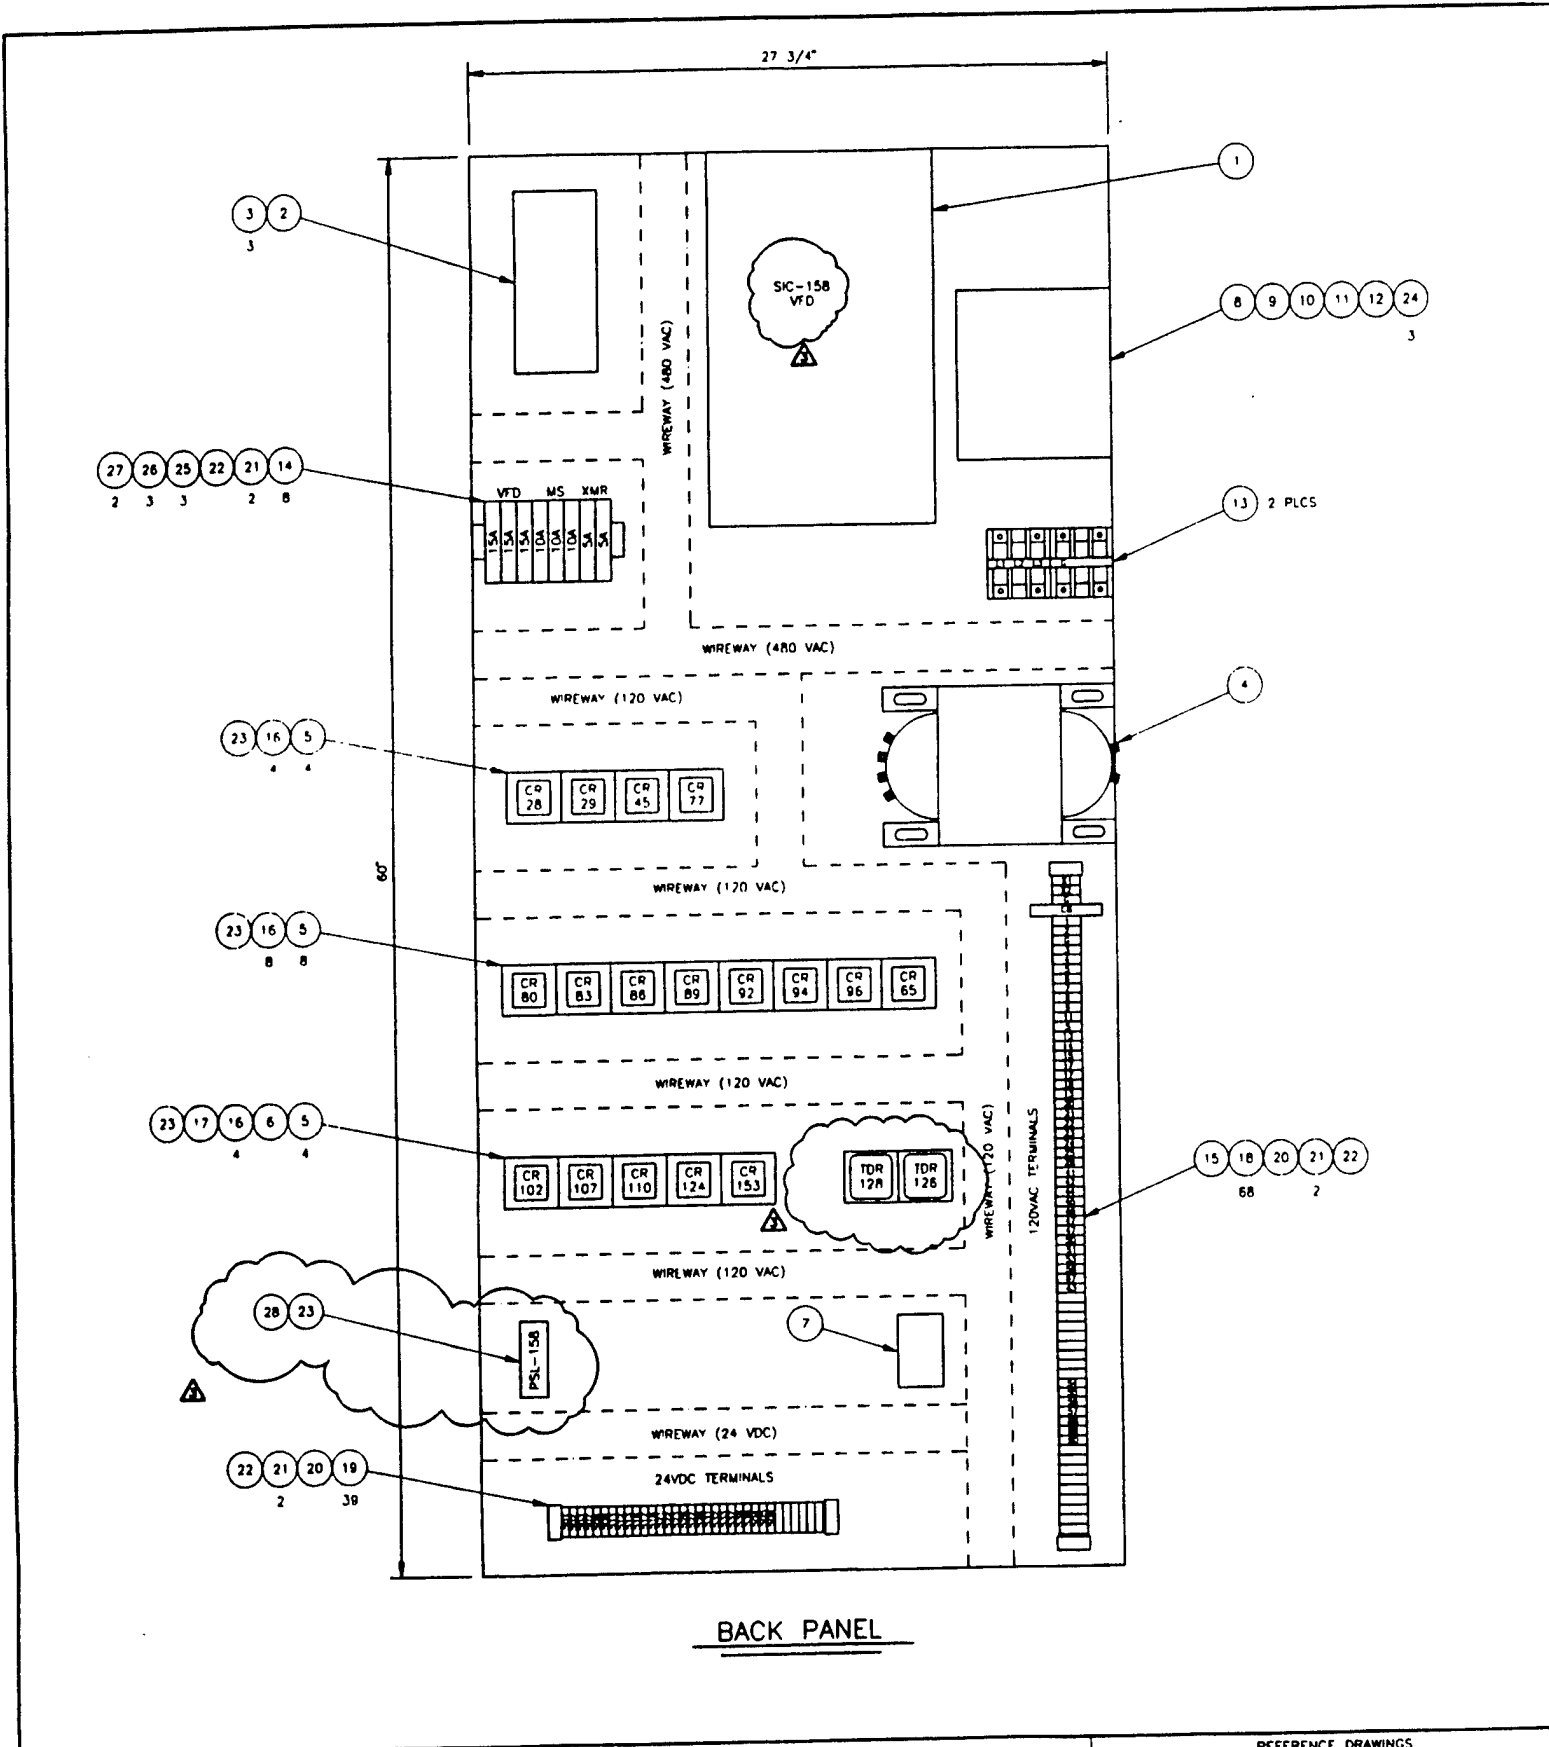

BACK PANEL

GENERAL NOTES

- 1 WIRE TERMINATIONS TO 120 VAC TERMINALS BLOCKS TO BE BY HOOK FORK TYPE CONNECTORS.
- 2 NAMEPLATES TO WHITE PLASTIC LAMINATE WITH BLACK CHARACTERS

REFERENCE DRAWINGS

NUMBER	TITLE
ES120	ELECTRICAL SCHEMATIC
IC120	INTERCONNECTION DIAGRAM
LCP120	LOCAL CONTROL PANEL ASSEMBLY

(1)

BILL OF MATERIAL

ITEM	QTY	DESCRIPTION
1	1	CONTROLLER, AC MOTOR; RELIANCE 2GU41005
2	1	STARTER, MOTOR; ALLEN-BRADLEY 509-AOD-90-90
3	3	ELEMENT, HEATER; ALLEN-BRADLEY W38 (2.51 A)
4	1	TRANSFORMER, CONTROL; ALLEN-BRADLEY 1497-N43
5	1B	RELAY, CONTROL; ALLEN-BRADLEY 700- HA33A1-4
6	2	RELAY, TIME DELAY; ALLEN-BRADLEY 700-HR52TA17
7	1	SUPPLY, POWER; MOORE IND DPS/2400/240MA/UTDIN
8	1	SWITCH, DISCONNECT; ALLEN-BRADLEY 1494V-DS30
9	1	ROD, CONNECTING; ALLEN-BRADLEY 1494V-RA2
10	1	HANDLE, SWITCH; ALLEN-BRADLEY 1494V-H1
11	1	BLOCK, FUSE; ALLEN-BRADLEY 1494V-FS30
12	1	CLIPS, FUSE; ALLEN-BRADLEY 1401-N41
13	2	BLOCK, POWER DISTRIB; ALLEN-BRADLEY 1492-PD3141
14	8	BLOCK, FUSE; ALLEN-BRADLEY 1492-UF8
15	1	BREAKER, CIRCUIT; ALLEN-BRADLEY 1492-GH150 (15 A)
16	20	SOCKET, RELAY; ALLEN-BRADLEY 700-HN126
17	1	SOCKET, RELAY; ALLEN-BRADLEY 700-HN126
18	68	BLOCK, TERMINAL; ALLEN-BRADLEY 1492-F3
19	39	BLOCK, TERMINAL; ALLEN-BRADLEY 1492-F1
20	2	BARRIER, END; ALLEN-BRADLEY 1492-N18
21	6	ANCHOR, END; ALLEN-BRADLEY 1492-N23
22	A/R	RAIL, MOUNTING; ALLEN-BRADLEY 1492-N22
23	A/R	RAIL, MOUNTING; ALLEN-BRADLEY 100-DR1
24	3	FUSE; TYPE H, 30 AMP
25	3	FUSE; 13/32" x 1 1/2", 15 AMP
26	3	FUSE; 13/32" x 1 1/2", 10 AMP
27	2	FUSE; 13/32" x 1 1/2", 5 AMP
28	1	CURRENT SENSING RELAY WIELAND CSR 4-20mA

24
3

⚠

⚠

⚠

REVISIONS				ENGINEERING RECORD			
NO	DESCRIPTION	BY	DATE	CHKD	DATE	SCALE	DATE
0	FOR CONSTRUCTION	JW	3-6-95			3"=1'-0"	
1	REVISED CR-110 & TERM 4.3	JW	4-27-95			JW	1-9-95
2	RECORD	JW	7-6-95				
3	FIELD MODIFICATIONS	CAP	8/1/96	CP	8/16/96		



PREPARED FOR
ROY F. WESTON, INC

REMOTE CONTROL PANEL ASSY
AFTERBURNER

APPROVED _____ DWG. # RCP120-2 REVISION 3

2

INDUCED DRAFT (I.D.) FAN

<u>DRAWING NO.:</u>	<u>REV. NO.:</u>	<u>DRAWING DATE</u>	<u>DRAWING DESCRIPTIO</u>
195978-1 (SHEET 1)	-	11/11/94	DESIGN 16A INDUSTRI ARRANGEMENT NO. 1 & SISW CLASSES II & III FIXED DISCHARGE - SI
195978-1 (SHEET 2)	-	-	DESIGN 16A ACCESSORIES
195978-2	-	11/11/94	INSULATION STUD

①

INDUCED DRAFT (I.D.) FAN

(I.D.) FAN

DRAWING DESCRIPTION


**IGN 16A INDUSTRIAL FANS
ANGEMENT NO. 1 & 9
V CLASSES II & III
ED DISCHARGE - SIZES 11 thru 21**

**IGN 16A
ESSORIES**

ULATION STUD

②

ARRANGEMENT 9 ILLUSTRATED (9L SHOWN, 9R OPP. HAND). ARRANGEMENT 1 SAME AS ILLUSTRATED BUT WITHOUT MOTOR.

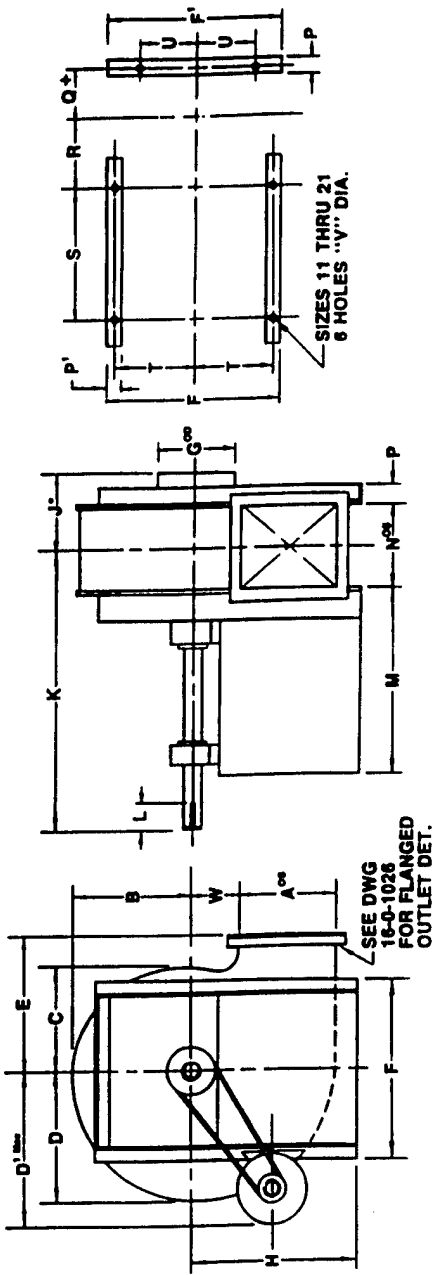

SIDE ELEVATION (drive side) ■ FRONT ELEVATION ▲ FOUNDATION (plan) ▲

DIMENSIONS - INCHES (DOUBLE LETTER DIMENSIONS ARE FOR OVERALL REFERENCE ONLY)

FAN SIZE	WHL DIA.	SHAFT DIA.			KEYWAY SIZE			LS WHEEL * AM WHEEL		J		W		U		T		S		R	
		CL I	CL II	CL III	CL I	CL II	CL III	AA	BB	CC	DD	EE	FF	GG	HH	JJ	KK	LL	MM	NN	Q +
11	19 1/2	1 1/16	1 1/16	1 1/16	3/8 x 3/16	3/8 x 3/16	3/8 x 3/16	8 3/32	7 3/32	6 1/16	4 1/2	7 1/16	7 1/16	7 1/16	7 1/16	7 1/16	7 1/16	7 1/16	7 1/16	7 1/16	7 1/16
13	22 5/8	1 7/16	1 7/16	1 7/16	3/8 x 3/16	3/8 x 3/16	3/8 x 3/16	9 7/32	8 7/32	7 7/16	7 1/16	7 1/16	7 1/16	7 1/16	7 1/16	7 1/16	7 1/16	7 1/16	7 1/16	7 1/16	7 1/16
15	26 1/8	1 5/8	1 5/8	1 5/8	1/2 x 1/4	1/2 x 1/4	1/2 x 1/4	10 1/8	9 1/8	8 1/16	8 3/16	8 3/16	8 3/16	8 3/16	8 3/16	8 3/16	8 3/16	8 3/16	8 3/16	8 3/16	8 3/16
17	29 3/8	1 3/4	1 3/4	1 3/4	1/2 x 1/4	1/2 x 1/4	1/2 x 1/4	11 1/16	10 1/16	9 1/16	9 1/16	9 1/16	9 1/16	9 1/16	9 1/16	9 1/16	9 1/16	9 1/16	9 1/16	9 1/16	9 1/16
19	33	1 7/8	1 7/8	1 7/8	5/8 x 3/8	5/8 x 3/8	5/8 x 3/8	12	11 1/8	10 1/2	10 1/4	10 1/4	10 1/4	10 1/4	10 1/4	10 1/4	10 1/4	10 1/4	10 1/4	10 1/4	10 1/4
21	36 1/2	2 1/16	2 1/16	2 1/16	1/2 x 1/4	1/2 x 1/4	1/2 x 1/4	14 1/32	13 1/32	11 1/8	11 1/4	11 1/4	11 1/4	11 1/4	11 1/4	11 1/4	11 1/4	11 1/4	11 1/4	11 1/4	11 1/4

+ FOR TYPE "C" SPARK RESISTANT CONSTRUCTION 200°F. AND ABOVE, ADD 3/8" TO DIMENSIONS SHOWN.

FAN SIZE	FRAME 143-145		FRAME 182-184		FRAME 213-215		FRAME 254-256		FRAME 284-286		FRAME 324-326		FRAME 364-365	
	MIN.	MAX.	MIN.	MAX.	MIN.	MAX.	MIN.	MAX.	MIN.	MAX.	MIN.	MAX.	MIN.	MAX.
11	18.7	21	19.6	21.8	20.2	22.3	21	23.7	21.4	24.4	22.4	25.7	23	26.7
13	17.2	19.2	18.5	20.1	18.5	21	19.3	22	19.8	22.8	20.8	24.4	22.8	26.7
15	15.8	17.8	16.5	18.5	16.5	19	17.3	20	17.8	20.8	20.8	24.4	22.8	26.7
17	14.7	16.8	15.8	17.8	15.8	18.6	17.3	20	17.8	20.8	20.8	24.4	22.8	26.7

ARRANGEMENT 9 DRIVE CENTERS

FAN SIZE	FRAME 56		FRAME 143-145		FRAME 182-184		FRAME 213-215		FRAME 254-256		FRAME 284-286		FRAME 324-326		FRAME 364-365	
	MIN.	MAX.	MIN.	MAX.	MIN.	MAX.	MIN.	MAX.	MIN.	MAX.	MIN.	MAX.	MIN.	MAX.	MIN.	MAX.
11	14.7	16.8	14.7	16.8	15.8	17.8	16.5	18.6	17.3	20	17.8	20.8	20.8	24.4	22.8	26.7
13	15	17.2	15	17.2	16	18.1	16.5	19	17.3	20	17.8	20.8	20.8	24.4	22.8	26.7
15	17	19.2	17	19.2	18	20.1	18.5	21	19.3	22	19.8	22.8	20.8	24.4	22.8	26.7
17	18.7	21	18.7	21	19.6	21.8	20.2	22.3	21	23.7	21.4	24.4	22.4	25.7	23	26.7

MAXIMUM MOTOR

FAN SIZE	U-FRAMES		TEFC		TEFC	
	ODP	TEFC	ODP	TEFC	ODP	TEFC
11	215T	215	215	215	215	215
13	256T	286U	286U	286U	286U	286U
15	284T	286U	286U	286U	286U	286U
17	324T	364U	364U	364U	364U	364U

FAN SIZE	R	S	T	U	V	W	J	AA	BB	CC	DD	EE	FF	GG	HH	JJ	KK	LL	MM	NN
13	22%	17%	11%	4 1/2	9/16	6 1/16	8 3/32	30 3/16	34 1/16	38%	33%	32%	35	30 1/4	43 1/2	38%	36 1/2	35 1/16	35%	31%
15	26%	19%	11%	7 1/16	9/16	7 3/16	9 7/32	36%	40 1/16	45 1/4	39%	38%	40 7/16	35 3/4	50 1/16	44%	42 1/2	41 1/16	40%	36%
17	29%	19%	8 3/16	8 3/16	9/16	8 5/16	10 10/32	41 9/16	45 9/16	51%	44%	43%	45 7/8	41	57 1/4	50%	48%	47 1/16	46 1/2	42%
19	33	23%	9 9/16	9 9/16	9/16	9%	11 1/16	48 7/16	51 1/16	58 3/16	50	49%	51 1/4	46 1/4	64 1/16	56%	54 1/4	53%	52%	47%
21	36 1/2	23%	10 1/4	10 1/4	9/16	10 1/2	12	51 9/16	56 1/2	64 9/16	55 1/16	54%	56 1/16	51%	70 7/8	62 1/4	60 1/16	58%	57 1/16	53%
			11 1/4	11 1/4	9/16	11 1/2	14 1/32	58 13/16	62 1/16	71%	60%	60%	62 1/8	56 3/4	77%	68 3/8	66	64 1/16	63%	58%

FOR TYPE "C" SPARK RESISTANT CONSTRUCTION 200°F. AND ABOVE, ADD 3/8" TO DIMENSIONS SHOWN.

FAN SIZE	LS WHEEL AM WHEEL		LS WHEEL AM WHEEL		LS WHEEL AM WHEEL		LS WHEEL AM WHEEL		LS WHEEL AM WHEEL		LS WHEEL AM WHEEL		LS WHEEL AM WHEEL		LS WHEEL AM WHEEL		LS WHEEL AM WHEEL		LS WHEEL AM WHEEL		LS WHEEL AM WHEEL	
	J	J	J	J	J	J	J	J	J	J	J	J	J	J	J	J	J	J	J	J	J	J
11	7 3/32	7 3/32	7 3/32	7 3/32	7 3/32	7 3/32	7 3/32	7 3/32	7 3/32	7 3/32	7 3/32	7 3/32	7 3/32	7 3/32	7 3/32	7 3/32	7 3/32	7 3/32	7 3/32	7 3/32	7 3/32	7 3/32
13	8 3/32	8 3/32	8 3/32	8 3/32	8 3/32	8 3/32	8 3/32	8 3/32	8 3/32	8 3/32	8 3/32	8 3/32	8 3/32	8 3/32	8 3/32	8 3/32	8 3/32	8 3/32	8 3/32	8 3/32	8 3/32	8 3/32
15	9 7/32	9 7/32	9 7/32	9 7/32	9 7/32	9 7/32	9 7/32	9 7/32	9 7/32	9 7/32	9 7/32	9 7/32	9 7/32	9 7/32	9 7/32	9 7/32	9 7/32	9 7/32	9 7/32	9 7/32	9 7/32	9 7/32
17	10 10/32	10 10/32	19	11 11/32	11 11/32	21	12 12/32	12 12/32	
FAN SIZE	T-FRAMES		U-FRAMES		FRAME 56		FRAME 143-145		FRAME 182-184		FRAME 213-215		FRAME 254-256		FRAME 284-286		FRAME 324-326		FRAME 364-365	
	ODP	TEFC	ODP	TEFC	MIN.	MAX.	MIN.	MAX.	MIN.	MAX.	MIN.	MAX.	MIN.	MAX.	MIN.	MAX.	MIN.	MAX.	MIN.	MAX.
11	215T	215	215	215	14.7	16.8	14.7	16.8	15.8	17.8	16.5	18.6								
13	256T	286U	286U	286U	15	17.2	15	17.2	16	18.1	16.5	19	17.3	20	17.8	20.8				
15	284T	286U	286U	286U	17	19.2	17	19.2	18	20.1	18.5	21	19.3	22	19.8	22.8				
17	324T	364U	364U	364U	18.7	21	18.7	21	19.6	21.8	20.2	22.3	21	23.7	21.4	24.4	22.4	25.7	23	26.7
19	326T	365U	365U	365U	20.6	22.9	20.6	22.9	21.5	23.7	22	24.6	22.9	25.6	23.3	26.3	24.1	27.6	24.8	28.6
21	326T	365U	365U	365U	22.8	25.1	22.8	25.1	23.6	25.9	24.2	26.7	24.9	27.8	25.3	28.4	26.5	29.9	26.8	30.7

ITEM NO.	IDENTIFICATION	ARRGT	NO. REQ'D	FAN SIZE	FIG. NO.	WHL. TYPE	CL	PERFORMANCE				MOTOR DATA								
								C.F.M.	O.V.	S.P.	R.P.M.	B.H.P.	TEMP.	ELEV.	H.P.	R.P.M.	CURRENT	FRAME	TYPE	
1	SN195978	9SR	1	13	5	LS	3	2250	2445	2.5	1545	1.39	650	5	1800	3/60/460	184T	TEFC	XP	
	Tag: Arrtech Job IJ-120							Den.	.027	Elev.	up to 7000'									Severe Duty

ITEM NO.	SLIDE BASE 7-2-94	DRIVE DATA		MOTOR POS.	VIBR. BASE TYPE	PADS TYPE	OPTIONAL ACCESS.	OPTIONAL ACCESSORIES	
		MTR PULLEY/FAN PULLEY	BELTS					CENTER	TYPE
1	7			9SR			A, E, D, L, Q, H		A = FLANGED INLET #16-0-1026 B = PUNCHED UNPUNCHED □ C = CLEANOUT DOOR - BOLTED #16-0-1026 D = CLEANOUT DOOR - QUICK CLAMP #16-0-1026 E = DRAIN OPENING #16-0-1026 w/plug F = SPECIAL FINISH - SEE NOTES G = SHAFT SEAL H = SPARK RESIST. CONST. C J = OUTLET DAMPER #16-0-1046 K = HEAVY DUTY HOUSING L = COOLING WHEEL M = INLET SCREEN N = HEAVY DUTY L.S. WHEEL P = BELT GUARD Q = SHAFT/BEARING GUARD R = EXT. GREASE FITTINGS S = MOUNT MOTOR & DRIVES T = INLET BOX #16-0-1061 U = INLET BOX DAMPER #16-0-1062 W = Insulation #16-0-1064

NOTES

Dwg. 16-0-1026 must accompany customer dwg.

Flanged outlet is not std. on DB & BAD units. When flanged outlet (punched) is required on DB (Fig. 7 & 17) or BAD (Fig. 8 & 18) units, See Dwg. 16-0-1027 for

CUSTOMER Arrtech Environmental Systems
Tulsa, Ok. P.O.# IJ120-0023

A	FLANGED INLET #16-0-1026	FLANGED INLET #16-0-1026
B	PUNCHED <input type="checkbox"/> UNPUNCHED <input type="checkbox"/>	PUNCHED <input type="checkbox"/> UNPUNCHED <input type="checkbox"/>
C	CLEANOUT DOOR - BOLTED #16-0-1026	CLEANOUT DOOR - QUICK CLAMP
D	CLEANOUT DOOR - PLUG TYPE @9:00	CLEANOUT DOOR - PLUG TYPE @9:00
E	DRAIN OPENING #16-0-1026 w/plug	DRAIN OPENING #16-0-1026 w/plug
F	SPECIAL FINISH - SEE NOTES	SPECIAL FINISH - SEE NOTES
G	SHAFT SEAL	SHAFT SEAL
H	SPARK RESIST. CONST. 'C'	SPARK RESIST. CONST. 'C'
J	OUTLET DAMPER #16-0-1046	OUTLET DAMPER #16-0-1046

NO.	BASE TYPE	POS.	CENTER	BELTS	PULLEY/FAN	ACCESS.
1	7	9SR				A, E, D, L, Q, H
						R, G, S, P, W, F

NOTES

- Dwg. 16-0-1026 must accompany customer dwg.
- ⊗ Flanged outlet is not std. on DB & BAD units. When flanged outlet (punched) is required on DB (Fig. 7 & 17) or BAD (Fig. 8 & 18) units, See Dwg. 16-0-1027 for details of outlet flange extension.
- ▲ When vibration or unitary base is furnished disregard foundation plan shown above and refer to vibration or unitary base Dwg.
Refer to order acknowledgment for shipping details.
Special hi temp, silicon aluminum on pedestal only.
CBC to furnish motor, belt guard, c/s drive and variable speed drive for motor.

* WHEEL TYPES: LS = Long Shavings, AM = Air Material

CUSTOMER Arrtech Environmental Systems
 Tulsa, Ok. P.O.# IJ120-0023

JOB NAME _____

LOCATION _____

ARCH./ENGINEER _____ **CITY** _____




DESIGN 16A INDUSTRIAL FANS
ARRANGEMENT NO. 1 & 9 SISW CLASSES II & III
FIXED DISCHARGE - SIZES 11 THRU 21

CHICAGO BLOWER CORPORATION
 1675 GLEN ELLYN ROAD, GLENDALE HEIGHTS, IL 60139

FURNISHED FOR SALES PURPOSE - DIMENSIONS NOT CERTIFIED BY CBC	DATE	SUBMITTED BY	SALES OFFICE
DRAWING CERTIFIED BY CBC - FURNISHED FOR APPROVAL - NOT RELEASED FOR PRODUCTION	DATE	CBC ENGINEER	SO#
DRAWING CERTIFIED BY CBC - APPROVAL NOT REQUIRED - RELEASED FOR PRODUCTION	DATE	CBC ENGINEER	DWG #
	11/11/94	HS/JC	195978-1

DIMENSION TOLERANCES ± 1/8 - DO NOT USE FOR GENERAL CONSTRUCTION UNLESS CERTIFIED BY C.B.C. ENG. DEPT.

Note: Outlet Flange is furnished as Std. on all D/16A Fans.

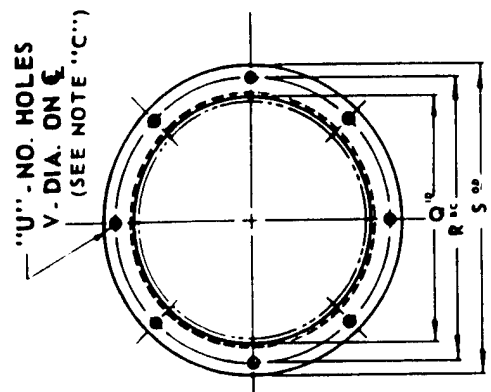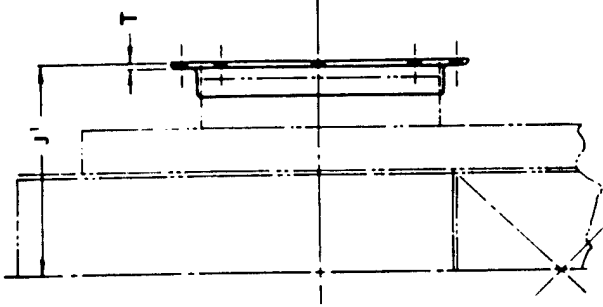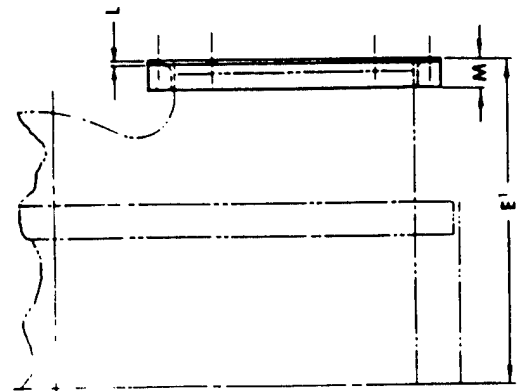

OUTLET FLANGE PUNCHING

All Sizes Except DB & BAD Sizes 23 - 45
See 16-0-1021 (BAD), 16-0-1022 (DB)


FAN SIZE	OUTLET FLANGE (DIMENSIONS — INCHES)														INLET FLANGE (DIM. — INCHES)									
	A	B	C	D	E	E'	F	G	H	J	K	L	M	N	P	LS	J'	AM	Q	R	S'	T GA.	U	V
11	10-5/8	12-3/8	13-5/8	11-1/16	12-5/16	15	4-3/16	10	5-17/32	0	1	3/16	1-1/2	9-5/16	1/2	8-19/32	NA	11-1/8	12-1/2	13-5/8	1/8	8	3/8	
13	12-5/8	14-3/8	15-5/8	12-13/16	14-1/16	17-7/16	5-3/16	12	4-13/32	1	1	1/2	1-1/2	11-1/16	1/2	9-23/32	1/2	13-3/16	14-13/16	16-3/16	1/8	12	7/16	
15	14-1/2	16-1/4	17-1/2	14-1/2	15-3/4	19-7/8	4-1/8	14	5-1/4	1	2	1/2	1-1/2	12-3/4	1/2	10-5/8	1/2	15-3/16	16-13/16	18-3/16	1/8	16	1/2	
17	16-7/16	18-3/16	19-7/16	16-1/8	17-3/8	22-1/4	5-3/32	16	4-11/16	2	2	1/2	1-1/2	14-3/8	1/2	11-9/16	1/2	17-3/16	19-1/8	20-3/16	3/16	16	1/2	
19	18-1/4	20	21-1/4	17-3/4	19	24-11/16	4	18	4-7/8	2	3	1/2	1-1/2	16	1/2	12-1/2	1/2	19-3/16	21-1/8	22-3/16	1/2	16	1/2	
21	20-3/16	21-15/16	23-3/16	19-7/16	20-11/16	27-1/8	4-31/32	20	3-23/32	3	3	1/2	1-1/2	17-11/16	1/2	14-17/32	1/2	21-3/16	23-1/8	24-3/16	1/2	20	1/2	
23	22-1/8	24-3/8	26-1/8	21-9/16	23-5/16	30-1/8	4-3/16	22	4-25/32	3	4	1/2	2	19-5/16	5/8	16-5/32	1/2	23-3/16	25-1/8	26-3/16	1/2	20	7/16	
26	24-15/16	27-3/16	28-15/16	24-7/16	26-3/16	33-11/16	5-19/32	24	4-7/32	4	4	1/2	1-1/2	22-3/16	1/2	17-23/32	1/2	26-3/16	28-1/2	30-3/16	1/2	24	9/16	
29	27-3/4	30	31-3/4	26-3/4	28-1/2	37-1/2	5	26	5-3/8	4	5	1/2	1-1/2	24-1/2	1/2	18-23/32	1/2	29-3/16	31-1/2	33-3/16	1/2	24	1/2	
33	31-3/4	34	35-3/4	29-15/16	31-11/16	42-7/16	5	30	4-31/32	5	6	1/2	1-1/2	27-11/16	1/2	20-13/32	1/2	33-3/16	35-3/8	37-3/16	1/2	16	9/16	

NOTE D



13	12-5/8	14-3/8	15-5/8	12-13/16	14-1/16	17-7/16	5-3/16	12	4-13/32	1	1	11-1/16	9-23/32	13-3/16	14-13/16	16-3/16	1/8	12	7/16
15	14-1/2	16-1/4	17-1/2	14-1/2	15-3/4	19-7/8	4-1/8	14	5-1/4	1	2	12-3/4	10-5/8	15-3/16	16-13/16	18-3/16	1/8	16	1/8
17	16-7/16	18-3/16	19-7/16	16-1/8	17-3/8	22-1/4	5-3/32	16	4-1/16	2	2	14-3/8	11-9/16	17-3/16	19-1/8	20-3/16	3/16	16	16
19	18-1/4	20	21-1/4	17-3/4	19	24-11/16	4	18	4-7/8	2	3	16	12-1/2	19-3/16	21-1/8	22-3/16	1/8	16	16
21	20-3/16	21-15/16	23-3/16	19-7/16	20-11/16	27-1/8	4-31/32	20	3-23/32	3	3	17-11/16	14-17/32	21-3/16	23-1/8	24-3/16	1/8	20	20
23	22-1/8	24-3/8	26-1/8	21-9/16	23-5/16	30-1/8	4-3/16	22	4-25/32	3	4	19-5/16	16-5/32	23-3/16	25-1/8	26-3/16	3/16	20	7/16
26	24-15/16	27-3/16	28-15/16	24-7/16	26-3/16	33-11/16	5-19/32	24	4-7/32	4	4	22-3/16	17-23/32	26-3/16	28-1/2	30-3/16	3/16	24	9/16
29	27-3/4	30	31-3/4	26-3/4	28-1/2	37-1/2	5	26	5-3/8	4	5	24-1/2	18-23/32	29-3/16	31-1/2	33-3/16	3/16	24	24
33	31-3/4	34	35-3/4	29-15/16	31-11/16	42-7/16	5	30	4-31/32	5	6	27-11/16	20-13/32	33-3/16	35-3/8	37-3/16	3/16	16	9/16
37	35-1/2	37-3/4	39-1/2	33-1/4	35	47-5/16	4-7/8	34	4-5/8	6	7	31	23-11/16	37-3/16	39-1/2	41-3/16	1/8	16	5/8
41	39-1/4	42	44-1/4	37-1/4	39-1/2	52-9/16	5	38	4-5/8	7	8	34-1/2	25	41-3/16	43-7/8	45-3/16	3/16	16	3/4
45	43-1/16	45-13/16	48-1/16	40-1/2	42-3/4	57-1/2	4-29/32	42	4-1/4	8	9	37-3/4	—	45-3/16	47-7/8	49-3/16	3/16	16	3/4

CLEANOUT DOORS

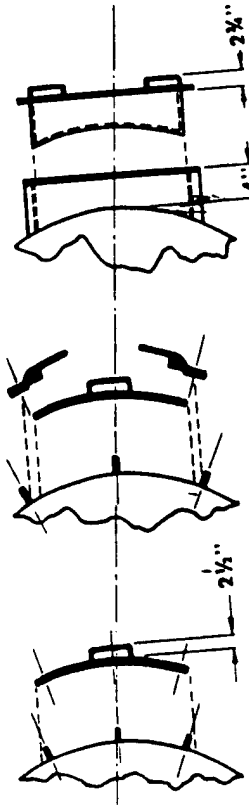


BOLTED TYPE CLAMP TYPE PLUG TYPE

Cleanout door locations must be specified on order by "o'clock" position. These locations are as viewed from drive side and doors are symmetrical on o'clock center-line.

On units with horizontal split housings 3:00 and 9:00 o'clock positions are prohibited.

- NOTES:
- A. OUTLET FLANGES ARE FURNISHED PUNCHED AS STANDARD
 - B. INLET FLANGES ARE FURNISHED PUNCHED AS STANDARD
 - C. FOR TYPE 'C' SPARK RESIST. CONSTRUCTION USE VALUES

DRAIN OPENING

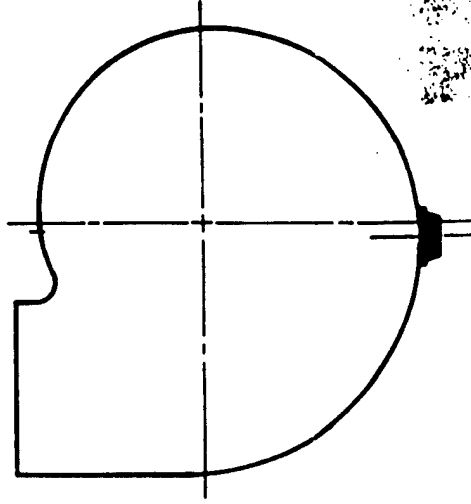

DRAIN CONNECTION IS 1 1/2" NPT HALF COUPLING AND IS LOCATED AT LOWEST POINT ON SCROLL.

FAN SIZE	SIZE OPENING		PLUG TYPE
	BOLTED TYPE	CLAMP TYPE	
11, 13,	6 x 10	6 x 10	8
15	10 x 10	10 x 10	8
17	10 x 10	10 x 10	12
19	10 x 10	10 x 10	12
21	10 x 10	10 x 10	12
23	14 x 14	10 x 10	12
26	14 x 14	10 x 16	18
29	14 x 14	16 x 16	22
33	20 x 20	16 x 16	22
37, 41, 45	20 x 20	22 x 22	22



BOLTED TYPE CLAMP TYPE PLUG TYPE

Cleanout door locations must be specified on order by "o'clock" position. These locations are as viewed from drive side and doors are symmetrical on o'clock center-line.


On units with horizontal split housings 3:00 and 9:00 o'clock positions are prohibited.

17	10 x 10	10 x 10	10 x 10	12
19	10 x 10	10 x 10	10 x 10	12
21	10 x 10	10 x 10	10 x 10	12
23	14 x 14	10 x 10	10 x 10	12
26	14 x 14	10 x 16	10 x 16	18
29	14 x 14	16 x 16	16 x 16	22
33	20 x 20	16 x 16	16 x 16	22
37, 41, 45	20 x 20	22 x 22	22 x 22	22

NOTES:

- A. OUTLET FLANGES ARE FURNISHED PUNCHED AS STANDARD
 - B. INLET FLANGES ARE FURNISHED PUNCHED AS STANDARD
 - C. FOR TYPE 'C' SPARK RESIST. CONSTRUCTION USE VALUES FOR TYPE L.S. WHEEL
 - D. FOR TYPE 'C' SPARK RESISTANT CONSTRUCTION AT 200° F AND ABOVE, ADD 3/8" TO DIMENSION SHOWN.
- FAN SIZES 11-15 ONLY

DRAIN CONNECTION IS 1 1/2" NPT HALF COUPLING AND IS LOCATED AT LOWEST POINT ON SCROLL.

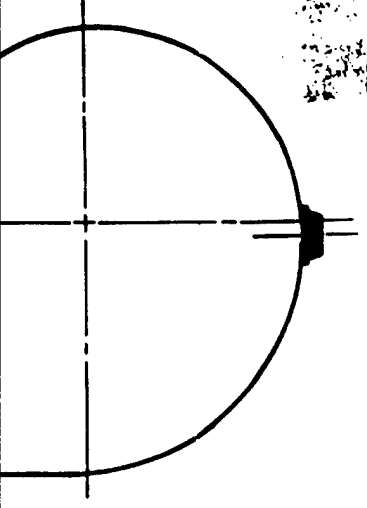

DESIGN 16A ACCESSORIES




1675 GLEN ELLYN ROAD, GLENDALE HEIGHTS, IL 60139

DIMENSION TOLERANCE ± 1/8

16-0-1026S

30

LISC.	
SOAP	
BY	
FIG	
GEN	
FIG	
ENG	
CAU	
AUG	
	NO.
CUST	
AGNT	
ENGR	
SALE	
DRN	
PROD	
COST	
INSP	
STAR	
LAY	
BR	
WELD	
CHWL	
EAL	
MCHN	
TRVL	
AWL	
VANE	
ASBN	
FISH	
SHIP	
FARM	

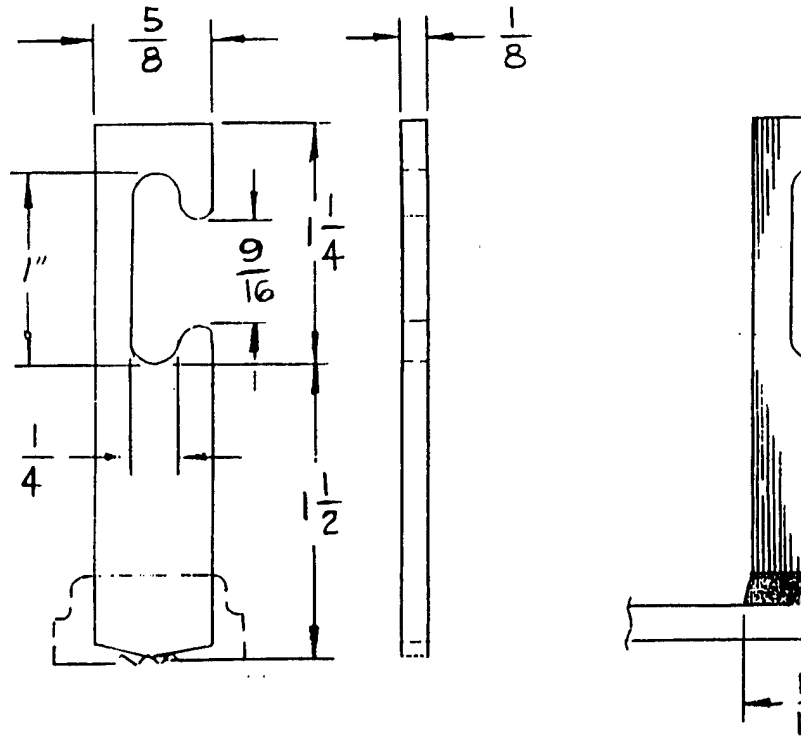

INSULATI



CHI
1675 GLEN EL


CUSTOMER	Arrtech Environmental Systems	
	Tulsa, Ok.	P.O. # IJ120-0023
JOB NAME		
LOCATION		
ARCH. ENGINEER	CITY	

FURNISHED FOR SALES PURPOSES-DIMENSIONS NOT CERTIFIED BY CBC

DRAWING CERTIFIED BY CBC - FURNISHED FOR APPROVAL - NOT RELEASED FOR PRODUCTION

DRAWING CERTIFIED BY CBC - APPROVAL NOT REQUIRED - RELEASED FOR PRODUCTION



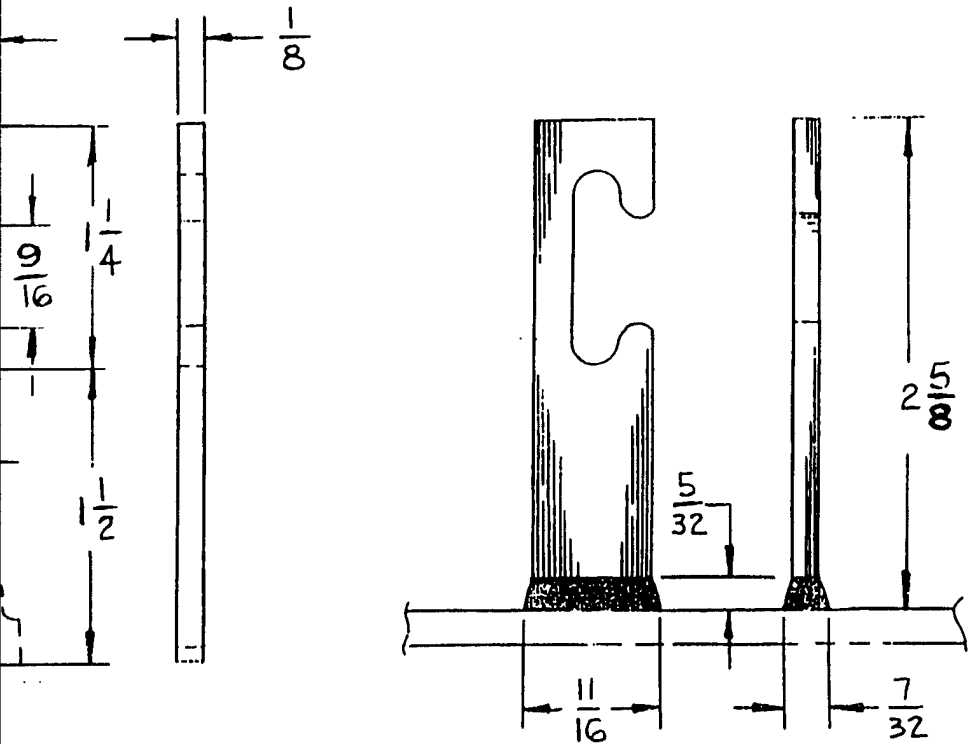

INSULATION STUD



CHICAGO BLOWER CORPORATION
 1675 GLEN ELLYN ROAD, GLENDALE HEIGHTS, ILL. 60137
 PHONE A C 312 858-2600

IJ120-0023 DRAWING CERTIFIED BY CDC - APPROVAL NOT REQUIRED - RELEASED FOR PRODUCTION	DATE 11/11/94	SUBMITTED BY HS/jc	SALES OFFICE 195978-2
	DATE 11/11/94	CDC ENGINEER HS/jc	DWG. NO. 195978-2
	DATE 11/11/94	CDC ENGINEER HS/jc	DWG. NO. 195978-2

2

PROPANE DELIVERY SYSTEM

<u>DRAWING NO.:</u>	<u>REV. NO.:</u>	<u>DRAWING DATE</u>	<u>DRAWING DESCRI</u>
9508-112 (SHEET 1)	1	10/13/95	SITE PLAN
9508-112 (SHEET 2)	-	2/27/95	PIPING DIAGRAM
9508-112 (SHEET 3)	-	9/18/95	BILL OF MATERIA

①

PROPANE DELIVERY SYSTEM DRAWINGS

PROPANE DELIVERY SYSTEM DRAWINGS

DRAWING DESCRIPTION

- SITE PLAN**
- PIPING DIAGRAM**
- BILL OF MATERIALS & GENERAL NOTES**

②

Suburban Propane

WHIPPANY

ROY WESTON, INC. - WEST CHESTER, PA.
ALABAMA ARMY AMMUNITION PLANT - ALPINE, AL.

<u>DRAWING</u>	<u>NUMBER</u>	<u>SHEET</u>	<u>REV.</u>
SITE PLAN	9508-112	1	OF 3
PIPING DIAGRAM	9508-112	2	OF 3
BILL OF MATERIAL & GENERAL NOTES	9508-112	3	OF 3

①

**ban
ane**


NEW JERSEY

**ESTER, PA.
T - ALPINE, AL.**

NUMBER SHEET REV.

**9-112 1 OF 3
9-112 2 OF 3
9-112 3 OF 3**


2

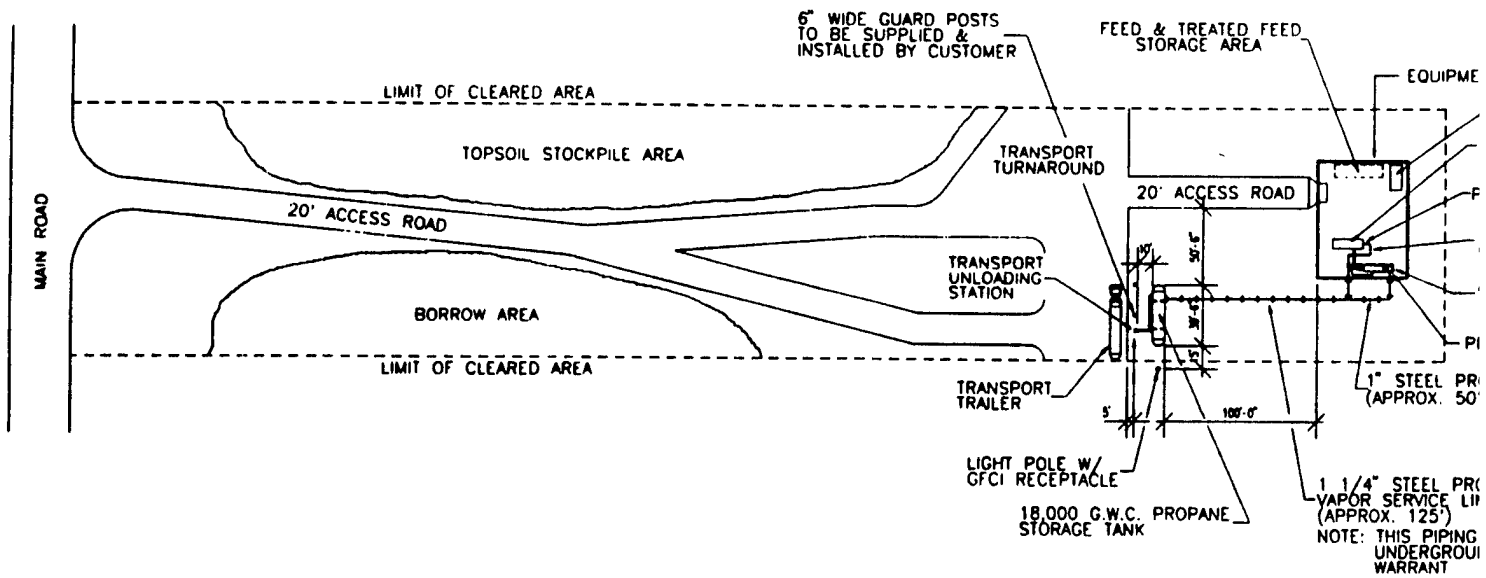

SITE PLAN

SCALE: 1" = 60'-0"


1

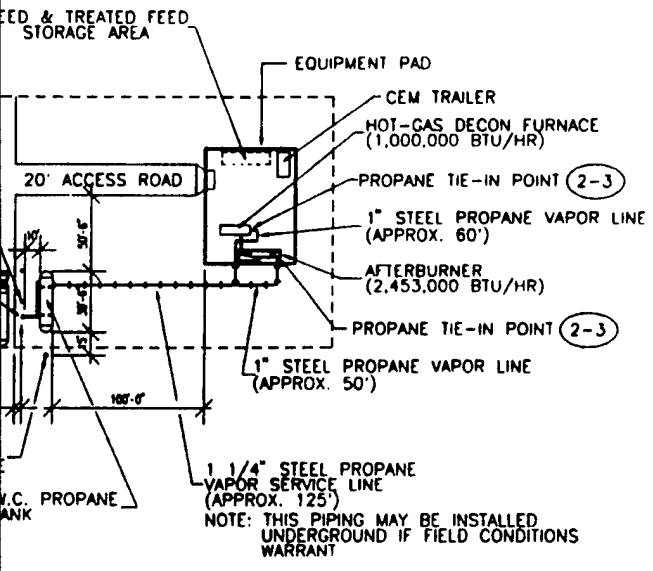


2

Suburban Propane


SUBURBAN PROPANE - WHIPPANY, N.J. SITE PLAN ROY WESTON, INC. - WEST CHESTER, PA. ALABAMA ARMY AMMUNITION PLANT - ALPINE, AL	J. YAPACIA DATE: 9-15-88 SCALE: 1" = 80'-0" DRAWN BY: [unclear]	DWG. NO. 9508-112 Sheet 1 of 3	COMMENTS 1. 80/3/RE/PT REVISION PER ROY WESTON, INC. (MU HISTORY) COMMENTS
--	--	--------------------------------	---

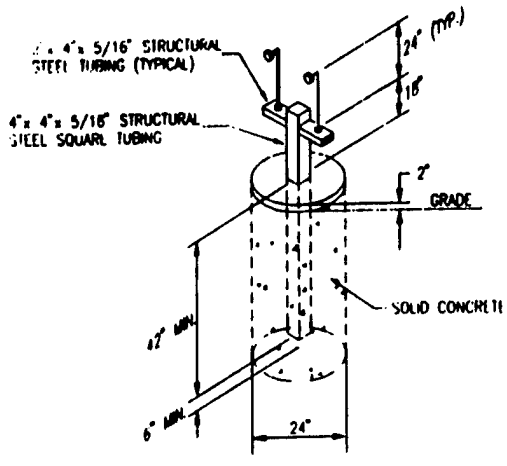

BREAKAWAY STANCHION DETAIL
SCALE: NONE

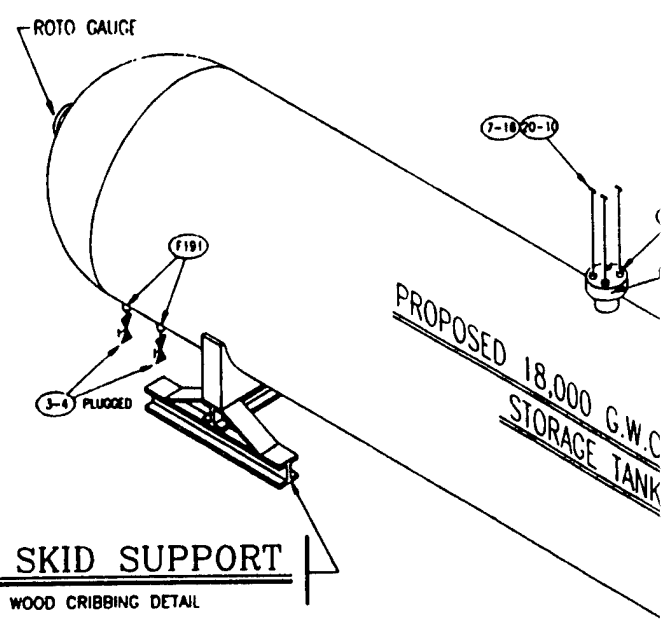


TANK SKID SUPPORT
SEE WOOD CRIBBING DETAIL

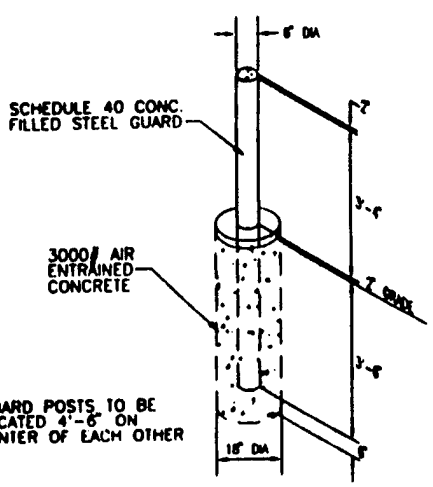

NOTE: GUARD POSTS TO BE LOCATED 4'-6\"/>

TYP. 6\"/>

SCALE: NONE
NOTE: CUSTOMER TO SUPPLY & INSTALL GUARD POSTS IF REQUIRED

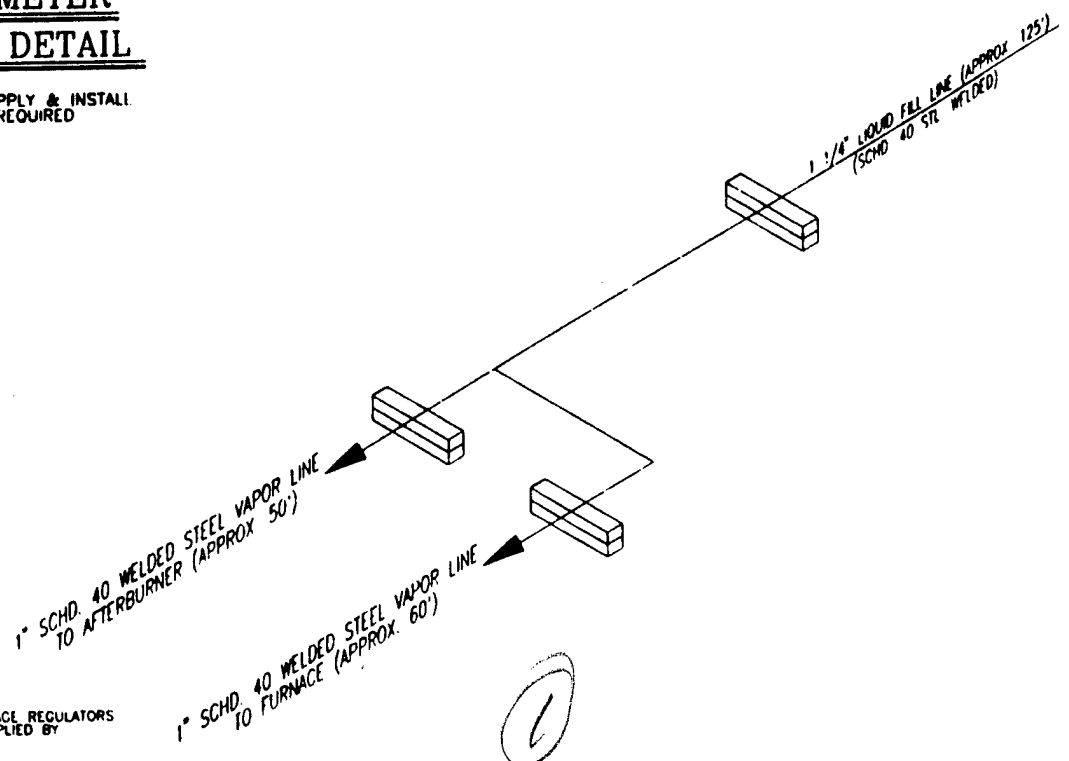


NOTE: SECOND STAGE REGULATORS TO BE SUPPLIED BY CUSTOMER




(8) 8" x 8" x 10' WOOD CRIBBING
(16 REQUIRED)

STEEL TANK SKID
1-BEAM CONSTRUCTION
(2 SETS REQUIRED)

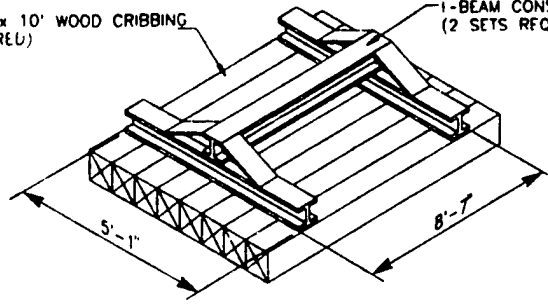

WOOD CRIBBING DETAIL

SCALE: NONE

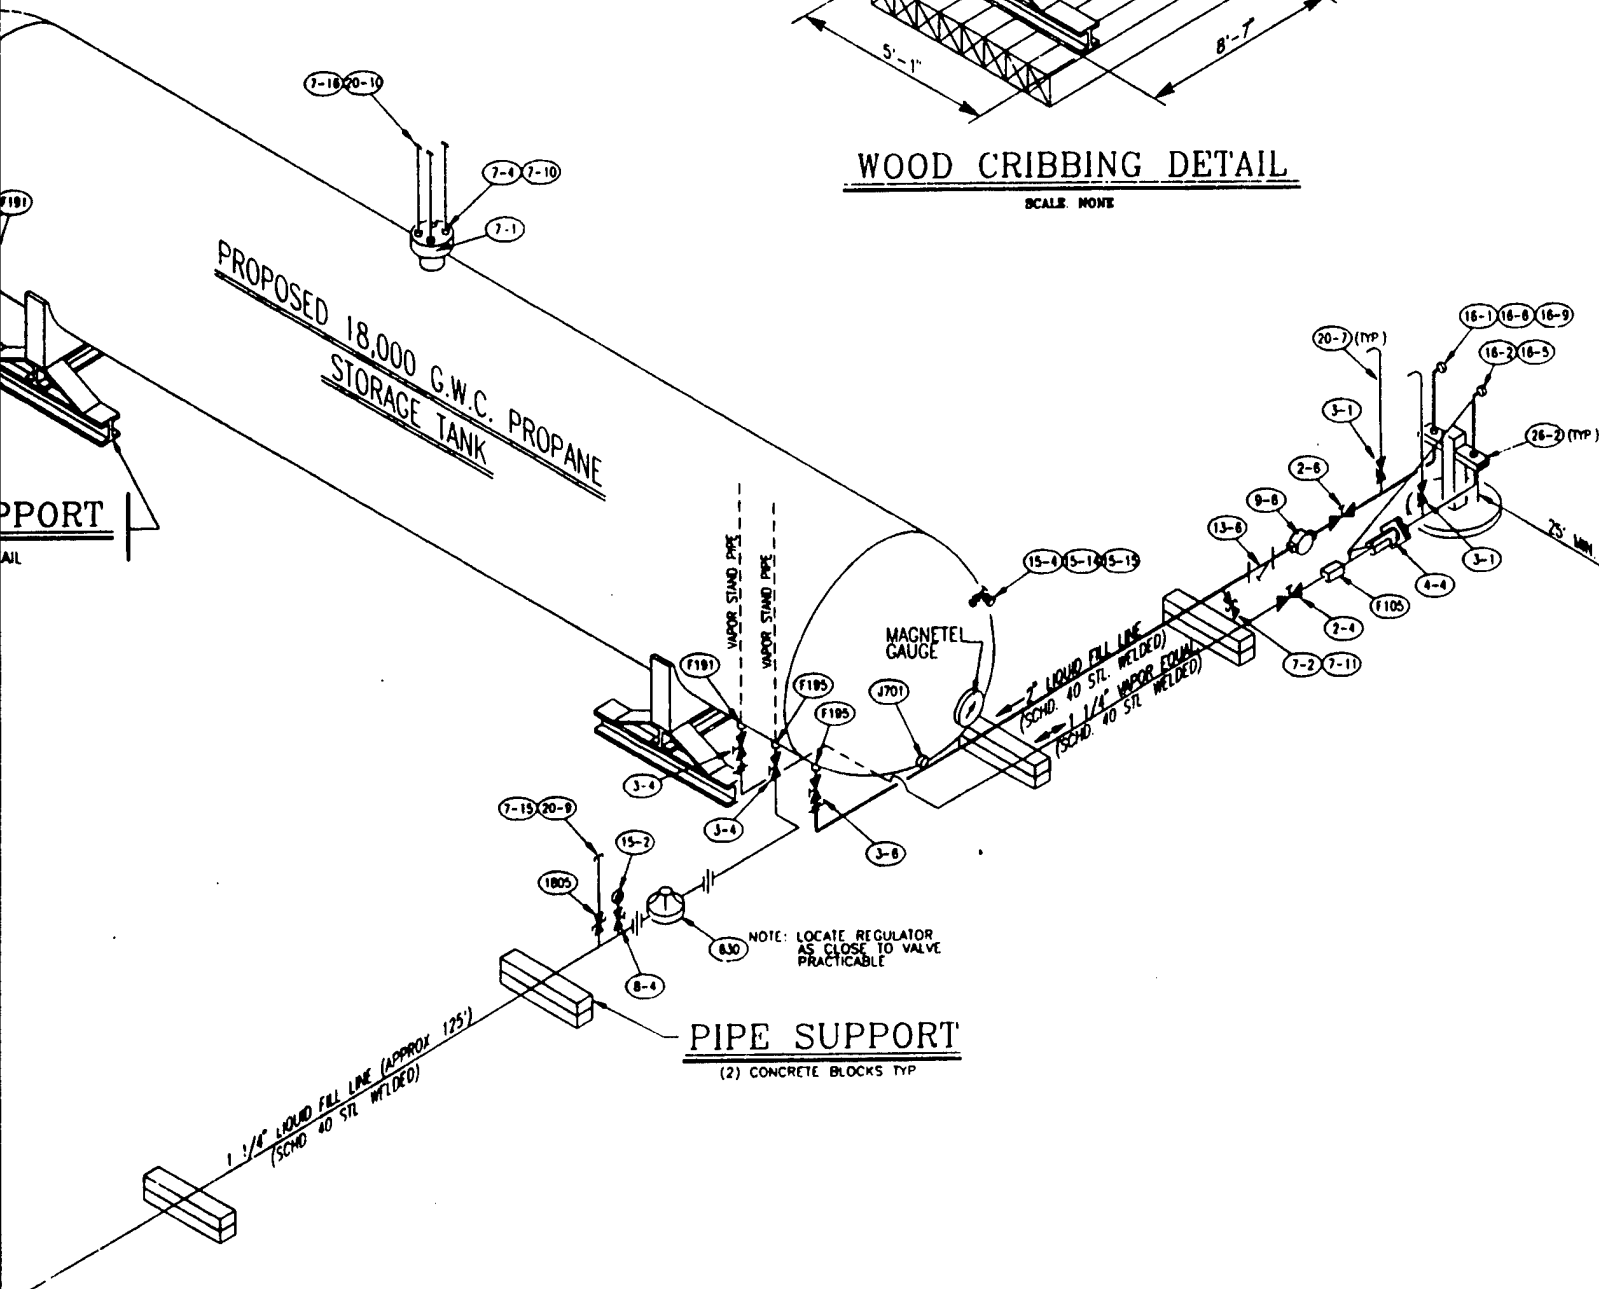

PIPE SUPPORT
(2) CONCRETE BLOCKS TYP

PIPING DIAGRAM


SCALE: NONE

NOTES

- 1) FOR ACTUAL LOCATION OF PROPANE STORAGE TANK, VAPORIZERS & TRANSPORT UNLOADING RISER SEE SITE PLAN DRAWING NO 9508-112 SHEET 1 OF 3
- 2) SEE BILL OF MATERIALS DRWG NO 9508-112 SH. 3 OF 3 FOR ALL MATERIAL SPECIFICATIONS & GENERAL NOTES


2

STEEL TANK SKID
 1-BEAM CONSTRUCTION
 (2 SETS REQUIRED)

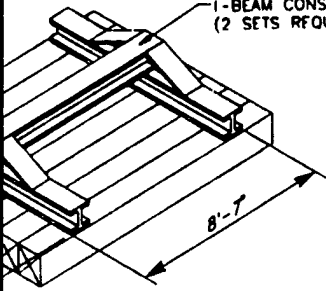


RIBBING DETAIL

SCALE: NONE

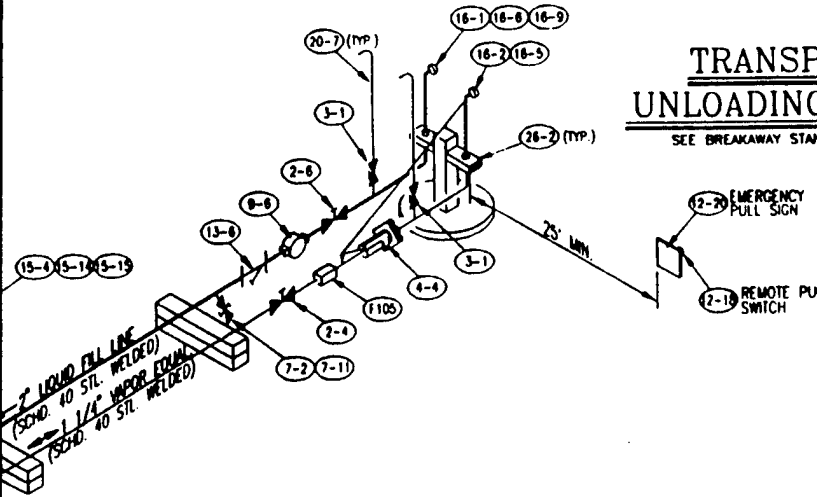

**TRANSP
 UNLOADING**

SEE BREAKAWAY STAMP

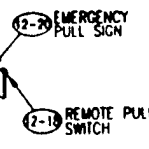

3

SUBURBAN PROPANE - WHIPPANY, N.J.		DATE	2-27-63
PIPING DIAGRAM		SCALE	1/2" = 1'
ROY WESTON, INC. - WEST CHESTER, PA.		DRAWN BY	CR/CRD
ALABAMA ARMY AMMUNITION PLANT - ALPINE, AL.		NOT TO BE USED FOR ANY OTHER PROJECT WITHOUT THE WRITTEN PERMISSION OF THE ENGINEER.	
DWG. NO. 9508-112		Sheet 2 of 3	

STEEL PIPE - GENERAL NOTES:

1) PIPE SPECIFICATIONS:

- BLACK WELDED & SEAMLESS PIPE ANSI/ASTM A53
- SEAMLESS CARBON STEEL PIPE ANSI/ASTM A106
- BLACK WELDED & SEAMLESS STEEL PIPE ANSI/ASTM A120

- 2) ALL ABOVEGROUND PIPE SHALL BE PRIMED AND PAINTED.
- 3) ALL UNDERGROUND PIPE SHALL BE X-TRU COATED OR EQUIVALENTLY WRAPPED (1MM FILM EPOXY-LI. GREEN)
- 4) ALL UNDERGROUND PIPING SHALL BE ELECTRICALLY ISOLATED AND CATHODICALLY PROTECTED WITH HIGH POTENTIAL MAGNESIUM ANODES
- 5) ALL UNDERGROUND PIPE JOINTS SHALL BE MASTIC COATED AND/OR WRAPPED WITH UNDERGROUND TAPE WRAP.
- 6) ALL ABOVEGROUND PIPE SHALL BE SECURELY SUPPORTED AND PROTECTED FROM PHYSICAL DAMAGE. SPACINGS OF A/G PIPE SUPPORTS SHALL NOT EXCEED THE FOLLOWING.

<u>STEEL PIPE SIZE</u> (INCHES)	<u>SPACING OF SUPPORTS</u> (FEET)
1/2"	6'
3/4" OR 1"	8'
1 1/4" OR LARGER (HORIZONTAL)	10'
1 1/4" OR LARGER (VERTICAL)	EVERY FLOOR LEVEL

- 7.) JOINT COMPOUND (PIPE DOPE) FOR ALL THREADED JOINTS SHALL BE LABELED FOR USE ON LP GAS AND LIQUID.
- 8.) ALL HIGH AND LOW PRESSURE FLANGE GASKETS SHALL BE ASBESTOS FIRE RATED OR WHEN REQUIRED NON ASBESTOS "GARLOCK" TYPE. FLANGED GASKETS SHALL BE RATED FOR THE GIVEN PRESSURE OF THE PIPELINE AND OR VALVE FLANGE.
- 9.) ALL PIPE WELDING SHALL MEET WITH THE LATEST A.P.I. STANDARD 1104.
- 10.) ALL HIGH PRESSURE PIPING SHALL BE SCHEDULE 80 WHEN THREADED OR SCHEDULE 40 OR 80 WHEN WELDED.
- 11.) ALL LOW PRESSURE PIPING SHALL BE AT LEAST SCHEDULE 40 WHEN THREADED OR WELDED.
- 12.) ALL HIGH PRESSURE FITTINGS SHALL BE FORGED STEEL RATED 600# OR GREATER. CAST IRON PIPE FITTINGS (ELLS, TEES, CROSSES, UNIONS, FLANGES OR PLUGS) SHALL NOT BE USED.
- 13.) ALL LOW PRESSURE FITTINGS SHALL BE RATED 250# OR GREATER MADE OF MALLEABLE IRON OR EQUIVALENT. CAST IRON PIPE FITTINGS (ELLS, TEES, CROSSES, UNIONS, FLANGES OR PLUGS) SHALL NOT BE USED.
- 14.) PRIOR TO PRESSURE TEST, PIPE SHALL BE CLEANED OF ALL FOREIGN MATERIAL.
- 15.) ALL NEW PIPING SHALL BE PRESSURE TESTED AFTER CONNECTIONS HAVE BEEN COMPLETED. PRESSURIZATION OF HIGH PRESSURE LINES WITH AIR OR NITROGEN TO 350 P.S.I.G. ALL LOW PRESSURE LINES WILL BE TESTED TO 50 P.S.I.G. HOLD PRESSURE ON SYSTEM FOR MINIMUM 15 MINUTES WHILE CHECKING ALL WELDS, THREADED JOINTS, VALVE PACKING JOINTS, ETC. WITH SOAP CHECK.
- 16.) ALL PIPE LEAVING TANK (MANWAY AND/OR OPENINGS) AREA SHALL INCORPORATE SWING JOINT ELLS TO RELIEVE PIPE STRESSES ON TANK FITTINGS. ADDITIONALLY, ANY PIPE SUBJECT TO MOVEMENT WITH RELATION TO ANY FIXED OBJECT MUST INCORPORATE SWING JOINT ELLS
- 17.) SUPPLY PIPE REDUCERS WHERE NECESSARY. (ONE PIECE CONCENTRIC WELD OR THREADED BUSHING TYPE).
- 18.) SUPPLY UNIONS WHERE NECESSARY FOR EASY REMOVAL OF EQUIPMENT (TAKE SPECIAL NOTE OF WHERE INSULATED UNIONS HAVE BEEN SPECIFIED)
- 19.) 6" DIAMETER CONCRETE FILLED SCHEDULE 40 STEEL GUARD POSTS TO BE INSTALLED WHERE NECESSARY (SUPPLIED BY CUSTOMER)
- 20.) INSTALLATION TO MEET THE FOLLOWING CODE REQUIREMENTS:
N.F.P.A. #58 AND N.F.P.A. PAMPHLET #70 COVERING
HAZARDOUS LOCATIONS CLASSIFICATIONS

①

BILL OF MATERIAL

SYMBOL	QTY	DESCRIPTION	INLET/OUTLET	PIPE SIZE	MANUFACTURER/ PART NO
2-3	2	BALL VALVE	UNION ENDS	1"	MARPAC CS-B790-TT
2-4	1	BALL VALVE	UNION ENDS	1 1/4"	MARPAC CS-B790-TT
2-6	1	BALL VALVE	UNION ENDS	2"	MARPAC CS-B790-TT
3-1	2	GLOBE VALVE	FNPT/FNPT	1/2"	FISHER N301-04
3-4	4	GLOBE VALVE	FNPT/FNPT	1 1/4"	FISHER N310-10
3-6	1	GLOBE VALVE	FNPT/FNPT	2"	FISHER N310-16
4-4	1	EMERGENCY VALVE	FNPT/FNPT	1 1/4"	REGO 7781AF
F191	3	EXCESS FLOW VALVE	MNPT/FNPT	2 x 1 1/4"	FISHER F191-105GPM
F195	2	EXCESS FLOW VALVE	MNPT	3 x 2"	FISHER F195-280GPM
7-1	1	MULTIPOINT RELIEF VALVE	FLANGE	3"	REGO A8560
7-2	1	HYDRO. RELIEF VALVE	MNPT	1/2"	FISHER H144
7-4	3	TANK RELIEF VALVE	MNPT	2"	REGO A3149AG
7-10	3	PIPEWAY ADAPTOR	-	-	FISHER P104-24
7-11	1	RAIN CAP	-	1/2"	FISHER P208
7-15	1	RAIN CAP	-	2"	P770 - 2 3/8"
7-16	3	RAIN CAP	-	3"	P770 - 3 1/2"
8-4	1	NEEDLE VALVE	MNPT/FNPT	1/4"	V335
9-6	1	BACKCHECK VALVE	FNPT/FNPT	2"	REGO A7784
12-18	1	EMERG. PULL TO CLOSE	-	-	FISHER P1848 W/ CABL
12-20	1	EMERG. PULL SIGN	-	-	P-81
13-8	1	STRAINER	FNPT/FNPT	2"	PAGET PG200 (W280-18)
15-2	2	PRESSURE GAUGE (0-300#)	-	1/4"	FISHER J501 (GS30)
15-4	1	PRESSURE GAUGE (0-300#)	-	1/4"	FISHER J506 (GS300)
15-14	1	VENT/PRESSURE VALVE	MNPT/FNPT	3/4" x 1/4"	FISHER J415
15-15	1	SPT VENT	FNPT	1/4"	FISHER J400
16-1	1	ACME ADAPTOR	MACME/MNPT	3 1/4" x 2"	FISHER 503-16
16-2	1	ACME ADAPTOR	MACME/MNPT	3 3/4" x 1"	FISHER M218
16-5	1	BRASS CAP W/ CHAIN	FACME	1 3/4"	FISHER M229
16-6	1	STEEL CAP	FACME	3 1/4"	FISHER M443
16-9	1	CHAIN W/ HOOKS	-	-	FISHER P167
20-9	1	STAND PIPE	SCHD.40 GALV	2" x 7'	BY CONTRACTOR
20-10	3	STAND PIPE	SCHD.40 GALV	3" x 7'	BY CONTRACTOR
1805	1	RELIEF VALVE	FNPT/FNPT	2"	FISHER 1805-52
26-2	2	BREAKAWAY EAR	-	-	-
27-6	2	INSULATED UNION	FNPT/FNPT	2"	3000# (HIGH PRESSURE)
J701	1	8" THERMOMETER	MNPT	1/2"	FISHER J701
630	2	REGULATOR	FNPT/FNPT	2"	FISHER 630-104/78

②

Suburban Propane

SUBURBAN PROPANE - WHIPPANY, N. J. J. YAPOLA 9/18/95
 DATE NAME NONE OFFICE NONE

BILL OF MATERIALS
 ROY WESTON, INC. - WEST CHESTER, PA.
 ALABAMA ARMY AMMUNITION PLANT - ALPINE, AL.

JWC.NO. 9508-112 Sheet 3 of 3

MISCELLANEOUS HGD SYSTEM EQ

<u>DRAWING NO.:</u>	<u>REV. NO.:</u>	<u>DRAWING DATE</u>	<u>DRAWING DESCRIPTION</u>
400	1	8/3/96	HGD SYSTEM: GENER
401	1	7/25/96	HGD SYSTEM: SECTIO
1000	-	8/8/95	STACK MODIFICATION TESTING
1001	2	5/2/96	HGD SYSTEM: PROCE
1002	2	5/10/96	HGD SYSTEM: PIPING
C100	3	1/10/96	HGD SYSTEM: SITE L
C2000	3	9/6/96	HGD SYSTEM: OVERA
C2001	2	9/6/96	HGD SYSTEM: OVERA

(1)

MISCELLANEOUS HGD SYSTEM EQUIPMENT

HGD SYSTEM EQUIPMENT

DRAWING DESCRIPTION

HGD SYSTEM: GENERAL ARRANGEMENT PLAN

HGD SYSTEM: SECTIONS & DETAILS

STACK MODIFICATION TO SUPPORT EMISSIONS
TESTING

HGD SYSTEM: PROCESS FLOW DIAGRAM


HGD SYSTEM: PIPING & INSTRUMENTATION DIAGRAM

HGD SYSTEM: SITE LAYOUT

HGD SYSTEM: OVERALL SITE LAYOUT @ ALAAP

HGD SYSTEM: OVERALL SITE LAYOUT: DETAIL A

2

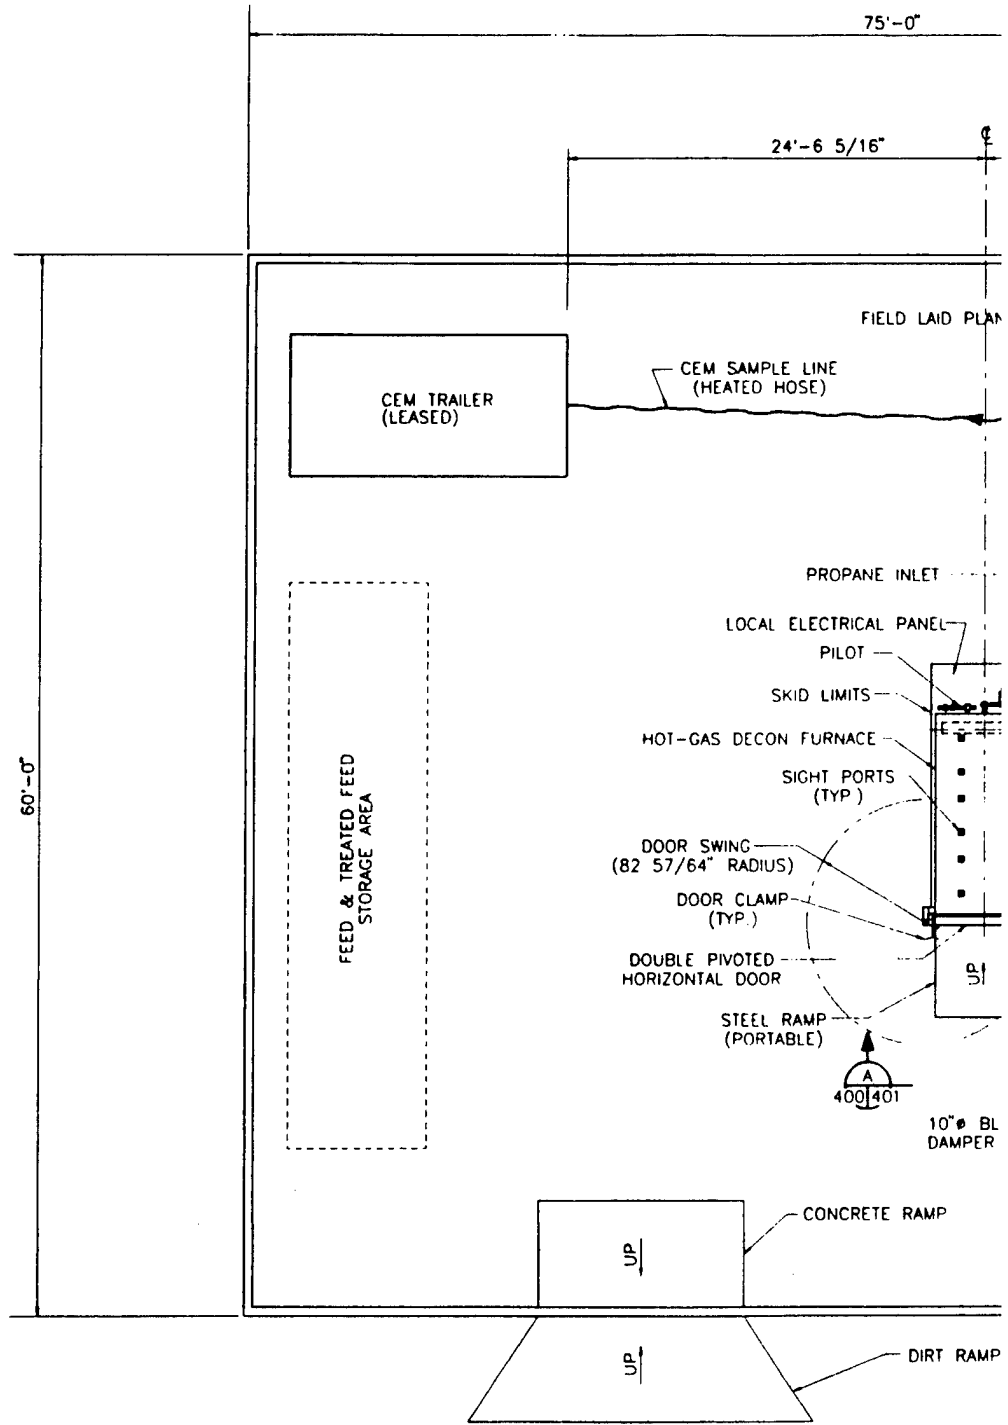


PLOTTED 07/31/96 11:35 am
 P.L.T. SC. 1-64 FILE NO 12104000

NO	DATE	APPR	REVISION	NO	DATE	APPR	REVISION
1		BL/CL	REVISED INTERCONNECTING DUCT ARRANGEMENT				

HC
DECONTAM
 ALAAP

WEST CHESTER



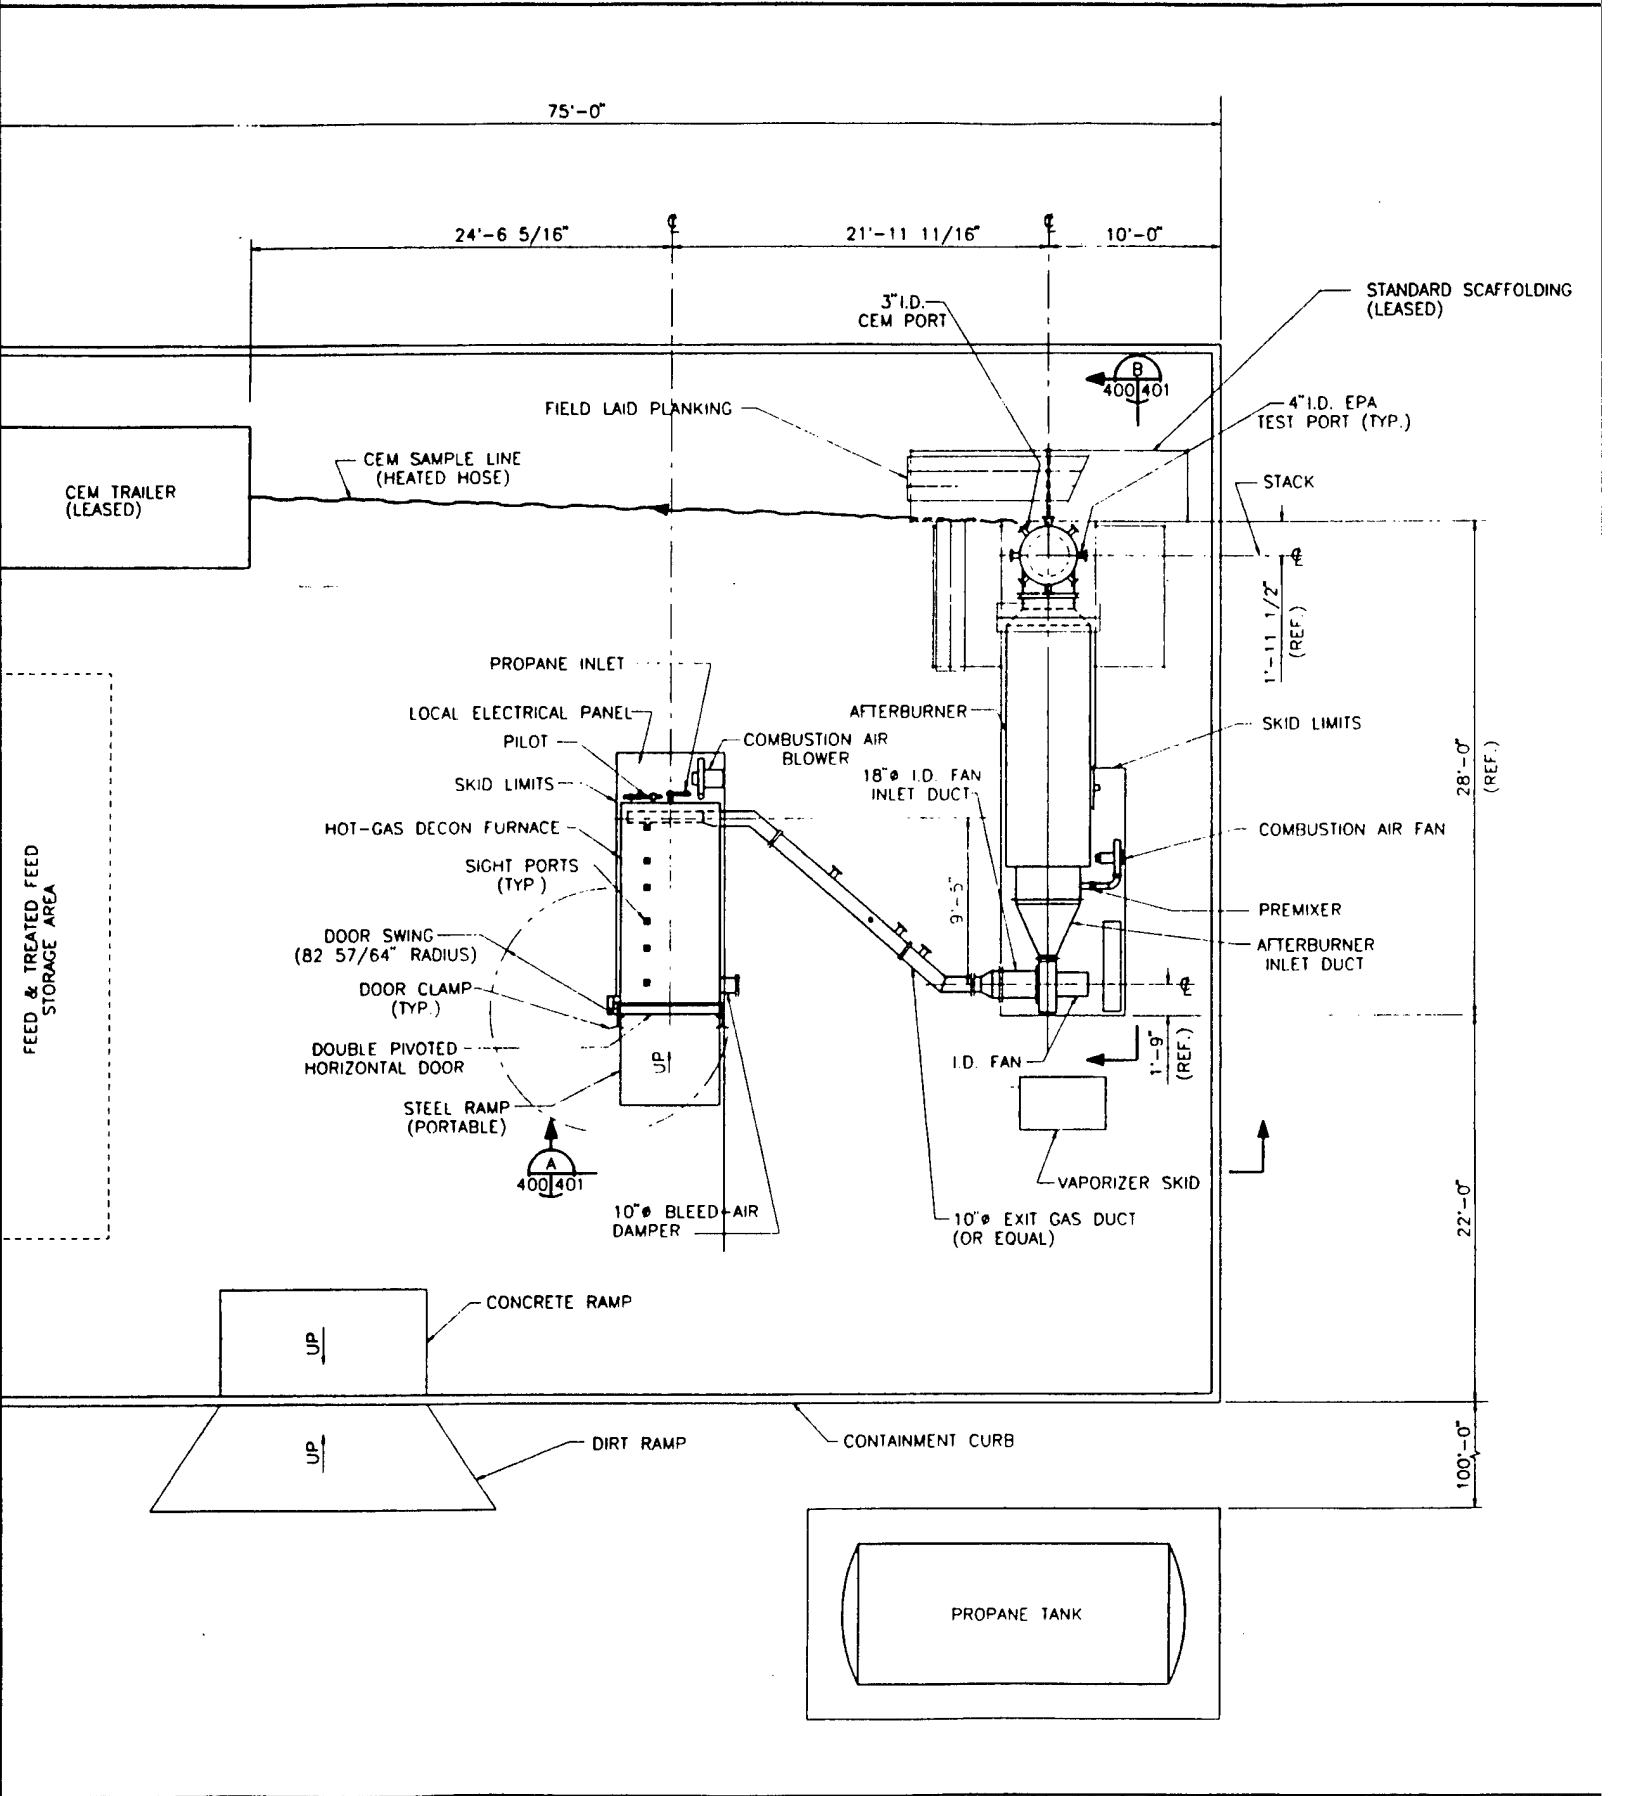

**HOT-GAS
DECONTAMINATION SYSTEM**
ALAAP ALPINE, ALABAMA





CHECKED	DATE	CLIENT APPROVALS	DATE
<i>Ufada</i>	8/3/96		
DES. ENG.			
PROJ. ENG.			
PROJ. MGR.			
APPROVED			
APPROVED			

ED FOR CONSTRUCTION

REVISION
2


WESTON CHESTNUT HILLS, VIRGINIA

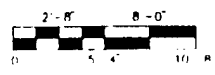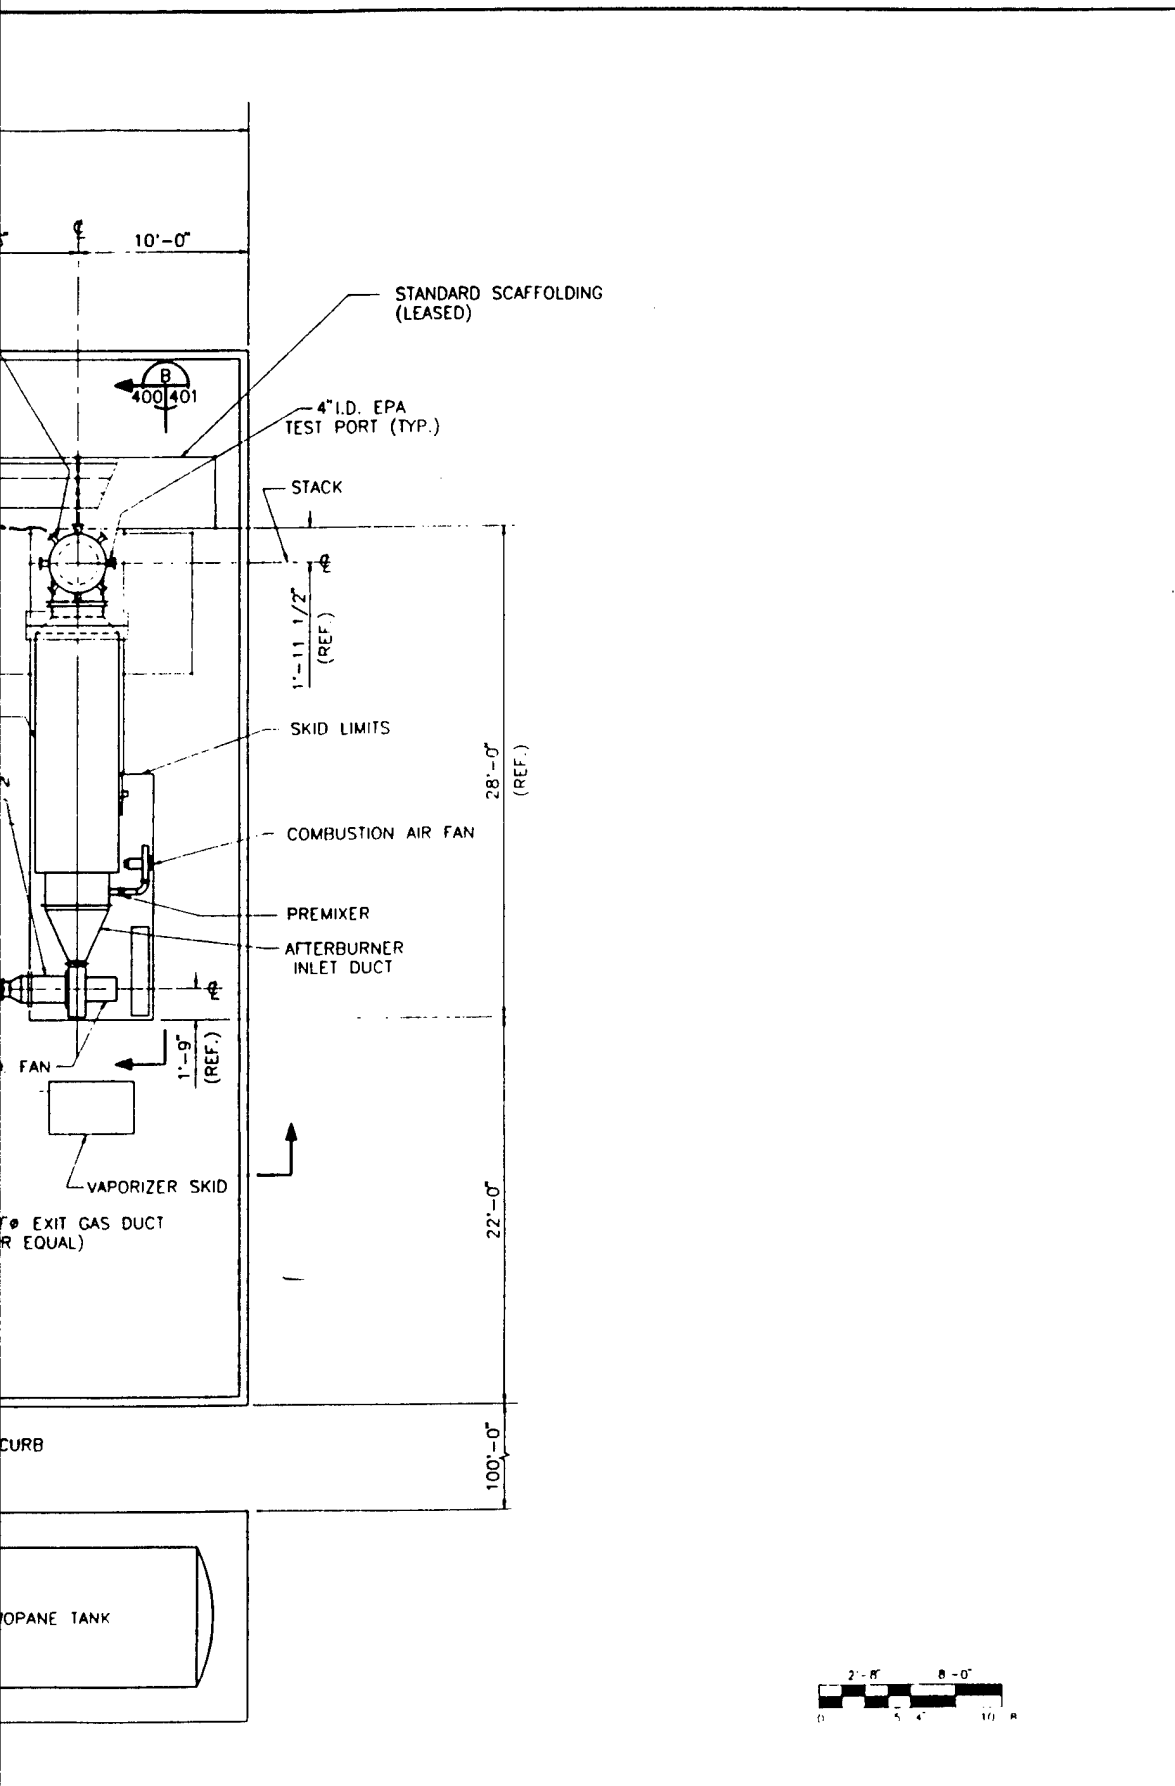


CHECKED	DATE	CLIENT APPROVALS	DATE
<i>Alfano</i>	8/3/96		
DES. ENG.			
PROJ. ENG.			
PROJ. MGR.			
APPROVED			
APPROVED			

HOT GAS DECON SYSTEM GENERAL ARRANGEMENT PLAN			
DESIGN	J M	DATE	11/09/94
SCALE	3/16" = 1'	DWG. NO.	2281-012-010
		DWG. NO.	400
		REV. NO.	1

3

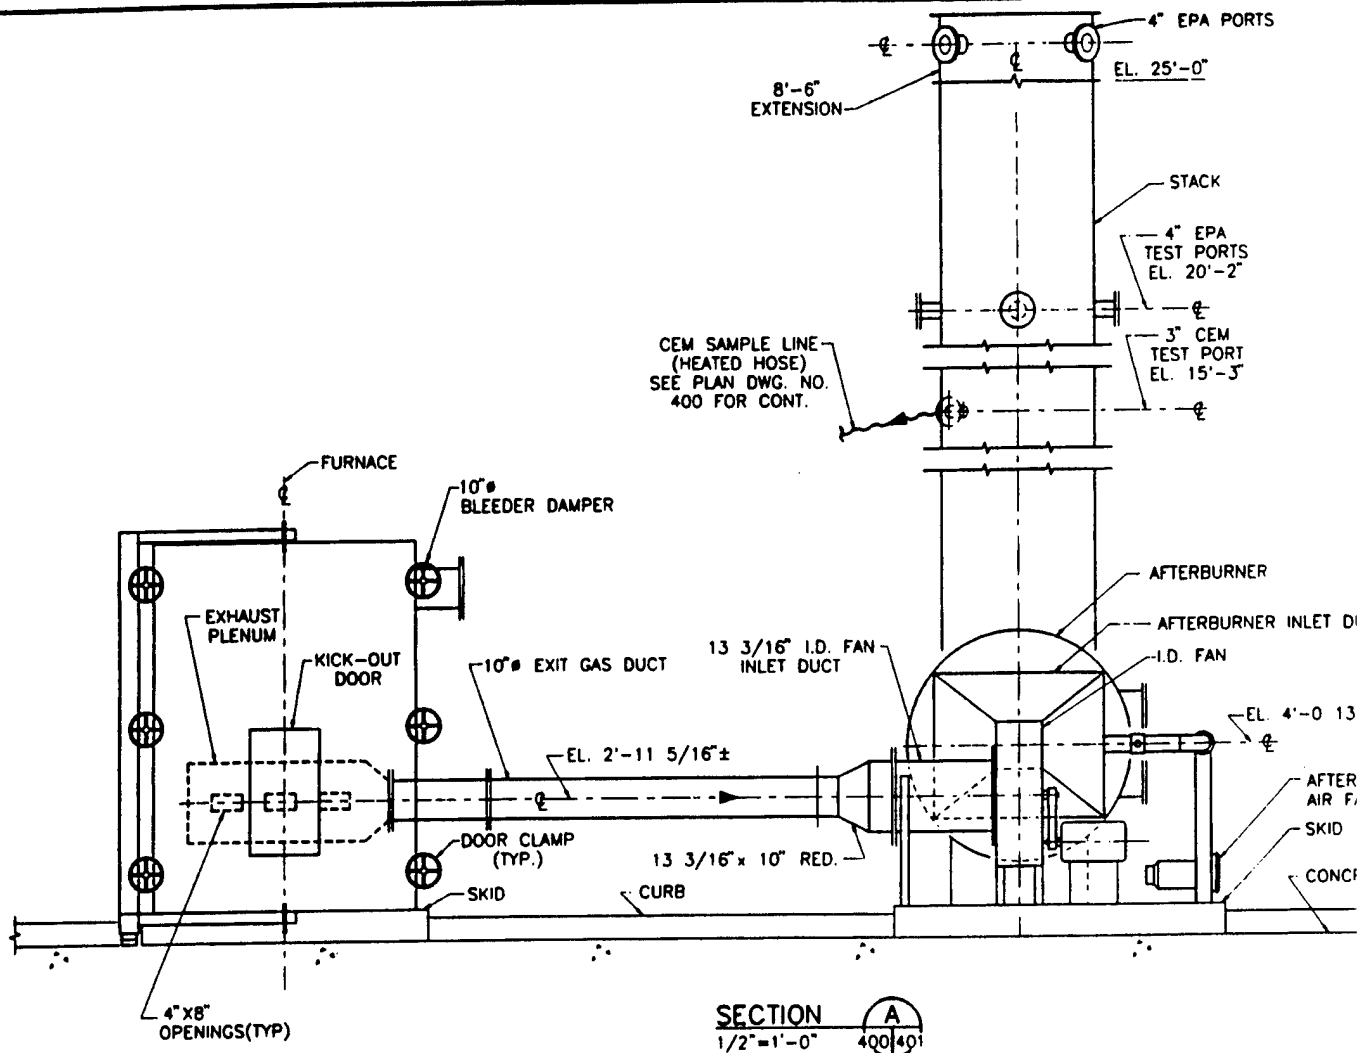

SECTION A
1/2" = 1'-0" 400/401

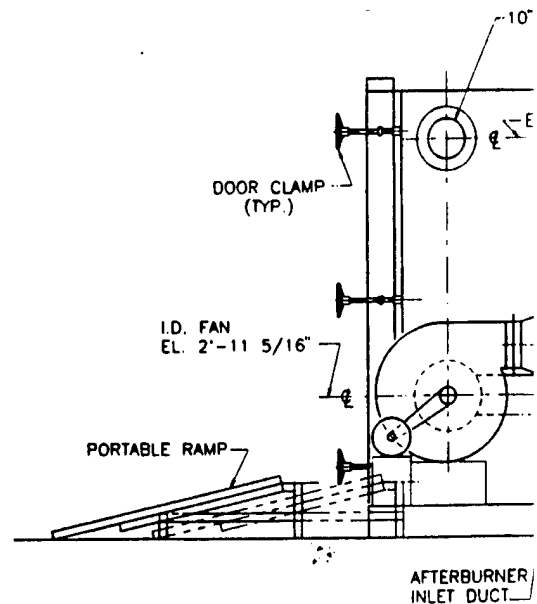


NOTE:
TOP OF CONCRETE EQUIPMENT PAD
IS ASSUMED TO BE EL. 0'-0".

PLOTTED 07/31/98 11:36 am
P.L.T. SC. 1=24 FILE NO. 12104001

NO	DATE	APPR.	REVISION	NO	DATE	APPR.	REVISION
-	04/01/98	CAP	ISSUED FOR CONSTRUCTION				
1	07/31/98	CAP	REVISED INTERCONNECTING DUCT ARRANGEMENT; ADDED 8'-6" STACK EXT.				

HO
DECONTAMII
ALAAP

WEST CHESTER

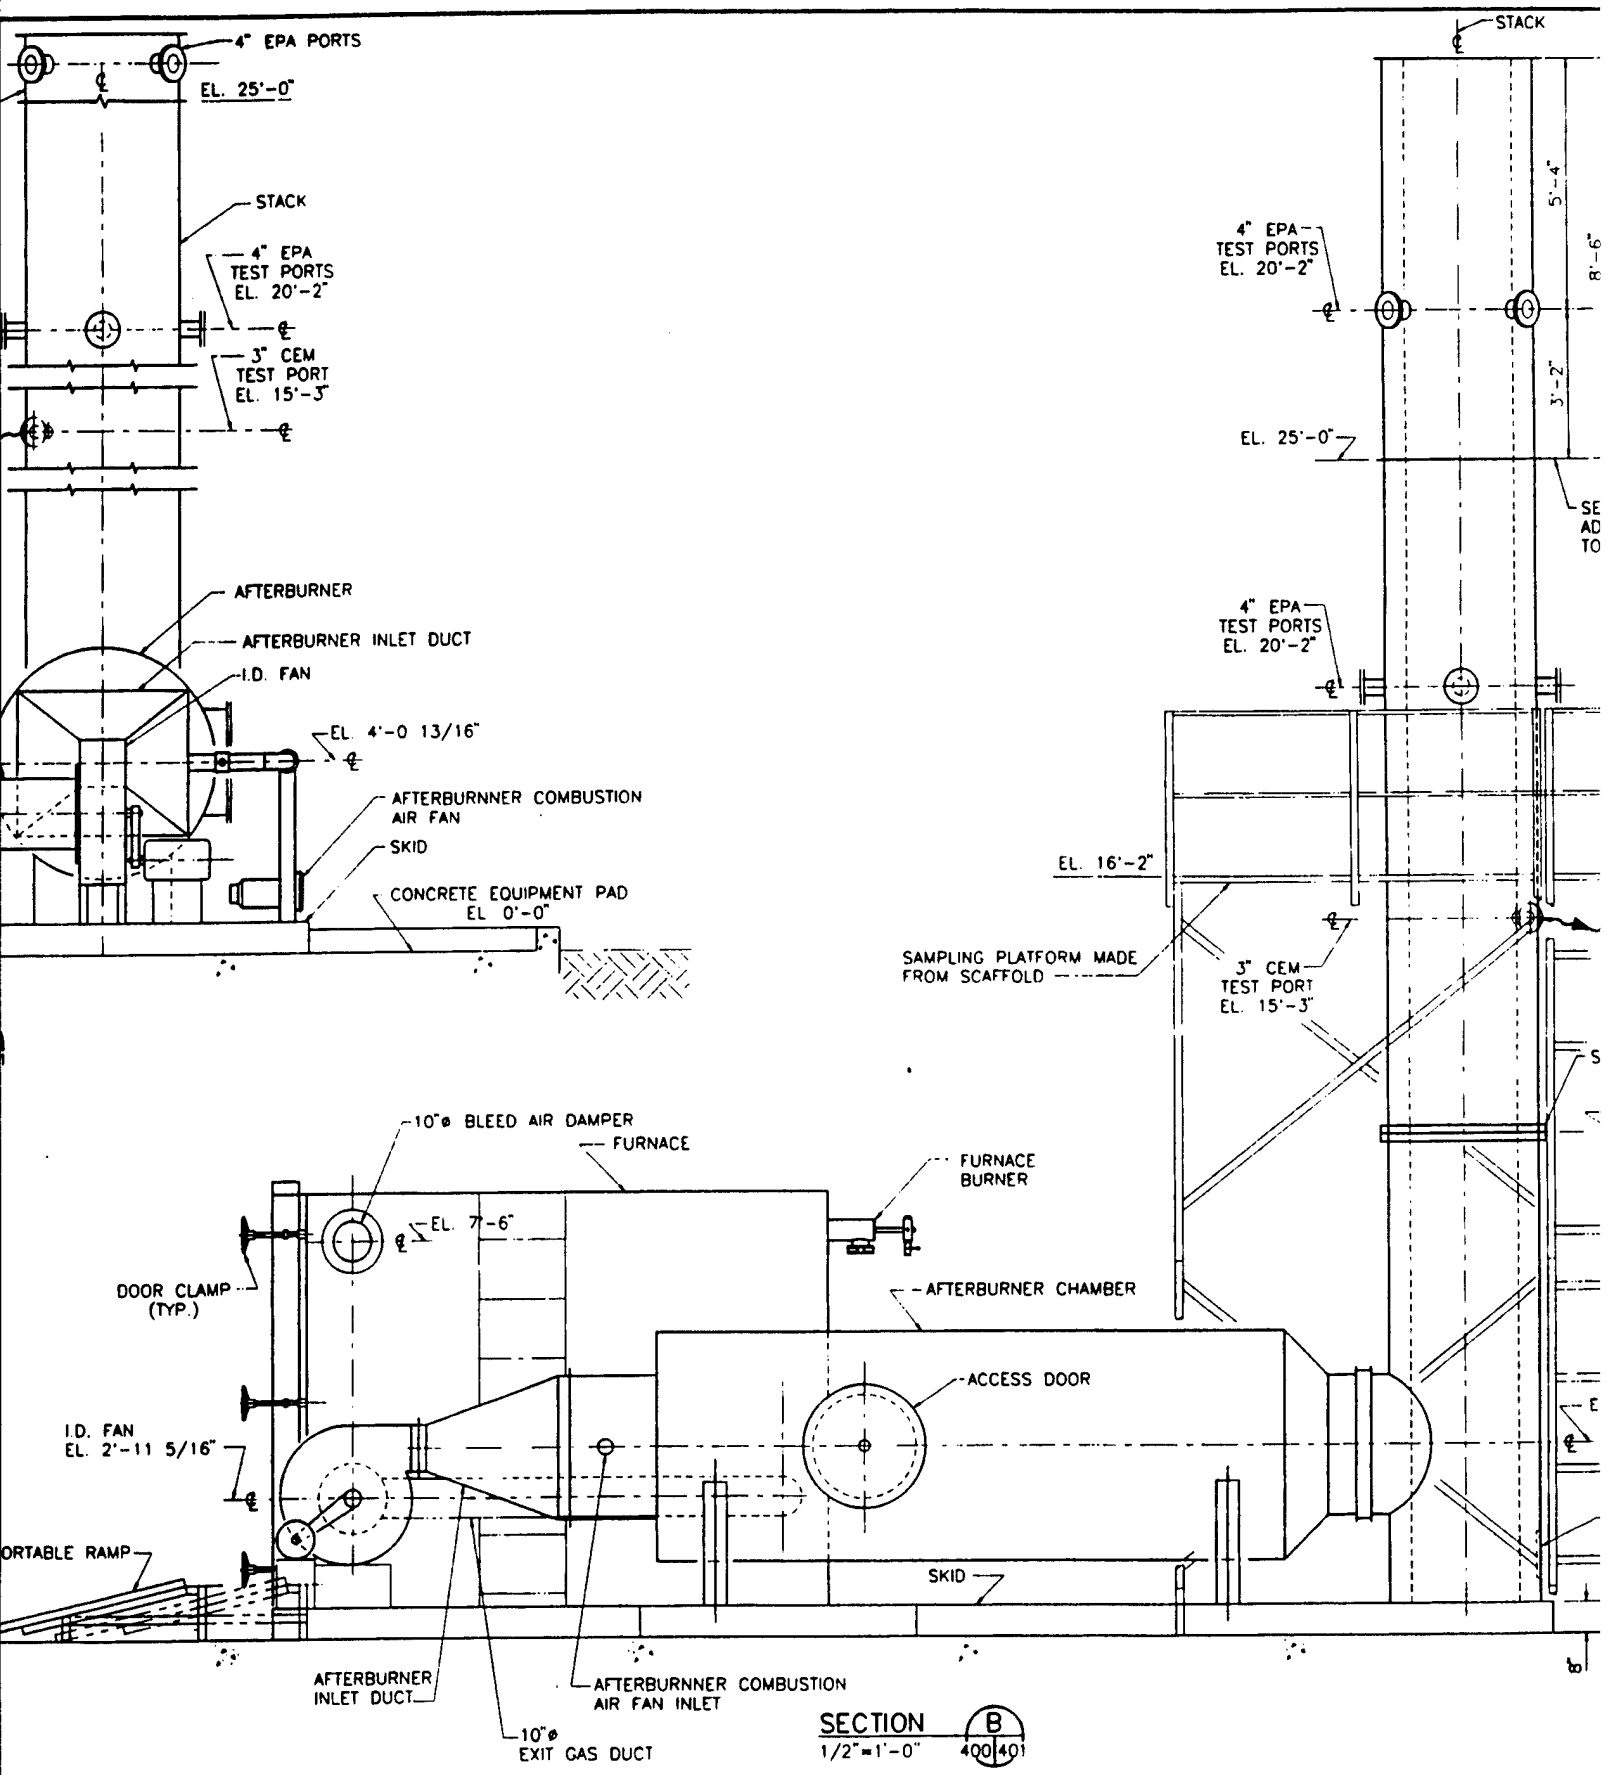

SECTION B
1/2" = 1'-0" 400/401

HOT-GAS DECONTAMINATION SYSTEM
ALAAP ALPINE, ALABAMA




CHECKED	DATE	CLIENT APPROVALS	DATE
DES. ENG.			
PROJ. ENG.			
PROJ. MGR.			
APPROVED			
APPROVED			

HOT GAS D
SECTIONS

DRWN	J.M.	DATE	11/10
SCALE	1/2" = 1'	FIG NO	02281-01

2

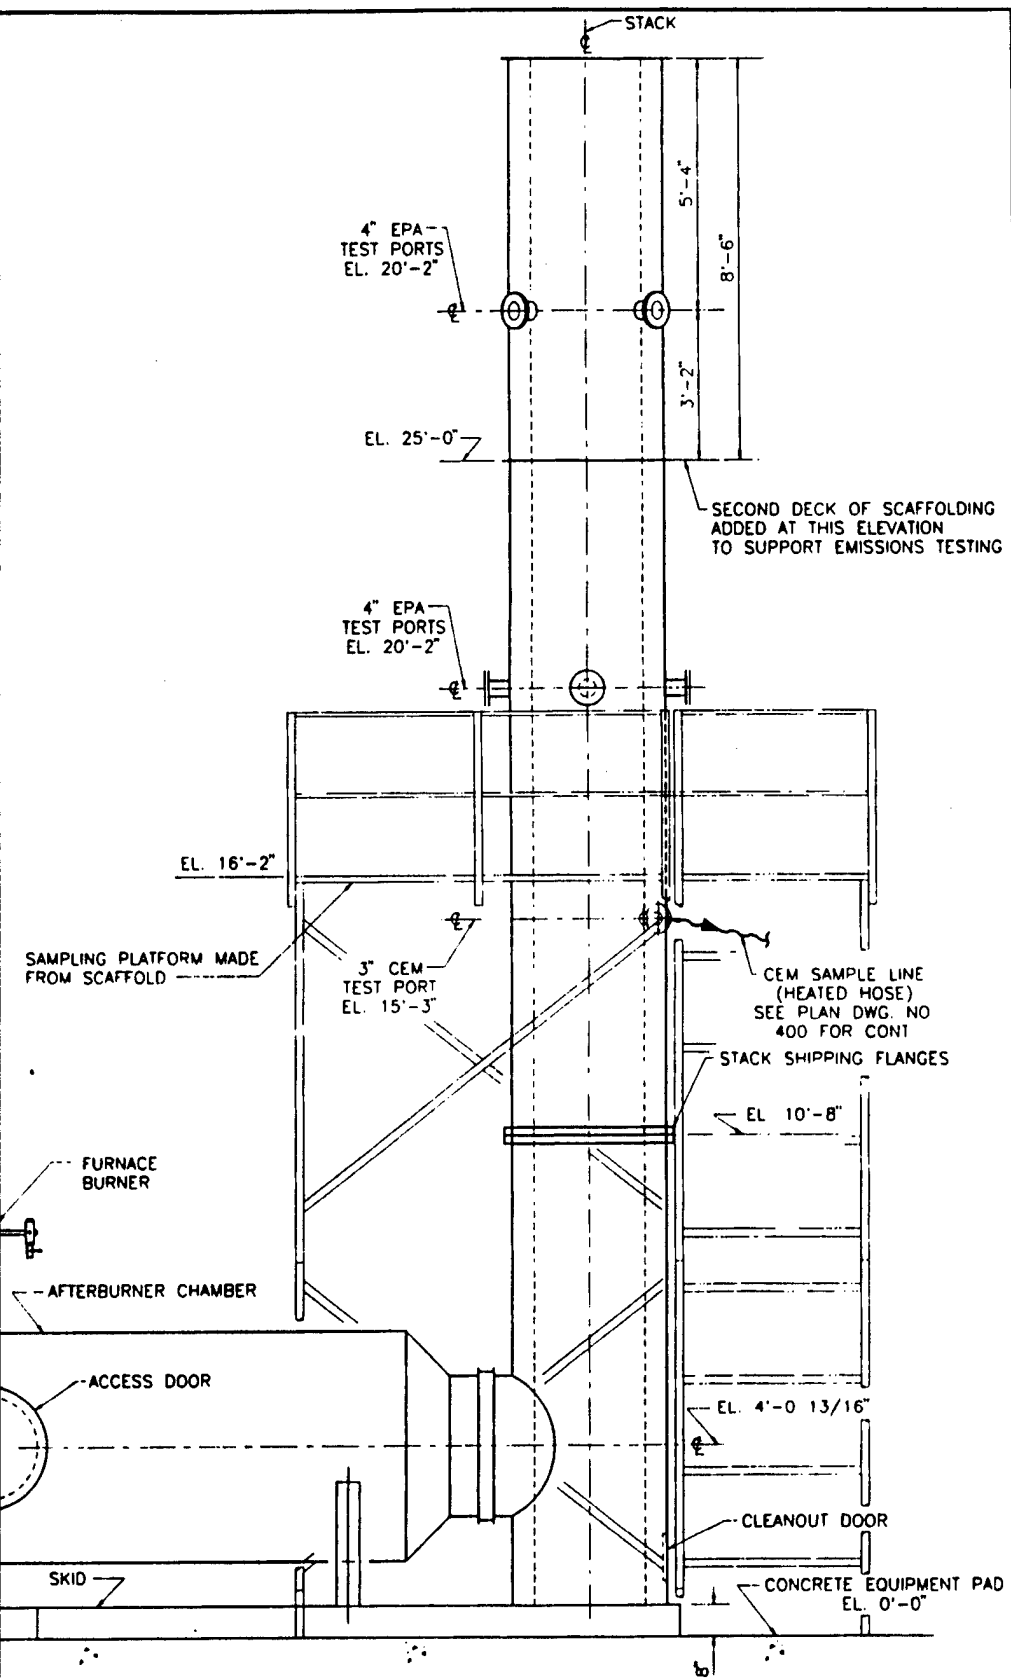



SECTION B
4'-0"

DATE	CLIENT APPROVALS	DATE


**HOT GAS DECON SYSTEM
SECTIONS AND DETAILS**

DESIGN	J.M.	DATE	11/10/94	DWG. NO.	401	REV. NO.	1
SCALE	1/2" = 1'	DWG. NO.	02281-012-010	BY		OF	

(B)

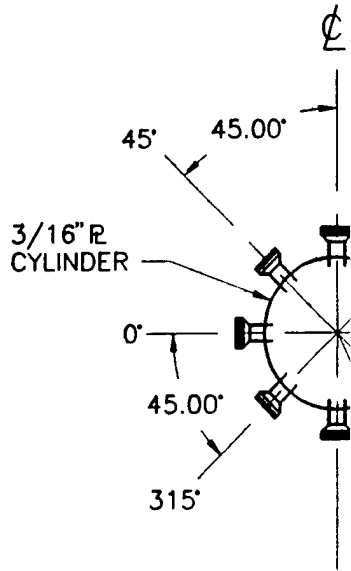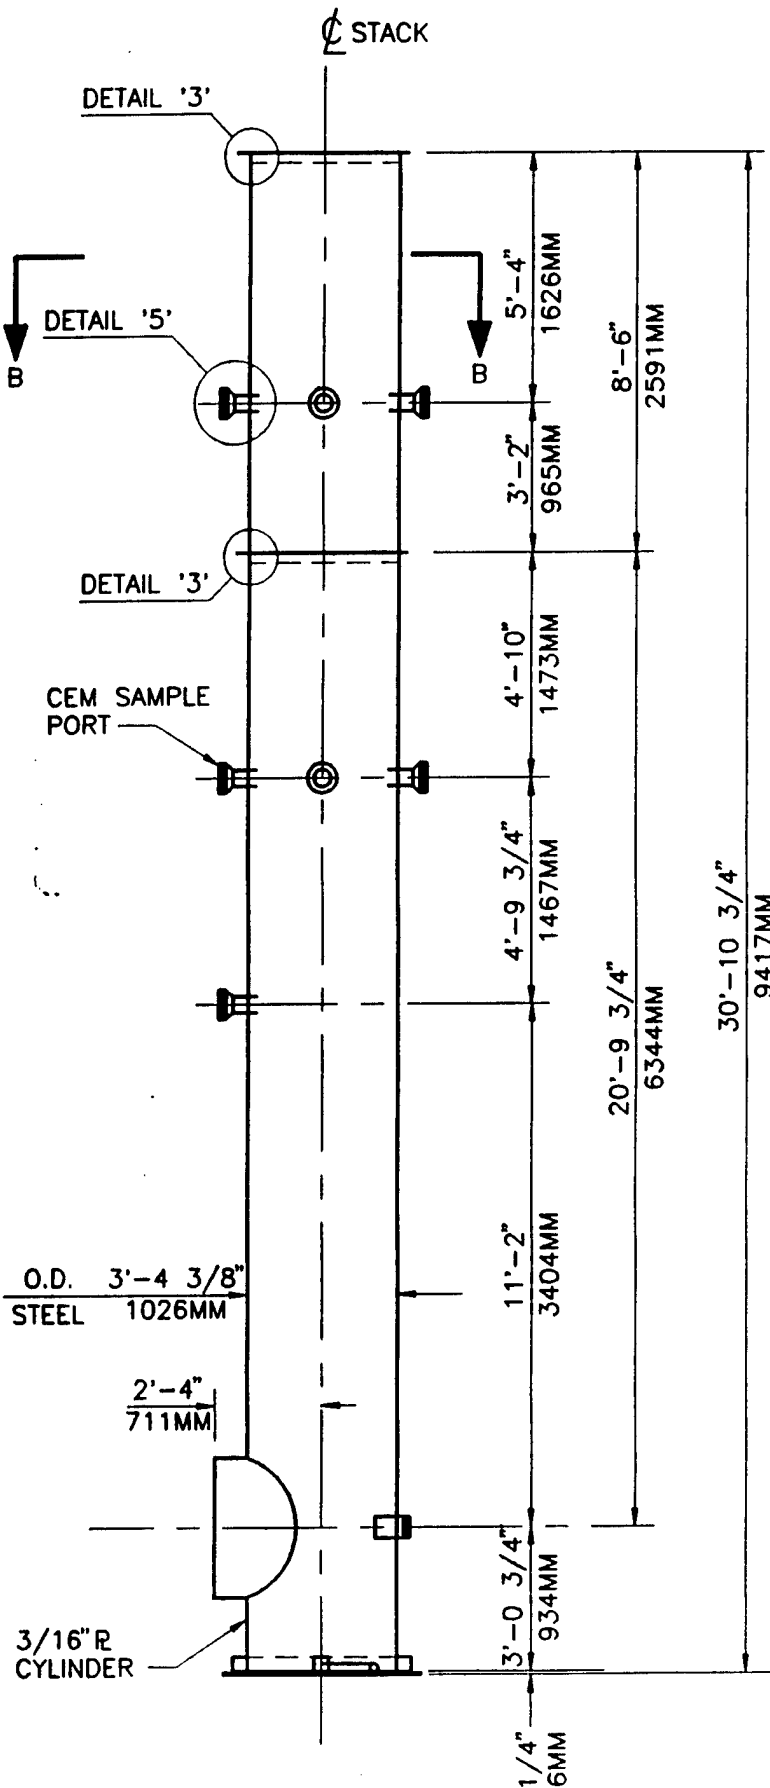

**SECTION
SAMPLE PORTS**
SCALE: 1/4"

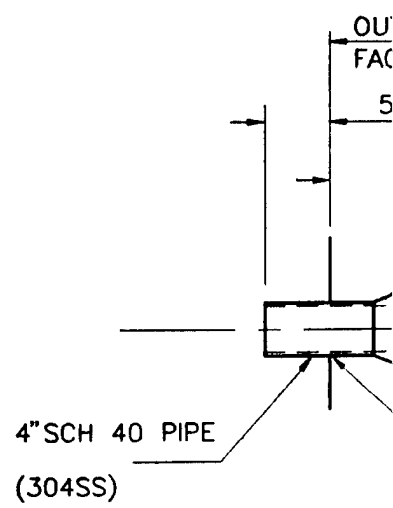



(EPA

PLOTTED
PLT. SC.

1

ELEVATION VIEW
SCALE: 1/4" = 1'-0"


ST/
TO SUPP
PROPO
DEL
REFERENCE
W.O. NO.: 0228

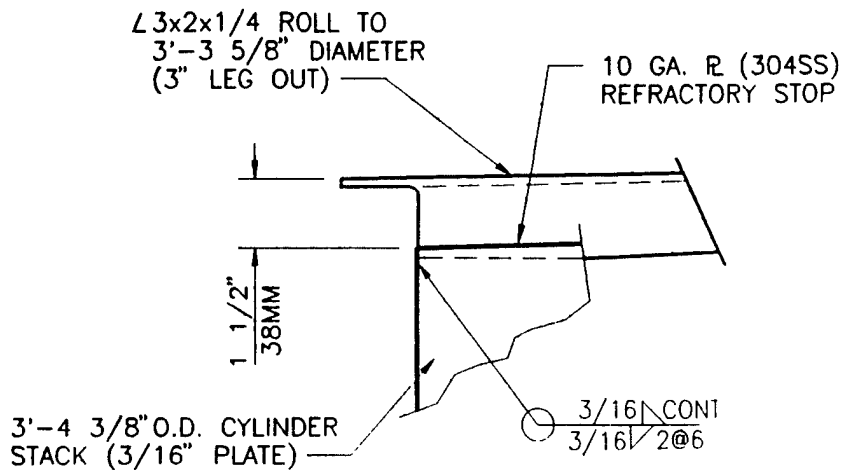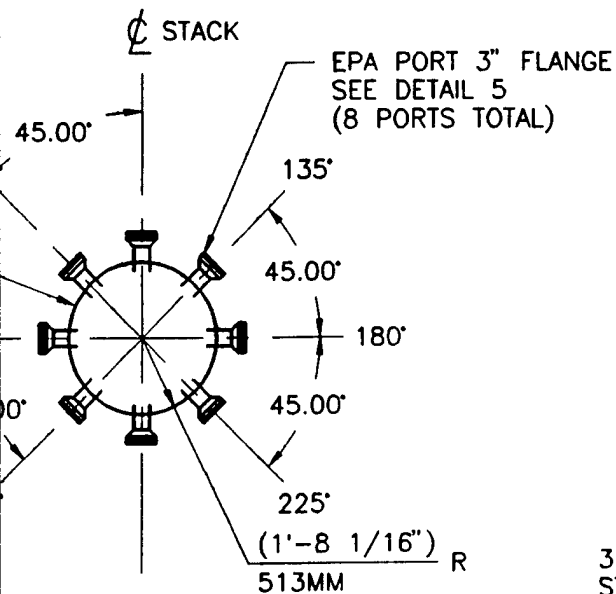

**SECTION B-B
PORTS PLAN VIEW**

SCALE: 1/4" = 1'-0"

**DETAIL '3'
(STACK CAP RING)**
N.T.S.

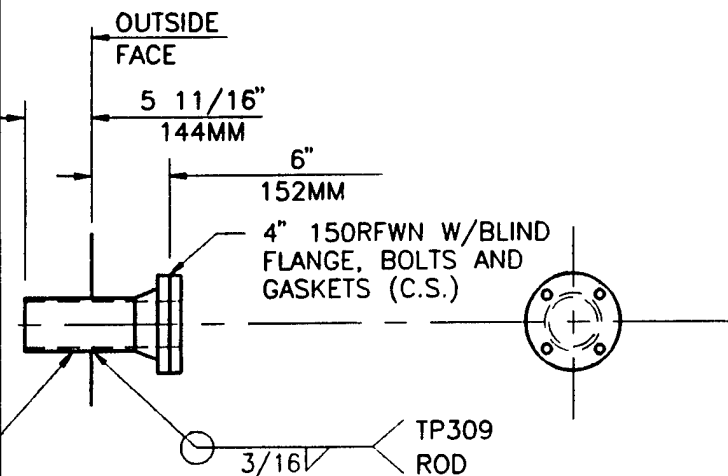

**DETAIL '5'
(EPA SAMPLE PORTS)
(TYPICAL)**
N.T.S.

NOTES:

1. SANDBLAST EXTERIOR SURFACES PER SSPC-SP6.
2. PAINT EXTERIOR SURFACES W/(1) COAT (3-4) MILS DFT CARBOZINC 11, FINISH COAT W/(2) COATS (4 MILS EACH) DFT "SHERMAN WILLIAMS-ALL-WEATHER-EXPOXY".
3. ALL C.S. MATERIAL SHALL BE A36.
4. ALL LIFTING LUGS LIFT STRAIGHT UP UNLESS NOTED OTHERWISE.

FILE NO. 19951000
1=48
08/10/95 3:08 pm

**STACK MODIFICATION
TO SUPPORT EMISSIONS TESTING
PROPOSED MODIFICATION #2
DELIVERY ORDER #12**


REFERENCE
NO.: 02281-012-012

2

ROY F. WESTON, INC.



DRAWN SCB	DATE 8/8/95	DES. ENG.	DATE	W. O. NO. 00936019095
CHECKED	DATE	APPROVED	DATE	DWG. NO. 1000

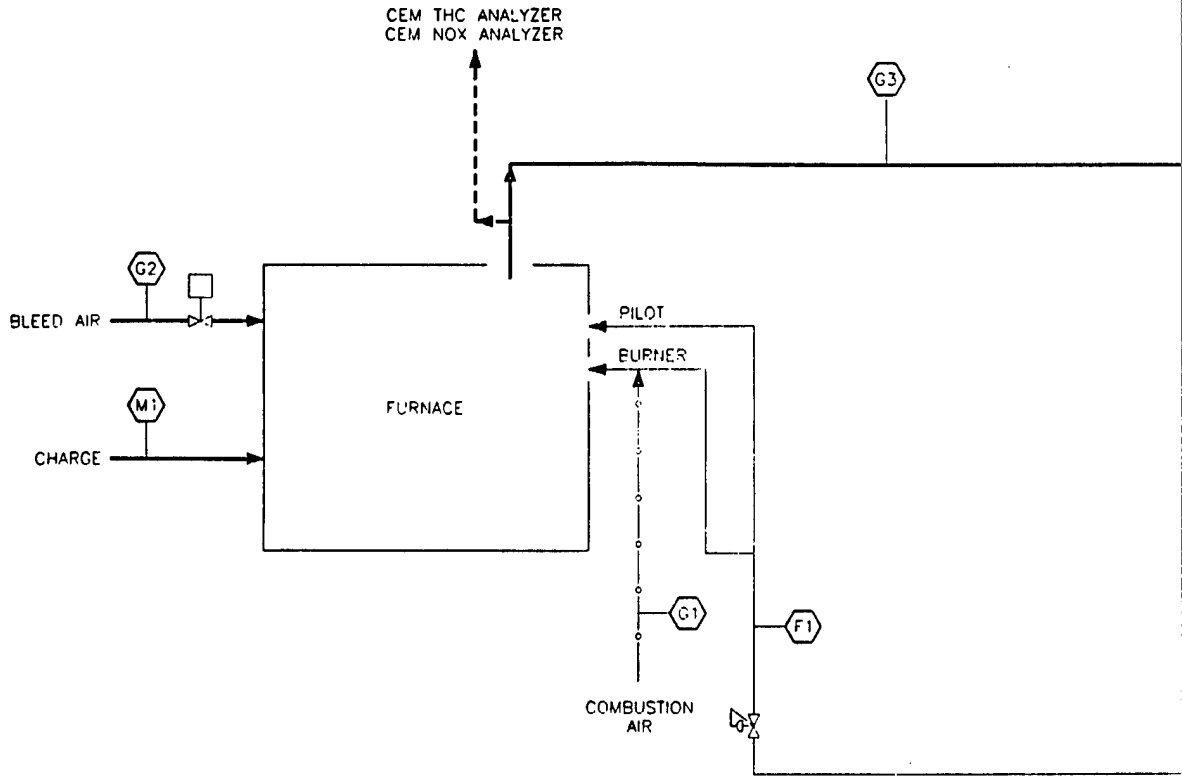

WARM-UP CONDITIONS						
GAS FLOWS						
	Units	G1 Furnace Combustion Air	G2 Bleed Air Damper	G3 Furnace Exit Gas	G4 Afterburner Combustion Air	G6 Stack Exit Gas
Flow Rate	scfm	333	565	940	248	2,653
Temperature	°F	70	70	700	70	1,800
Pressure	in w.c.	27.00	-0.50	-0.50	13.90	-
Mass Flow: Warm Up	lb/hr	1,536	2,705	4,294	1,137	5,513
Composition:						
CO2	wt %	--	--	3.5	--	7.2
H2O	wt %	--	--	1.9	--	4.0
N2	wt %	79.0	79.0	77.7	79.0	78.8
O2	wt %	21.0	21.0	18.9	21.0	12.0
SOx	wt %	--	--	--	--	--
THC	wt %	--	--	--	--	--
NOx	wt %	--	--	--	--	--

FUEL			
	Units	F1 Furnace Fuel	F2 Afterburner Fuel
Flow Rate (maximum)	scfh	423	1037
Pressure	psi	5	5
Mass Flow (maximum)	lb/hr	50.54	123.90
Burner Heat Release	bbu/hr	1,120,868	1,830,850
Composition:			
C	wt %	81.6	81.6
H	wt %	18.4	18.4

MATERIAL		
	Units	M1 Furnace Charge
Charge Size (maximum)	lbs	3,000
Moisture Content	%	--
Temperature	°F	70

STEADY-STATE CONDITIONS						
GAS FLOWS						
	Units	G1 Furnace Combustion Air	G2 Bleed Air Damper	G3 Furnace Exit Gas	G4 Afterburner Combustion Air	G6 Stack Exit Gas
Flow Rate	scfm	80	0	342	248.10	1,311
Temperature	°F	70	--	700	700	1,800
Pressure	in w.c.	27.00	--	-0.50	13.90	--
Mass Flow	lb/hr	371	--	1,582	1,137	2,729
Composition:						
CO2	wt %	--	--	4.5	--	5.9
H2O	wt %	--	--	2.5	--	3.2
N2	wt %	79.0	--	77.3	79.0	77.2
O2	wt %	21.0	--	15.7	21.0	13.8
SOx	wt %	--	--	--	--	--
THC	wt %	--	--	--	--	--
NOx	wt %	--	--	--	--	--

FUEL			
	Units	F1 Furnace Fuel	F2 Afterburner Fuel
Flow Rate (maximum)	scfh	197	248
Pressure	psi	5	5
Mass Flow (maximum)	lb/hr	24	29.60
Burner Heat Release	bbu/hr	487,184	587,498
Composition:			
C	wt %	81.6	81.6
H	wt %	18.4	18.4


MATERIAL		
	Units	M1 Furnace Charge
Charge Size (maximum)	lbs	3,000
Moisture Content	%	--
Temperature	°F	700

PLOTTED 05/19/95 5:05 am
 FILE NO. 12101001

2. ADDITIONAL ADDITION OF BLEED AIR 1. ADDITIONAL INTERPOLATED SENSITIVE DATA AND AS-BUILT INFORMATION - ENCL. 00101									

U.S
DELIVERY OR



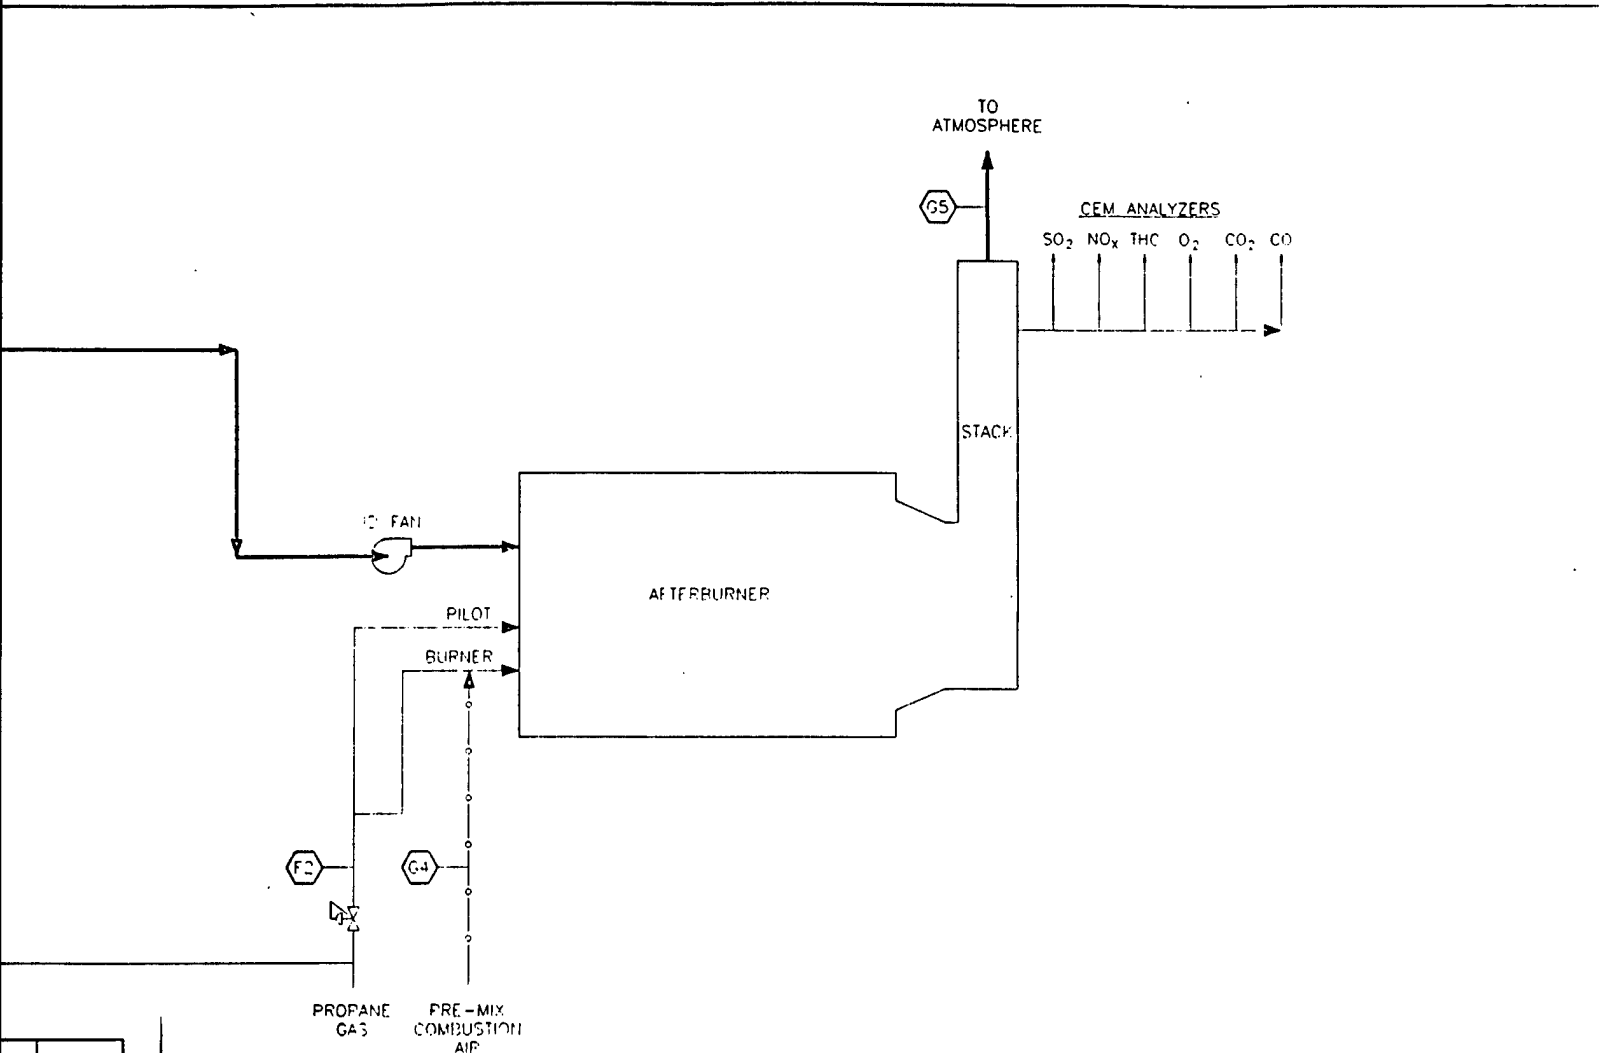

	M1
Rate	Furnace Charge
lb/hr	3,000
Temp	70

COOL-DOWN CONDITIONS						
GAS FLOWS						
	Units	G1 Furnace Combustion Air	G2 Bleed Air Damper	G3 Furnace Exit Gas	G4 Afterburner Combustion Air	G5 Stack Exit Gas
Flow Rate	scfm	333	565	918	246	1,108
Temperature	°F	70	70	--	70	1,800
Pressure	in w.c.	27.00	-0.50	-0.50	13.90	--
Mass Flow	lb/hr	1,538	2,705	4,243	1,137	2,324
Composition:						
CO2	wt %	--	--	--	--	14.7
H2O	wt %	--	--	--	--	8.1
N2	wt %	79.0	79.0	79.0	79.0	59.4
O2	wt %	21.0	21.0	21.0	21.0	17.8
SOx	wt %	--	--	--	--	--
THC	wt %	--	--	--	--	--
NOx	wt %	--	--	--	--	--

FUEL		F1	F2
	Units	Furnace Fuel	Afterburner Fuel
Flow Rate (maximum)	scfm	--	956
Pressure	psi	--	5
Mass Flow (maximum)	lb/hr	--	114
Burner Heat Release	btu/hr	--	2,258,900
Composition:			
C	wt %	--	81.6
H	wt %	--	18.4

MATERIAL		M1
	Units	Furnace Charge
Charge Size (maximum)	lbs	3,000
Moisture Content	%	--
Temperature	°F	700

M1
Furnace Charge
3,000
700


U.S.A.E.C.
LIVERY ORDER #10 & 12



PROCESS FLOW DIAGRAM
HOT-GAS DECONTAMINATION SYSTEM



M. PALANCA
1001 2

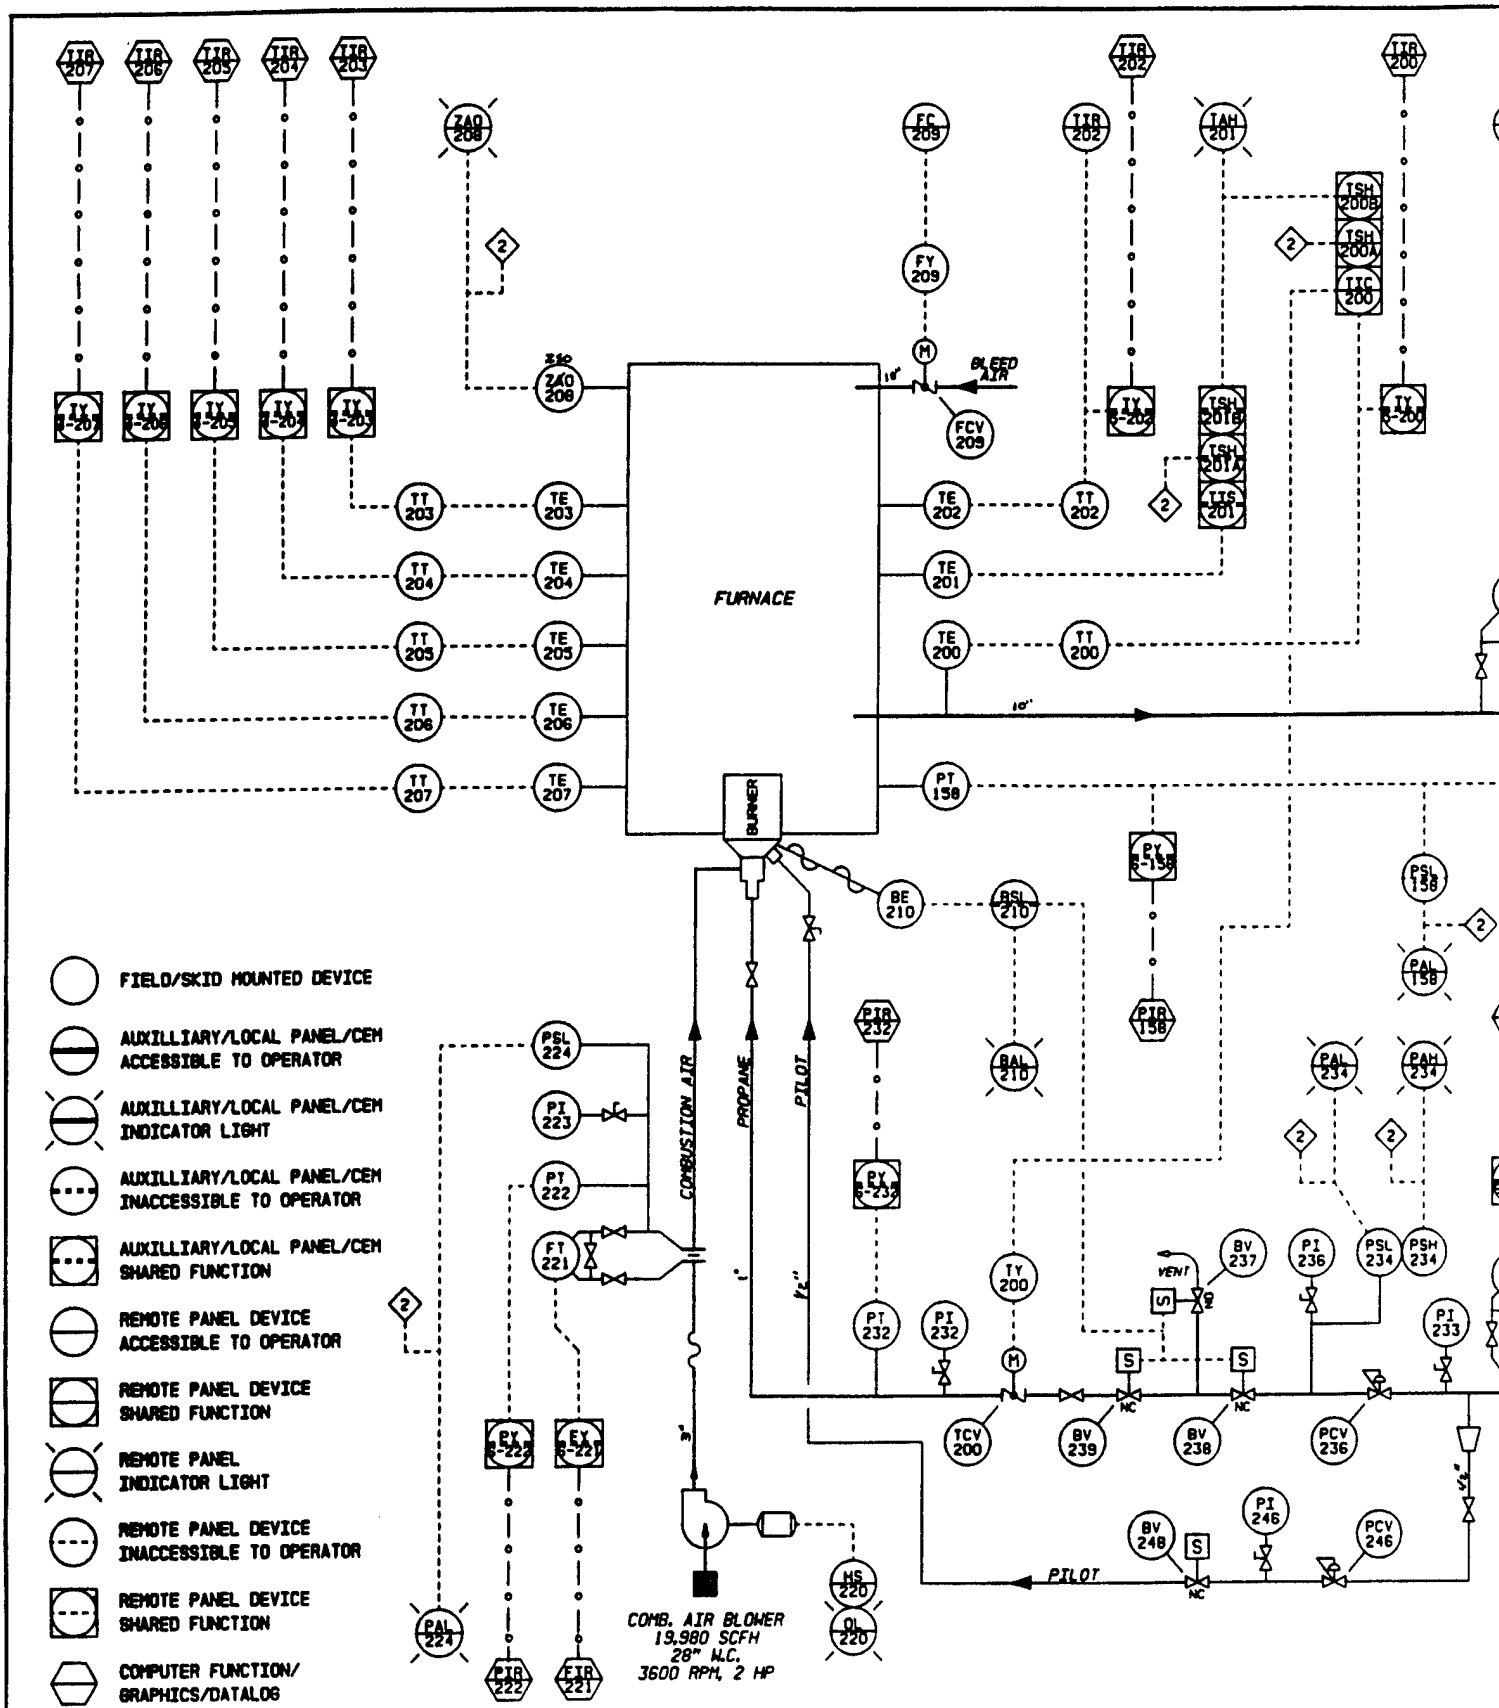

- FIELD/SKID MOUNTED DEVICE
- ◐ AUXILIARY/LOCAL PANEL/CEM ACCESSIBLE TO OPERATOR
- ◑ AUXILIARY/LOCAL PANEL/CEM INDICATOR LIGHT
- ◒ AUXILIARY/LOCAL PANEL/CEM INACCESSIBLE TO OPERATOR
- ◓ AUXILIARY/LOCAL PANEL/CEM SHARED FUNCTION
- ⊖ REMOTE PANEL DEVICE ACCESSIBLE TO OPERATOR
- ⊗ REMOTE PANEL DEVICE SHARED FUNCTION
- ⊘ REMOTE PANEL INDICATOR LIGHT
- ⊙ REMOTE PANEL DEVICE INACCESSIBLE TO OPERATOR
- ◑ REMOTE PANEL DEVICE SHARED FUNCTION
- ⬡ COMPUTER FUNCTION/ GRAPHICS/DATALOG

COMB. AIR BLOWER
13,980 SCFH
28" N.C.
3600 RPM, 2 HP


NO	DATE	APPR	REVISION	NO	DATE	APPR	REVISION
2	8/15/00	CAP	"AS-BUILT" FINAL EQUIPMENT CONFIGURATION				
1	7/17/00	CAP	UPDATED PER L&L AND ARRTech REVISED SUBMITTALS				
-			DRAFT				

**DELIVERY ORDER
HOT-GAS DECOIL**



WEST CHEST 1

①

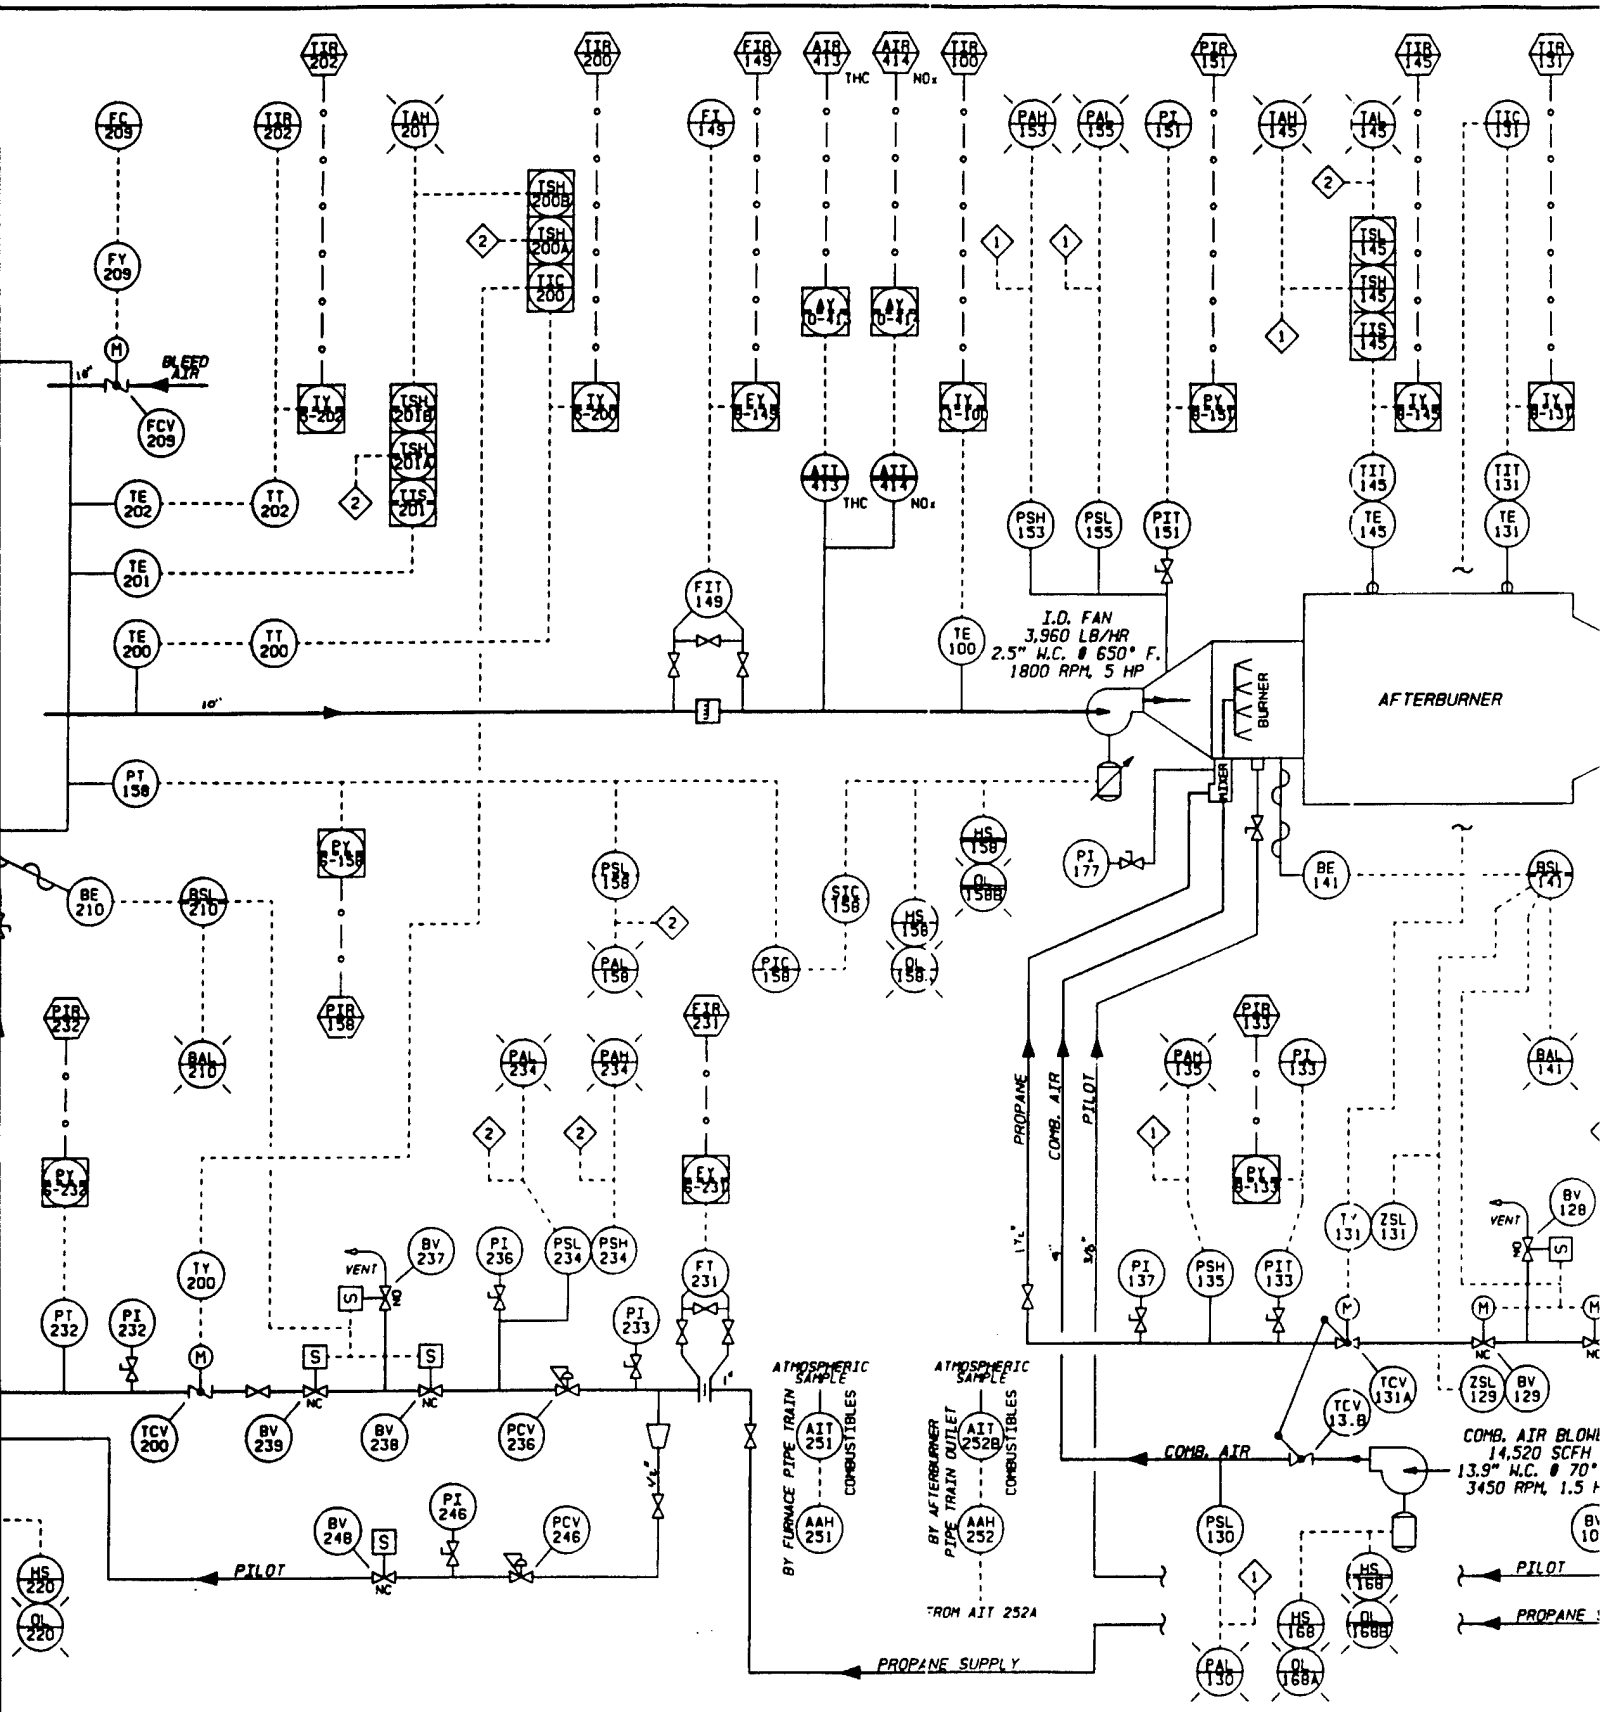

**DELIVERY ORDERS #10 & #12
HOT-GAS DECON SYSTEM**




DESIGN	DATE	CLIENT APPROVALS	DATE
DES: <i>AM</i>	DATE: <i>4/12/92</i>		
PROJ. ENG.			
PROJ. MGR.			
APPROVED:			
APPROVED:			



REVISION	
EQUIPMENT CONFIGURATION	
AND ARRTECH REVISED SUBMITTALS	

PIPIN
R DA
NOT

2

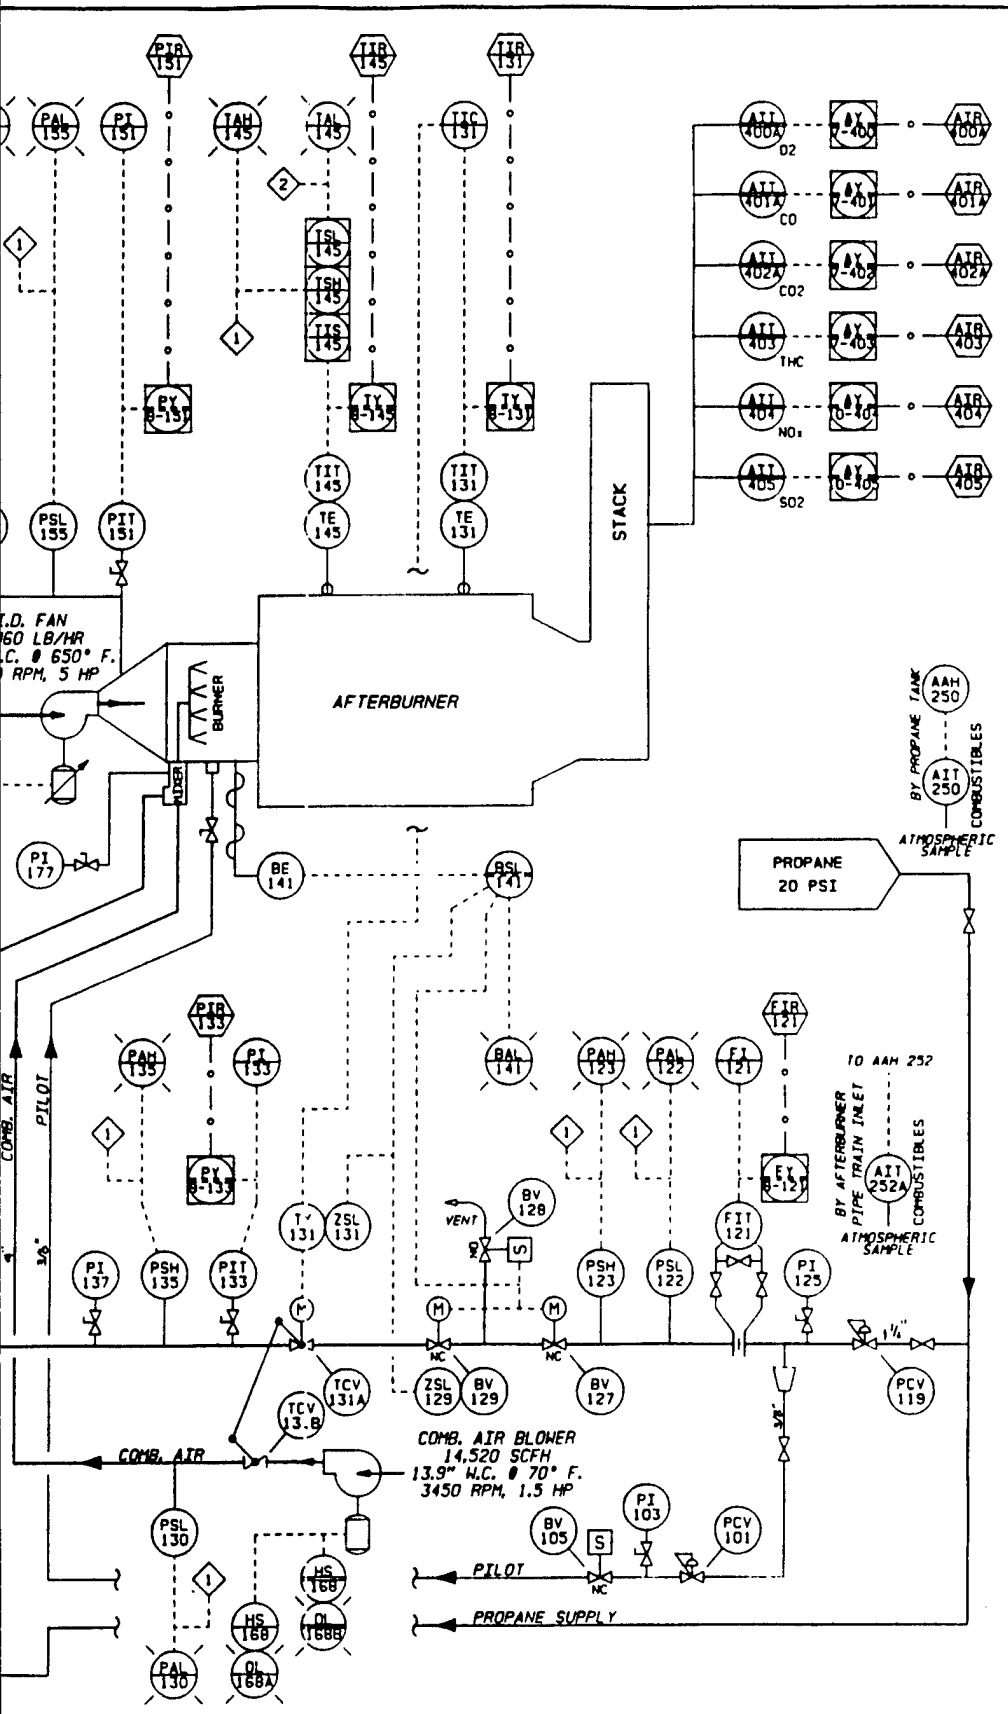

3

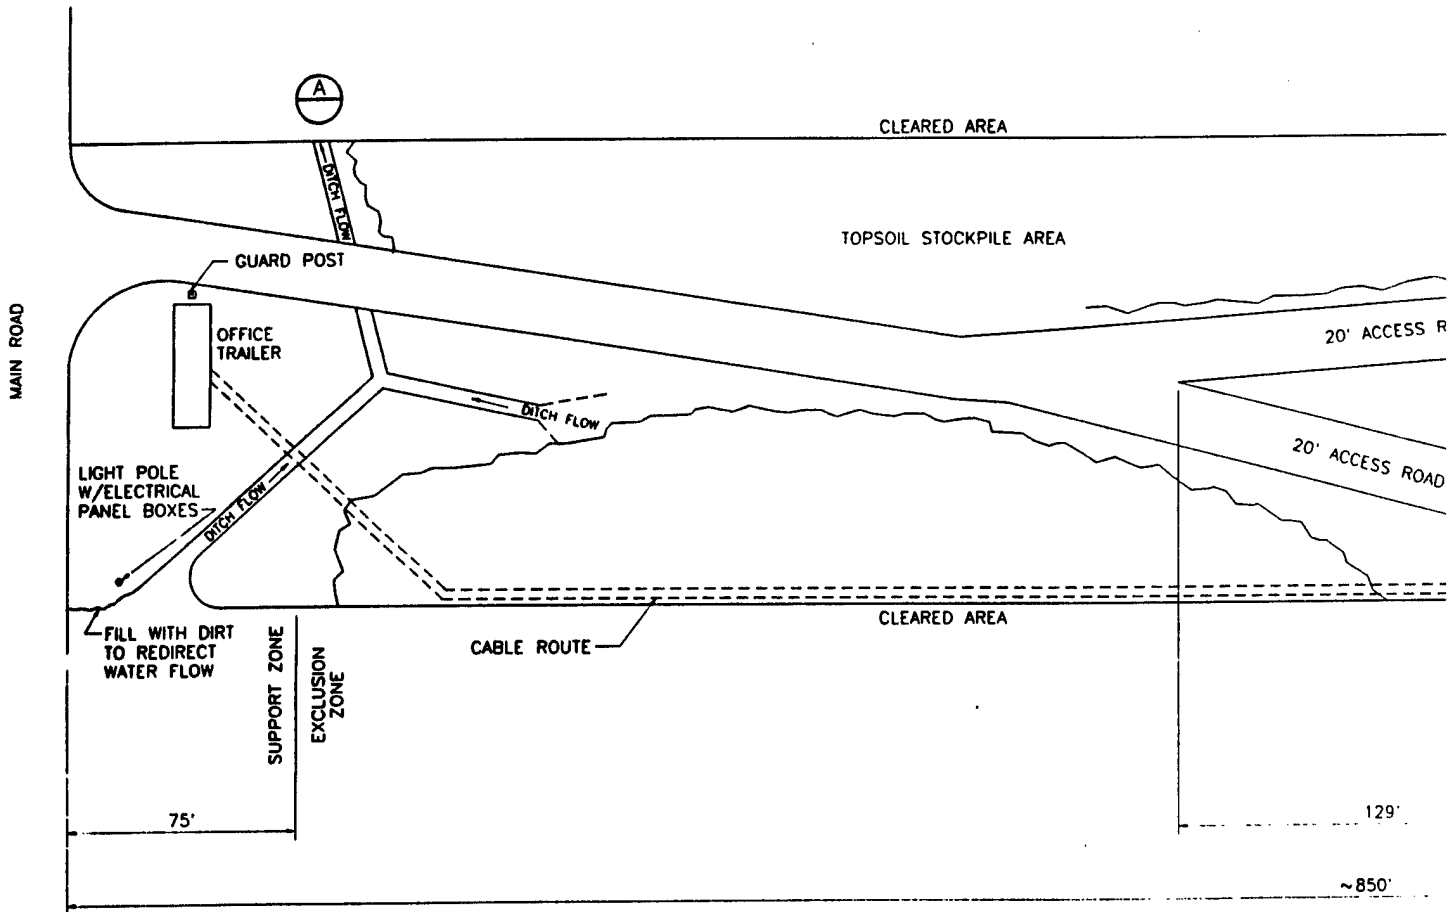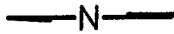


PLOTTED 01/10/96 11:06 am
 PLOT SC 1=350 FILE NO 12122000

NO	DATE	APPR	REVISION	NO	DATE	APPR	REVISION
3	1/10/96	WJW	SHOWN WITH MODIFICATIONS FOR TESTING				
2	1/1/96	WJW	SHOWN WITH TRAILERS AND AS CONSTRUCTED				
1			INITIAL SITE LAYOUT				

US
 DELIVERY ORD

WEST CHESTER

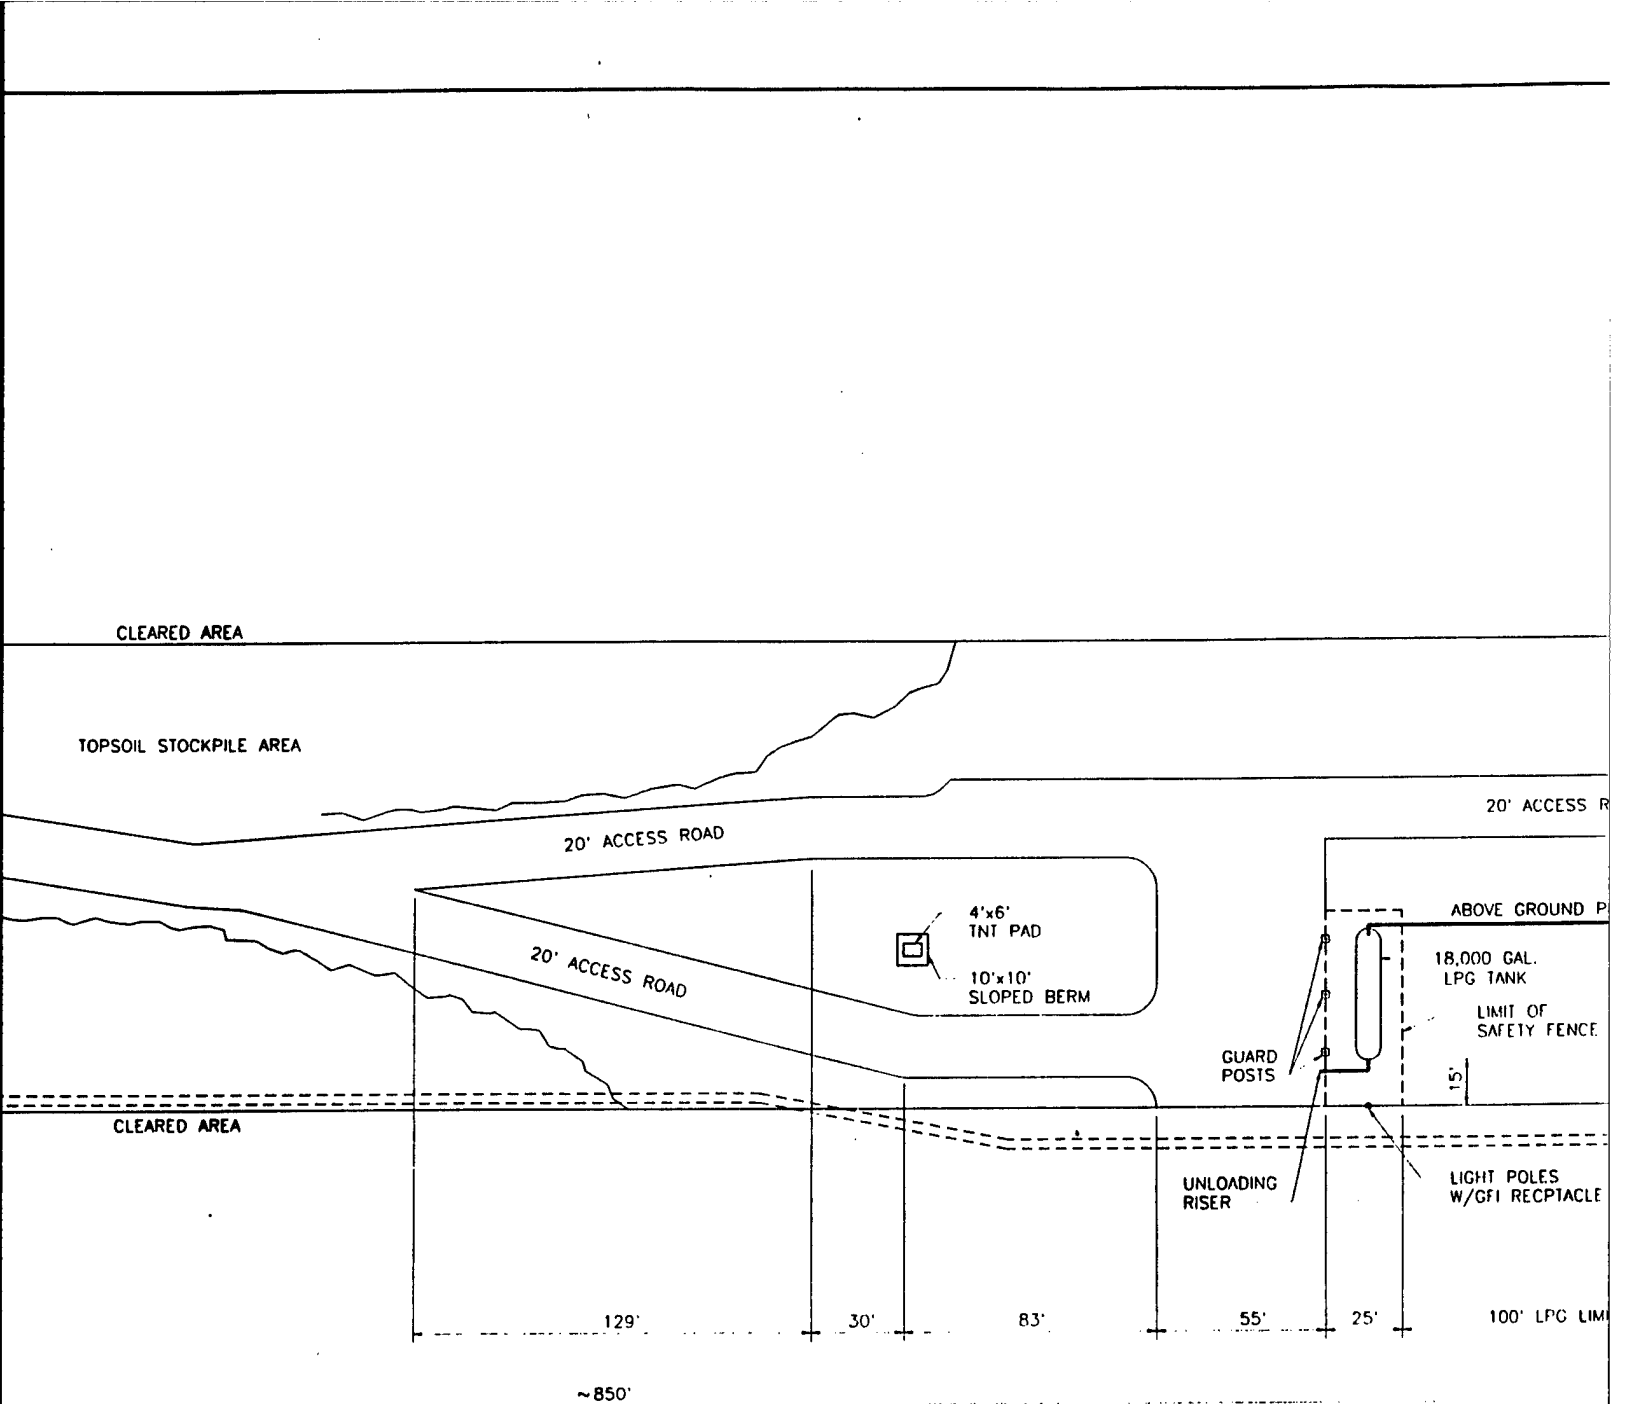

<div style="border: 1px solid black; border-radius: 50%; width: 40px; height: 40px; display: flex; align-items: center; justify-content: center; margin: 0 auto;">2</div>	USACE DELIVERY ORDER #10& #12	CHECKED <i>CA Pader</i> DATE <i>11/11/96</i>	CLIENT APPROVALS _____ DATE _____
		DES. ENG. _____	
		PROJ. ENG. _____	
		PROJ. MGR. _____	
		APPROVED _____	
	APPROVED _____		


REVISION

WEST CHESTER



PENNSYLVANIA


DRAWN
SCALE

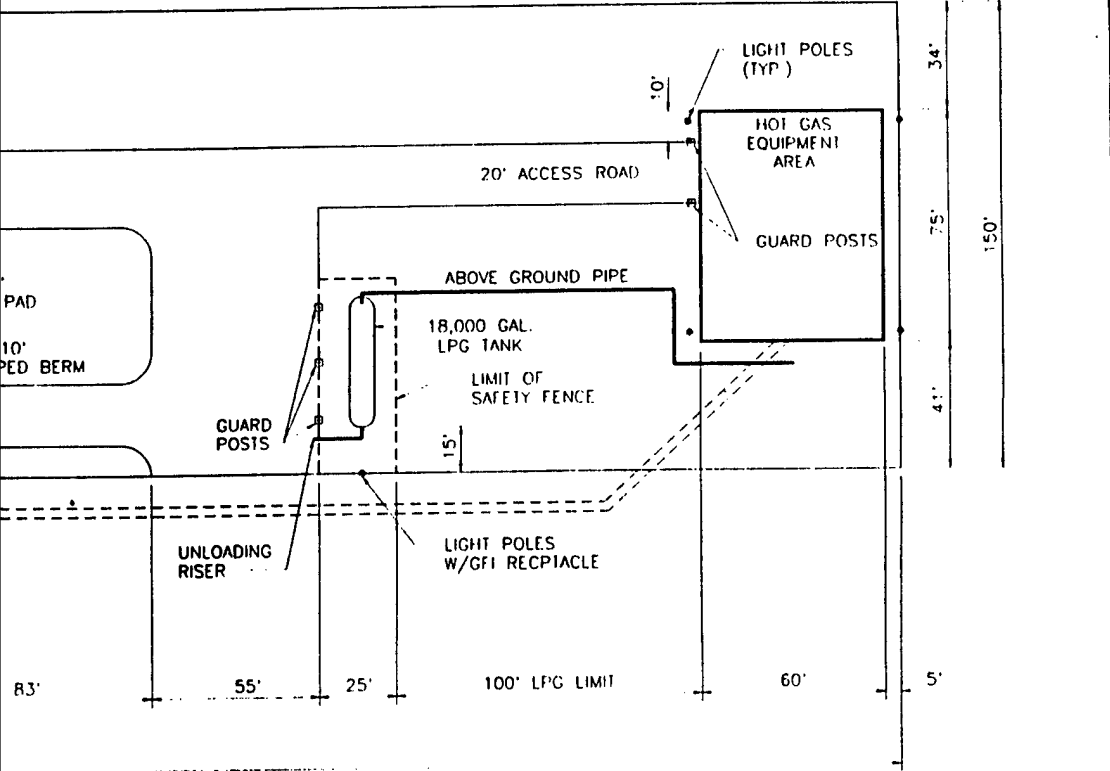

DATE	CLIENT APPROVALS	DATE
11/11/96		

(B)

SITE LAYOUT			
DATE	6/21/95	DRW. NO.	C100
SCALE	1" = 30'	PROJ. NO.	02281-012-012
		SHT.	3

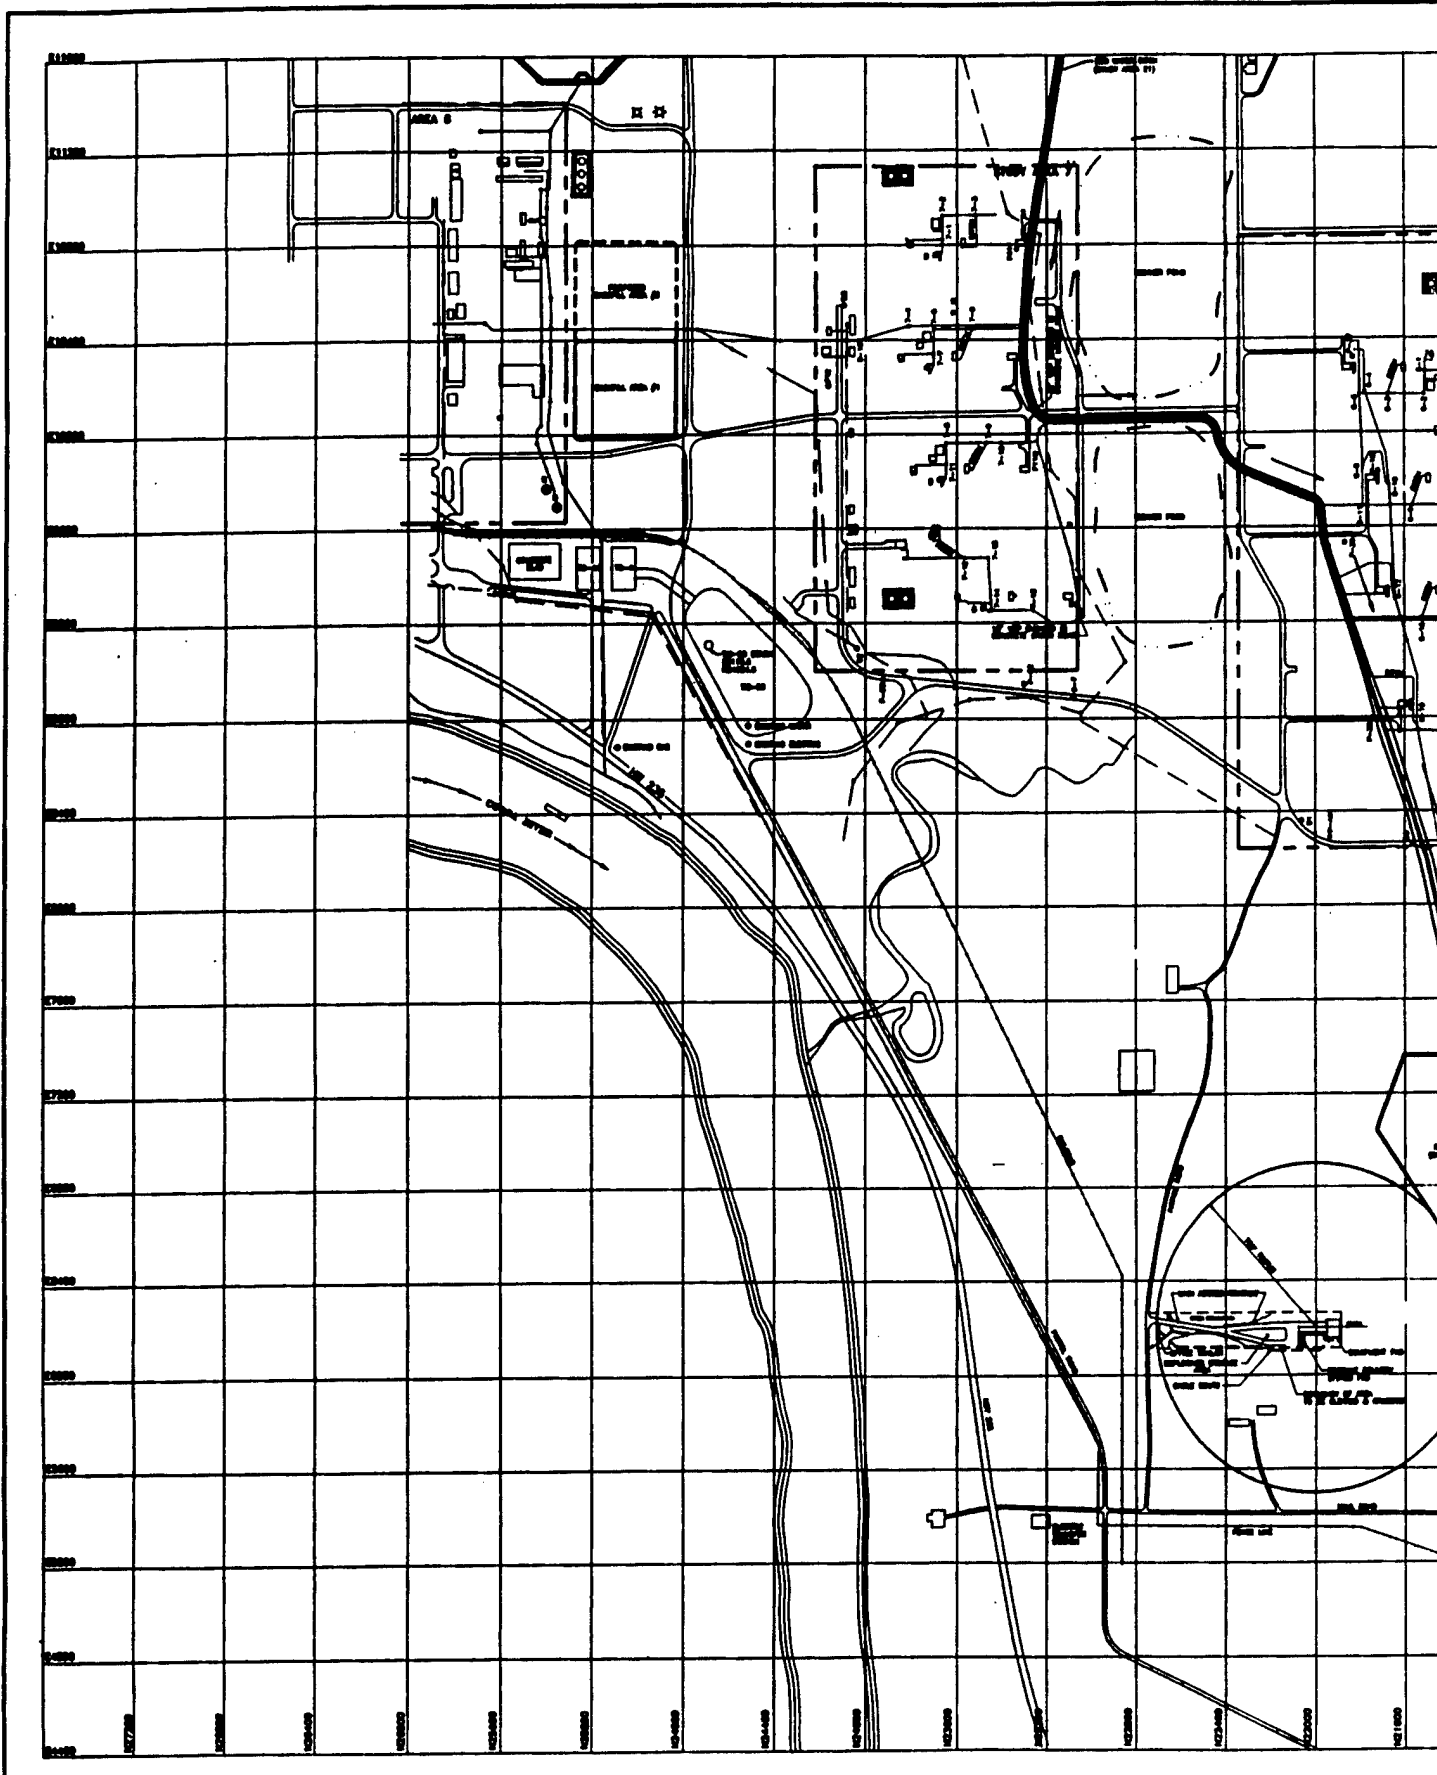

PLOTTED 06/07/96 10:20 am
 PLY. SC. 1-4800 FILE NO. PARKER


NO.	DATE	APPL.	REVISION	NO.	DATE	APPL.	REVISION
				3	8/7/96	CAP	SHOWN WITH MODIFICATIONS FOR TESTING
				2	8/1/96	CAP	ADDED EXPLOSIVES- STORAGE AREA & ADDITIONAL SITE ID'S
				1	8/1/96	CSP	MOVED SITE TO ACCOMMODATE OTHER SITE REMEDIATION ACTIVITIES

DECONTA
 ALPINE




WEST CHESTER

①

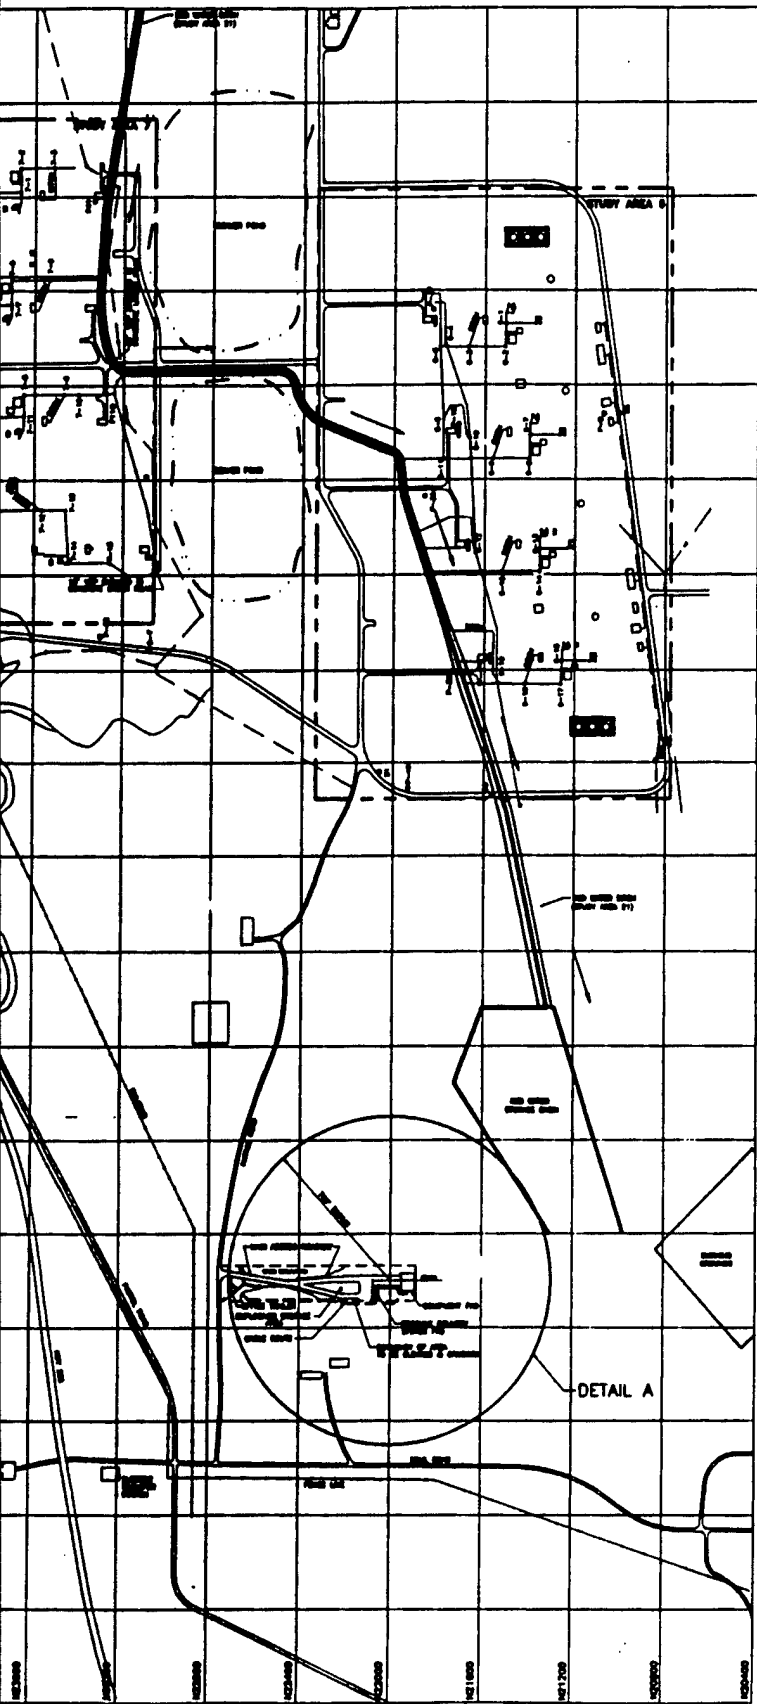

NOTE:
 DRAWINGS ARE APPROXIMATELY SCALED BASED UPON
 PREVIOUS INVESTIGATIVE REPORTS PREPARED BY
 AND A SITE PLAN PREPARED FOR ALABAMA ORDINANCE
 WORKS (SANITARY & INDUSTRIAL WASTE SEWERAGE
 NO. 2, 1946). SITE FEATURES AND OTHER INFORMATION
 PROVIDED IN THIS DRAWING WILL BE VERIFIED DURING
 SITE SURVEY AND SUBSEQUENT REMEDIATION ACTIVITIES.

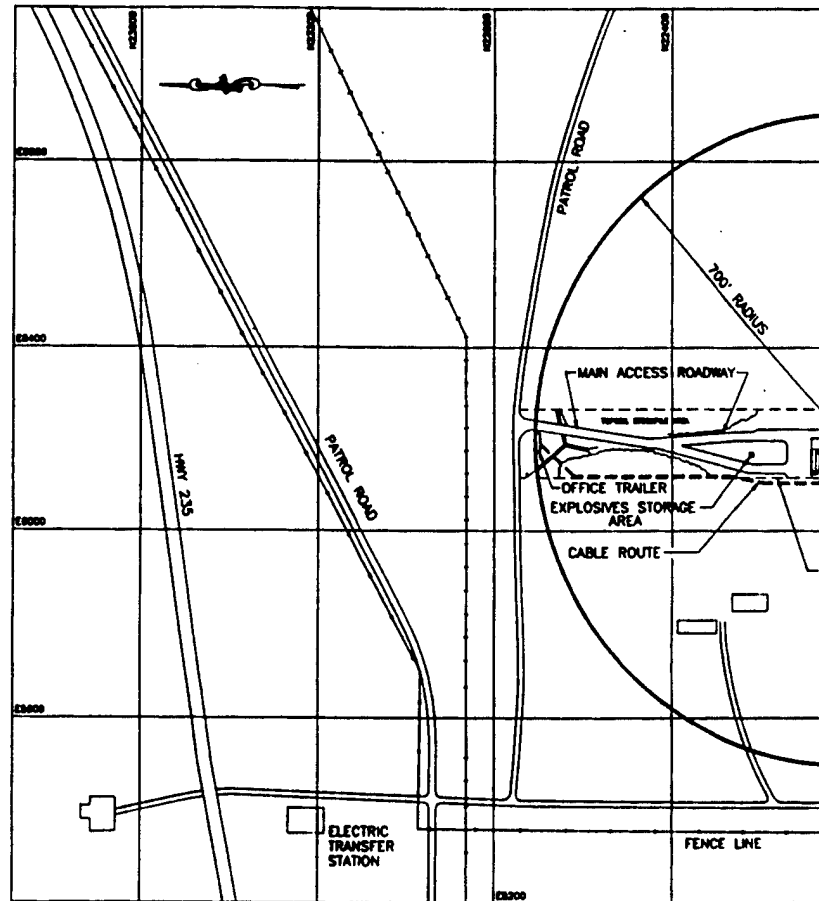


DETAIL A

- LEGEND
- +— RAILROAD TRACKS
 - P41 ⊙ MONITORING WELL
 - MANHOLE
 - EXISTING ROAD
 - FLOW DIRECTION
 - 700' SAFETY ZONE




FOR TESTING RANGE AREA & ADDITIONAL SITE ID'S OTHER SITE REMEDIATION ACTIVITIES REMARKS	HOT-GAS DECONTAMINATION SYSTEM ALPINE ALABAMA		CHECKED	DATE	CLEAR APPROVALS	DATE	HO O R.L. SCALE 1" = 400'	
			DESIGN					
			PROJ. ENG.					
			PROJ. MGR.					
			APPROVED					


NOTE:
 DRAWINGS ARE APPROXIMATELY SCALED BASED UPON
 PREVIOUS INVESTIGATIVE REPORTS PREPARED BY ESE INC.,
 AND A SITE PLAN PREPARED FOR ALABAMA ORDINANCE
 WORKS (SANITARY & INDUSTRIAL WASTE SEWERAGE PLANT
 NO. 2, 1946). SITE FEATURES AND OTHER INFORMATION
 PROVIDED IN THIS DRAWING WILL BE VERIFIED DURING THE
 SITE SURVEY AND SUBSEQUENT REMEDIAL ACTIVITIES.

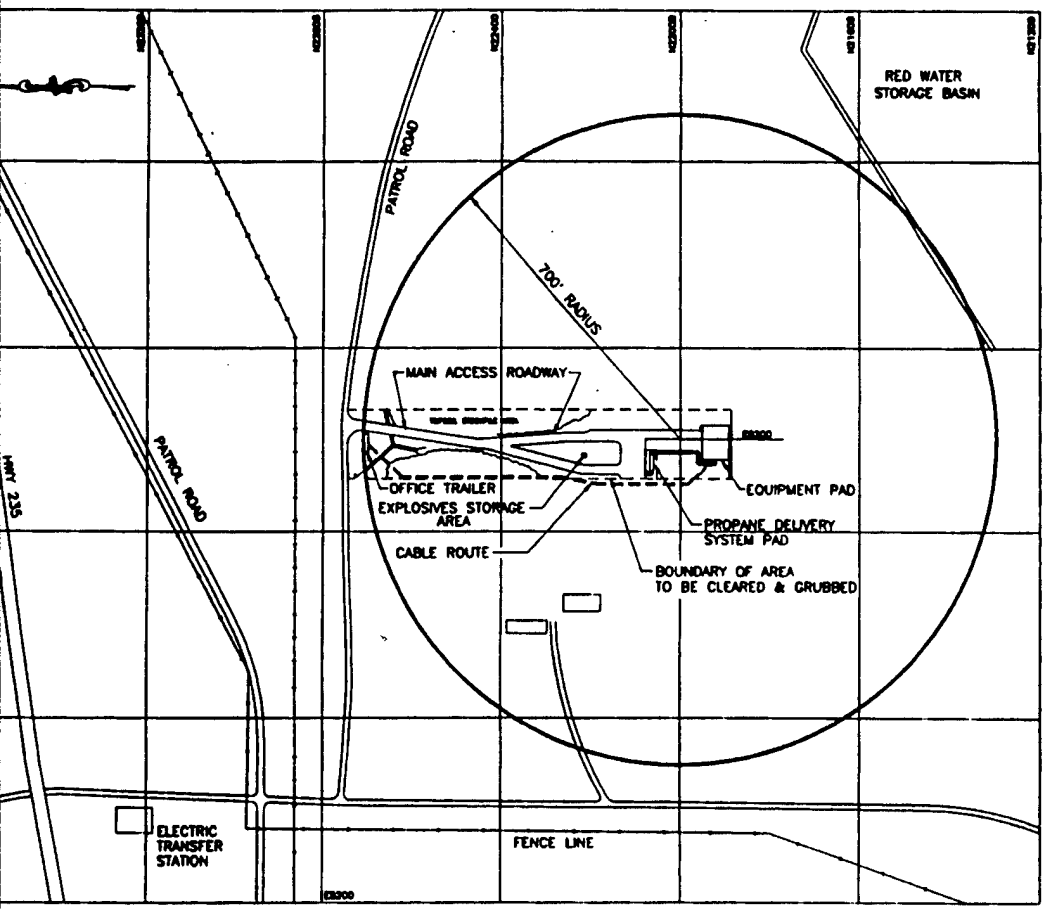

DETAIL A

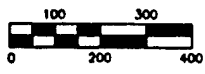

- LEGEND**
- RAILROAD TRACKS
 - MONITORING WELL
 - MANHOLE
 - EXISTING ROAD
 - FLOW DIRECTION
 - 700' SAFETY ZONE

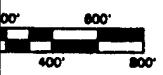

DATE	CLIENT APPROVALS	DATE


**HOT GAS DECON SYSTEM
 OVERALL SITE LAYOUT**

DESIGN	R.L.	DATE	11/9/94	DWG NO	2000	REV. NO	3
SCALE	1" = 400'	DWG. NO.	02281-012-010	BY _____ OF _____			

(3)

PLOTTED 06/07/96 10:22 am
 P.L.T. SC. 1-2400 FILE NO. 12102001


①

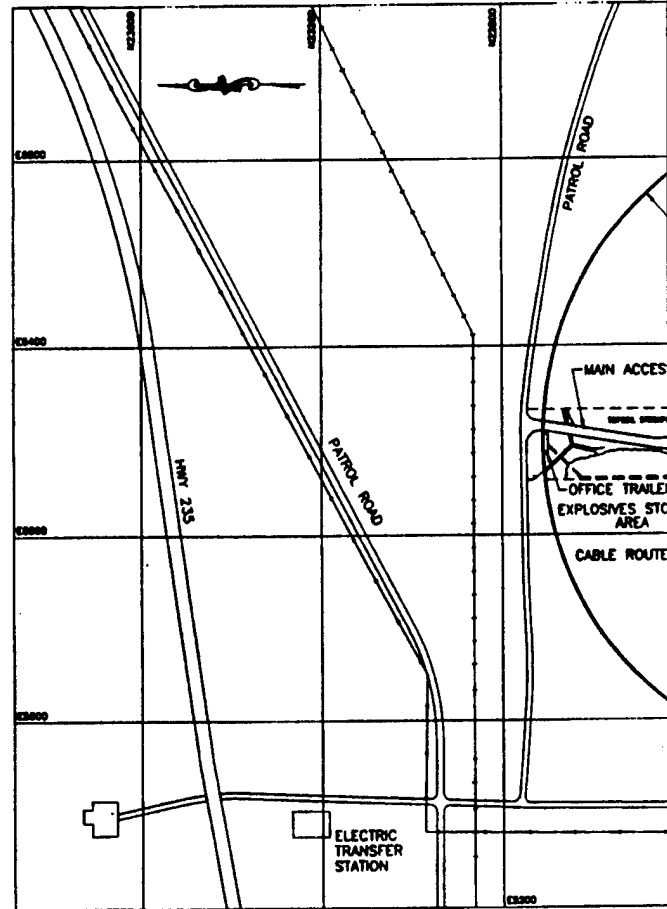

NO	DATE	APPL	REVISION
2	8/7/96	CAP	SHOWN WITH MODIFICATIONS FOR TESTING
1	7/1/96	CAP	ADDED EXPLOSIVES- STORAGE AREA & ADDITIONAL SITE ID'S
-	1/1/96	CAP	ISSUED FOR CONSTRUCTION

HOT -
 DECONTAMINATION
 ALPINE

WEST CHESTER

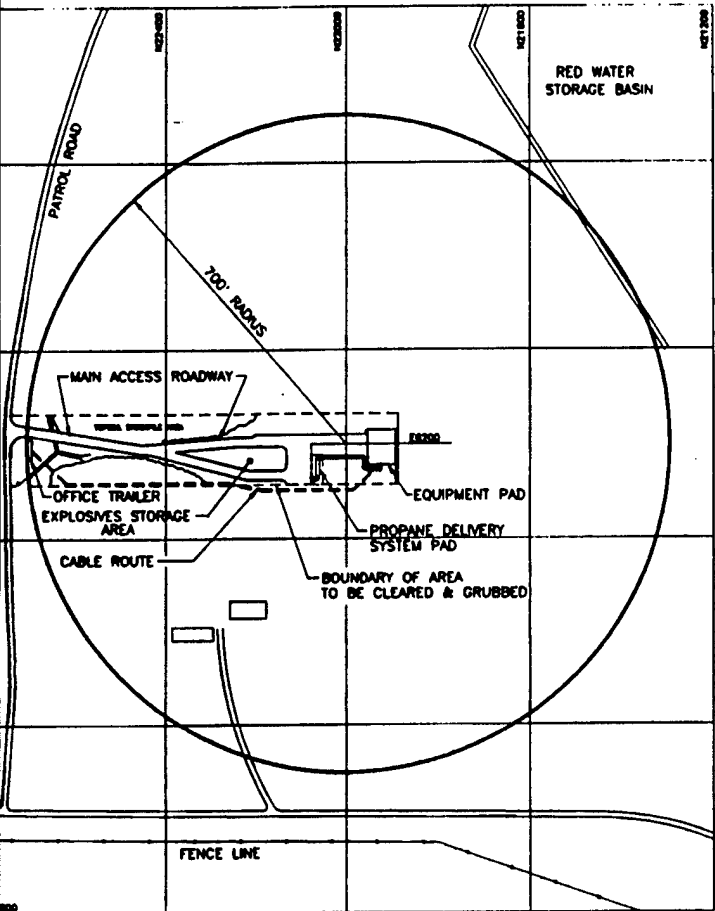

②



HOT - GAS
CONTAMINATION SYSTEM
ALABAMA



FORM 10/94

CHECKED	DATE	CLIENT APPROVALS	DATE
DES. ENG.			
PROJ. ENG.			
PROJ. MGR.			
APPROVED			
APPROVED			

FIGURE 1
SYSTEM SITE LAYOUT

DESIGN	B. DAILY	DATE	11/11/94	DWG. NO.	2001	REV. NO.	2
SCALE	1" = 200'	W.D. NO.	02281-012-010	DATE _____ OF _____			