

-AUGO 932

NEW YORK STATE DEPT OF ENVIRONMENTAL CONSERVATION ALBANY F/G 13/1
NATIONAL DAM SAFETY PROGRAM. CLARK'S CREEK WATERSHED PROJECT SI-FF-
SEP 80 G KOCH


DACW51-79-C-0001

NL

UNCLASSIFIED



END
DATE
FILED
11-80
DTIC

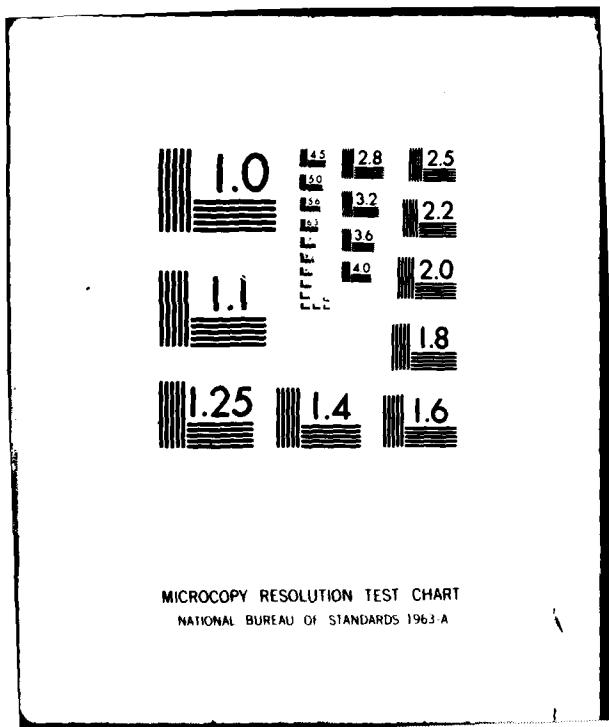

AD A 090932

SECURITY CLASSIFICATION OF THIS PAGE (When Data Entered)

**READ INSTRUCTIONS
BEFORE COMPLETING FORM**

REPORT DOCUMENTATION PAGE		READ INSTRUCTIONS BEFORE COMPLETING FORM	
1. REPORT NUMBER		2. GOVT ACCESSION NO.	
Phase I Inspection Report Clark's Creek Watershed Project Site I Susquehanna River Basin, Chenango County, NY Inventory No. 718		AD-A090932	
3. TITLE (and Subtitle)		4. TYPE OF REPORT & PERIOD COVERED	
Phase I Inspection Report National Dam Safety Program		5. PERFORMING ORG. REPORT NUMBER	
6. CONTRACT OR GRANT NUMBER(s)			
George Koch		✓DACW-51-79-C-0001	
7. AUTHOR(s)			
8. PERFORMING ORGANIZATION NAME AND ADDRESS New York State Department of Environmental Conservation Albany, NY 12233		10. PROGRAM ELEMENT, PROJECT, TASK AREA & WORK UNIT NUMBERS	
9. CONTROLLING OFFICE NAME AND ADDRESS New York State Department of Environmental Conservation Albany, NY 12233		12. REPORT DATE 30 September 1980	
11. MONITORING AGENCY NAME & ADDRESS (if different from Controlling Office) Department of the Army 26 Federal Plaza New York District, CofE New York, NY 10287		13. NUMBER OF PAGES UNCLASSIFIED	
14. SECURITY CLASS. (of this report)			
15. DECLASSIFICATION/DOWNGRADING SCHEDULE			
16. DISTRIBUTION STATEMENT (of this Report) Approved for public release; Distribution unlimited.			
17. DISTRIBUTION STATEMENT (of the abstract entered in Block 20, if different from Report)			
18. SUPPLEMENTARY NOTES THIS DOCUMENT IS BEST QUALITY PRACTICABLE. THE COPY FURNISHED TO DDC CONTAINED A SIGNIFICANT NUMBER OF PAGES WHICH DO NOT REFLECT THE ORIGINAL. S A			
19. KEY WORDS (Continue on reverse side if necessary and identify by block number) Dam Safety National Dam Safety Program Visual Inspection Hydrology, Structural Stability			
Clark's Creek Chenango County Susquehanna River			
20. ABSTRACT (Continue on reverse side if necessary and identify by block number) This report provides information and analysis on the physical condition of the dam as of the report date. Information and analysis are based on visual inspection of the dam by the performing organization. The examination of documents and visual inspection of the Clark's Creek Site 1 Dam did not reveal conditions which constitute a hazard to human life or property.			


FILE COPY

SECURITY CLASSIFICATION OF THIS PAGE(When Data Entered)

The total discharge capacity of the spillways is adequate to impound and safely discharge the floodwaters resulting from the Probable Maximum Flood (PMF).

Several minor deficiencies were noted which should be corrected within 6 months of the date of final approval of this report. The required actions are cutting brush and trees which are growing near the riser and in the vicinity of the plunge pool and investigating the wet area in the bottom of the auxiliary spillway channel. In addition, an emergency action plan for notification of downstream residents should be developed within the same time frame.

SECURITY CLASSIFICATION OF THIS PAGE(When Data Entered)

 

DISCLAIMER NOTICE

**THIS DOCUMENT IS BEST QUALITY
PRACTICABLE. THE COPY FURNISHED
TO DTIC CONTAINED A SIGNIFICANT
NUMBER OF PAGES WHICH DO NOT
REPRODUCE LEGIBLY.**

PREFACE


This report is prepared under guidance contained in the Recommended Guidelines for Safety Inspection of Dams, for Phase I Investigations. Copies of these guidelines may be obtained from the Office of Chief of Engineers, Washington, D.C. 20314. The purpose of a Phase I Investigation is to identify expeditiously those dams which may pose hazards to human life or property. The assessment of the general condition of the dam is based upon available data and visual inspections. Detailed investigation, and analyses involving topographic mapping, subsurface investigations, testing, and detailed computational evaluations are beyond the scope of a Phase I Investigation; however, the investigation is intended to identify any need for such studies.

In reviewing this report, it should be realized that the reported condition of the dam is based on observations of field conditions at the time of inspection along with data available to the inspection team. In cases where the reservoir was lowered or drained prior to inspection, such action, while improving the stability and safety of the dam, removes the normal load on the structure and may obscure certain conditions which might otherwise be detectable if inspected under the normal operating environment of the structure.

It is important to note that the condition of a dam depends on numerous and constantly changing internal and external conditions, and is evolutionary in nature. It would be incorrect to assume that the present condition of the dam will continue to represent the condition of the dam at some point in the future. Only through frequent inspections can unsafe conditions be detected and only through continued care and maintenance can these conditions be prevented or corrected.

Phase I inspections are not intended to provide detailed hydrologic and hydraulic analyses. In accordance with the established Guidelines, the Spillway Test flood is based on the estimated "Probable Maximum Flood" for the region (greatest reasonably possible storm runoff), or fractions thereof. Because of the magnitude and rarity of such a storm event, a finding that a spillway will not pass the test flood should not be interpreted as necessarily posing a highly inadequate condition. The test flood provides a measure of relative spillway capacity and serves as an aide in determining the need for more detailed hydrologic and hydraulic studies, considering the size of the dam, its general condition and the downstream damage potential.

Accession For	
NTIS GRA&I	<input checked="" type="checkbox"/>
DTIC TAB	<input type="checkbox"/>
Unannounced	<input type="checkbox"/>
Justification	
By _____	
Distribution/	
Availability Codes	
Distr	Avail and/or Special
A	23 90

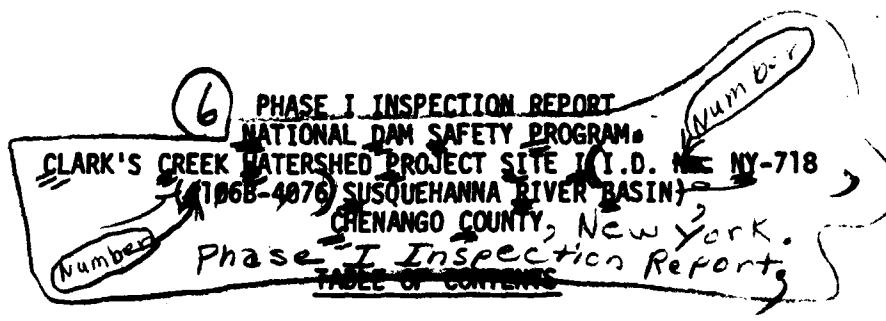

	<u>PAGE NO.</u>
- ASSESSMENT	-
- OVERVIEW PHOTOGRAPH	-
1 PROJECT INFORMATION	1
1.1 GENERAL	1
1.2 DESCRIPTION OF PROJECT	1
1.3 PERTINENT DATA	2
2 ENGINEERING DATA	4
2.1 GEOTECHNICAL DATA	4
2.2 DESIGN RECORDS	4
2.3 CONSTRUCTION RECORDS	4
2.4 OPERATION RECORDS	4
2.5 EVALUATION OF DATA	4
3 VISUAL INSPECTION	5
3.1 FINDINGS	5
3.2 EVALUATION OF OBSERVATIONS	5
4 OPERATION AND MAINTENANCE PROCEDURES	6
4.1 PROCEDURE	6
4.2 MAINTENANCE OF DAM	6
4.3 WARNING SYSTEM IN EFFECT	6
4.4 EVALUATION	6

393970

JCB

	<u>PAGE NO.</u>
5 HYDROLOGIC/HYDRAULIC	7
5.1 DRAINAGE AREA CHARACTERISTICS	7
5.2 ANALYSIS CRITERIA	7
5.3 SPILLWAY CAPACITY	7
5.4 RESERVOIR CAPACITY	7
5.5 FLOODS OF RECORD	7
5.6 OVERTOPPING POTENTIAL	7
5.7 EVALUATION	7
6 STRUCTURAL STABILITY	8
6.1 EVALUATION OF STRUCTURAL STABILITY	8
7 ASSESSMENT/RECOMMENDATIONS	9
7.1 ASSESSMENT	9
7.2 RECOMMENDED MEASURES	9

APPENDIX

- A. PHOTOGRAPHS
- B. VISUAL INSPECTION CHECKLIST
- C. HYDROLOGIC/HYDRAULIC: ENGINEERING DATA AND COMPUTATIONS
- D. STABILITY COMPUTATIONS
- E. REFERENCES
- F. DRAWINGS

PHASE I INSPECTION REPORT
NATIONAL DAM SAFETY PROGRAM

Name of Dam: Clark's Creek Watershed Project Site 1
I.D. No. NY-718

State Located: New York

County Located: Chenango

Watershed: Susquehanna River Basin


Date of Inspection: July 31, 1980

ASSESSMENT


The examination of documents and visual inspection of the Clark's Creek Site 1 Dam did not reveal conditions which constitute a hazard to human life or property.

The total discharge capacity of the spillways is adequate to impound and safely discharge the floodwaters resulting from the Probable Maximum Flood (PMF).

Several minor deficiencies were noted which should be corrected within 6 months of the date of final approval of this report. The required actions are cutting brush and trees which are growing near the riser end in the vicinity of the plunge pool and investigating the wet area in the bottom of the auxiliary spillway channel. In addition, an emergency action plan for notification of downstream residents should be developed within the same time frame.

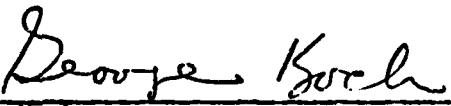
George Koch
Chief, Dam Safety Section
New York State Department
of Environmental Conservation
NY License No. 45937

Approved By:

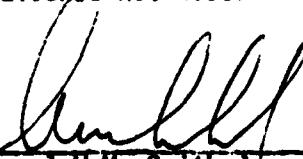
Colonel W.M. Smith Jr.
New York District Engineer

Date:


30 Sep 80

OVERVIEW
CLARK'S CREEK WATERSHED PROJECT
SITE 1
I.D. No. NY-718



PHASE I INSPECTION REPORT
NATIONAL DAM SAFETY PROGRAM
CLARK'S CREEK WATERSHED PROJECT
SITE I
I.D. No. NY-718
(#106B-4076)
SUSQUEHANNA RIVER BASIN
CHENANGO COUNTY, NEW YORK

SECTION 1: PROJECT INFORMATION

1.1 GENERAL

a. Authority

The Phase I inspection reported herein was authorized by the Department of the Army, New York District, Corps of Engineers, to fulfill the requirements of the National Dam Inspection Act, Public Law 92-367.

b. Purpose of Inspection

This inspection was conducted to evaluate the existing conditions of the dam, to identify deficiencies and hazardous conditions, to determine if these deficiencies constitute hazards to life and property, and to recommend remedial measures where required.

1.2 DESCRIPTION OF PROJECT

a. Description of Dam

→ The Clark's Creek Watershed Project Site I dam consists of an earth dam with a service spillway pipe passing through the embankment and an excavated auxiliary spillway passing around the eastern end of the dam.

The dam consists of a compacted earth embankment which is 46 feet high, has a crest length of 1250 feet and a crest width of 16 feet. The upstream slope is 1 vertical on 3 horizontal with a 10 foot wide berm near the base of the slope. The downstream slope is 1 vertical on 2.5 horizontal. The crest and exposed slopes are covered with grass and crownvetch. An earth cutoff trench of varying depth and width keys the embankment into the foundation soils. → [unclear]

The service spillway consists of a two-stage rectangular concrete drop inlet structure, a 30 inch diameter reinforced concrete pipe with anti-seepage collars and a riprapped plunge pool. A reservoir drain consisting of a 12 inch diameter cast iron pipe extends from the upstream toe of the embankment to the base of the spillway riser. A vertical slide gate mechanism mounted along the inside of the riser controls the flow through the reservoir drain. The auxiliary spillway is an earth cut with a bottom width of 200 feet.

An internal drainage system consisting of a gravel and stone filter is located at the base of the embankment near the downstream toe. Seepage is conducted through this drain to beyond the toe of the embankment via twin 6 inch diameter asbestos-cement pipes.

b. Location

The Clark's Creek Watershed Project Site I Dam is located off McCall Road

in the Town of Oxford. The structure is approximately one mile northwest of the Village of Oxford.

c. Size Classification

The dam is 46 feet high and has a maximum storage capacity of 200 acre feet. Therefore, the dam is in the intermediate size category as defined by the "Recommended Guidelines for Safety Inspection of Dams".

d. Hazard Classification

This dam is classified as "high" hazard due to the presence of a number of homes in the Village of Oxford located downstream of the dam.

e. Ownership

The dam is owned by Chenango County, New York and maintained by the Village of Oxford. The contracting officer is Mr. Phillip Cummings whose telephone number is (607)334-4632.

f. Purpose of Dam

The dam is a floodwater retarding structure.

g. Design and Construction History

The dam was designed by the U.S. Department of Agriculture, Soil Conservation Service (SCS). The SCS office at the Broome County Airport has a design folder containing hydrologic, hydraulic and structural design information. The dam was under construction from 1972-74 by the Jones and Mead Construction Company of Appalachia, New York.

h. Normal Operating Procedures

Normal flows are discharged through the service spillway. This structure has sufficient capacity to store and discharge a 100 year flood without discharge occurring in the auxiliary spillway. For storms in excess of the 100 year flood, discharge through the auxiliary spillway can be expected.

1.3 PERTINENT DATA

a. Drainage Area (acres)	536
b. Discharge at Dam (cfs)	
Service Spillway at maximum high water	160
Service Spillway at auxiliary spillway crest elev.	91
Auxiliary Spillway at maximum high water	4,966
Reservoir drain at service spillway crest elev.	21
c. Elevation (USGS Datum)	
Top of Dam	1361.6
Auxiliary Spillway Crest	1357.2
Service Spillway Crest - High Stage	1355.9
- Low Stage	1335.1
Reservoir Drain (invert elevation)	1319.9
d. Reservoir Surface Area (acres)	
Top of Dam	17.6
Auxiliary Spillway Crest	13.3
Service Spillway Crest	12.2

e. Storage Capacity (acre-feet)

Top of Dam	199.8
Auxiliary Spillway Crest	129.0
Service Spillway Crest	113.0

f. Dam

Embankment type - A compacted earth fill with a rock zone, a keyed earth cut-off trench, and a drain parallel to axis of dam.

Embankment length (ft)	1250
Slopes-Upstream	1 vertical on 3 horizontal
-Downstream	1 vertical on 2.5 horizontal
Crest Width (ft)	16

g. Service Spillway

Type: Two Stage, ungated, reinforced concrete drop inlet (2.5 x 7.5 ft), rising 39 feet above the invert of the 30 inch diameter concrete conduit; length of conduit 240 feet.

Weir length (ft)	15.0
------------------	------

h. Auxiliary Spillway

Type: An excavated trapezoidal channel.

Bottom Width (ft)	200
Side Slopes (V:H)	1:3
Exit Slope (ft/ft)	0.020

i. Reservoir Drain

Type: 12 inch diameter cast iron pipe

Control: Manually operated vertical slide gate mounted along the inside of the service spillway riser.

SECTION 2: ENGINEERING DATA

2.1 GEOTECHNICAL DATA

a. Geology

The Clark's Creek Watershed Project Site I Dam is located in the glaciated portion of the Appalachian uplands (northern extreme of the Appalachian Plateau) physiographic province of New York State. These uplands were formed by dissection of the uplifted but flat lying sandstones and shales of the Middle and Upper Devonian Catskill Delta. The plateau surface is represented by flat-topped divides with drainage generally southwest toward the Susquehanna River system.

The present surficial deposits have resulted primarily from glaciations during the Cenozoic Era, the last of which was the Wisconsin glaciation.

b. Subsurface Investigations

A subsurface investigation program was conducted by SCS during the design process in 1971. This program consisted of 4 drill holes and 25 test pits at locations along the dam, auxiliary spillway, structural elements and borrow area. Applicable subsurface information has been included in Appendix F.

In general, the soils in the vicinity of the dam are of glacial till origin and consist of silty sand with some gravel. The soils encountered had slight permeability.

2.2 DESIGN RECORDS

The dam was designed by the Soil Conservation Service, who prepared a design report. A folder containing the design report and other design information was available at the SCS office at the Broome County Airport. Twenty-two drawings, several of which have been included in Appendix F, were prepared for the construction of this dam.

2.3 CONSTRUCTION RECORDS

Complete construction records are available from the SCS office at the Broome County Airport. As built plans have been included in Appendix F.

2.4 OPERATION RECORDS

Since the dam is an uncontrolled, floodwater retarding structure, no operating records are maintained regarding water levels. During periods of heavy rainfall, SCS personnel do monitor reservoir levels.

2.5 EVALUATION OF DATA

The data presented in this report has been compiled from information obtained from the Soil Conservation Service as well as the New York State Department of Environmental Conservation files. It appears to be adequate and reliable for Phase I inspection purposes.

SECTION 3: VISUAL INSPECTION

3.1 FINDINGS

a. General

Visual inspection of the Site I dam was conducted on July 31, 1980. The weather was clear and the temperature was in the seventies. The water surface at the time of the inspection was at the low stage orifice elevation on the principal spillway riser.

b. Embankment

No signs of distress were observed in the earth embankment and no evidence of seepage, misalignment, subsidence or surface cracking were noted on the embankment. The only deficiencies noted were of a minor nature. There was some brush growing near the toe of the upstream slope in the vicinity of the riser. There were several spots on the downstream slope where the grass was somewhat sparse.

An internal drainage system composed of 2-6 inch diameter pipes surrounded by "drain fill" material and extending parallel to the axis of the dam provides drainage at the base of the embankment. At the time of the inspection, both pipes were dry.

c. Service Spillway

The service spillway consists of a vertical drop inlet structure, a reinforced concrete pipe, a plunge pool at the outlet to the conduit, and an outlet channel. The height of the riser made it impossible to inspect the top or interior of the structure. All elements which were visible appeared to be in good condition. There was brush and small willow trees growing at the outlet to the plunge pool.

d. Auxiliary Spillway

The auxiliary spillway for this structure is located in an earth cut at the eastern end of the dam. The channel bottom has a good grass cover which had recently been mowed. A wet area extends along the upstream portion along eastern side of the spillway. This area is up to 25 feet wide and over 300 feet long. It is caused by water flowing from the outer cut slope which forms the spillway channel side.

e. Reservoir Drain

The 12 inch diameter reservoir drain and manually operated slide gate may be used to lower the reservoir. The drain was reported to be operational.

f. Reservoir

There were no signs of soil instability in the reservoir area.

3.2 EVALUATION OF OBSERVATIONS

Visual inspection of this dam revealed the following deficiencies:

1. A small amount of brush growing near the riser on the lower portion of the upstream slope.
2. Brush and small trees growing immediately downstream of the plunge pool.
3. A wet area in the bottom of the auxiliary spillway channel.

SECTION 4: OPERATION AND MAINTENANCE PROCEDURES

4.1 PROCEDURES

The normal water surface elevation is at the low stage elevation of the principal spillway riser. Downstream flows are limited by the flow into the principal spillway riser, except during periods of extremely heavy runoff when the auxiliary spillway is in service.

4.2 MAINTENANCE OF THE DAM

The dam is maintained by the Village of Oxford through an agreement with the owner, Chenango County. While there were some minor deficiencies noted, this dam was generally well maintained.

4.3 WARNING SYSTEM IN EFFECT

There is no warning system in effect.

4.4 EVALUATION

The operation and maintenance procedures for this dam are satisfactory.

SECTION 5: HYDROLOGIC/HYDRAULIC

5.1 DRAINAGE AREA CHARACTERISTICS

Delineation of the 536 acre watershed of the Site I dam was made using the USGS 7.5 minute quadrangle for Oxford, New York. The watershed consists of open grassed fields and woodlands. Relief in the drainage area ranges from moderate to steep.

5.2 ANALYSIS CRITERIA

The analysis of the floodwater retarding capability of this dam was performed using the Corps of Engineers HEC-1 computer program, Dam Safety version. This program develops an inflow hydrograph using the "Snyder Synthetic Unit Hydrograph" method and then uses the "Modified Puls" flood routing procedure. The spillway design flood selected was the Probable Maximum Flood (PMF) in accordance with the Recommended Guidelines of the U.S. Army Corps of Engineers.

5.3 SPILLWAY CAPACITY

The principal and auxiliary spillways are ungated structures. The capacities for both spillways were taken from the stage-discharge data included in the SCS design report.

The spillways have sufficient capacity for discharging the peak outflow from the PMF. For this storm, the peak inflow is 1,577 cfs and the peak outflow is 1,567 cfs. When the spillways are discharging the peak outflow the water surface will be 2.5 feet below the top of the dam. Further information concerning this analysis is included in Appendix C.

5.4 RESERVOIR CAPACITY

Normal flood control storage capacity of the reservoir between the principal and auxiliary spillway is 16 acre-feet which is equivalent to a runoff depth of 0.4 inches over the drainage area. Surcharge storage capacity to the maximum high water elevation is an additional 71 acre feet, equivalent to a runoff depth over the drainage area of 1.6 inches. Total storage capacity of the dam is 200 acre-feet.

5.5 FLOODS OF RECORD

The maximum known flood occurred on February 24, 1975. The pool level at this time was reported to be about 12.3 feet above the principal spillway crest. The calculated discharge for this flood is as follows:

<u>Elevation (USGS)</u>	<u>Discharge (cfs)</u>
1374.4	17

5.6 OVERTOPPING POTENTIAL

Analysis indicates that the total discharge capacity is sufficient to prevent overtopping from the PMF.

5.7 EVALUATION

This dam has sufficient capability to impound and adequately discharge floodwaters expected to result from the PMF.

SECTION 6: STRUCTURAL STABILITY

6.1 EVALUATION OF STRUCTURAL STABILITY

a. Visual Observations

No signs of distress were observed in connection with the earth embankment.

b. Design and Construction Data

Design data was obtained from the Soil Conservation office at the Broome County airport. Stability analyses were performed using a Swedish circle method of analysis. One undrained triaxial shear test and one direct shear test was performed on compacted soil samples from the proposed borrow area. These tests were used to select soil parameters for use in the analysis. Various conditions were analyzed in the stability analysis. The conditions applicable to the dam as it was constructed are as follows:

<u>CONDITION</u>	<u>UPSTREAM SLOPE</u>	<u>MINIMUM FACTOR OF SAFETY</u>	<u>DOWNTSTREAM SLOPE</u>
Full Draw Down	1.57	-	-
Long Term Steady State Seepage	-	-	1.62

The calculated factors of safety for this dam are considered to be adequate.

c. Seismic Stability

No seismic stability analysis was performed for this structure.

SECTION 7: ASSESSMENT/RECOMMENDATIONS

7.1 ASSESSMENT

a. Safety

The Phase I inspection of the Clark's Creek Project Site I dam did not reveal conditions which constitute a hazard to human life or property. The earth embankment is considered to be structurally stable and the spillways are capable of retarding and safely discharging floodwaters resulting from the Probable Maximum Flood (PMF).

b. Adequacy of Information

Information reviewed for Phase I inspection purposes is considered to be adequate.

c. Need for Additional Investigations

No additional investigations are necessary at this time.

7.2 RECOMMENDED MEASURES

The following actions should be taken within 6 months of the date of final approval of this report:

- a. Cut the brush and small trees growing near the riser on the lower portion of the upstream slope as well as those in the vicinity of the plunge pool.
- b. Investigate the wet area in the bottom of the auxiliary spillway channel to determine whether remedial work is required to drain this area.
- c. Develop an emergency action plan for notification of downstream residents and the proper authorities in the event of large auxiliary spillway discharges.

APPENDIX A

PHOTOGRAPHS



Service Spillway Riser with Auxiliary Spillway
Channel at Left



Brush Growing on Slope Near the
Base of the Riser



Outlet to Principal Spillway Conduit and
Plunge Pool - Note Undesirable Growth through Rock



Plunge Pool and Downstream Channel
Note Small Tree Growing at Outlet to
Plunge Pool



Entrance to Auxiliary Spillway Channel



Control Section of Auxiliary Spillway Channel



Wet Area on Cut Slope of Auxiliary Spillway



Wet Area at Base of Cut Slope on Auxiliary Spillway

APPENDIX B
VISUAL INSPECTION CHECKLIST

1

VISUAL INSPECTION CHECKLIST

1) Basic Data

a. General

Name of Dam CLARK'S CREEK WATERSHED PROJECT SITE 1 DAM

Fed. I.D. # NY 718 DEC Dam No. #1068-4076

River Basin SUSQUEHANNA

Location: Town OXFORD County CHEMANGO

Stream Name CLARK'S CREEK

Tributary of CHEMANGO RIVER

Latitude (N) 42° 27.5' Longitude (W) 75° 36.1'

Type of Dam EARTH EMBANKMENT

Hazard Category C

Date(s) of Inspection 7/31/80

Weather Conditions SUNNY; CLEAR 75°

Reservoir Level at Time of Inspection AT LOW STAGE ORIFICE

b. Inspection Personnel W. LYNCH R. WARRENDER

c. Persons Contacted (Including Address & Phone No.)

GARY PAGE - SCS BROOME CO. AIRPORT OFFICE

607-773-2751

d. History:

Date Constructed 1974 Date(s) Reconstructed None

Designer SOIL CONSERVATION SERVICE

Constructed By JONES & MEAD CONSTRUCTION - APPALACHIAN, N.Y.

Owner CHEMANGO COUNTY - PHIL CUMMING @ NORWICH SWCD OFFICE

MAINTAINED BY VILLAGE OF OXFORD

2) Embankment

a. Characteristics

(1) Embankment Material GLACIAL TILL

(2) Cutoff Type COMPACTED EARTH

(3) Impervious Core NONE

(4) Internal Drainage System YES

(5) Miscellaneous GRASS & CROWN VETCH

b. Crest

(1) Vertical Alignment SATISFACTORY

(2) Horizontal Alignment CURVILINEAR

(3) Surface Cracks NONE

(4) Miscellaneous _____

c. Upstream Slope

(1) Slope (Estimate) (V:H) 1 on 3

(2) Undesirable Growth or Debris, Animal Burrows WELL MAINTAINED
MOWED GRASS - SOME BRUSH & TREES NEAR RISER AT BOTTOM

(3) Sloughing, Subsidence or Depressions NONE

(4) Slope Protection NONE

(5) Surface Cracks or Movement at Toe NONE

d. Downstream Slope

(1) Slope (Estimate - V:H) 1 ON 2.5

(2) Undesirable Growth or Debris, Animal Burrows NONE - GRASS
WAS SLIGHTLY SPARSE IN SPOTS

(3) Sloughing, Subsidence or Depressions NONE

(4) Surface Cracks or Movement at Toe NONE

(5) Seepage NONE

(6) External Drainage System (Ditches, Trenches; Blanket) ACROSS

ABUTMENT-EMBANKMENT CONTACT - NO SEEPAGE OR
WET AREAS

(7) Condition Around Outlet Structure SATISFACTORY

(8) Seepage Beyond Toe NONE NOTED

e. Abutments - Embankment Contact

DOWNSLOPE - RIPRAP LINED - NO SEEPAGE OR
WET SPOTS

(1) Erosion at Contact No

(2) Seepage Along Contact NONE

3) Drainage System

a. Description of System TWIN 6" ASBESTOS-CEMENT
PIPES WITH ANIMAL GUARDS ACROSS PIPE OUTLET

b. Condition of System APPEARED SATISFACTORY

c. Discharge from Drainage System NONE AT TIME OF INSPECTION

4) Instrumentation (Monumentation/Surveys, Observation Wells, Weirs,
Piezometers, Etc.)

None

5) Reservoir

a. Slopes RELATIVELY STEEP

b. Sedimentation NONE APPARENT

c. Unusual Conditions Which Affect Dam NONE

6) Area Downstream of Dam

a. Downstream Hazard (No. of Homes, Highways, etc.) VILLAGE OF OXFORD

b. Seepage, Unusual Growth NONE

c. Evidence of Movement Beyond Toe of Dam NONE

d. Condition of Downstream Channel Some BRUSH & SMALL TREES AT OUTLET
OF PLUNGE POOL - BEYOND THAT TRAPEZOIDAL CHANNEL IS OKAY

7) Spillway(s) (Including Discharge Conveyance Channel)

2 STAGE RISER WITH LOW FLOW ORIFICE - AUXILIARY
CHANNEL AT EAST END

a. General SATISFACTORY

b. Condition of Service Spillway

NOT POSSIBLE TO INSPECT TOP OR INTERIOR OF
RISER DUE TO HEIGHT OF RISER

c. Condition of Auxiliary Spillway SATISFACTORY MAINTENANCE;
RECENTLY MOWED
WET AREA WITH MINOR PONDING ALONG OUTSIDE BEND - SEEPAGE
OFF CUT SLOPE EXTENDS ABOUT 25' OUT FROM TOE OF CUT
AND FOR ABOUT 300 FT. - BEGINS UPSTREAM OF LEVEL SECTION &
EXTENDS TO END OF CHANNEL - FLOWING INTO RESERVOIR

d. Condition of Discharge Conveyance Channel _____

OKAY - SOME TREES SURROUND PLUNGE POOL

8) Reservoir Drain/Outlet

Type: Pipe Conduit _____ Other _____

Material: Concrete _____ Metal _____ Other CAST IRON

Size: 12 Length 50'

Invert Elevations: Entrance 1319.9 Exit 1317.9

Physical Condition (Describe): Unobservable

Material: _____

Joints: _____ Alignment _____

Structural Integrity: _____

Hydraulic Capability: _____

Means of Control: Gate _____ Valve _____ Uncontrolled _____

Operation: Operable _____ Inoperable _____ Other _____

Present Condition (Describe): REPORTED TO BE OPERABLE -
IS OPERATED ANNUALLY

9) Structural

a. Concrete Surfaces Pipe - OKAY RISER - OKAY

b. Structural Cracking NOT AT OUTLET

c. Movement - Horizontal & Vertical Alignment (Settlement) NONE

d. Junctions with Abutments or Embankments N/A

e. Drains - Foundation, Joint, Face N/A

f. Water Passages, Conduits, Sluices SATISFACTORY

g. Seepage or Leakage NONE OBSERVED

- h. Joints - Construction, etc. N/A
- i. Foundation N/A
- j. Abutments N/A
- k. Control Gates RESERVOIR DRAIN - OPERATED ANNUALLY BUT NOT YET THIS YEAR
- l. Approach & Outlet Channels
- m. Energy Dissipators (Plunge Pool, etc.) SATISFACTORY - GRADED RIPRAP AROUND ENTIRE POOL & DOWNSTREAM CHANNEL
SOME BRUSH & TREES IN VICINITY OF POOL
- n. Intake Structures
- o. Stability
- p. Miscellaneous

APPENDIX C
HYDROLOGIC/HYDRAULIC
ENGINEERING DATA AND COMPUTATIONS

CHECK LIST FOR DAMS
HYDROLOGIC AND HYDRAULIC
ENGINEERING DATA

1

AREA-CAPACITY DATA:

	<u>Elevation</u> (ft.)	<u>Surface Area</u> (acres)	<u>Storage Capacity</u> (acre-ft.)
1) Top of Dam	<u>1361.6</u>	<u>17.6</u>	<u>199.8</u>
2) Design High Water (Max. Design Pool)	<u> </u>	<u> </u>	<u> </u>
3) Auxiliary Spillway Crest	<u>1357.2</u>	<u>13.3</u>	<u>129.0</u>
4) Pool Level with Flashboards	<u> </u>	<u> </u>	<u> </u>
5) Service Spillway Crest	<u>1355.9</u>	<u>12.2</u>	<u>113.0</u>

DISCHARGES

	<u>Volume</u> (cfs)
1) Average Daily	<u> </u>
2) Spillway @ Maximum High Water	<u>160.1</u>
3) Spillway @ Design High Water	<u> </u>
4) Spillway @ Auxiliary Spillway Crest Elevation	<u>91.4</u>
5) Low Level Outlet	<u>20.5</u>
6) Total (of all facilities) @ Maximum High Water	<u>512.6</u>
7) Maximum Known Flood	<u> </u>
8) At Time of Inspection	<u> </u>

CREST:

ELEVATION: 1361.6Type: GRASSED EARTHWidth: 16 FT Length: 1250 FTSpillover GRASSED EARTH CHANNELLocation EASTERN END

SPILLWAY:

SERVICE	AUXILIARY
<u>1355.9</u>	<u>1357.2</u>

<u>R/C DROP INLET</u>	Type <u>GRASSED CHANNEL</u>
<u>2.5 FT X 7.5 FT</u>	Width <u>200 FT</u>

Type of Control

<u>✓</u>	Uncontrolled <u>✓</u>
----------	-----------------------

Controlled:

Type <u>(Flashboards; gate)</u>

Number

Size/Length

Invert Material

Anticipated Length of operating service
--

Chute Length

Height Between Spillway Crest & Approach Channel Invert (Weir Flow)

HYDROMETEOROLOGICAL GAGES:Type : NONE

Location: _____

Records:

Date - _____

Max. Reading - _____

FLOOD WATER CONTROL SYSTEM:Warning System: NONE

Method of Controlled Releases (mechanisms):

OPERATION OF RESERVOIR DRAIN

DRAINAGE AREA: 536 ACRES

DRAINAGE BASIN RUNOFF CHARACTERISTICS:

Land Use - Type: FARM & FORESTS

Terrain - Relief: Moderate

Surface - Soil: GLACIAL TILL

Runoff Potential (existing or planned extensive alterations to existing
(surface or subsurface conditions)

NONE

Potential Sedimentation problem areas (natural or man-made; present or future)

NONE

Potential Backwater problem areas for levels at maximum storage capacity
including surcharge storage:

NONE

Dikes - Floodwalls (overflow & non-overflow) - Low reaches along the
Reservoir perimeter:

Location: WEST END OF DAM - DIVERSION TO GET HIGHWAY

CULVERT RUNOFF AWAY FROM EMBANKMENT

Elevation: _____

Reservoir:


Length @ Maximum Pool _____ (Miles)

Length of Shoreline (@ Spillway Crest) _____ (Miles)


PROJECT GRID

JOB	SHEET NO.	CHECKED BY	DATE			
CLARK'S CREEK WATERSHED PROJECT	1					
HYDROLOGIC/HYDRAULIC COMPUTATIONS	RLW	7/22/83				
DRAINAGE AREA OF RESERVOIR - TAKEN FROM SCS P4A VS						
536 ACRES = .8460 mi ²						
SNYDER SYNTHETIC UNIT HYDROGRAPH						
$L = 1.63 \text{ mi.}$	$L_a = .72 \text{ mi.}$					
$t_p = C_p (L \cdot L_a)^{1/3} = 2.05(1.63)(.72)^{1/3} = 2.10$						
$t_r = \frac{t_p}{5.5} = \frac{2.10}{5.5} = .38$	Use 70 minute increments					
$t_{pr} = t_p + .25(t_R - t_r) = 2.10 + .25(33 - .38) = 2.09$						
HR #33 P1A RAINFALL						
ZONE 1	P1A RAIN = 20 IN					
6 HR = 111%	24 HR = 134%					
12 HR = 123%	48 HR = 142%					
$T_{SP} = 1 - \frac{.30}{(.8)(.77)} = .689$						
(SEE FIG) → USE 2 cfs						

P 3-4

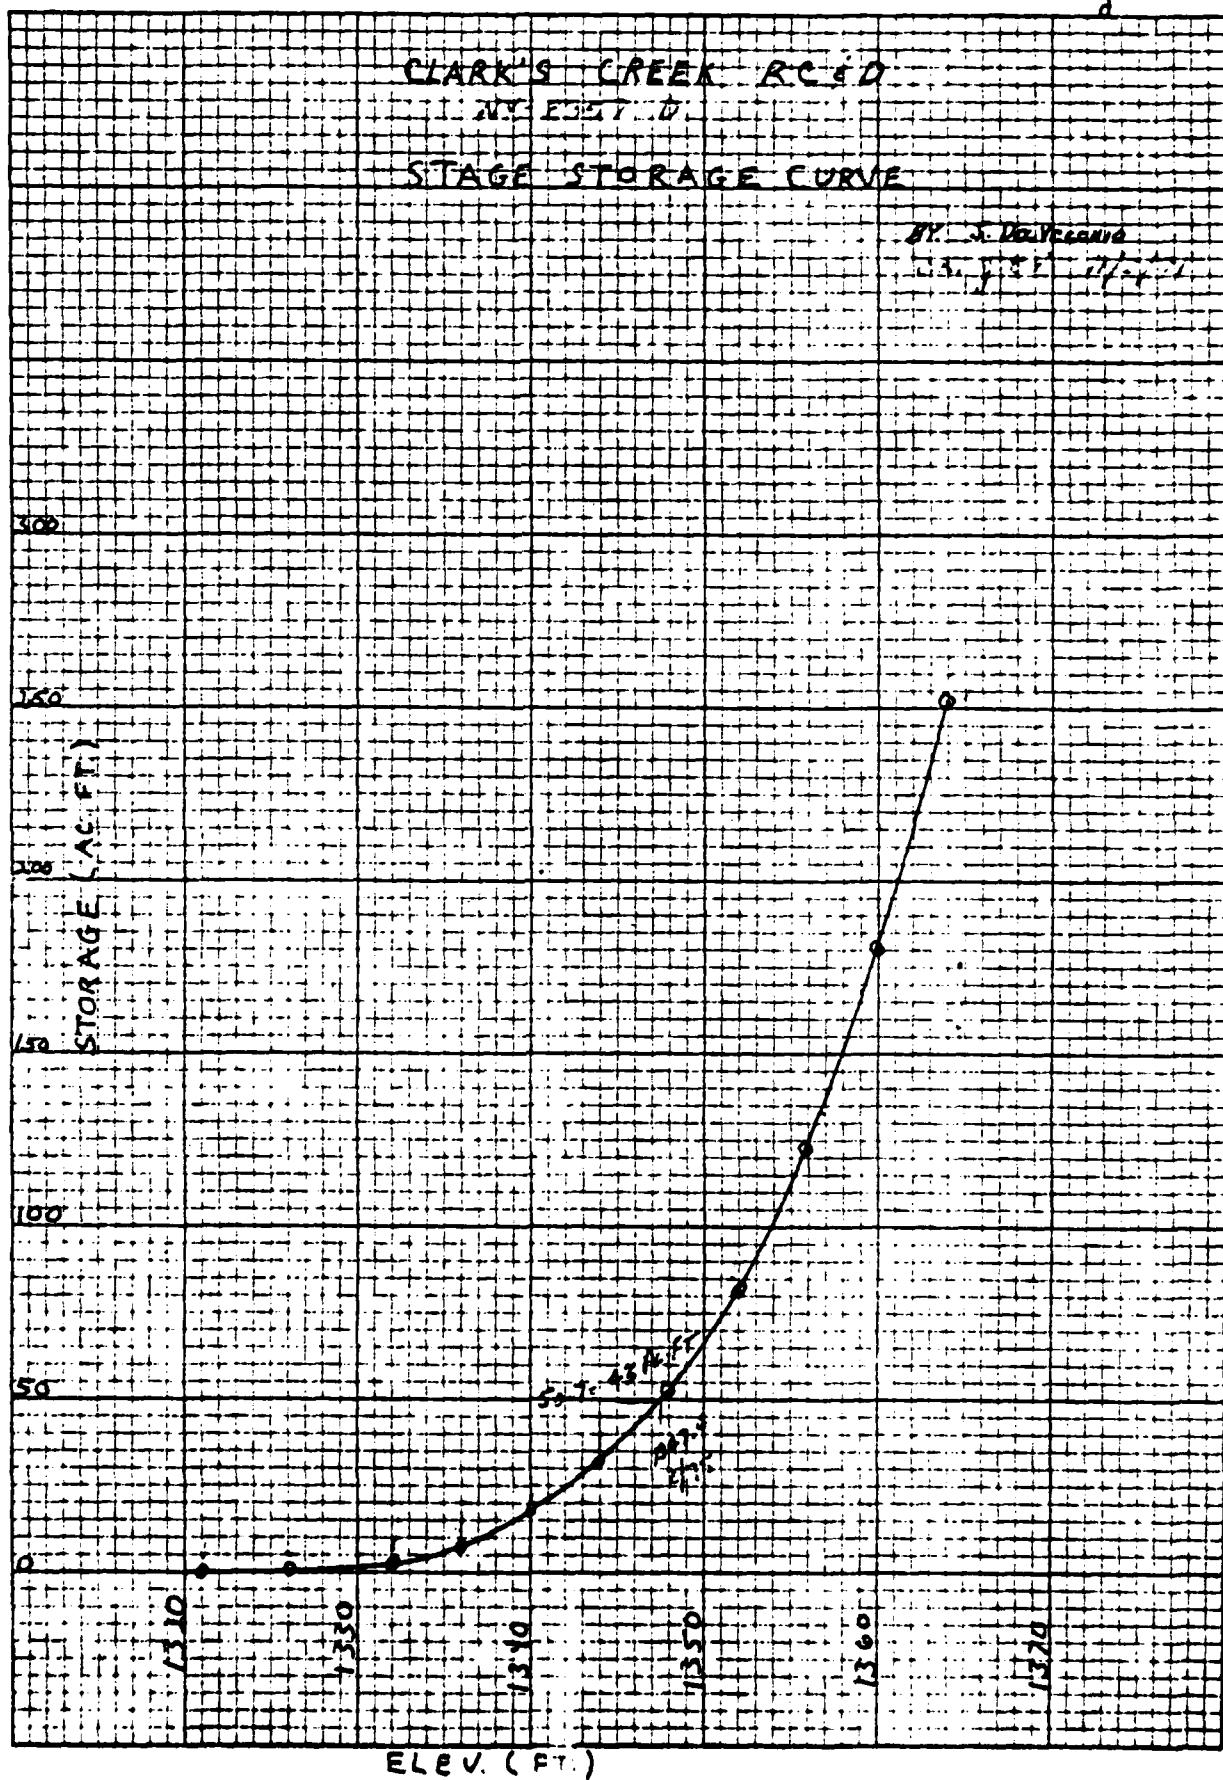

Pg 3-5

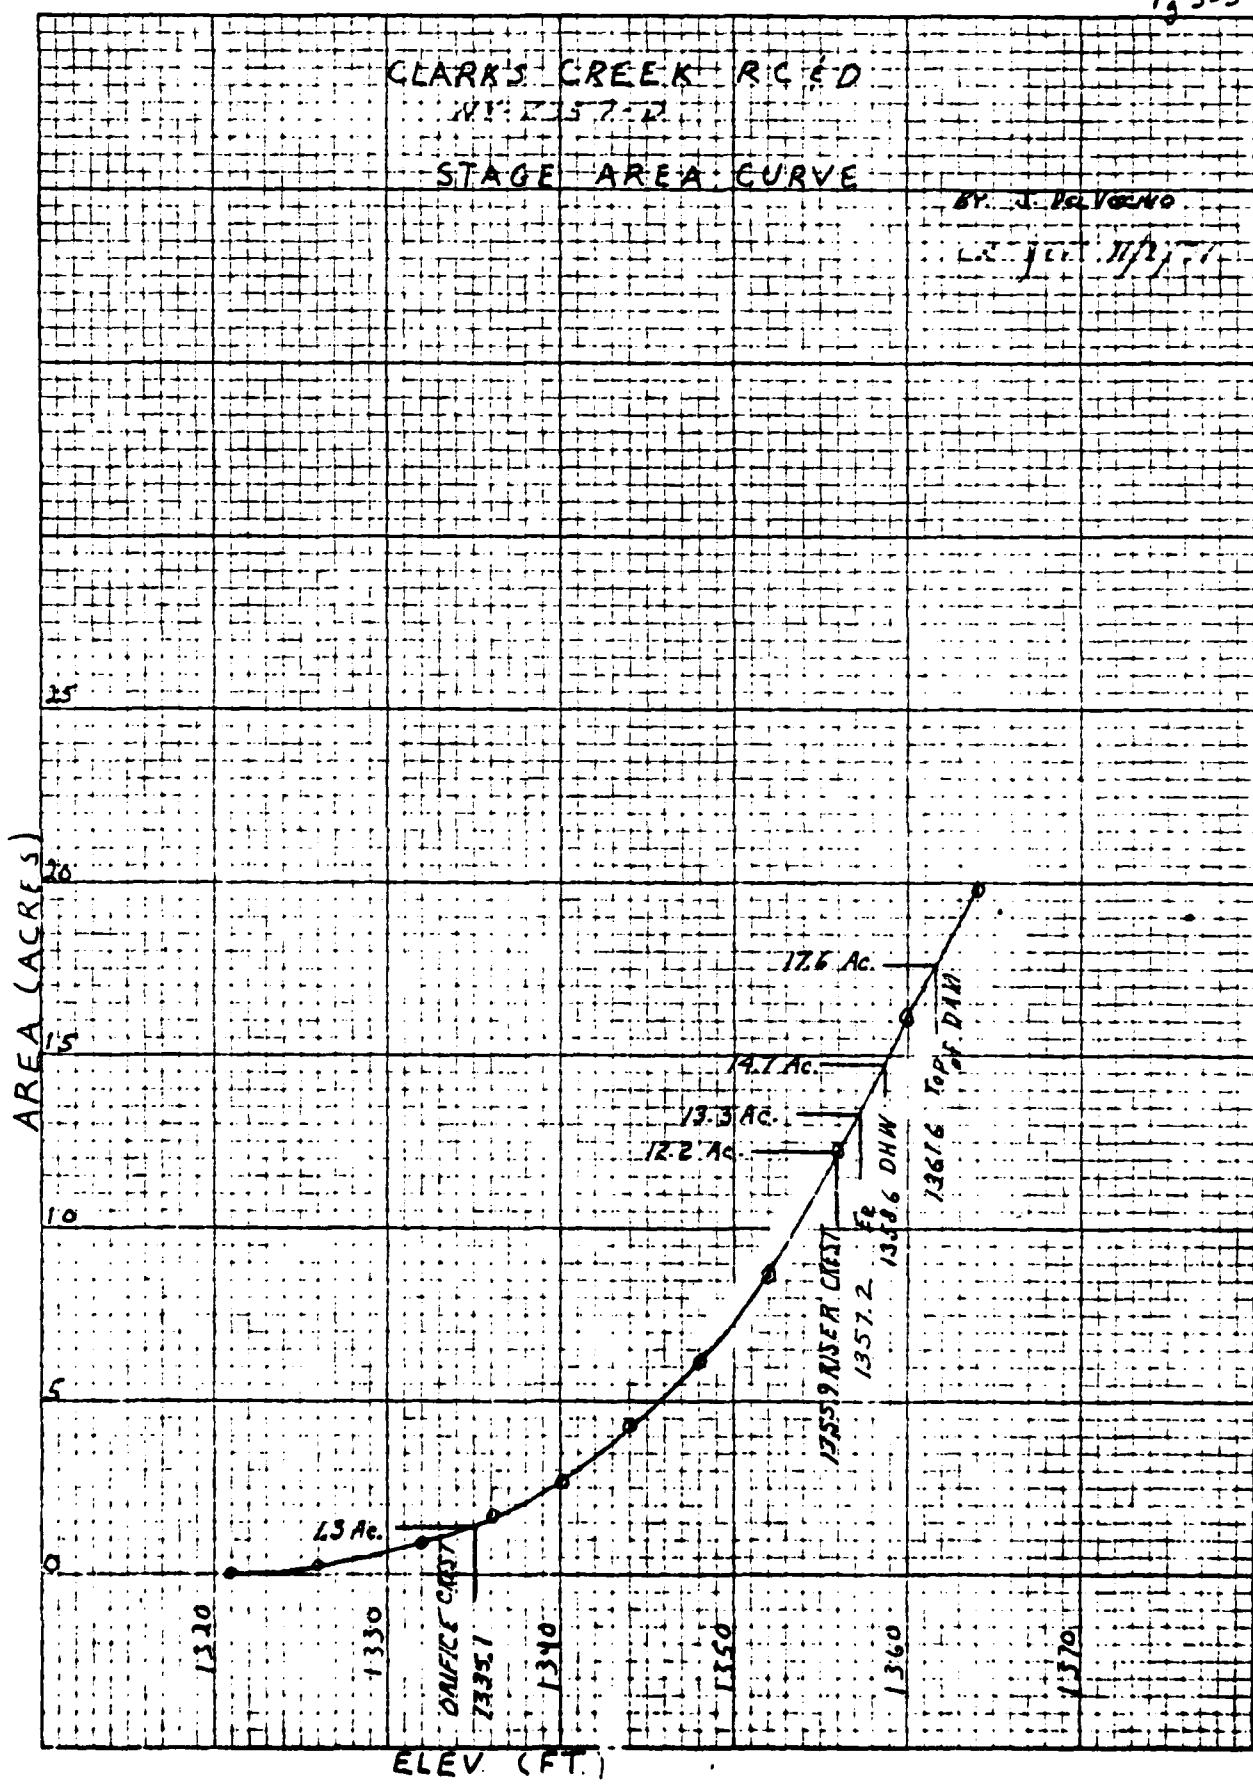

CLARKSON C. CO & FARM 1 SPILLWAY PROFILE WORK BY JEP NOV 4, 1971
C.R.V. NO. 1650, SALTWELL 3.40, 1.046 0.0 CURVE NO. 100.0, RAINFALL 0.00, 0.000
16.000 LENGTH OF PROFILE 1.14. MAXIMUM D/S VOLUME 0.012 FLOOD AREA 0.04

BASE LINE IS 3.000 LSF (5.72' UFS).

LOW STAGE WITH 1PF & 100.

LOW STAGE SPILLWAY 1.295.10 RAINFALL IS 1.00 X 1.000 FEET.

HIGH STAGE SPILLWAY 1.300.40 RAINFALL 1.000

CONDENSED 1.17. IS 30. PROFILE

ELEVATION	SURFACE	SPFs
1335.10	1.90	0.00
1339.25	1.38	0.20
1343.41	1.16	1.45
1347.57	0.92	15.45
1351.73	0.78	19.33
1355.89	0.69	21.68
1359.10	0.61	4.94
1363.26	0.44	15.65
1367.40	0.27	4.30
1371.59	0.20	35.40
1375.76	0.13	4.01
1379.14	0.06	1.43
1387.30	0.00	0.43
1391.45	-0.42	16.02
1395.59	-0.65	1.40
1407.95	-0.48	1.64-1.69
1412.10	-0.34	1.55-1.50
1416.160	-0.17	1.70-1.13
1420.260	-0.02	1.66-1.30
1425.300	0.57	1.65-1.40
1427.00	0.12	1.77-1.26
1427.500	-0.07	1.67-1.13
1427.800	-0.01	1.64-1.04
1428.100	0.19	1.67-1.10

EE. S. DESIGN AND F BOARD KLUTINGS.

CLARKS CREEK DAM I CHENANGO RCSD NEW YORK BY JAM 11-23-71 C

CURVE NO. 75.1 RC . 0.30 ✓ STORM DURATION 6.00

EMERK. SPW. RAINFALL 9.10 / FREEBOARD RAINFALL 23.00




ELEVATION STORAGE CFS CF5 CFS CFS

1336.00

1340.00 18.00 10.00
1344.00 13.00 13.00

1348.00 16. 16.

1335.90 - 121. - 22. - 22.

133.720 131.91. 91. 208.
133.710 133.82. 82. 235.

1358.20 152.0 380.0 468.0 557.0

1359.20 1588. 1298. 1008. 167. 24. 21. 15. 12. 10. 8. 6. 4. 2.

135.9.0 174. 1432. 1886. 2320.
136.60 178. 1726. 2316. 2856.

1360.20 - 182. = 1988. - 2598. = 3208.


13180.
1731
10377.
1206
1944.
1202
179
250.
1364.00
145.20

1367.99 322. 17610. 23424. 29238.









NEW YORK STATE
DEPT OF ENVIRONMENTAL CONSERVATION
FLOC PROTECTION BUREAU

PLANO-CHIN LOVASH PACKAGE (HFC-11)
CA - SECURITY VERSION 1 JULY 1974
LAST MODIFICATION 26 FEB 79

NEW YORK STATE
DEPT OF ENVIRONMENTAL CONSERVATION
FLOC PROTECTION BUREAU

FLD00 HYDROGRAPH PACKAGE (HEC-1)
LAN SAVIV VERSION 26 JULY 1975
LAST INDICATION 26 FEB 79
INDIEN FOR HONEYWELL APR 79

NEW YORK STATE
DEPT OF ENVIRONMENTAL CONSERVATION
FLDCO PROTECTION AUREAL

RUN DATE 07/23/80

CLARKS CREEK PROJECT SITE A
ANALYSIS PHF WITH RATIOS
DATE

NO	MHR	MIN	IDAY	JCB SPECIFICATION	IPAT	INSTAN
200	0	15	0	ININ METAC 0 0 0	0	0
				LADPT TRACE 0 0 0	0	0
					0	0

MULTI-PLAN ANALYSES TO BE PERFORMED
NPLAN=1 NRATIO=2 LRATIO=1
RTICS= 0.50 1.00

SUB-AREA RUNOFF COMPUTATION

INFLOW HYDROGRAPH
ISSTAQ ICOMP RECON ITAPE JPLT JPAT INAME ISSTAGE IAUTO
1 0 0 0 0 0 0 0 0 0

INWDOE 1 TUNG 0.84 SNAP TRSDA TRSPC RATIO ISNOW ISAME LOCAL
0. 0. 0. 0. 0. 0. 0.

SPFE PMS R6 PRECIP DATA R12 R24 R48 R72 R96
0. 20.00 111.00 123.00 132.00 142.00 0. 0. 0.

LADPT STAKR DLTKA RTINL ERAIN STAKS RTIUK STRTL GSTL ALSPX RTIMP
0. 0. 1.00 0. 0. 1.00 1.00 0.10 0. 0.

UNIT HYDROGRAPH DATA
TP= 2.10 CP=0.63 NTA= 0

RECEDITION DATA
STAG= 2.00 QRCNE 2.00 RTICR= 1.00
UNIT HYDROGRAPH 46 END-OF-PERIOD ORDINATES. LAG= 2.00 HQLRS> CP= C.63 VOL= 1.00
4. 24. 48. 75. 104. 131. 151. 162. 166. 157.
140. 123. 108. 95. 93. 73. 64. 56. 49. 41.
32. 33. 29. 26. 22. 20. 17. 15. 13. 12.
12. 9. 6. 7. 6. 5. 5. 4. 4. 3.
3. 2. 2. 2. 1. 1.

APPROXIMATE CLARK COEFFICIENTS FROM GIVEN SNYDER CP AND TP ARE TC= 9.31 AND RA= 7.65 INTERVALS
UNIT HYDROGRAPH 46 END-OF-PERIOD FLOW
0.04 RA=.11 PERIOD RAIN EXCS LOSS CAMP q KGDA +R.PA PERIOD RAIN EXCS LCSS COMP G
1.01 0.15 1 0.00 0. 0.00 2. 1.02 1.13 101 0.02 0. 0.02 3.
1.01 2.10 2 0.00 C. 0.00 2. 1.02 1.30 102 0.02 0. 0.02 3.
1.01 0.45 3 0.00 0. 0.00 2. 1.02 1.45 103 0.02 0. 0.02 3.

104	105	106	
-----	-----	

0.02 0.02 0.02 0.02 0.02 0.02 0.02 0.02 0.01



PEAK CFS	6-HOUR INCHES	24-HOUR MM	72-HOUR MM	TOTAL VOLUME 34761.	SLM (497.0) (406.0) (91.0) 19.57 16.00 3.57 983.16)
1577. 49.	1087. 31.	357. 10.	174. 5.	913. 16.01	
	12.04	15.81	16.01		
	305.77	401.57	406.71	406.71	
	539.	708.	717.	717.	
	665.	873.	884.		

PEAK	CFS	6-HOUR	24-HOUR	72-HOUR	TOTAL VOLUME
79°	344.	344.	178.	87.	1735.
22.	15.	15.	5.	2.	46.0
1° CMES	6.02	6.02	7.90	8.01	6.01
MM	152.88	200.79	203.75	203.35	
AC-FI	270.	354.	359.	359.	359.
TRANS CU H	332.	437.	442.	442.	

PEAK	CFS	6-HOUR	24-HOUR	72-HOUR	TOTAL VOLUME
1577.	1087.	357.	174.	347C1.	
.45.	31.	10.	5.	983.	
INCHES					
MM					
AC-FT					
YD-GS CU M					

HYDROGRAPH ROUTING

~~ADMITTED HYDROGRAPH AT DAM NO BREACH~~

	I STAG	I CDMP	I EC0N	I TAPE	JPLT	JPRJ	I NAME	I STAGE	I AUTO
GLOSS	0.	0.	0.	ROUTING DATA	IPAR	IPRP		LSTK	0
NSIPS	1	0	0	I KES	ISAME	IPAR		STRA	-1336.
NSTDL	1	0	0	LAG	AHSKK	0.	X	TSK	-1336.

STAGE	1334,10	1355,90	1357,20	1358,60	1361,60
FLOW	0.	23.00	91.00	763.00	5126.00
CAPACITY	7.	113.	126.	150.	200.
ELEVATION	1335.	1356.	1357.	1359.	1362.

PEAK OUTFLO™ IS 770. AT TIME 42.00 HOURS

	PEAK	6-HOUR	24-HOUR	72-HOUR	TOTAL	VOLUME
CFS	770.	515.	156.	94.	16853.	
C4S	22.	15.	4.	2.	476.	
HCES		5.71	6.91	7.80	7.80	
MH		146.99	175.47	197.99	197.99	
AC-FT		256.	309.	349.	349.	
T-OLS CU H		315.	382.	431.	431.	

**STATION 1, PLAN 1, RATIC 2
END-OF-PERIOD HYDROGRAPH CREDIMATES**

PEAK INFLOW IS 15.1567, AT TIME 41.75 HOURS

	PEAK	6-HOUR	24-HOUR	72-HOUR	TOTAL	VOLUME
CFS	1567.	1080.	334.	176.	34023.	
CMH	44.	31.	9.	5.	963.	
INCHES		11.96	14.80	15.70	15.70	
MM		303.68	375.84	398.75	398.75	
AC-FT		535.	663.	703.	703.	
THQLS C.U. M		660.	817.	867.	867.	


PARK FLOW AND STORMAGE (INU OF PERIOD) SUMMARY FORMULATED RATIO COMPUTATIONS
 FLCS IN CUBIC FEET PER SECOND (CUBIC METERS PER SECOND)
 AREA IN SQUARE MILES (SQUARE KILOMETERS)

OPERATION	STATION	ANFA	PLAN	RATIO 1	RATIO 2	RATIOS APPLIED TO FLOWS
HYDROGRAPH AT	1	0.004 0.001	1 (0.50 22.33	1.00 44.67	
ROUTE 70	1	0.004 0.001	1 (770 21.00	1567 44.36	

SUMMARY OF DAM SAFETY ANALYSIS

PLAN I

	ELEVATION STORAGE OUTFLOW	INITIAL VALUE	SPILLWAY CREST	TOP OF DAM
RATIC	MAXIMUM DEPTH OVER DAM	1355.91	1355.91	1361.60
PF	REFRESHED P.M.F	113.	113.	200.
P.M.F	" S. FLEV	23.	23.	5120.
C.S.O	1356.61			
I.C.O	1359.15			

	MAXIMUM DEPTH OVER DAM	MAXIMUM STORAGE AC-FT	MAXIMUM OUTFLOW CFS	CLEARANCE OVER TOP +HOURS	TIME OF MAX OUTFLOW HOURS	TYPE OF FAILURE +CLAS
	3.	150.	770.	0.	42.00	0.
	0.	159.	1562.	0.	41.75	0.

APPENDIX D
STABILITY COMPUTATIONS

A & P. L. S.

UNITED STATES DEPARTMENT OF AGRICULTURE

SOIL CONSERVATION SERVICE - Soil Mechanics Laboratory

800 "J" Street, Lincoln, Nebraska 68508

SUBJECT: ENG 22-5, New York RCD-25, Clark's Creek Dam
(Chenango County)

DATE: September 21, 1971

TO: Richard L. Phillips, State Conservation Engineer,
SCS, Syracuse, New York

ATTACHMENTS

1. Form SCS-354, Soil Mechanics Laboratory Data, 1 sheet.
2. Form SCS-355A & B, Triaxial Shear Test Data, 1 test, 2 sheets.
3. Form SCS-366, Direct Shear Test, 1 sheet.
4. Form SCS-352, Compaction and Penetration Resistance, 1 sheet.
5. Form SCS-357, Summary - Slope Stability Analysis, 3 sheets.

INTRODUCTION

The proposed 47-foot high, Class C hazard dam is in the glaciated Allegheny Plateau physiographic province in Chenango County, New York. The glacial till of Wisconsin Age is very dense. Bedrock was not encountered in any of the test holes, one of which extended to a depth of 46 feet in the flood plain.

No major engineering problems are anticipated at this site with fill placed at a minimum density of 100% of Standard Proctor density (ASTM D-698, Method A).

DISCUSSION

FOUNDATION

A. Classification. Approximately 1 foot of loose, medium density top soil (ML-SM) mantles the glacial till.

The underlying glacial till is sandy with silt and gravel.

B. Dry Unit Weight. Standard penetration tests in the surface 10 feet of till yielded blow count generally in the range of 25 to 35 blows per foot. Below 10 feet, the blow count generally exceeded 100 blows/foot.

C. Permeability. Considerable seepage was encountered in some of the test pits in the flood plain in the surface 7.5 feet; however, field permeability tests at the same depths exhibited only very slight leakage.



Richard L. Phillips
Subj: New York RCD-25, Clark's Creek Dam

2

Considerable difficulty was experienced in keeping the deeper holes open due to caving.

Springs occur at the base of the right abutment at the site. The dense underlying till causes a perched water table condition in the loose top soil layer.

- D. Shear Strength and Consolidation Potential. The high blow count materials are expected to have high strength and low consolidation potential. Shear parameters of $\phi = 35^\circ$ and $c = 0$ psf are assumed for the lower blow count shallow till foundation materials.

EMBANKMENT

- A. Classification. Most of the borrow material will consist of glacial till. The sample submitted to the laboratory is an SC-SM material with a liquid limit of 19 and a plasticity index of 4. It contains 26% gravel, 29% sand, and 45% fines. Boulders up to 36 inches in diameter occur in the surface few feet.
- B. Compacted Dry Density. A Standard Proctor compaction test (ASTM D-698, Method A) was made on the minus No. 4 fraction of the SC-SM till material. The maximum dry density was 123.0 pcf and the optimum moisture content was 11.0%.
- C. Shear Strength. A consolidated undrained triaxial shear test was made on the minus No. 4 material at a compacted density of approximately 97% of Standard Proctor density. The test specimens were saturated by backpressuring, after being molded wet of optimum. The test data was interpreted to give saturated total stress shear parameters of $\phi = 13^\circ$ and $c = 425$ psf. Effective stress shear parameters were $\bar{\phi} = 26^\circ$ and $\bar{c} = 150$ psf.

A subsequent direct shear test was made on specimens compacted to 100% of Standard Proctor density. The test data was interpreted to give shear parameters of $\phi = 34^\circ$ and $c = 100$ psf.

STABILITY ANALYSIS

The stability of the proposed 47-foot high embankment was analyzed using a modified Swedish circle method. The dense foundation material is expected to be sufficiently strong to limit any failure surface to the embankment; however, several circles were also cut into the upper 10 to 16 feet of the foundation material.

Shear parameters of $\phi = 35^\circ$ and $c = 0$ psf were assumed for the upper 16 feet of the foundation. For the compacted embankment materials at 97% of Standard density, total stress shear parameters of $\phi = 13^\circ$ and $c = 425$ psf were used.

Richard L. Phillips
Subj: New York RCD-25, Clark's Creek Dam

3

A full drawdown analysis of the 3:1 upstream slope shows a 24-foot berm is required at elevation 1334.5 for a safety factor of 1.35. The steady seepage analysis of the $2\frac{1}{2}:1$ downstream slope with a drain at $c/b = 0.6$ shows a 25-foot berm is needed at elevation 1338.0 to obtain a safety factor of 1.50 (see Trial #1A in the slope stability summary in the attachments).

Subsequent stability analyses using the direct shear test values of $\phi = 34^\circ$ and $c = 100$ psf for the till material compacted to 100% of Standard Proctor density show a full drawdown analysis of the 3:1 upstream slope with a 10-foot berm at elevation 1334.5 gives a safety factor of 1.54 (see Trial #8 in the slope stability summary). The steady seepage analysis of the downstream $2\frac{1}{2}:1$ slope with a drain at $c/b = 0.6$ gave a safety factor of 1.62 without any berm.

RECOMMENDATIONS

- A. Site Preparation. Removal of the soft, wet top soil on the right side of the flood plain and in the right abutment is recommended.
- B. Centerline Cutoff. A normal width cutoff with 1:1 side slopes extending down to a depth of 7 to 10 feet is recommended to cut off the small pockets of highly permeable material as encountered in test pit #7. Backfill with the till borrow material. Place at or wet of optimum and compact to a minimum density of 100% of Standard Proctor density.
- C. Principal Spillway. The proposed location appears to be adequate. A horizontal strain of 0.002 ft/ft is suggested for pipe elongation for joint design. A ϕ angle of 34° is recommended for conduit loading calculations.
- D. Drainage. A shallow foundation trench drain at $c/b = 0.6$ is recommended below the permanent pool elevation to prevent the phreatic line in the embankment from emerging on the downstream slope and to provide a controlled outlet for foundation seepage that by-passes the centerline cutoff.
- E. Embankment Design. The following are recommended:
 1. Provide a homogeneous embankment of the SC-SM till material compacted to a minimum density of 100% of Standard Proctor density.
 2. Place the till borrow material at or wet of optimum.
 3. Provide 3:1 upstream slopes with a 10-foot berm at elevation 1334.5 and a $2\frac{1}{2}:1$ downstream slope with a drain at $c/b = 0.6$.

Richard L. Phillips
Subj: New York RCD-25, Clark's Creek Dam

4

- 4.. Provide an overfill of 0.6 foot across the flood plain to compensate for residual settlement after construction is complete.

Prepared by:

Edgar F. Steele

Edgar F. Steele

Acting Head

Soil Mechanics Laboratory

Attachments


cc:

R. L. Phillips
L. C. Ibbitson, SCS, Syracuse, N.Y.
B. S. Ellis, SCS, Syracuse, N.Y.
N. F. Bogner, Head, EWPU, SCS, Upper Darby, Pa.
Edward Blackmer, SCS, Binghamton, N.Y.

MATERIALS TESTING REPORT		U. S. DEPARTMENT of AGRICULTURE SOIL CONSERVATION SERVICE			TRIAXIAL SHEAR TEST			
PROJECT AND STATE <i>Glacier Creek Dens</i>		NEW YORK			SAMPLE LOCATION <i>Fogbow</i>			
FIELD SAMPLE NO. <i>105.1</i>	DEPTH	GEOLOGIC ORIGIN			<i>Glacial Till (Wisconsin)</i>			
TYPE OF SAMPLE <i>COMPACTED</i>	TESTED AT <i>SMU-Lincoln</i>	APPROVED BY <i>Edgar F Stroh</i>			DATE <i>9/14/71</i>			
INDEX TEST DATA		SPECIMEN DATA				TYPE OF TEST		
USCS SC-SM1; LL <u>19</u> ; PI <u>4</u> % FINER (mm): 0.002 <u>10</u> ; 0.005 <u>17</u> 0.074 (#200) <u>45</u> G _s (-#4) <u>2.73</u> ; G _s (+#4) <u>2.73</u> STANDARD: γ _d MAX. <u>123.0</u> pcf; w _o <u>11.0</u> % MODIFIED: γ _d MAX. _____ pcf; w _o _____ %	HEIGHT <u>3.0</u> "; DIAMETER <u>1.4</u> " MATERIALS TESTED PASSED <u>#4</u> SIEVE METHOD OF PREPARATION <u>STATIC 3</u> <u>LAYER COMPACTION</u> MOLDING MOISTURE <u>11.2</u> % MOLDED AT <u>97.5</u> % OF γ _d MAXIMUM				UU <input type="checkbox"/> CU <input type="checkbox"/> CU <input checked="" type="checkbox"/> CD <input type="checkbox"/>			
DRY DENSITY	B, Parameter	MOISTURE CONTENT, %		TIME OF CONSOLIDATION (hrs.)	MINOR PRINCIPAL STRESS σ ₃ (psi)	DEVIATOR STRESS σ ₁ - σ ₃ (psi)	AXIAL STRAIN AT FAILURE, ε (%)	
INITIAL pcf <input checked="" type="checkbox"/> g/cc <input type="checkbox"/>	CONSOLI- DATED pcf <input type="checkbox"/> g/cc <input type="checkbox"/>	START OF TEST	DEG. OF SAT. AT START OF TEST	END OF TEST				
119.7	0.99			15.4	87.68	10	1.54	
119.7	0.96			15.3	15.50	25	19.0	
120.0	1.00			14.8	16.00	40	30.6	
120.3	0.98			14.6	15.92	30	25.6	
DEVIATOR STRESS (σ ₁ - σ ₃), psi								
<p style="text-align: center;">SHEAR PARAMETERS</p> <p>θ = <u>13</u> deg. tan θ = <u>.231</u> c = <u>425</u> pcf</p>								
<p style="text-align: center;">REMARKS BACK-PRESSED</p> <p style="text-align: right;"><i>C. H. J. M.</i></p>								

MATERIALS TESTING REPORT	U. S. DEPARTMENT OF AGRICULTURE SOIL CONSERVATION SERVICE	TRIAXIAL SHEAR TEST with pore pressure measured
-----------------------------	--	--

PROJECT AND STATE <u>CLARK'S CREEK DMR</u> <u>NEW YORK</u>				SAMPLE LOCATION	
TYPE OF SAMPLE <u>COMPACTED</u>	TESTED AT <u>SNL-LINCOLN</u>	APPROVED BY <u>CDJ</u>			DATE <u>9/14/71</u>
MINOR PRINCIPAL STRESS, σ_3 (psi)	PORE PRESSURE, u (psi)	EFFECTIVE MINOR PRINCIPAL STRESS, $\bar{\sigma}_3$ (psi)	DEVIATOR STRESS, $\sigma_1 - \sigma_3$ (psi)	FAILURE CRITERIA	AXIAL STRAIN AT FAILURE, ϵ (%)
10	3.4	6.6	13.4		1.0
25	12.0	13.0	18.0		1.1
40	22.1	17.9	30.6		1.5
30	16.2	13.8	25.6		1.5

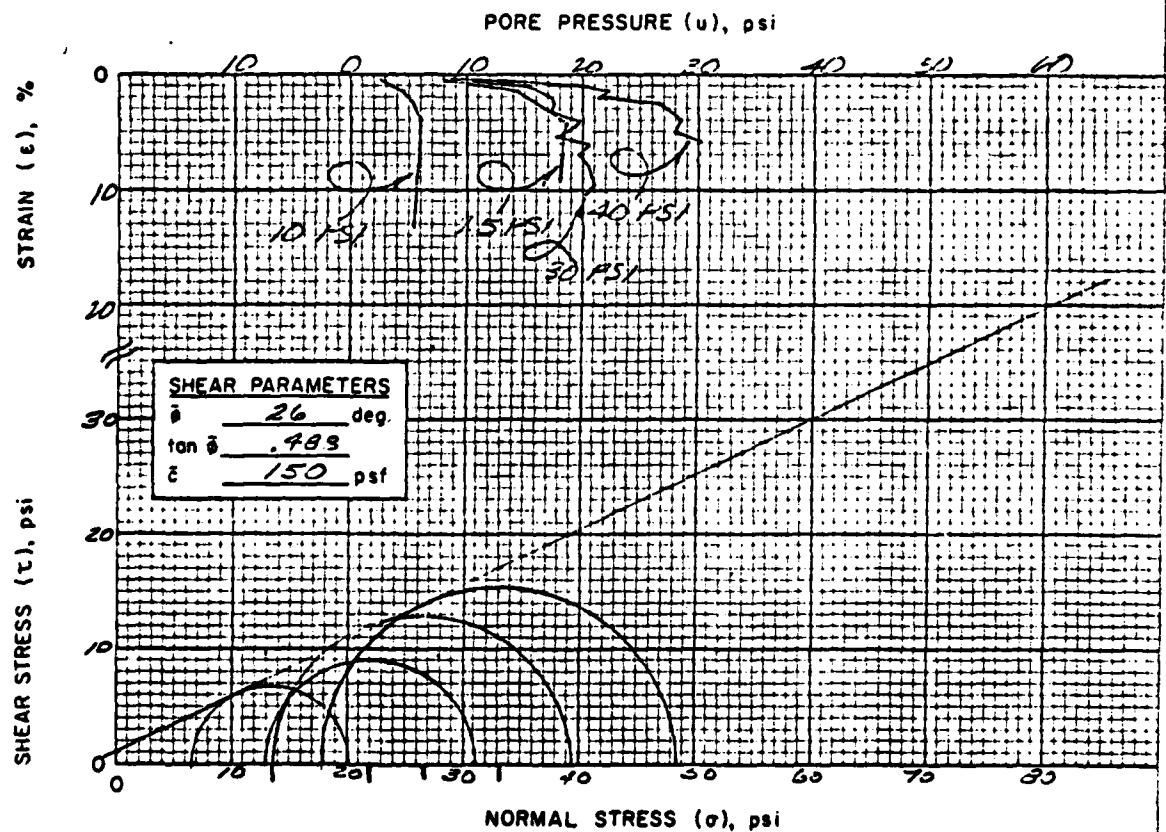

REMARKS BACK-PRESSED

OTF/HJB.

MATERIALS TESTING REPORT		U. S. DEPARTMENT of AGRICULTURE SOIL CONSERVATION SERVICE		DIRECT SHEAR TEST	
PROJECT AND STATE <u>CLARK CREEKS DAM</u> <u>NEW YORK</u>				SAMPLE LOCATION <u>BORROW</u>	
FIELD SAMPLE NO. <u>105.1</u>	DEPTH	GEOLOGIC ORIGIN			
TYPE OF SAMPLE <u>COMPACTED</u>	TESTED AT <u>SML LINCOLN</u>	APPROVED BY			DATE
CLASSIFICATION	<u>SC - SM</u>	LL <u>19</u>	PI <u>4</u>	SPECIFIC GRAVITY	
TYPE OF TEST	<u>CONTROL STRAIN</u>			$G_s (-)^{1/4}$	<u>2.73</u>
RATE OF LOADING (in/min.)	<u>0.00055</u>		MOISTURE CONDITION <u>FLOODED</u>	$G_s (+)^{1/4}$	
TYPE OF SPECIMEN	AREA (sq.in) <u>6.25</u>	THICKNESS (in) <u>1.0</u>	$G_m(\text{bulk})^{1/4}$		
TEST NO.	1	2	3	4	
INIT. MOISTURE, %	11.3	11.3	11.3		
DRY DENSITY, $\frac{\text{lb}}{\text{ft}^3}$ <input checked="" type="checkbox"/> $\frac{\text{kg}}{\text{m}^3}$	122.6	122.7	123.5		
INIT. VOID RATIO	.3900	.3886	.3801		
TEST DURATION, (min)	288	497	501		
FINAL MOISTURE, %	12.2	12.7	12.0		
NORMAL STRESS	10	25	40		
MAX. SHEAR STRESS	7.6	15.9	27.7		
SHEAR VALUES ϕ c AT MAXIMUM STRESS 34° 100					
DISPLACEMENT (%)	0	10	20	30	40
CHANGE IN THICKNESS (%)	0	1	2	3	4
NORMAL STRESS (σ)					
REMARKS AVERAGE TEST $\bar{\gamma} = 99.9\% \text{ STD.}$					

C.J.
 10/14

MATERIALS TESTING REPORT	U. S. DEPARTMENT OF AGRICULTURE SOIL CONSERVATION SERVICE	COMPACTION AND PENETRATION RESISTANCE
-----------------------------	--	--

PROJECT AND STATE

Clark's Creek Dam

NEW YORK

FIELD SAMPLE NO.

105.1

LOCATION

Borrow

DEPTH

GEOLOGIC ORIGIN

Wisconsin Glacial Till

TESTED AT

SML - LINCOLN

APPROVED BY

Edgar F. Steele

DATE

9/14/71

CLASSIFICATION

SC-5M LL 19 PI 4

CURVE NO. 1 OF 1

MAX. PARTICLE SIZE INCLUDED IN TEST

< #4

STD. (ASTM D-698) METHOD A



SPECIFIC GRAVITY (G_s)

{ MINUS NO. 4 2.73

MOD. (ASTM D-1557) METHOD _____

PLUS NO. 4 2.73

OTHER TEST (SEE REMARKS)

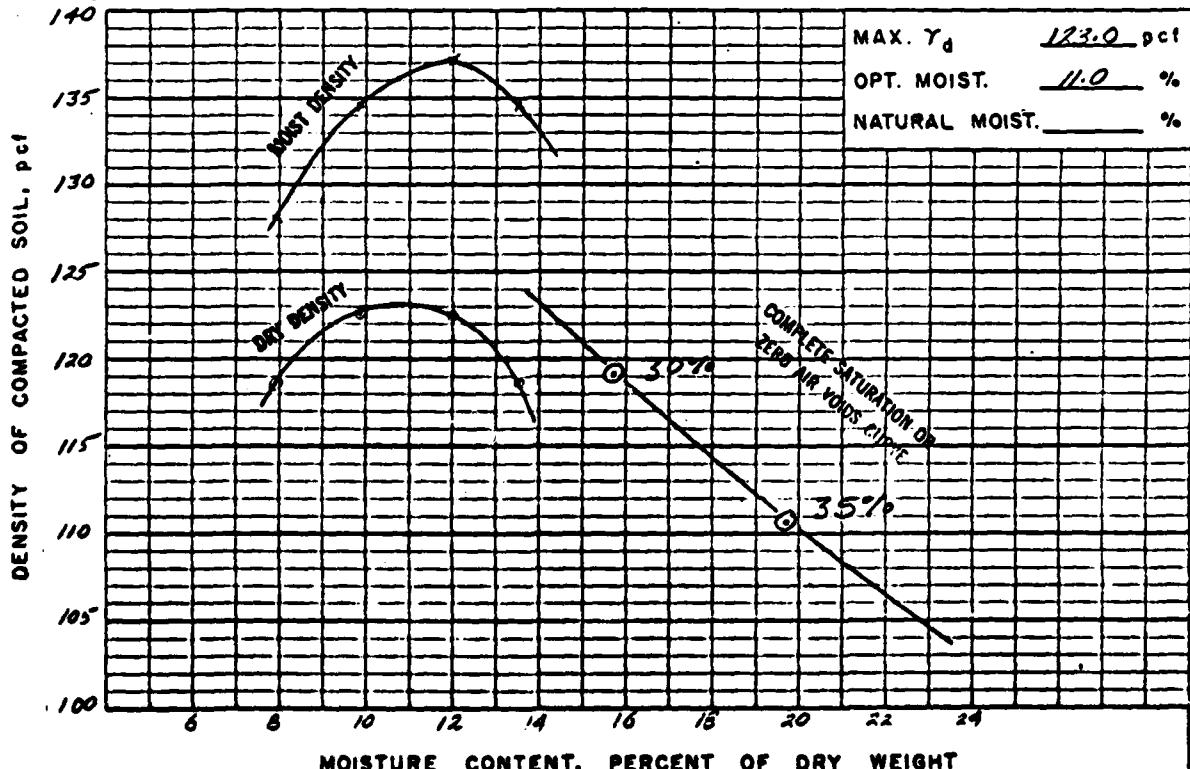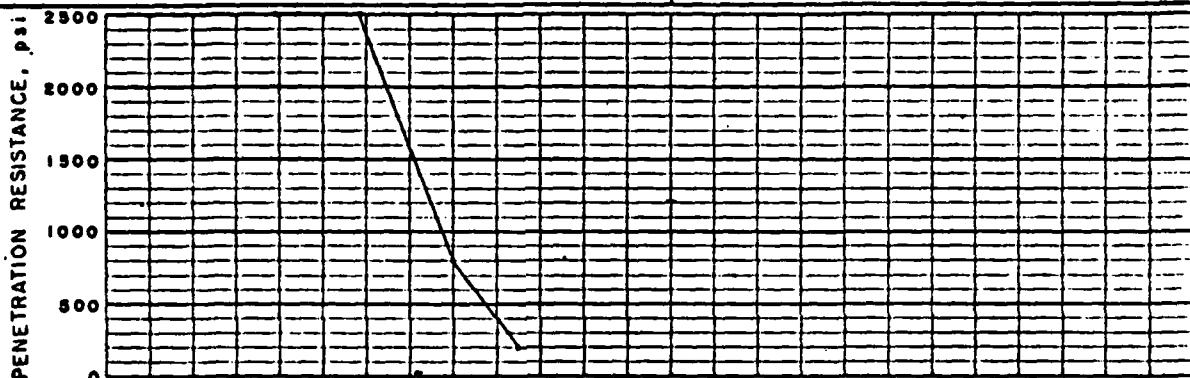

REMARKS

CURVE IS FOR THE MINUS NO. 4 FRACTION
GRADATION OF TOTAL SAMPLIE

< NO. 200 75%; < NO. 4 24%; < 3 in. 100%

MATERIALS U.S. DEPARTMENT OF AGRICULTURE
TESTING REPORT SOIL CONSERVATION SERVICE

SUMMARY - SLOPE
STABILITY ANALYSIS

SOURCE AND USE OF MATERIALS		CLASSIFICATION	ADOTTED	DESIGN	DATA	REMARKS			
		γ_d (pcf)	γ_m (pcf)	γ_{sat} (pcf)	γ_{sat} (pcf)	$\tan \phi$	c	$\tan \phi$	c
①	Foundation	120.0	113.2	135.0	22.5	3.5	700	0	-Est. 1/4 acre.
②	Embankment	SC-SSM 123.5	129.5	121.0	31.5	1.3	2.31	42.5	-CU - 24.9 rock.
③							2.6	49.3	-CD
④	Embankment	SC-SSM 130.9	142.0	145.5	33.0	3.4	150	1.75	100
⑤									
⑥									
⑦									
⑧									
PROJECT AND STATE		CLARK'S CREEK DAM		NEW YORK		ANALYZED AT		DATE	
METHOD OF ANALYSIS		SWEDISH CIRCLE		Syracuse, N.Y.		9-20-71		APPROVED BY	
TRAIL NO.		SLOPE		CONDITIONS Obsd - Steady Seepage.		F.			
1Dn	2:1	Drain. $\beta/c_b = 0.6$ - Emb. $(13:42.5)$ only.				1.20			
1Adn	2:1	Drain. $\beta/c_b = 0.6$ - Emb. $(13:42.5)$ only - 25' berm @ elev. 1334.5				1.50			
2Dn	2:1	Drain. $\beta/c_b = 0.6$ - Emb. $(34:100)$ only.				1.82			
3Dn	2:1	Drain. $\beta/c_b = 0.6$ - Emb. $(34:100)$ only.				1.87			
4Dn	2:1	Drain. $\beta/c_b = 0.6$ - Emb. $(34:100)$ only.				1.97			
5Dn	3:1	Emb. $(34:100)$ only - 10' berm @ elev. 1334.5.				1.68			
6Dn	3:1	Emb. $(34:100)$ only - 10' berm @ elev. 1334.5.				1.57			
7Dn	3:1	Emb. $(34:100)$ only - 10' berm @ elev. 1334.5.				1.22			
8Dn	3:1	Emb. $(34:100)$ & 10' found $(35:0)$ - 10' berm @ elev. 1334.5.				1.52			
9Dn	3:1	Emb. $(34:100)$ & 10' found $(35:0)$ - 10' berm @ elev. 1334.5.				1.53			
10Dn	2:1	Emb. $(34:100)$ & 10' found $(35:0)$ - Design. $\beta/c_b = 0.6$.				1.76			
11Dn	2:1	Emb. $(34:100)$ & 10' found $(35:0)$ - Design. $\beta/c_b = 0.6$.				1.62			
12Dn	2:1	Emb. $(34:100)$ & 10' found $(35:0)$ - Design. $\beta/c_b = 0.6$.				1.73			
Flood Plain Section									
13Dn	3:1	Emb. $(34:100)$ & 9' found $(35:0)$ - 10' berm @ elev. 1334.5.				1.49			
14Dn	3:1	Emb. $(34:100)$ & 10' found $(35:0)$ - 10' berm @ elev. 1334.5.				1.61			
15Dn	3:1	Emb. $(34:100)$ & 9' found $(35:0)$ - 10' berm @ elev. 1334.5.				1.21			
16Dn	3:1	Emb. $(34:100)$ & 9' found $(35:0)$ - 10' berm @ elev. 1334.5.				1.45			
17Dn	2:1	Drain. $\beta/c_b = 0.6$ - Emb. $(34:100)$ & 9' found $(35:0)$.				1.82			
18Dn	2:1	Drain. $\beta/c_b = 0.6$ - Emb. $(34:100)$ & 9' found $(35:0)$.				1.66			
19Dn	2:1	Drain. $\beta/c_b = 0.6$ - Emb. $(34:100)$ & 9' found $(35:0)$.				1.92			

APPENDIX E
REFERENCES


APPENDIX E

REFERENCES


- 1) U.S. Department of Commerce; Weather Bureau;
Hydrometeorological Report No. 33 - Seasonal Variation of the Probable Maximum Precipitation East of the 105th Meridian for Areas from 10 to 1,000 Square Miles and Durations of 6, 12, 24, and 48 Hours, April 1956.
- 2) H.W. King and E.F. Brater, Handbook of Hydraulics, 5th edition, McGraw-Hill, 1963.
- 3) University of the State of New York, Geology of New York, Education Leaflet 20, Reprinted 1973.
- 4) Elwyn E. Seelye, Design, 3rd edition, John Wiley and Sons, Inc., 1960.
- 5) U.S. Department of the Interior, Bureau of Reclamations;
Design of Small Dams, 2nd edition (rev. reprint), 1977.

APPENDIX F

DRAWINGS

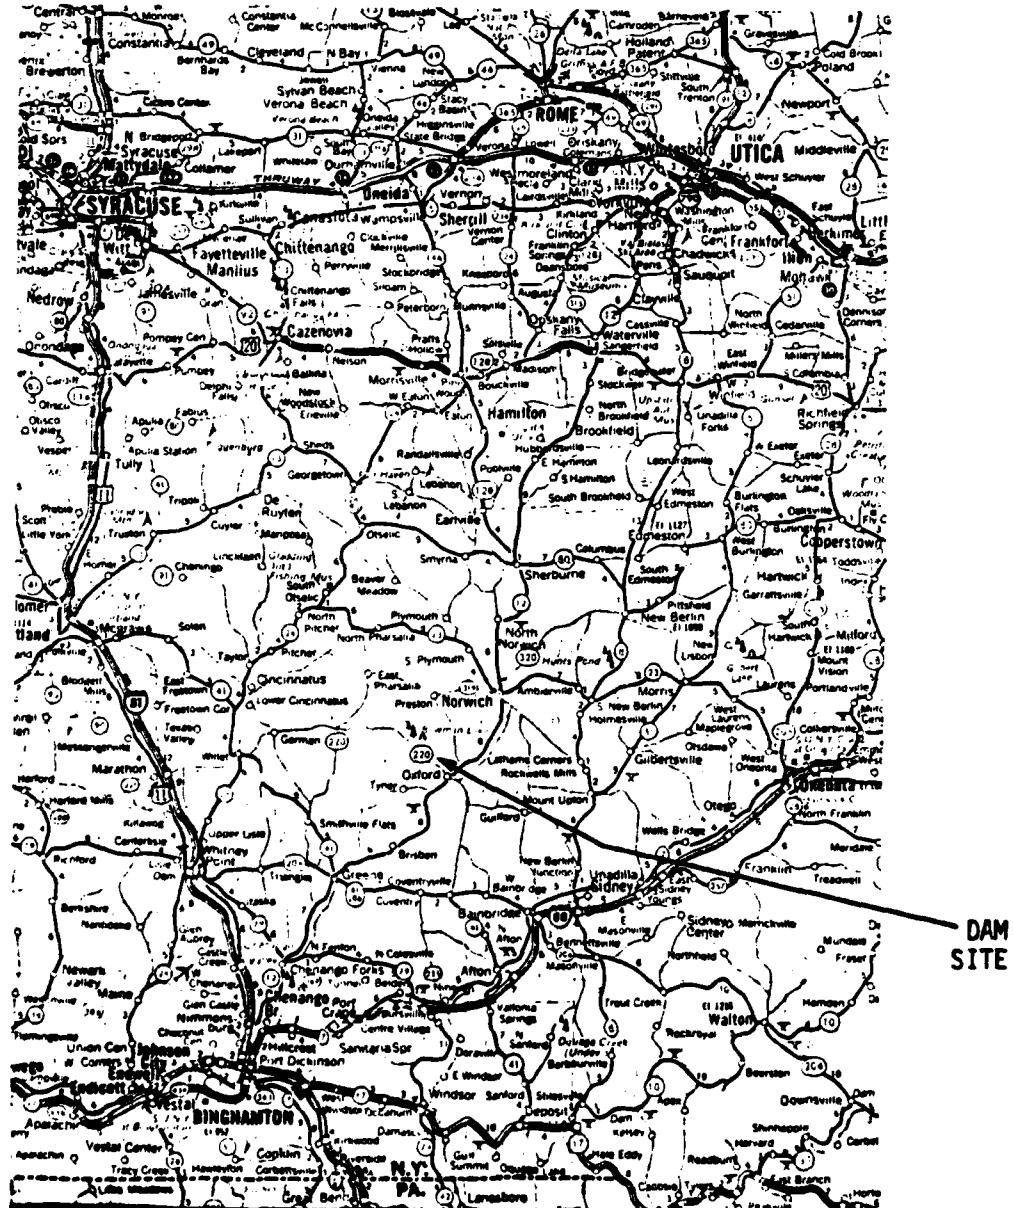

**VICINITY MAP
CLARK'S CREEK WATERSHED PROJECT
SITE I
NY-718**

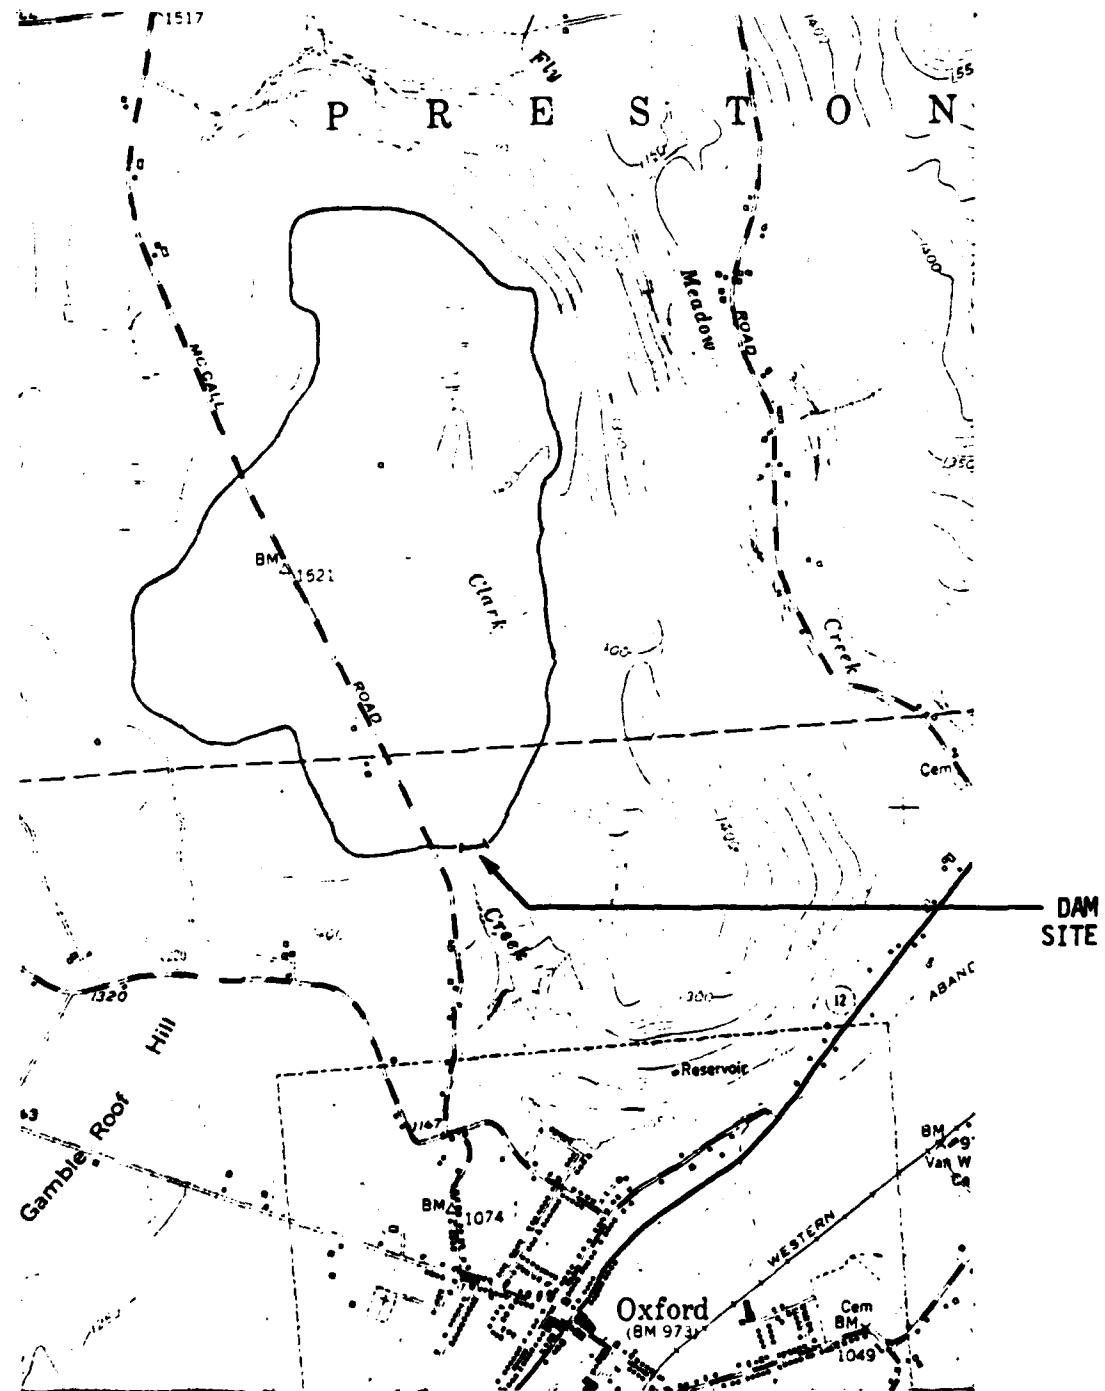

**TOPOGRAPHIC MAP
CLARK'S CREEK WATERSHED PROJECT
SITE I
NY-718**


CONSTRUCTION DETAILS

1. Areas under the dam (including 15 feet outside the toes), emergency spillway (including 15 feet outside the cut slopes), and borrow areas to be cleared and grubbed. Limits of areas to be cleared and grubbed to be staked in the field by the engineer.
2. The waste area and the area upstream from the dam and below elevation 1337.1 shall be cleared. Limits of area to be cleared will be staked in the field by the engineer.
3. Bottom section of emergency spillway to be covered with 8" of topsoil from STA 6+00 to approx. STA 7+76.
4. Waste areas shall be graded to be free draining & generally smooth. The maximum fill height shall be 5' unless otherwise approved by the engineer.
5. BORROW AREA
 - a) Limits of borrow area are approximate and final location to be determined by the engineer in the field at the time of construction.
 - b) Excavation will not be any closer than 90' feet from the upstream toe slope of dam and no lower than elevation 1329.0
 - c) The side slopes of borrow area will not be steeper than 1' vert. to 3' horiz. from intersection of natural ground and top of cut to elevation 1335.1 to slope of 1' vert. to 2' horiz. to intersection of bottom of pool.
 - d) Bottom of pool slope will not be less than 1% from elevation 1329.0 to intersection of 1:1 slope.
 - e) At the completion of earth fill operations, the borrow areas above elevation 1335.1 shall be left gently sloping, generally smooth, and free draining.

DIVERSION #1

CONSTRUCTION DETAILS

1. Minimum depth of cut & of ditch to be 2' or as determined in the field by the engineer at the time of construction.
2. The grades as stated are only approx. The final location and finished grades will be established in the field by the engineer at time of construction.

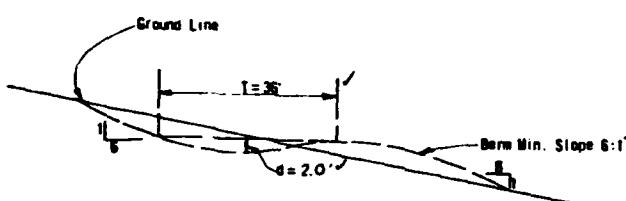

TYPICAL SECTION DIVERSION NO.1

Center Line Profile Grades Vary

0+00-thru 2+50 0-00 thru 3-00 - 4.0% Grade
2+50-thru 4+50 2-00 thru 5-00 - 1.0% Grade
4+50-thru 8+30 5-00 thru 6-00 - 0.9% Grade

DIVERSION = 830 L.F.

CLEARING = 0.6Ac.

MOO. "1-10774-CLEAR+GRUB = 5.5Ac.

SEEDING = 15.9 Ac.

BENCH MARK DESCRIPTION

W. MON. ELEV. 1312.42
BRASS CAP IN 3" CONCRETE POST
E OF DAM STA. 6+74.36
W. OF MC CALL ROAD

CENTER MON. ELEV. 1317.01
BRASS CAP IN 3" CONCRETE POST
LEFT SIDE OF OUTLET CHANNEL
302.94' BEYOND STA. 8+23 ON LINE W/ LEFT LEG OF DAM

N.E. MON. ELEV. 1370.85
BRASS CAP IN 3" CONCRETE POST
E OF DAM STA. 0-19.91

BM 6.1 ELEV. 1343.46
RAILROAD SPIKE IN 16" DBH BLACK CEDAR
N. SIDE OF TREE, APPROX 120' NW & DAM STA. 14-00

BM 6.6 ELEV. 1367.28
RAILROAD SPIKE IN 14" DBH OAK, E. SIDE OF TREE
TREE IN FENCE LINE APPROX 175' UPS EMER SPWY STA. 4-00

BM 6.7 ELEV. 1350.38
RAILROAD SPIKE IN 20" DBH ELM
UPSTREAM END OF BORROW AREA, NEAR OUTLET OF DIVERSION

BM 6.12 ELEV. 1357.92
BRASS CAP IN CENTER OF TOP DECK OF RISER

1

1

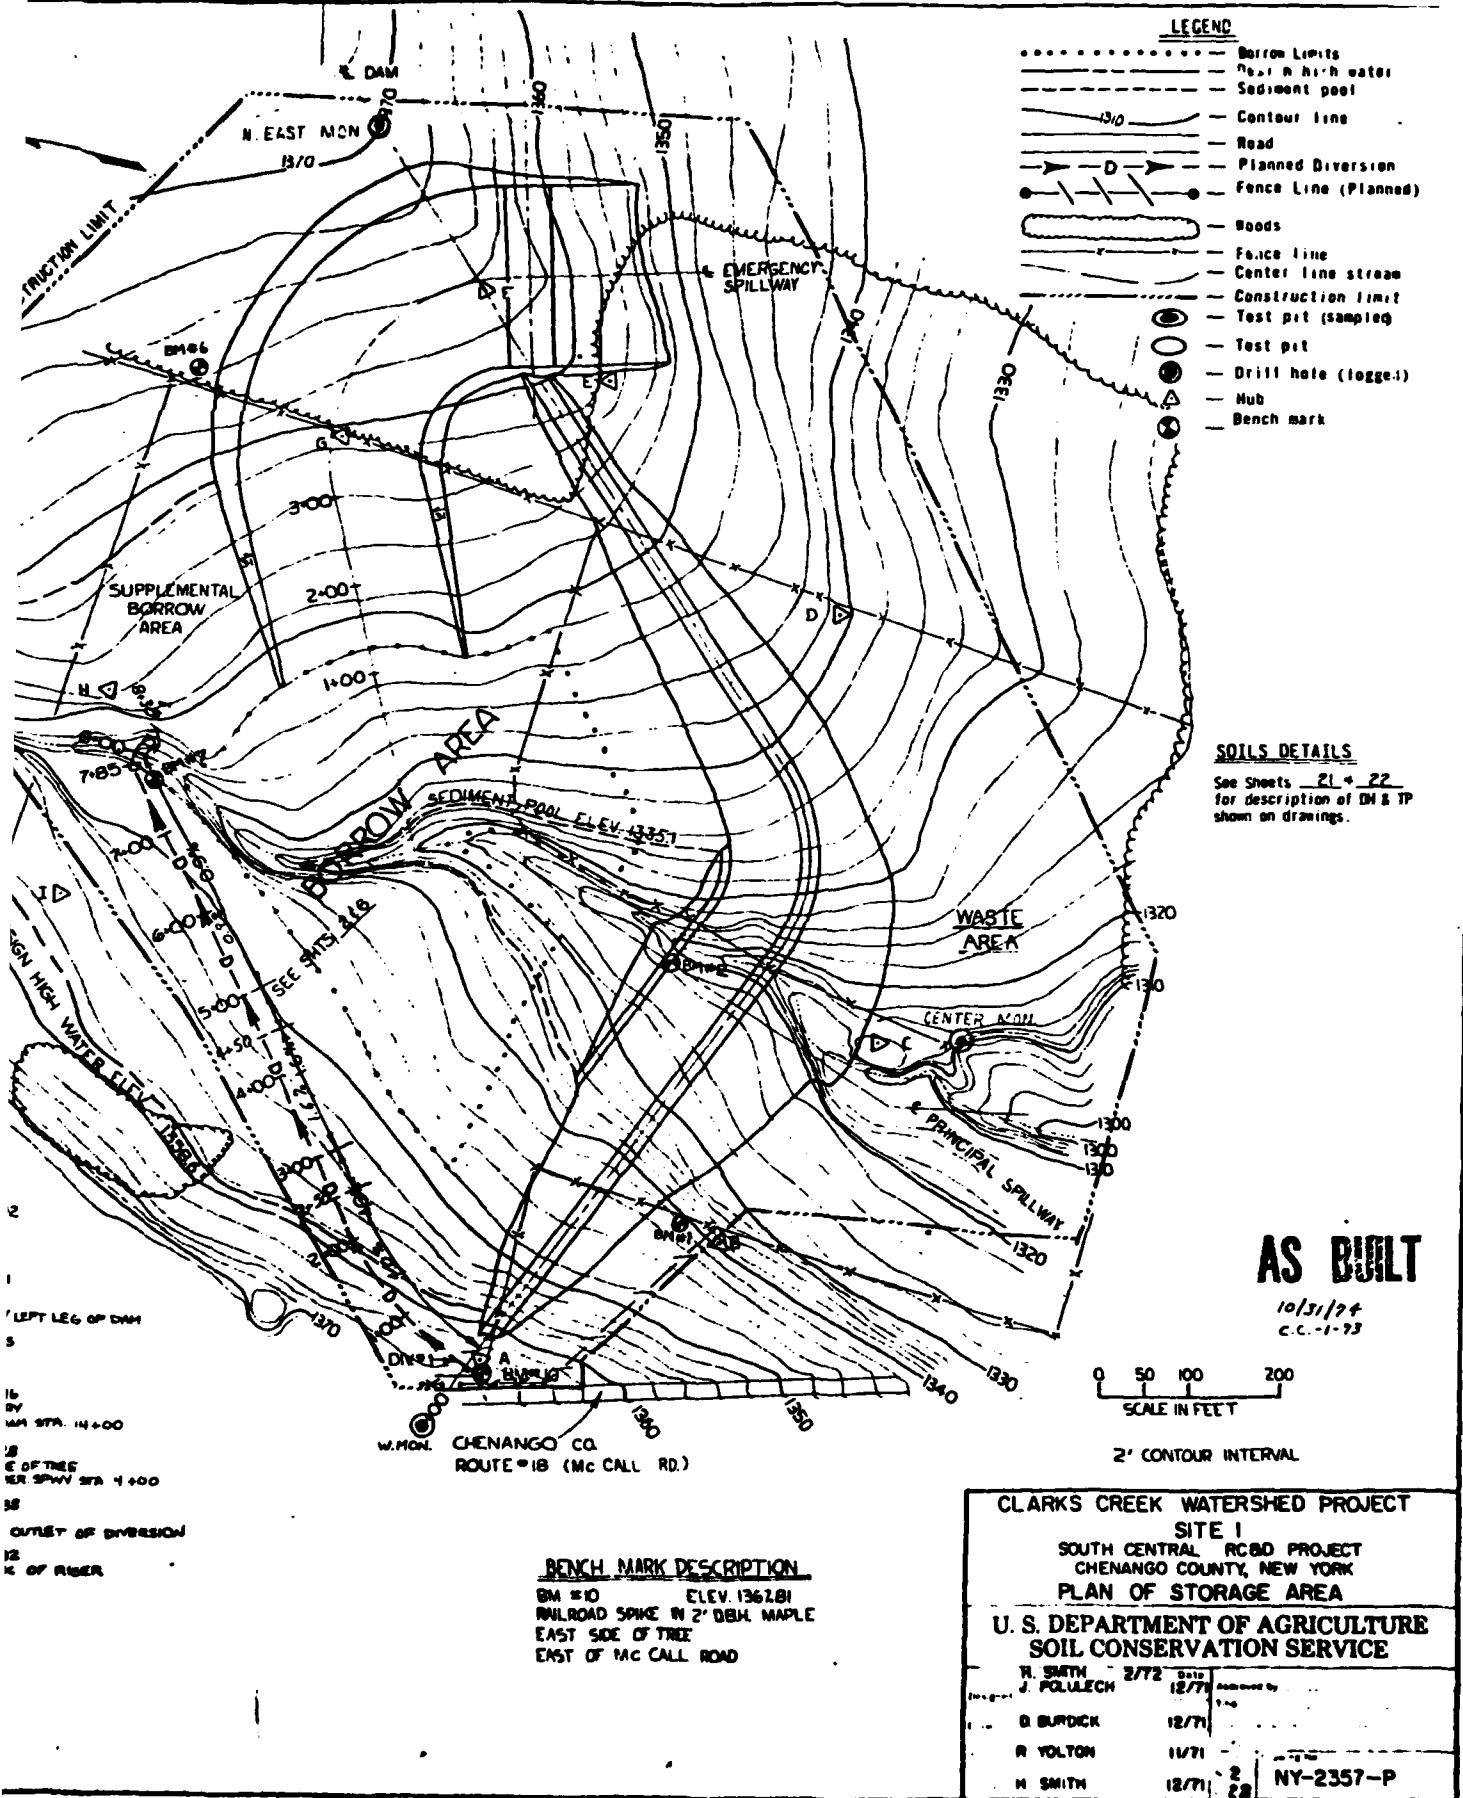

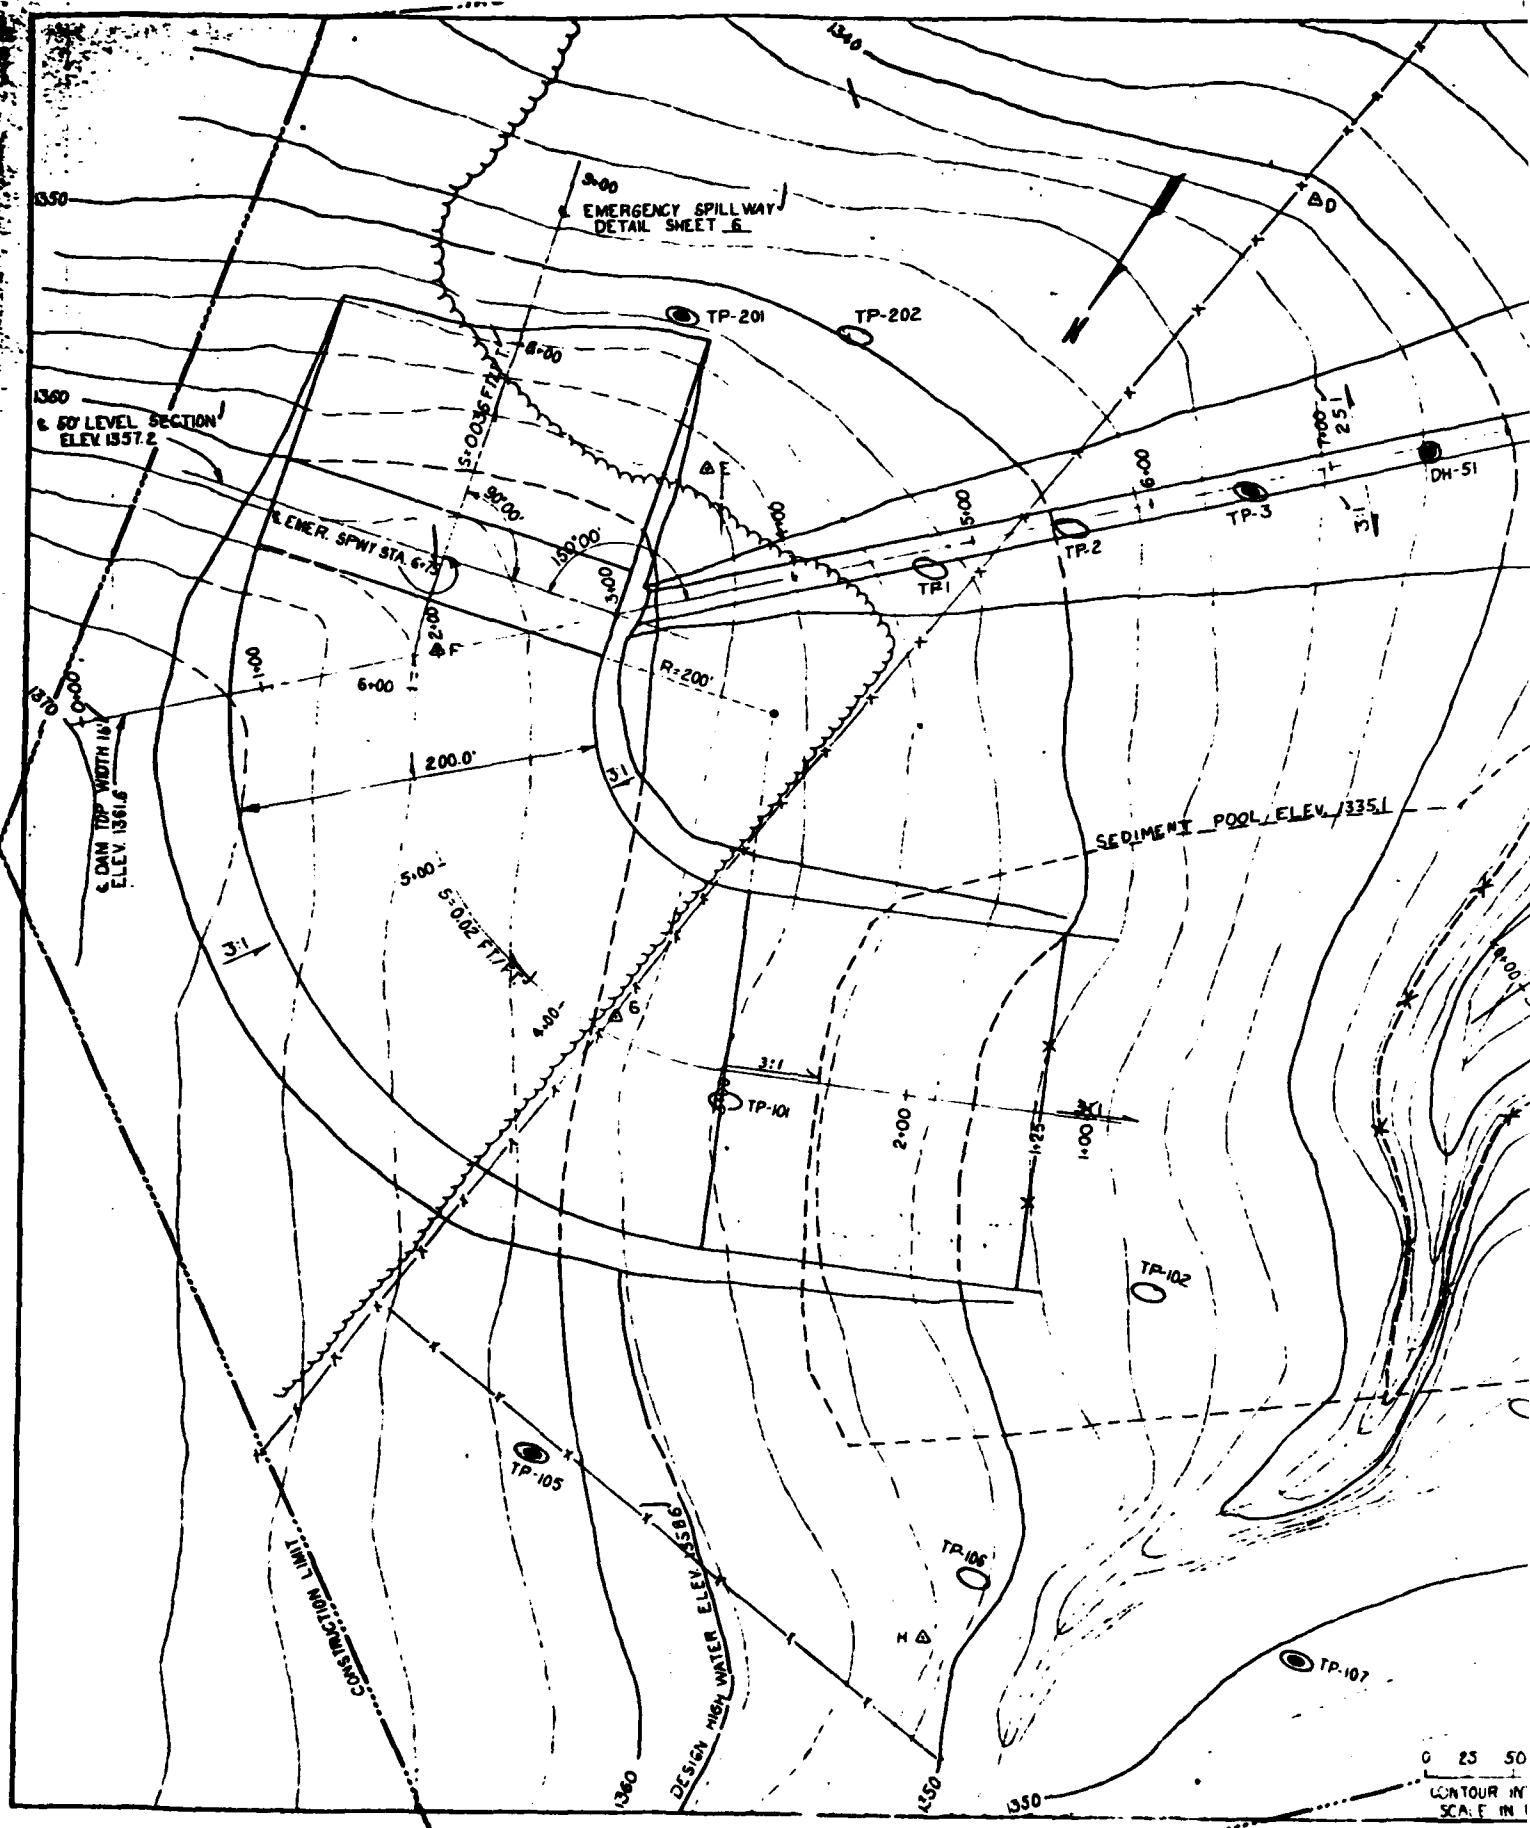

2

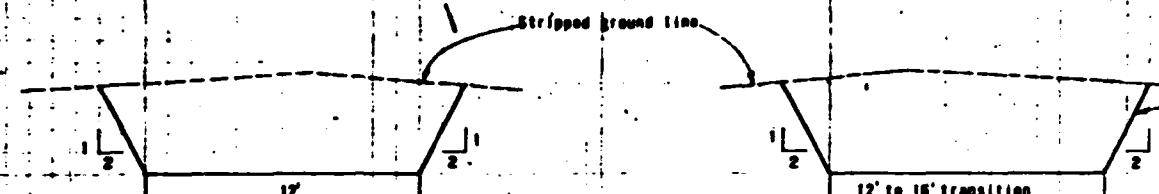


SECTION OF CUTOFF TRENCH AT STA. 5-00

Typical from approx. sta. 3+10 to sta.
10+00 and from sta. 12+50 to approx.
sta. 15+00. 15-07

SECTION OF CUTOFF TRENCH AT STA. 11-25




Typical from sta. 10+00 to sta. 10+50
and from sta. 11+00 to 12+50.

(Sections not to scale.)

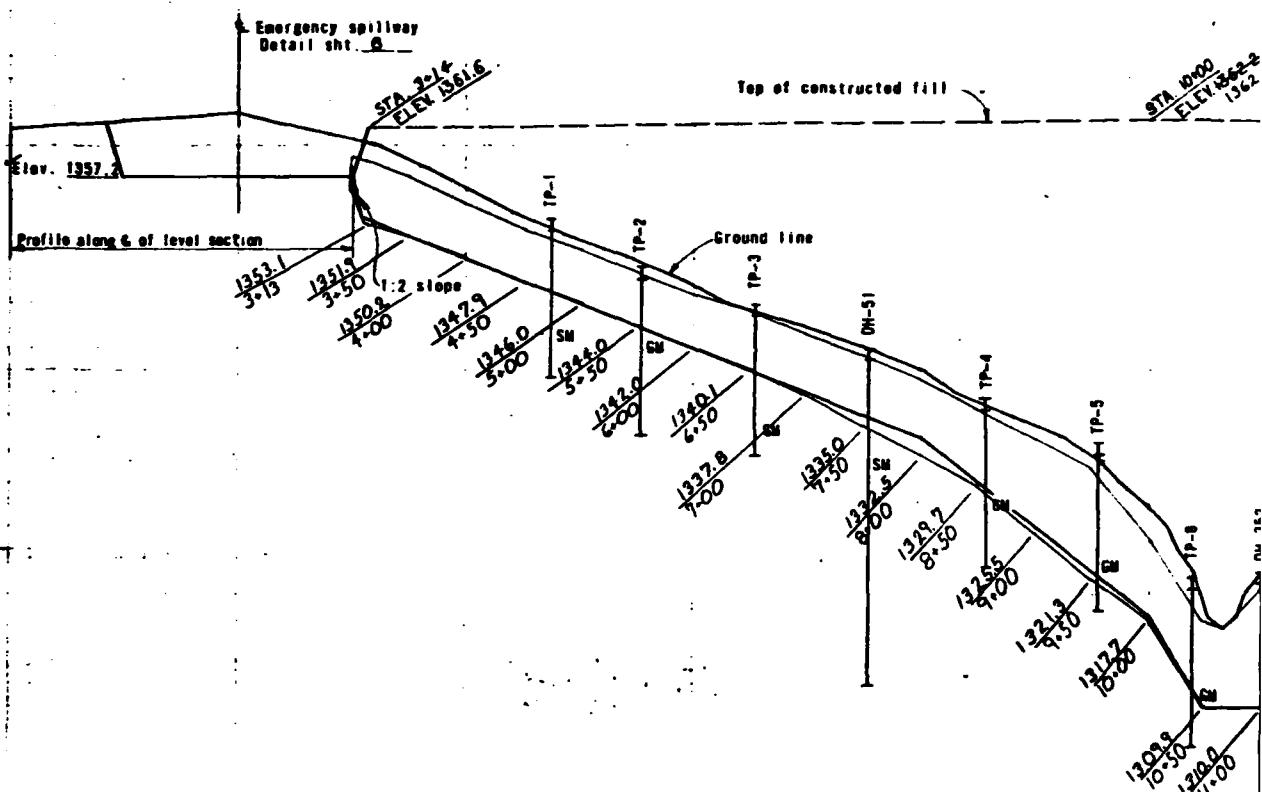

PROFILE ALONG S. OF CUTOFF TRENCH

Vert. scale in foot Horz. scale in foot

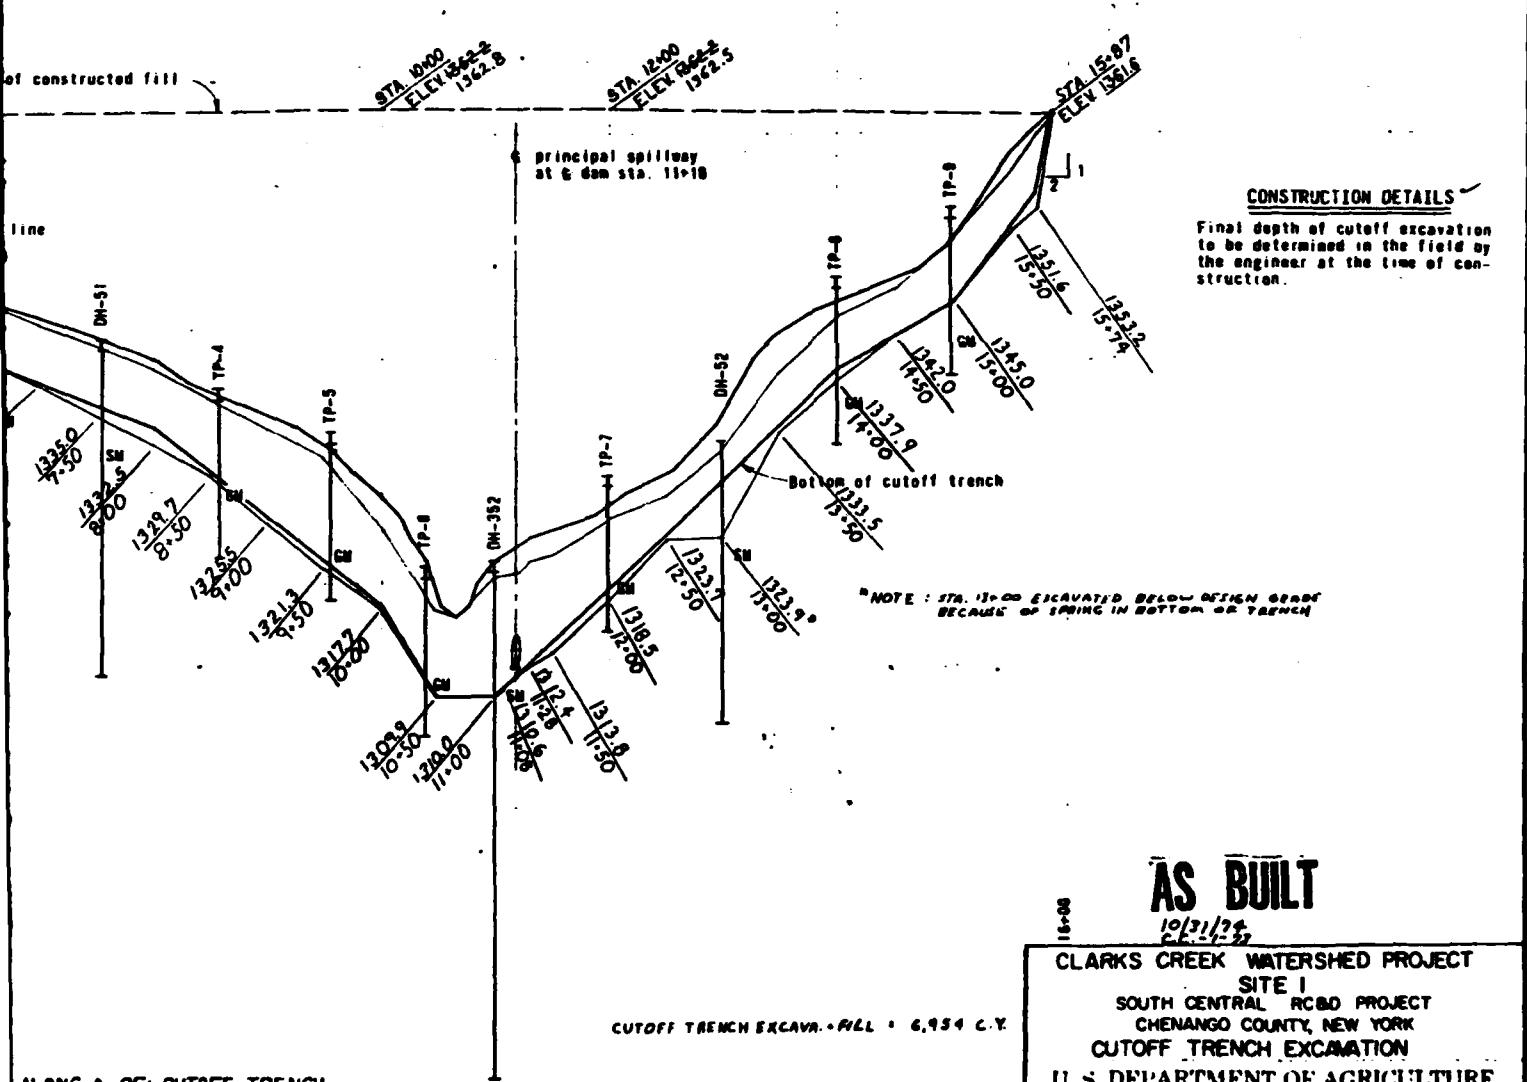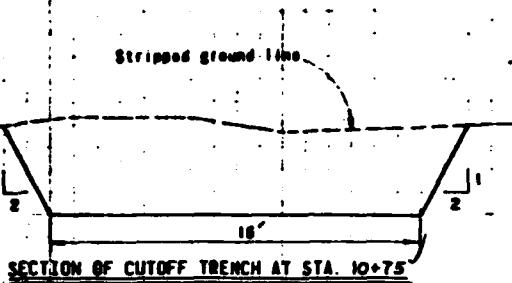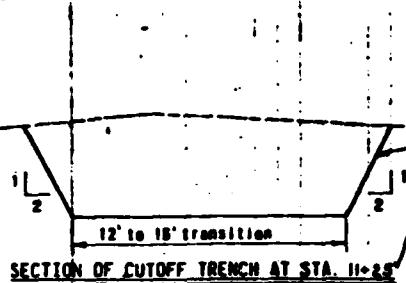

AS BUILT


CLARKS CREEK WATERSHED PROJECT	
SITE I	
SOUTH CENTRAL RCBD PROJECT	
CHENANGO COUNTY, NEW YORK	
CUTOFF TRENCH EXCAVATION	
U. S. DEPARTMENT OF AGRICULTURE	
SOIL CONSERVATION SERVICE	
M. SMITH	1/72
J. POLULECH	12/71
D. BURDICK	12/71
JOT	3/72
NY-2357-P	

ALONG S. OF CUTOFF TRENCH

0 10 0 40 0 100
feet in foot
Horiz. scale in feet

12 0 12 0 12 0


MS Inv 714 Sec 2 09

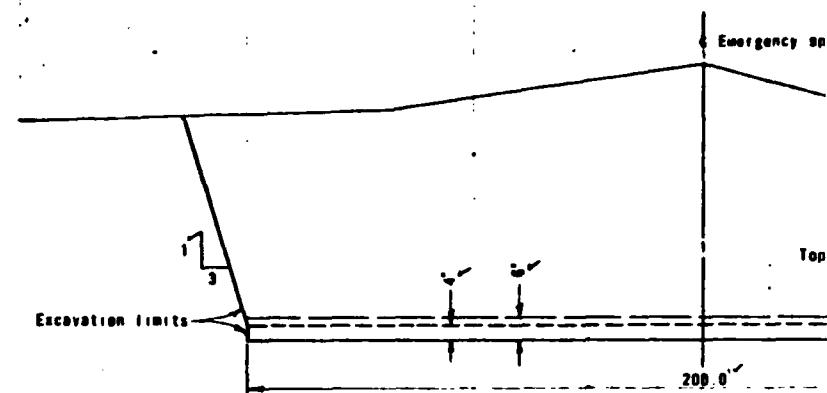

SECTION OF EMERGENCY SPILLW


Typical from sta. 5-00 to approximately
station limits to design bottom from app.
to sta. 5-00

Vert. scale in feet Horz. scale

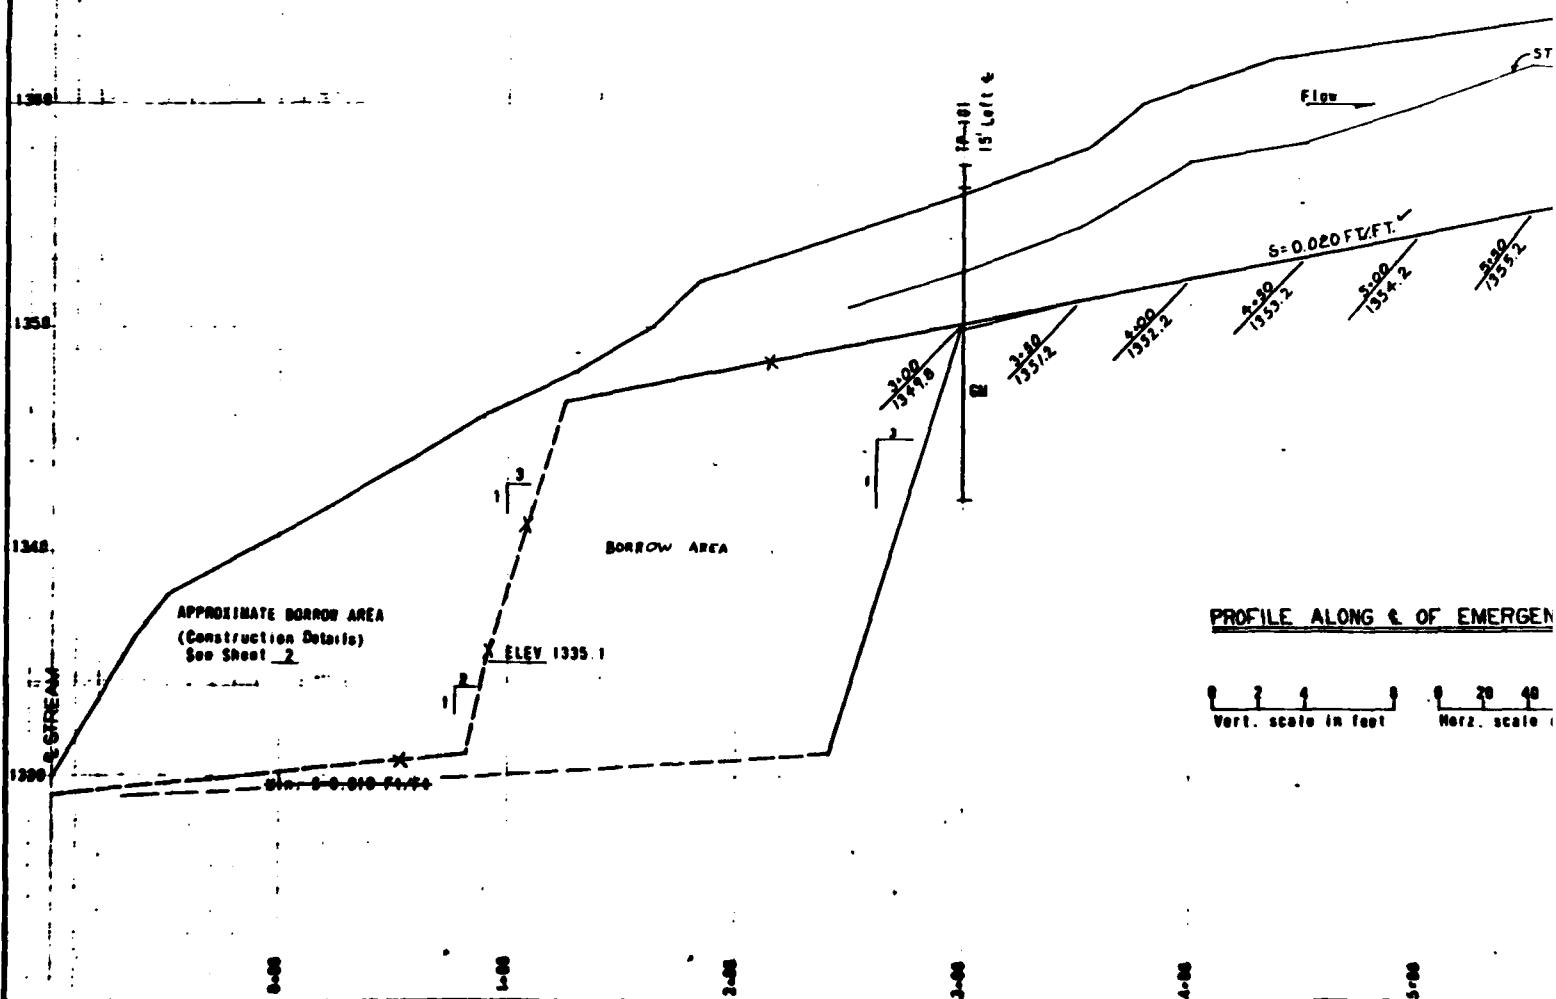

PROFILE ALONG E OF EMERGEN


Vert. scale in feet Horz. scale (

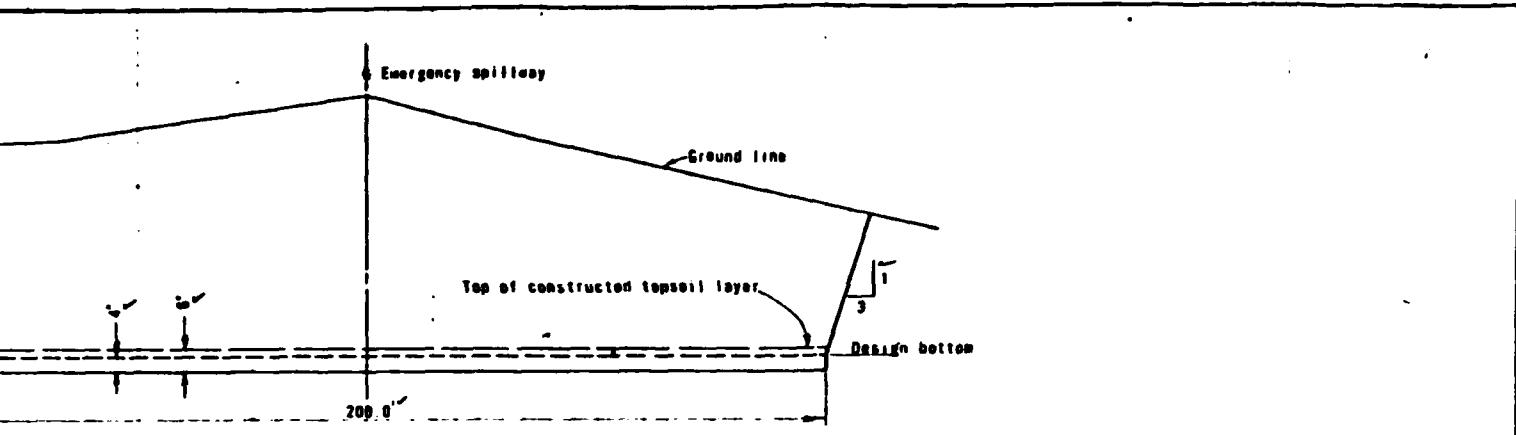

SECTION OF EMERGENCY SPILLWAY @ STA. 6+75

Typical from sta. ~~8+00~~ to approximately sta. ~~8+25~~ to excava-
tion limits to design bottom from approximately sta 8+25.00
to sta. ~~8+00~~

Vert. scale in feet Horz. scale in feet

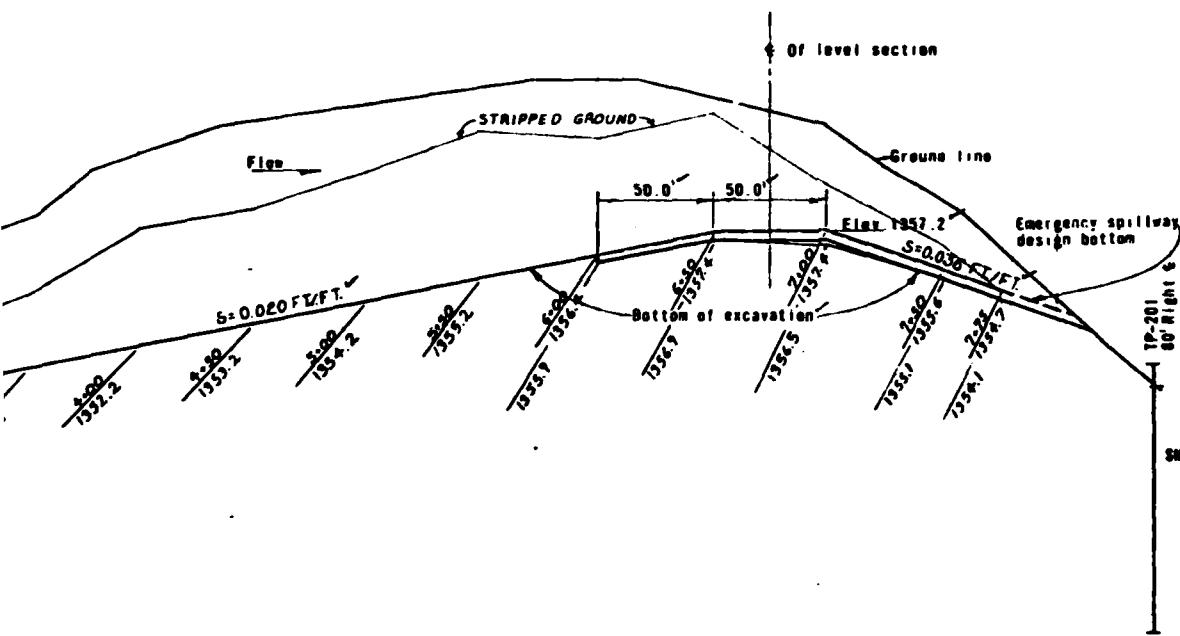



PROFILE ALONG S. OF EMERGENCY SPILLWAY

Vert. scale in feet Horz. scale in feet

TOPSAIL IN FOGGY SPOTS - 2702 3.1

CLARKS CREEK WATERSHED PROJECT
SITE 1
SOUTH CENTRAL RCBD PROJECT
CHENANGO COUNTY, NEW YORK
EMERGENCY SPILLWAY
U. S. DEPARTMENT OF AGRICULTURE
SOIL CONSERVATION SERVICE


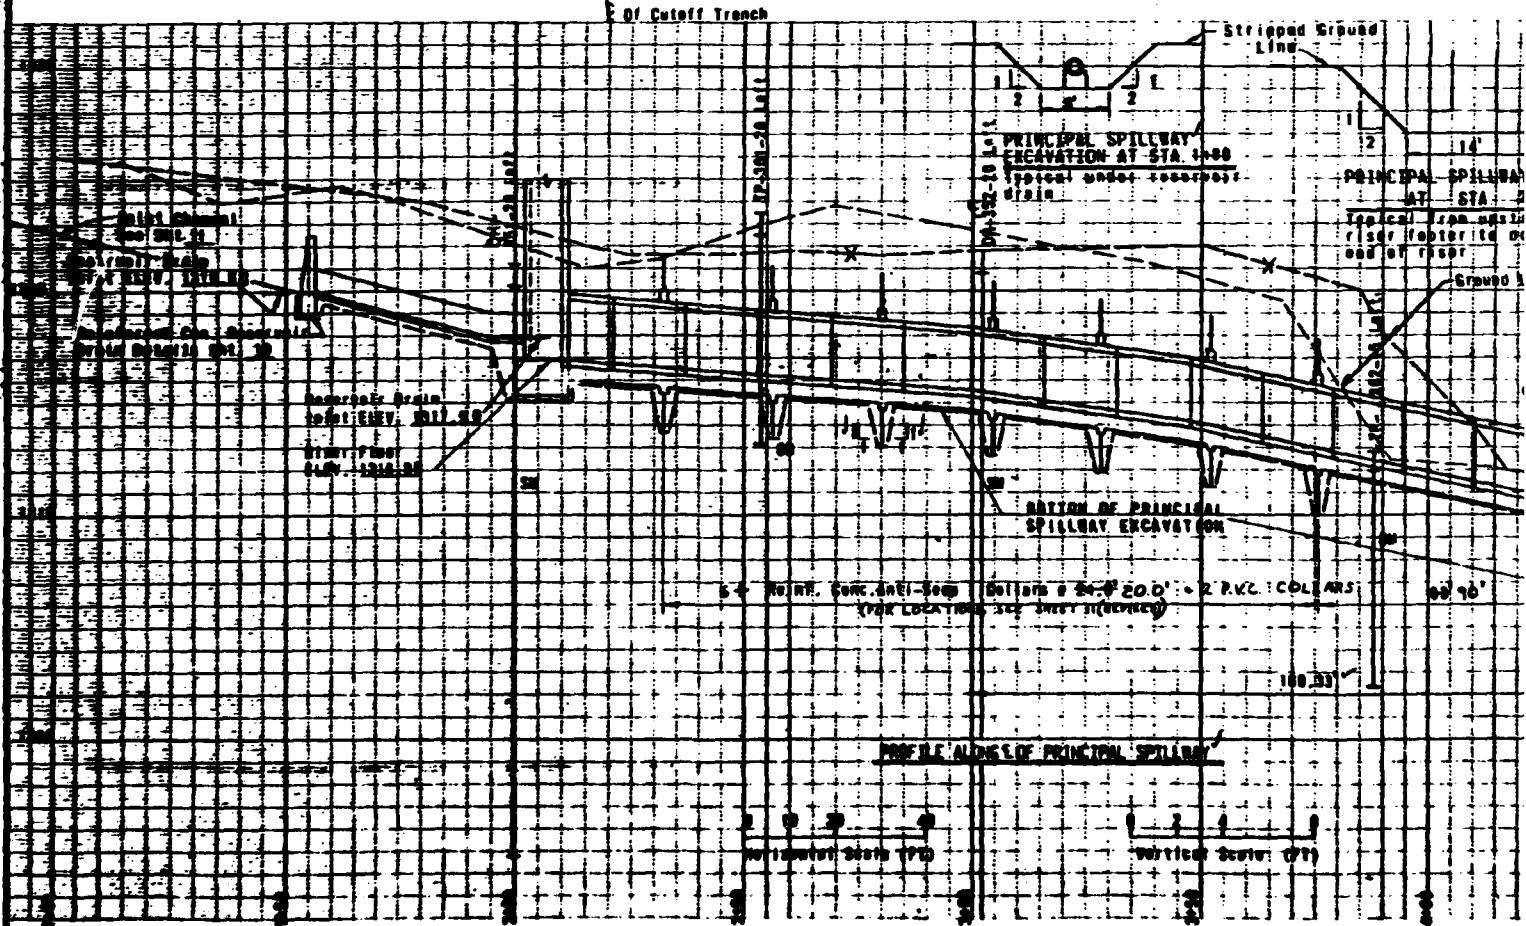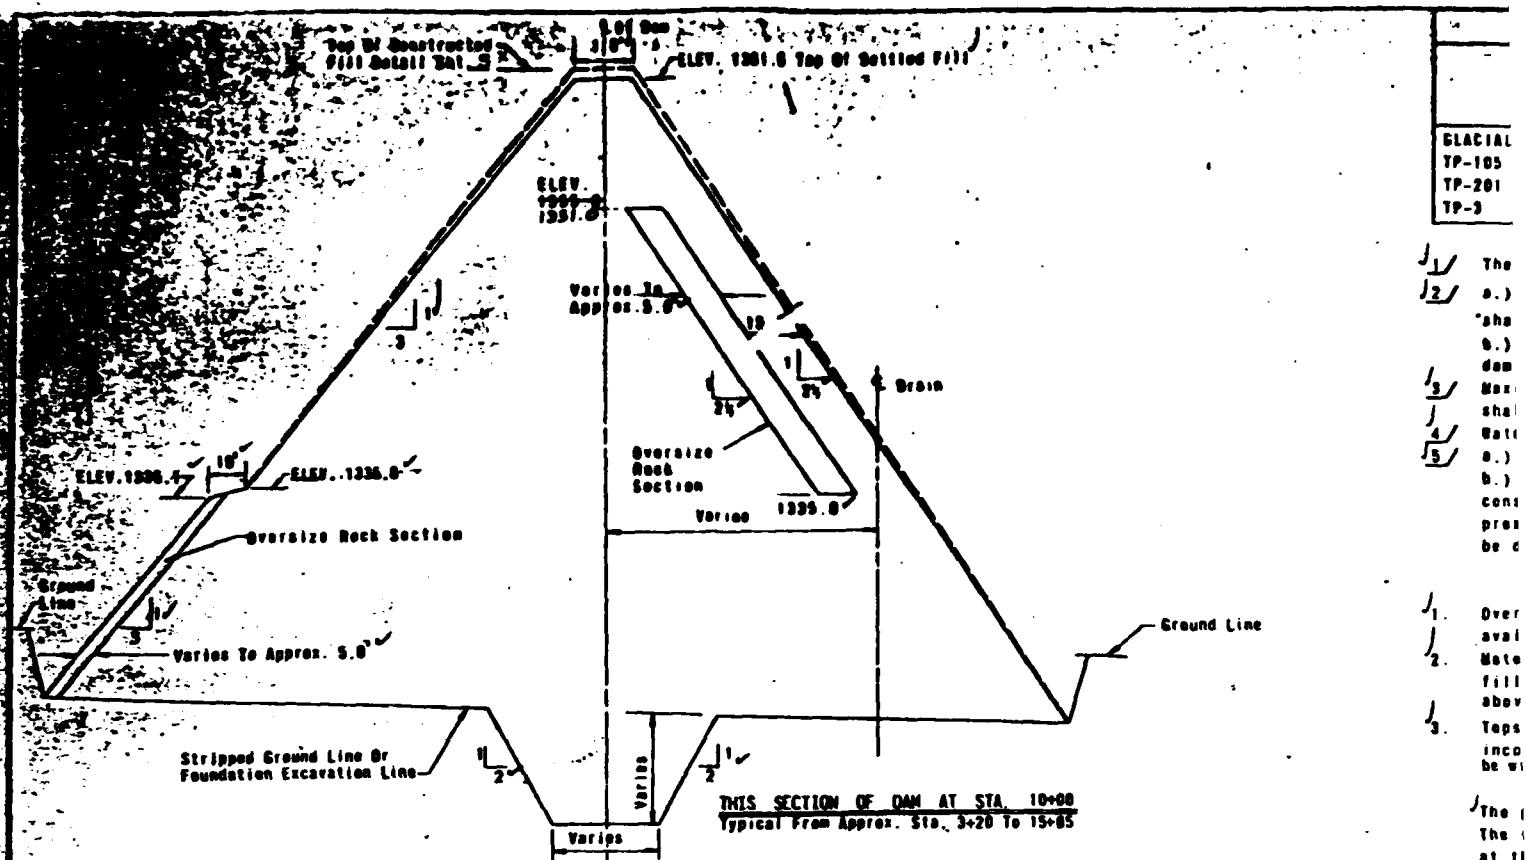

MATERIAL	Nom. Rock Size	Nom. Lift Thickness	MINIMUM REQUIRED DRY TENSILE STRENGTH	COMPACTATION	
				CLOSE	DEFINITION
GLACIAL TILL REPRESENTED BY: TP-105 From 1.0' to 10.0' TP-201 From 1.0' to 12.0' TP-3 From 1.0' to 13.0'	"	"	One (1) percentage point below optimum	"	100% of maximum density by A.S.T.M. D-698 method A


- J₁/ The placement table indicates estimated use of materials.
- J₂/ a.) Maximum rock size in backfill compacted by means of manually directed power tampers or plate vibrators shall be 3".
b.) Oversize material (0" to 10" inclusive) placed in the earth fill shall be raked to the portion of the dam labeled oversize rock sections as shown on the drawings.
- J₃/ Maximum lift thickness prior to compaction. The maximum lift thickness in the oversize rock sections shall be no greater than 10" prior to compaction.
- J₄/ Water content at time of compaction.
- J₅/ a.) For typical compaction curve see sheet 22.
b.) Use class C compaction in areas of dam containing oversize material. Class C compaction shall consist of a minimum of six passes per lift of fill by a tamper roller exerting a minimum contact pressure of 450 psi or equivalent as approved by the engineer. The final number of passes required will be determined by the engineer in the field.

CONSTRUCTION DETAILS


- J₁/ Oversize rock section boundaries are approximate. Adjustments will be made by the engineer to utilize available material.
- J₂/ Material placed in the oversize rock sections shall consist of oversize material raked from the earth fill. These sections shall be essentially free of materials less than 3". The oversize rock section above ELEV. 1335.0 may be relocated so as to be exposed at upstream slope of the dam as determined by the engg.
- J₃/ Topsoil that is suitable for use and not used on the specified area of the emergency spillway, shall be incorporated within the slopes of the earth fill as directed by the engineer. The source of topsoil shall be within the required excavation.



PRINCIPAL SPILLWAY EXCAVATION DETAILS


The profiles at the bottom of all excavations as shown are only approximate. The required finished grades will be established in the field by the engineer at the time of construction.

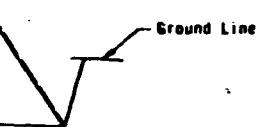

10+00
To 15+05

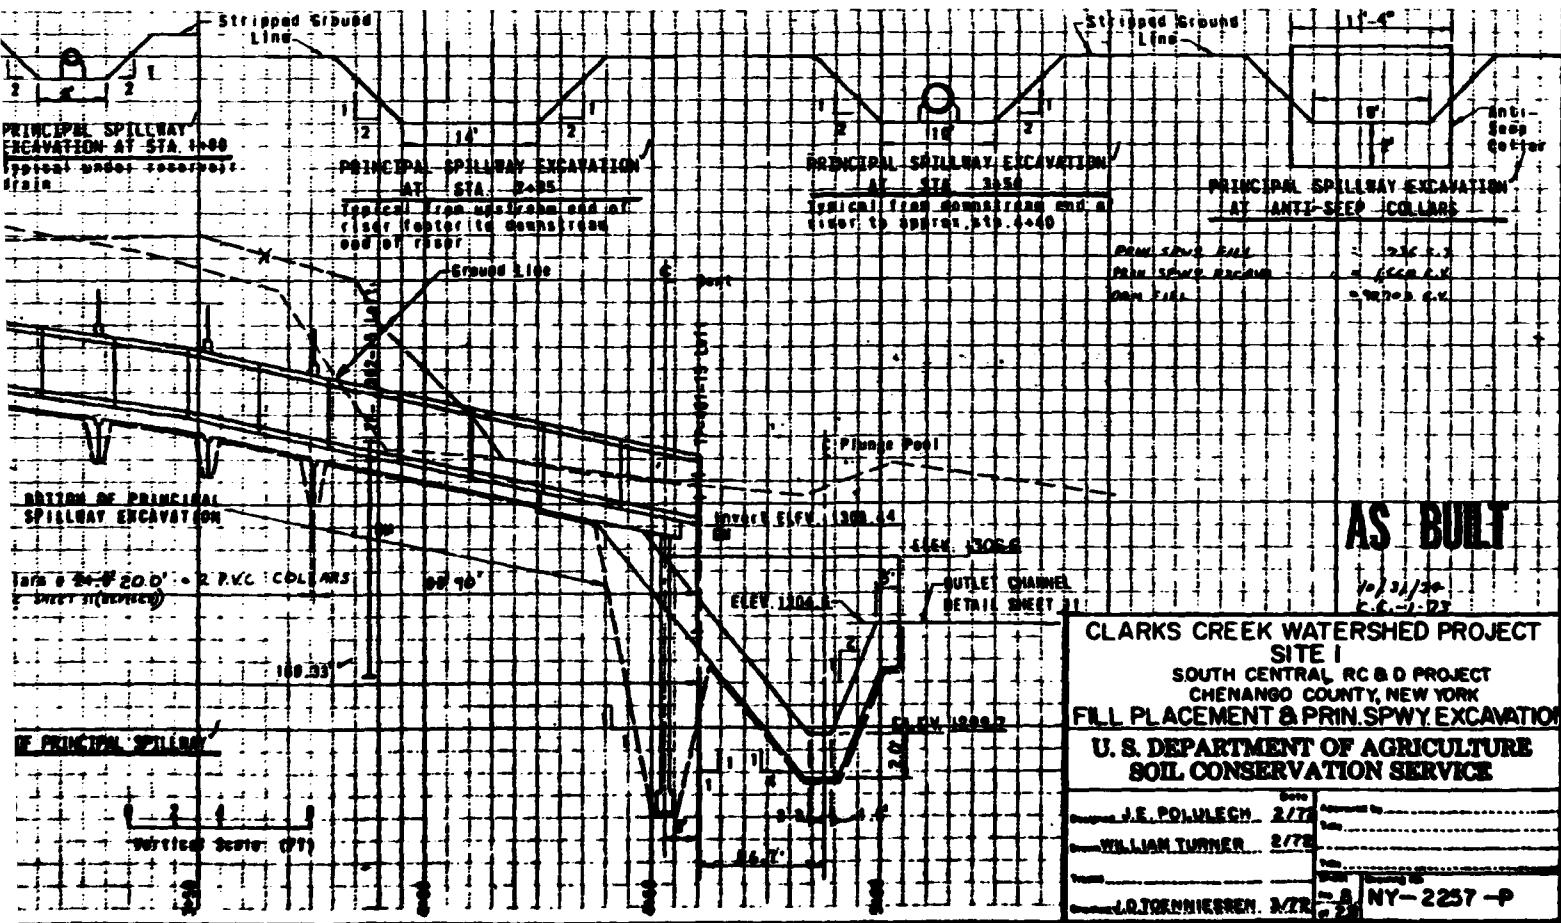

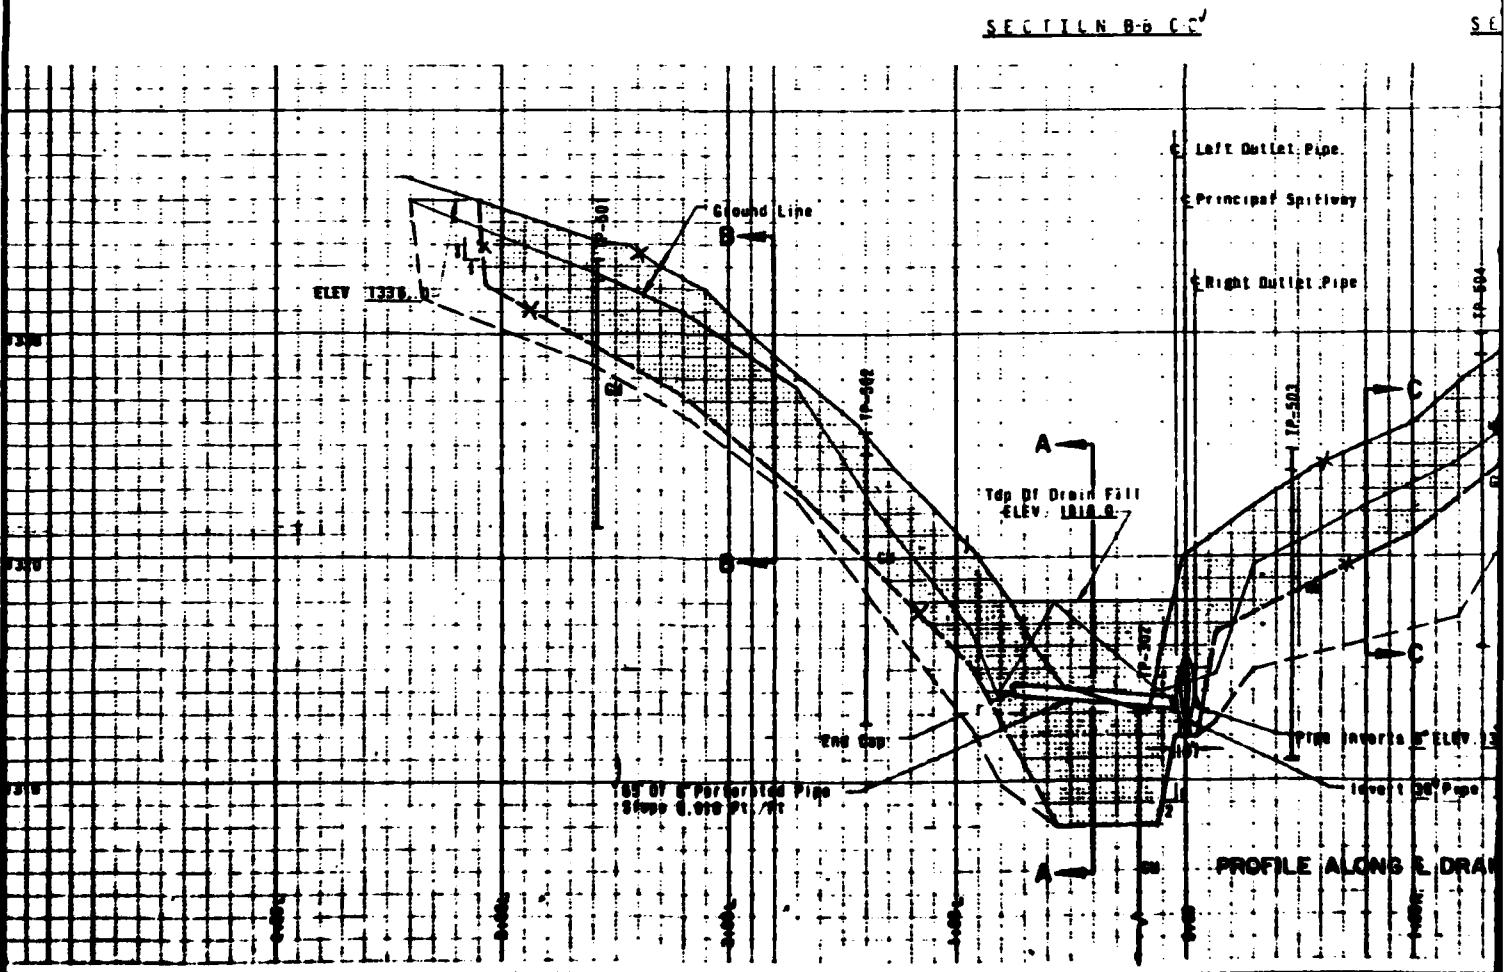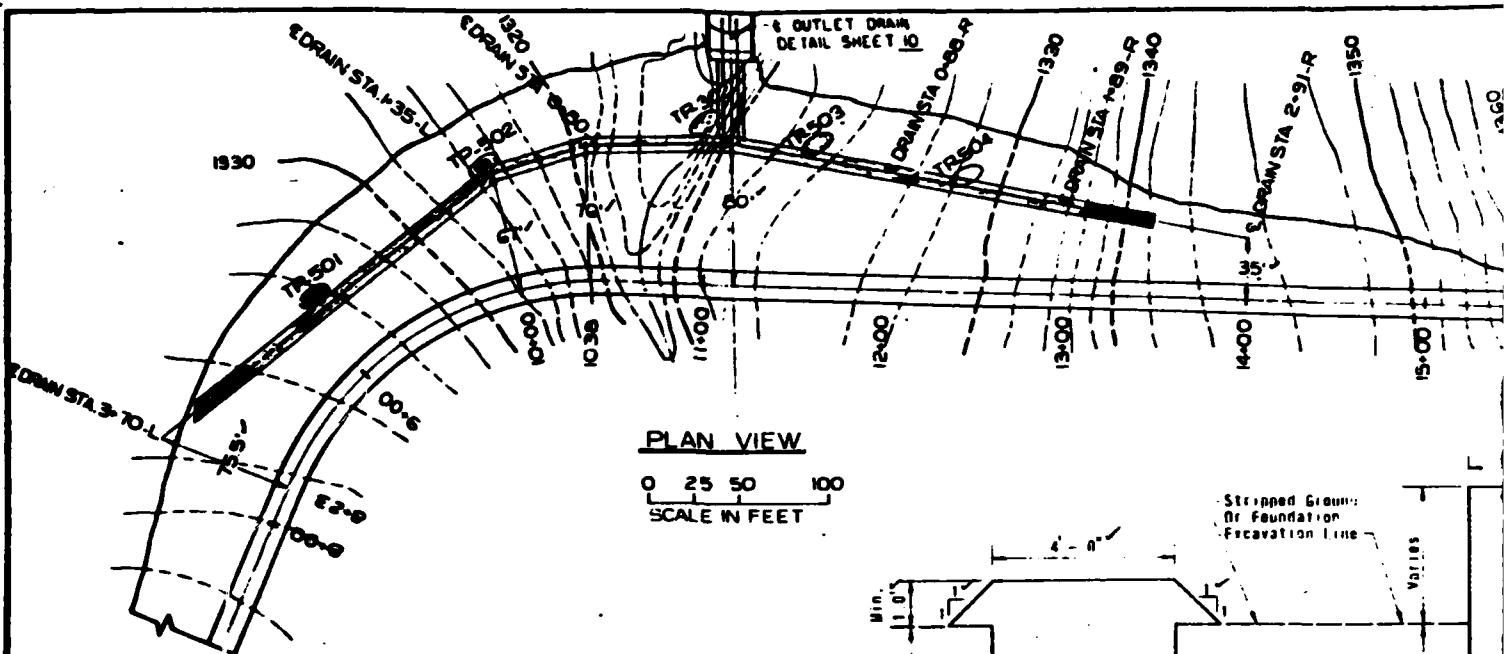

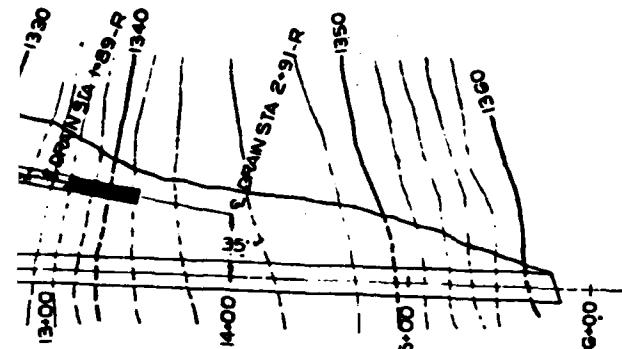

DRAINAGE SYSTEM DETAILS


1. Asbestos Cement Drain Pipe Shall Conform To Material Spec. 545 and Shall Be 6" Dia Pressure Pipe, Class 200.
2. The Bottom Profiles Elev. Of All Excavation as Shown Are Only Approx. The required finished Grades will Be Established in The Field At The Time of Construction By The Engineer.

QUANTITY SUMMARY


607	Cu.Yds. Of Grav. Fill
145	Lin.Ft. Of Straight Section Of 6" Perforated Asbestos Cement Pipe.
2	End Caps
1	90° 6" Cast Iron (External Angle) Elbow
22	Lin.Ft. Of Straight Section Of 6" Non-Perforated Asbestos Cement Pipe.

GRAIN SIZE DISTRIBUTION FOR DRAIN FILL

Drain fill shall meet the gradation of screening of the standard gradations from the January 2 1967 New York Public Works Specifications. In addition, the percentage of material in the drain fill finer than a #200 sieve shall not be more than three (3) percent.

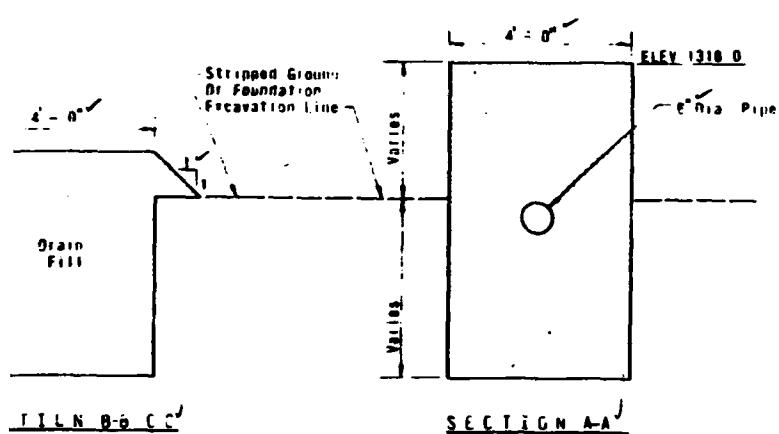

SECTION A-A

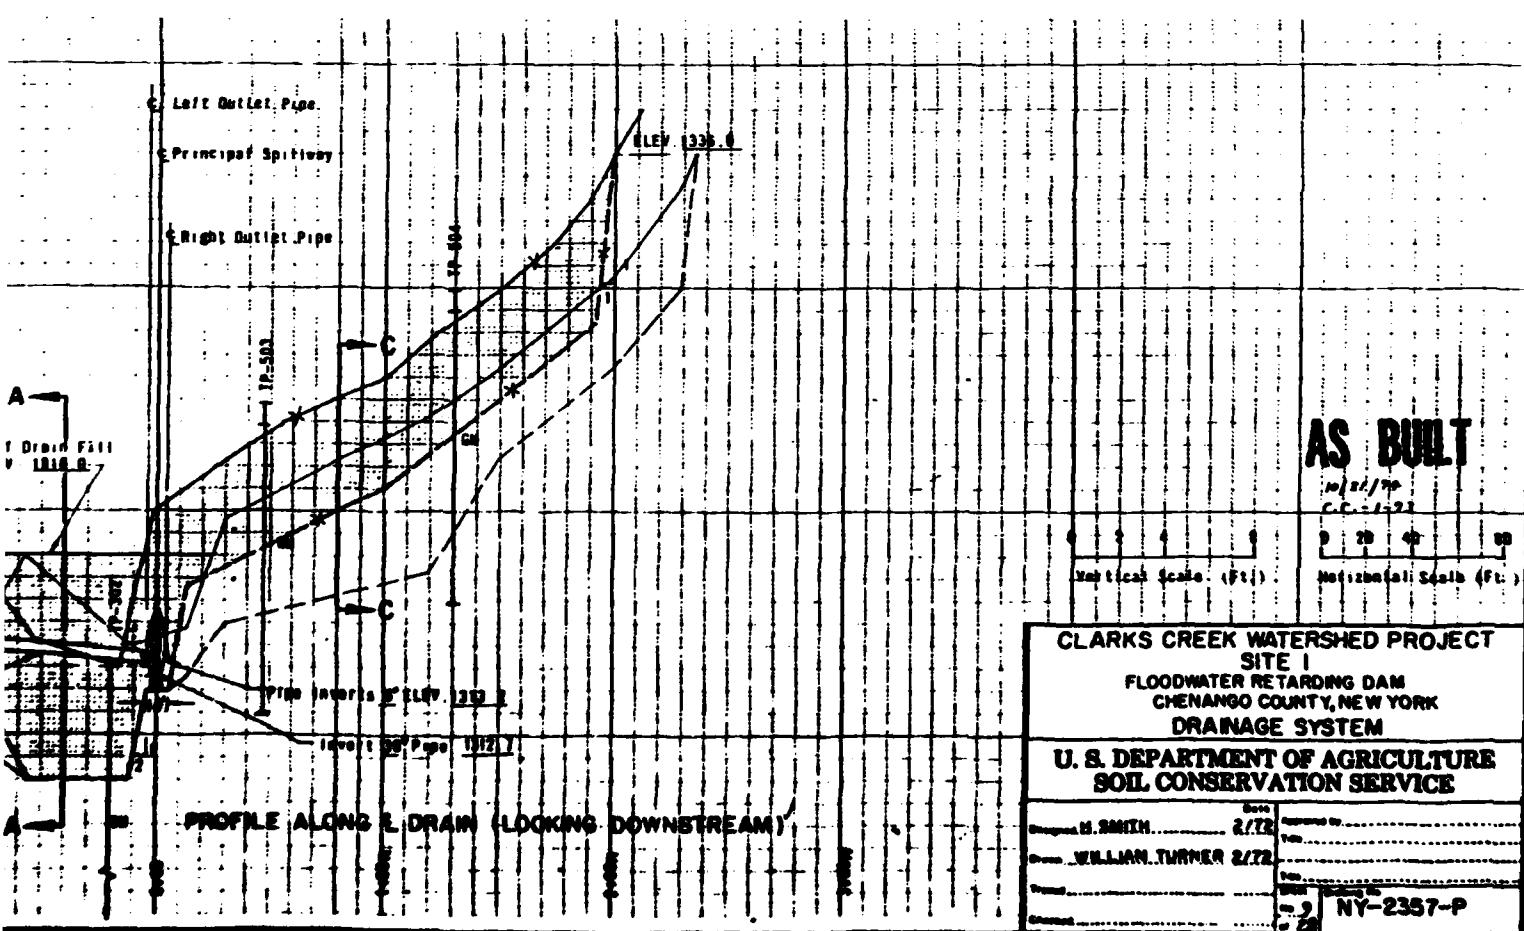

AS BUILT

M/SL/PP

C.C.-122

CLARKS CREEK WATERSHED PROJECT

SITE I

FLOODWATER RETARDING DAM

CHENANGO COUNTY, NEW YORK

DRAINAGE SYSTEM

U. S. DEPARTMENT OF AGRICULTURE
SOIL CONSERVATION SERVICE


H. SMITH..... 2/72

WILLIAM TURNER 2/72

.....

.....


NY-2357-P

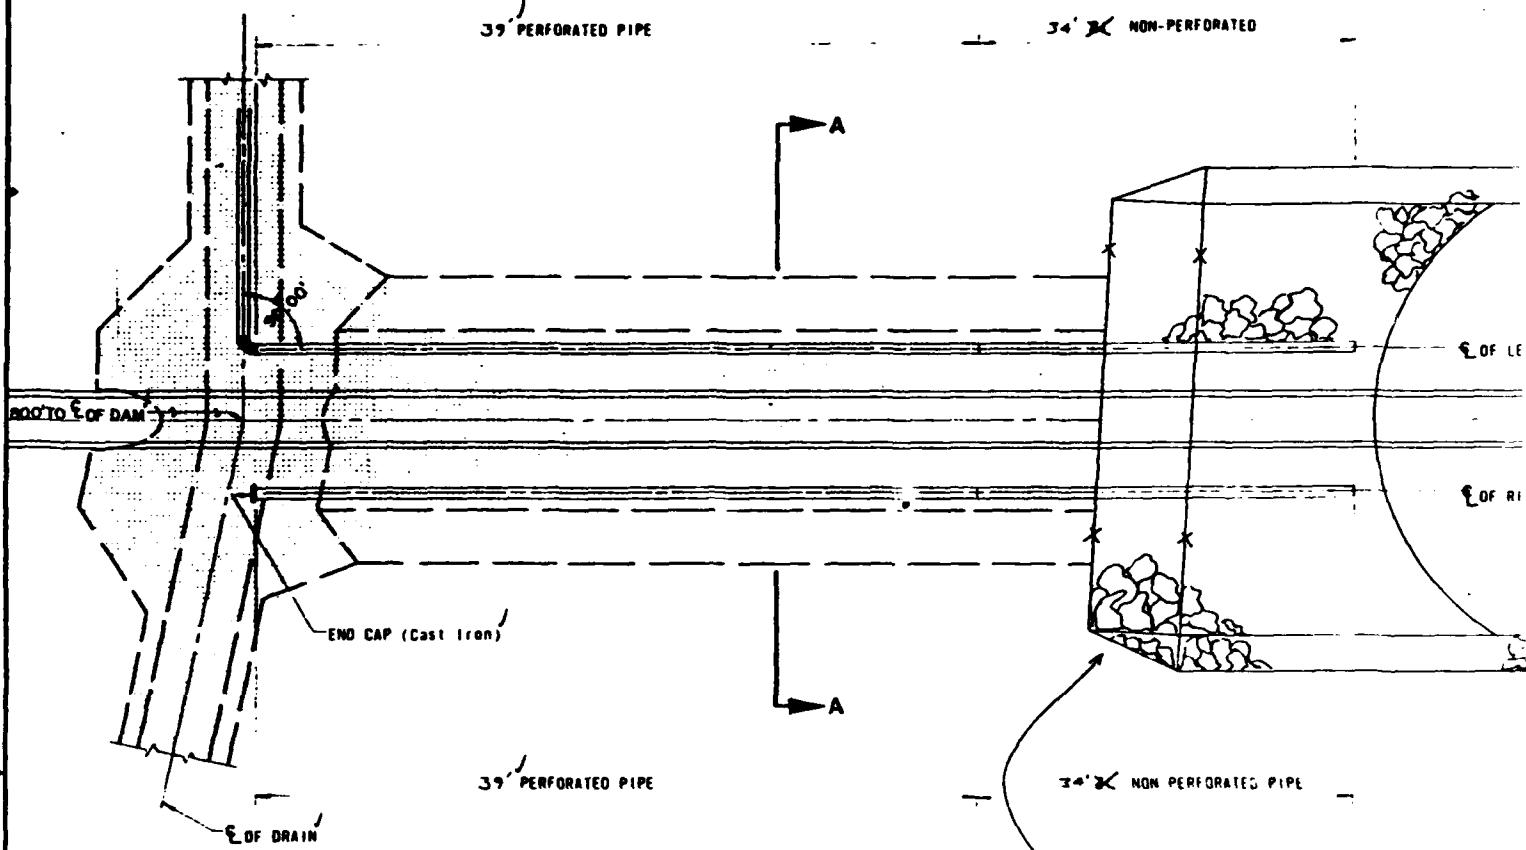

PLAN OF DRAIN OUTLET


0 5 10
(Scale in Feet)

RIPRAP REVISED IN THIS AREA.
DETAILS ON SHEET 10A.

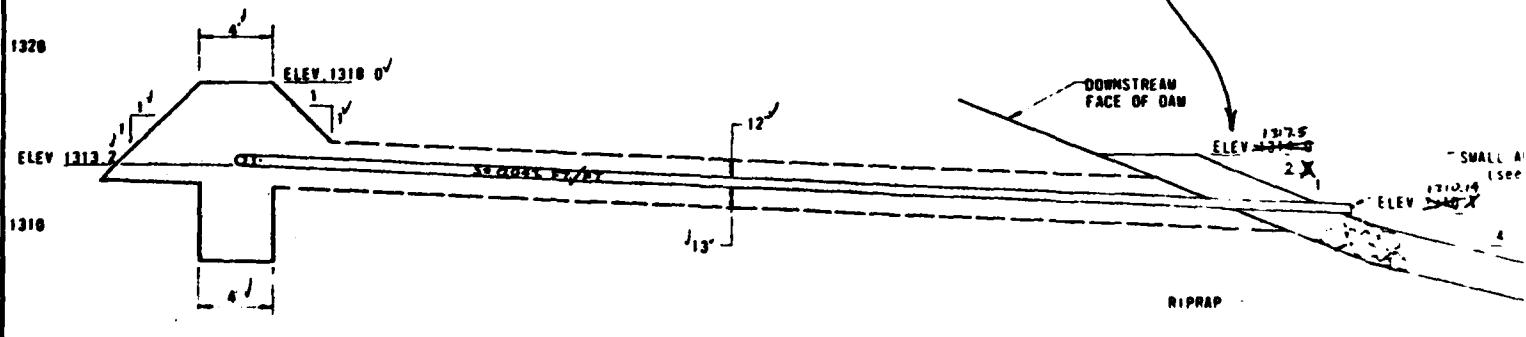


PROFILE ALONG DRAIN OUTLET

1

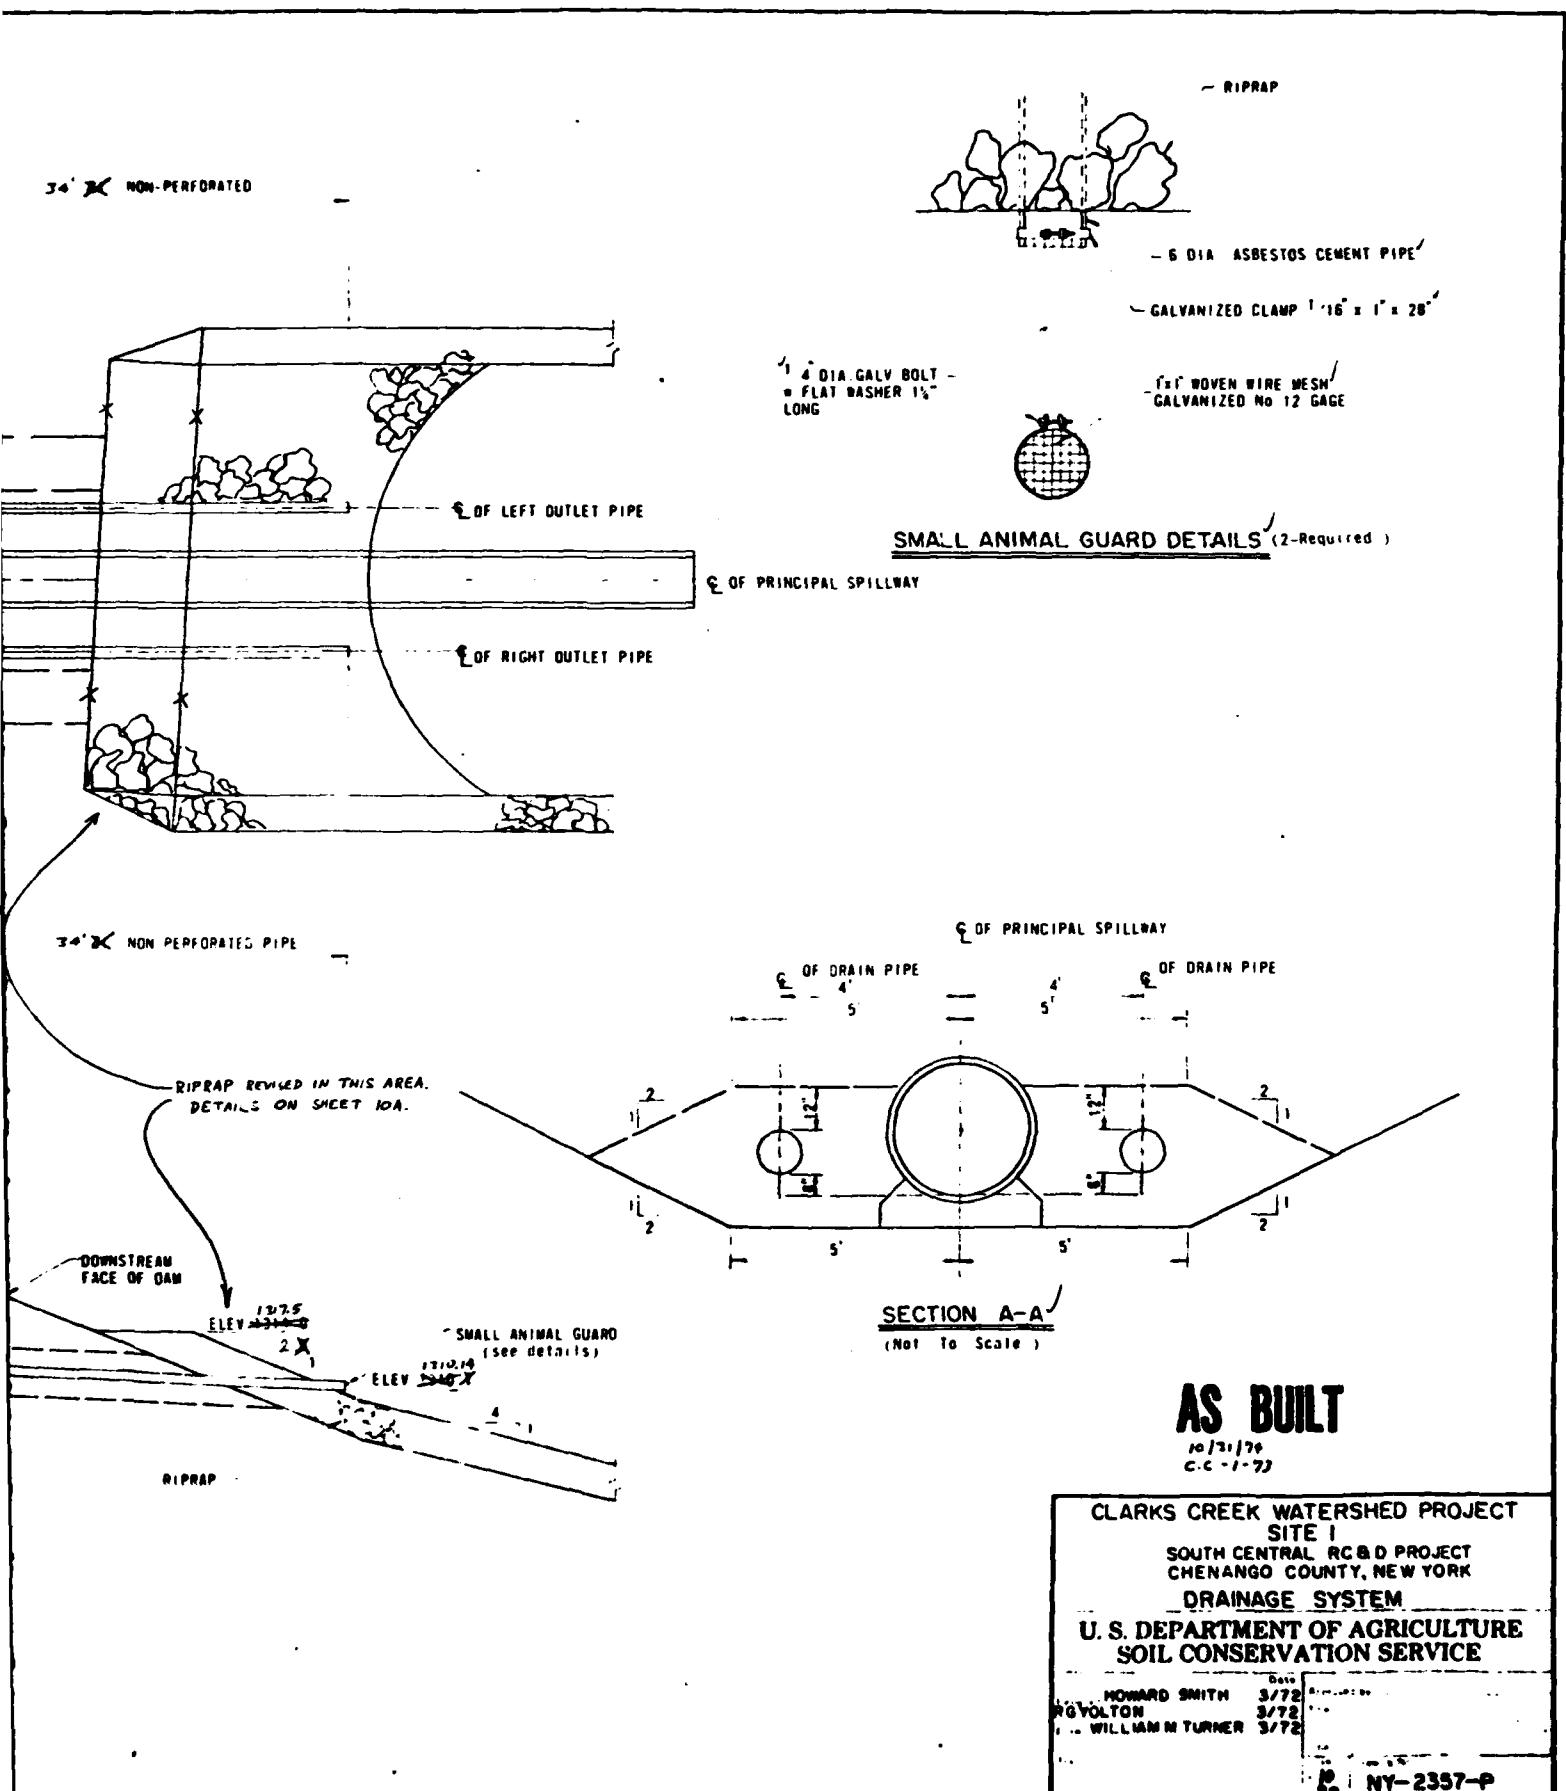


1 - 2

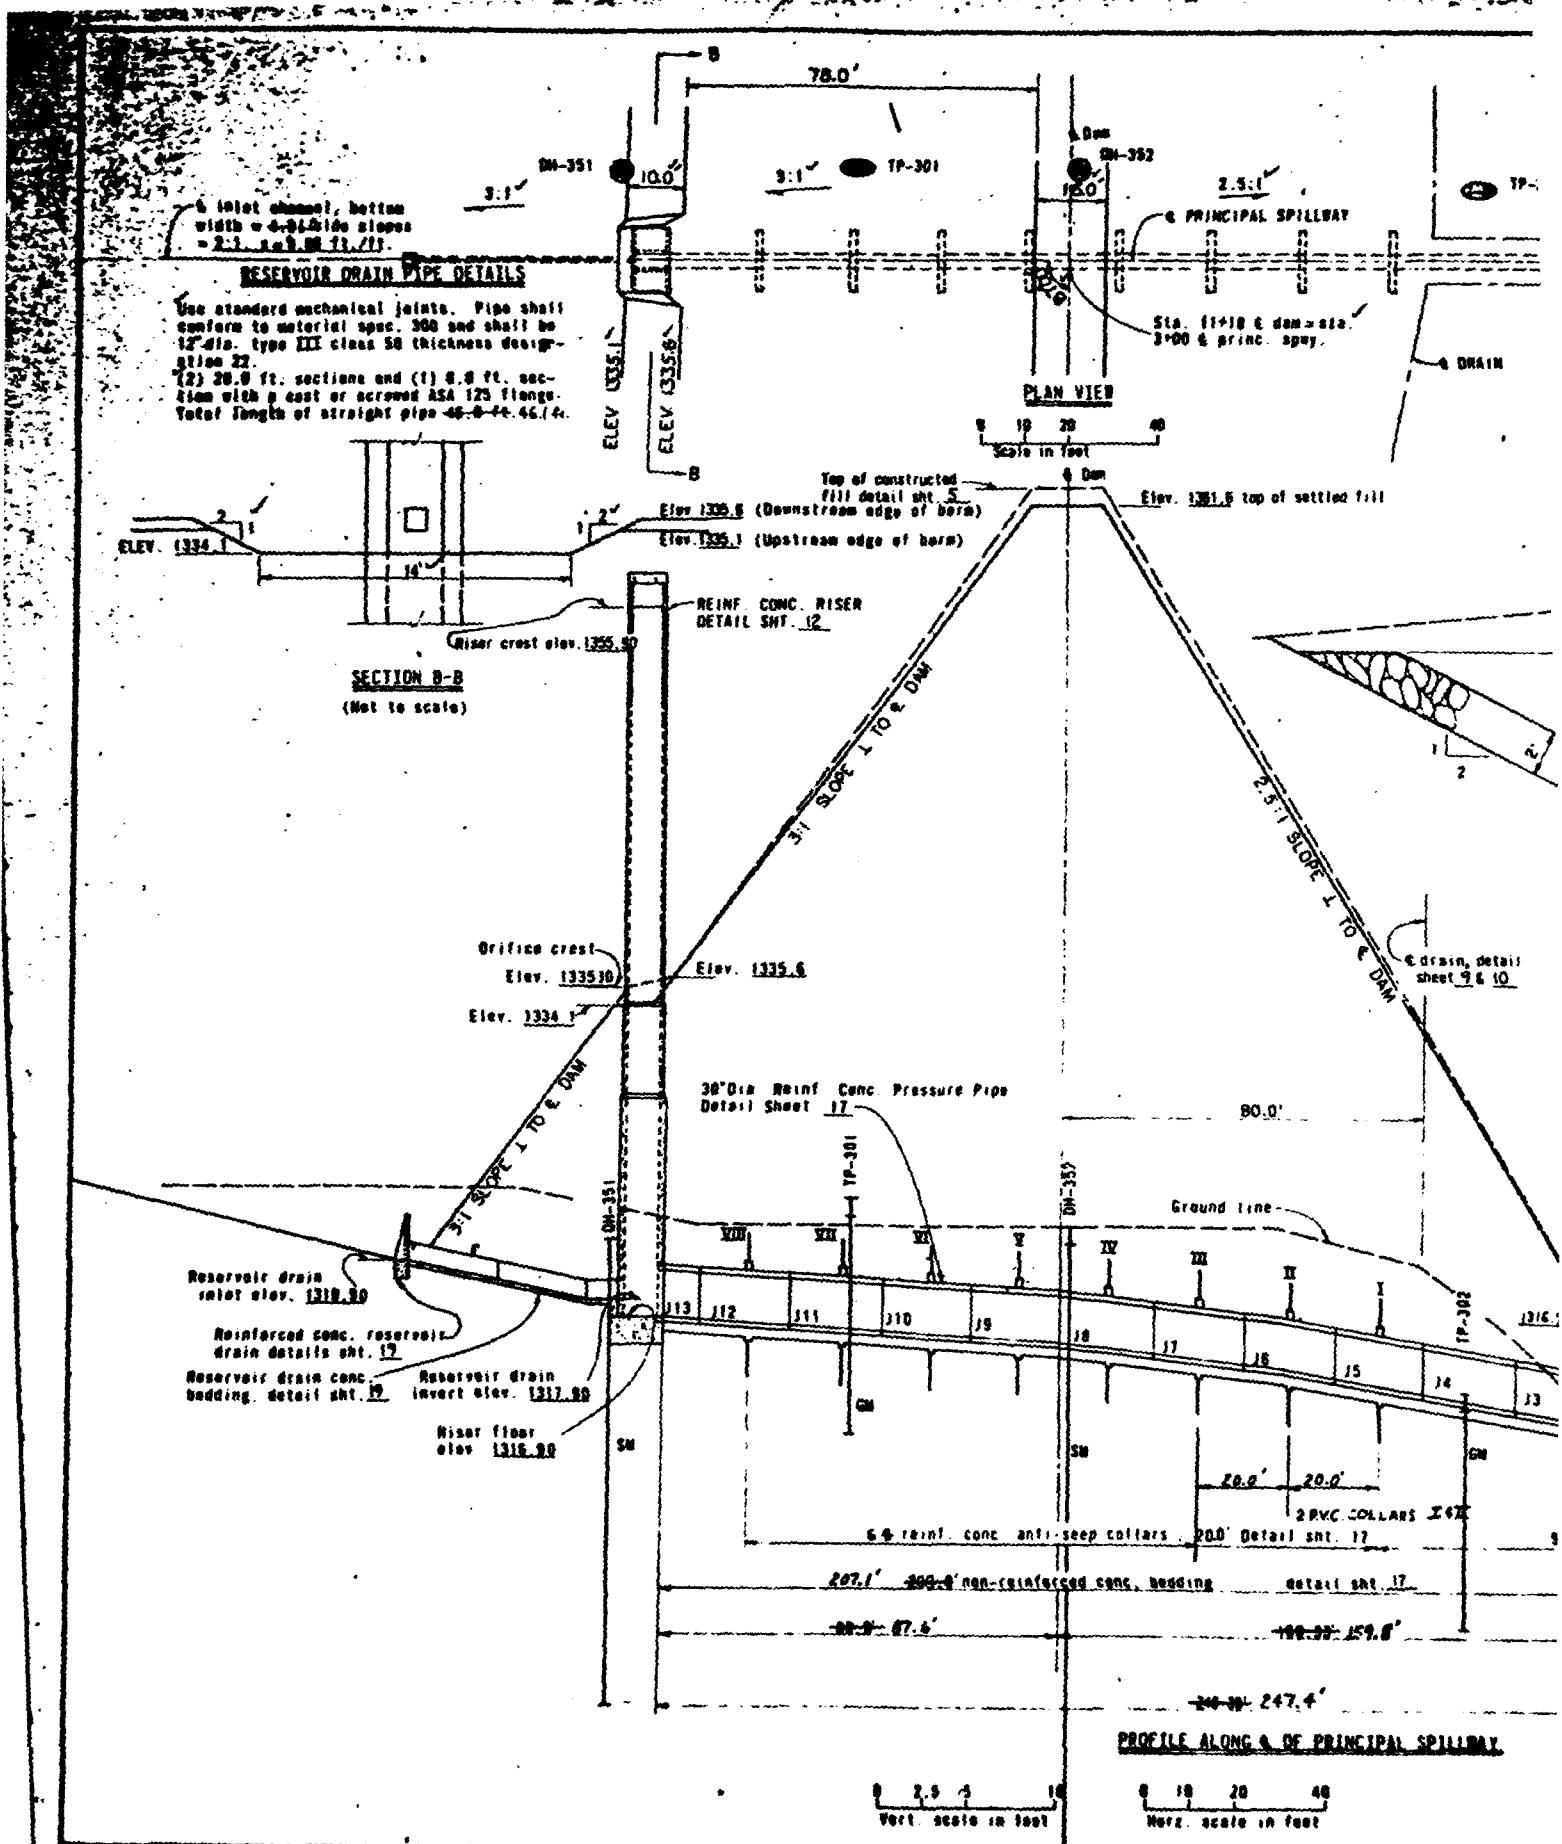

-362


2.5:1
PRINCIPAL SPILLWAY
Sta. 11+10 & dam = 820.
3'00 & prim. aggr.

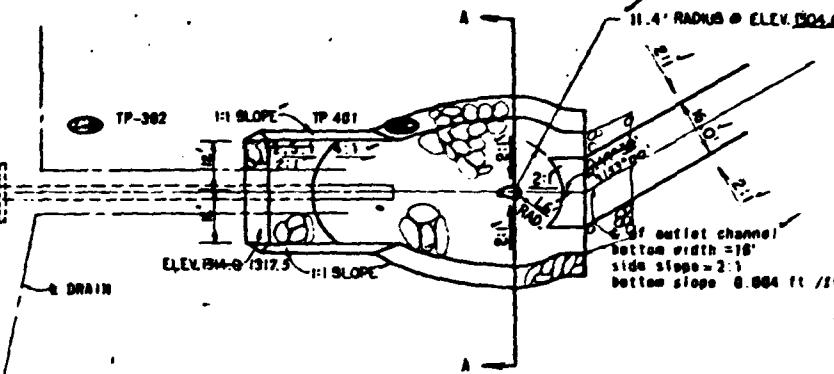

Elev. 1301.8 top of settled fill

JOINT	DIST FROM OUTLET	INVERT OF 30 DIA PIPE	SLOPE FT/FT
Outlet	0	1300.44'	0.0371
1-1	20	1310.18'	
2	40	1310.92'	
3	60	1311.67'	
4	80	1313.41'	
5	100	1313.196	
6	120	1313.889	
7	140	1314.534	
8	160	1315.17'	0.0278
9	180	1315.753	
10	200	1316.296	
11	220	1316.523	0.0135
12	240	1316.756	
13	260	1316.90	

Above dimensions for lengths of pipe are based on nominal lengths and do not include creep

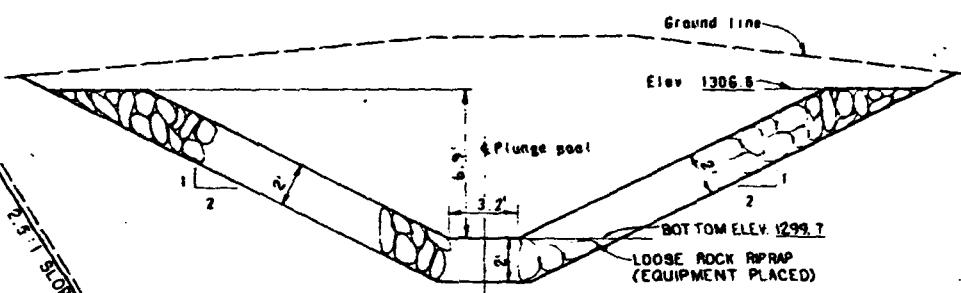

COLLAR	DIST FROM OUTLET	INVERT OF 30 DIA PIPE
I	90	1312.78
II	110	1313.52
III	130	1314.26
IV	150	1314.98
V	170	1315.44
VI	190	1315.98
VII	210	1316.38
VIII	230	1316.65

30" reinforced concrete pipe See detail sheet 17

SECTION A-A (Not to scale)
RIPRAP DETAILS


LOOSE ROCK RIPRAP SHALL BE WELL GRADED FROM A MAXIMUM SIZE OF 24" TO A MINIMUM SIZE OF 6". 35% OF THE TOTAL WEIGHT TO BE FRAGMENTS HEAVIER THAN 350 LBS. AVERAGE WEIGHT OF THE FRAGMENTS SHALL BE 180-220 LBS. NOT MORE THAN 10% OF THE TOTAL WEIGHT TO BE FRAGMENTS LIGHTER THAN 35 LBS.

80.0'

drain, detail sheet 9 & 10

REINF CONC PRESSURE PIPE 30" O.D 2474#
CAST IRON PIPE

46.1 LF
LOOSE ROCK RIP RAP 164 CY
MOO #S-8/22/74-P.V.C. COLLARS -2 1 JOB

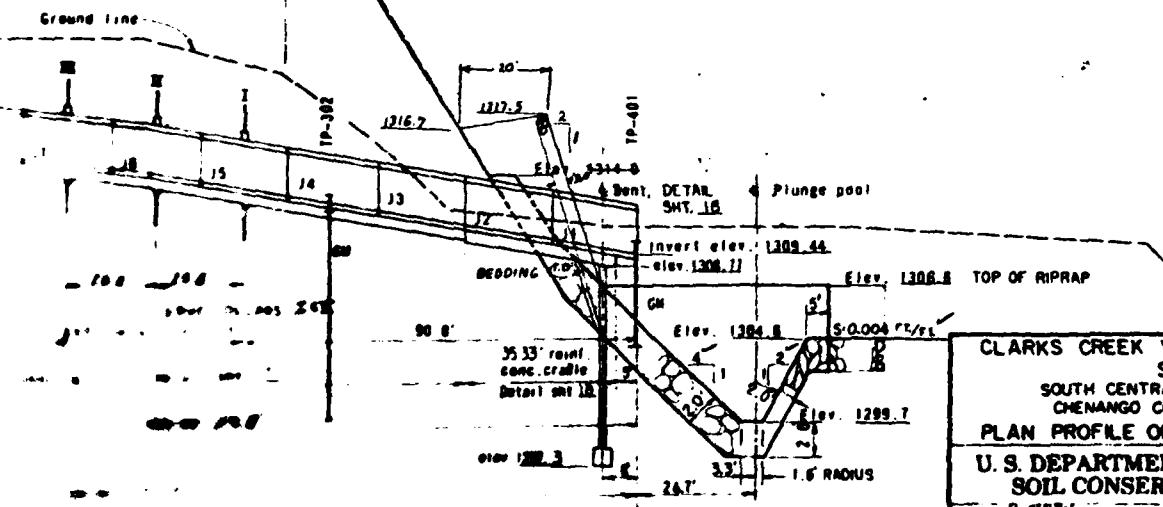

AS BUILT

10/31/74
C.C.-1-73


CLARKS CREEK WATERSHED PROJECT
SITE I
SOUTH CENTRAL RCBD PROJECT
CHENANGO COUNTY, NEW YORK
PLAN PROFILE OF PRINCIPAL SPILLWAY
U.S. DEPARTMENT OF AGRICULTURE
SOIL CONSERVATION SERVICE

R SMITH 1/78
J POLLECH 1/78
D BURDICK 1/78

NY-2357-P

CONTRACT MODIFICATION

8-8/11/70

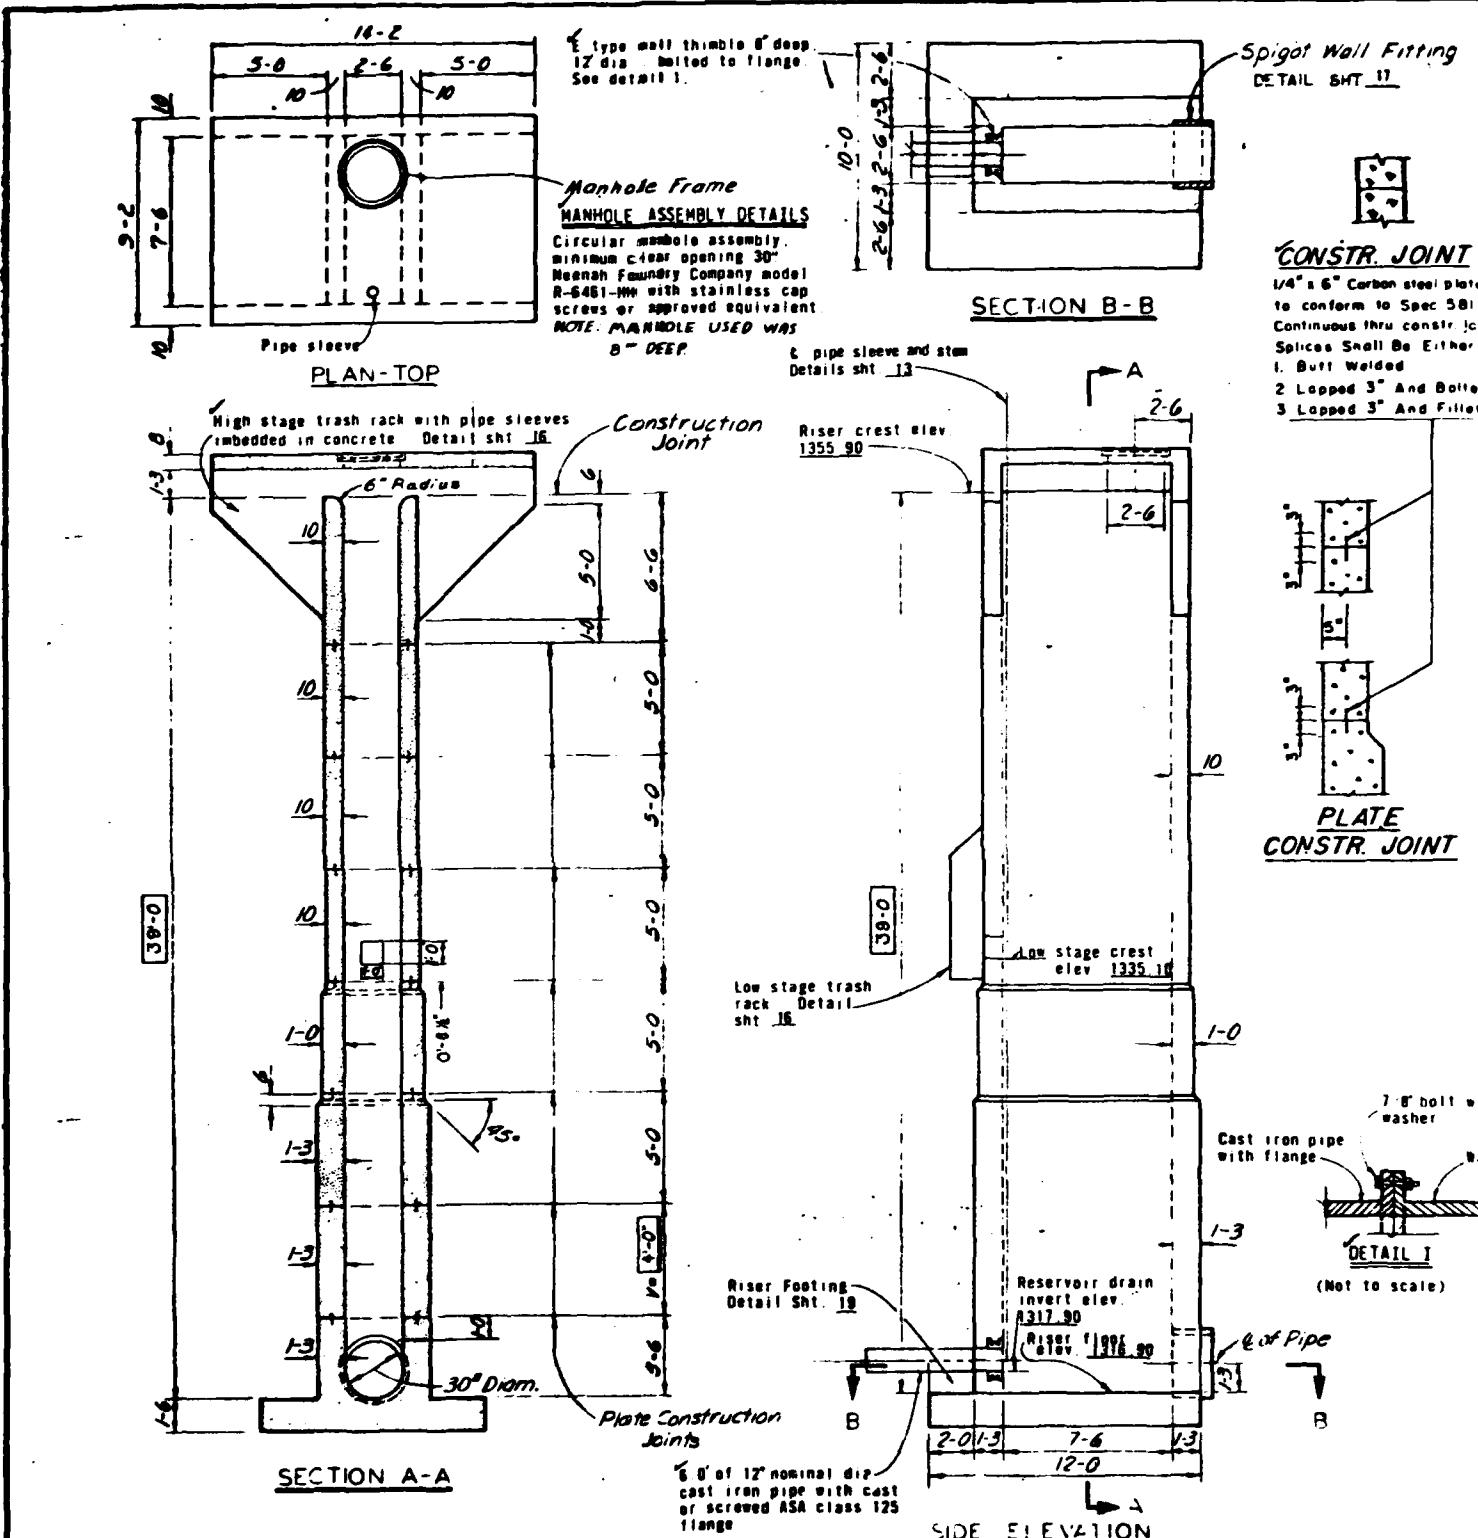



Spigot Wall Fitting
DETAIL SHT 17



CONSTR. JOINT

1/4" x 6" Carbon steel plate,
to conform to Spec 581.
Continuous thru constr. joint.
Splices Shall Be Either:
1. Butt Welded
2. Lapped 3" And Bolted
3. Lapped 3" And Fillet Welded


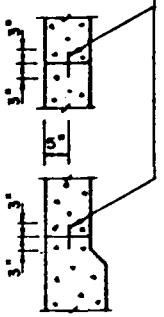


PLATE CONSTR. JOINT

Don stage crest
elev 1335 10

1-0

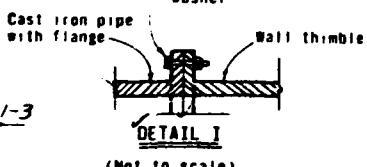

DETAIL I
(Not to scale)

Reservoir drain
invert elev

A317.90

Riser f 1996.90
elev

7-6 1-3
12-0

€ of Pipe

B

ELEVATION

FT.	234	LBS.
FT.	6477	LBS.
FT.	3159	LBS.
FT.	777	LBS.
Total	8641	LBS.



Bars R2, R3, R4 and R5)

• 16(6) = 42.32 + 6.64 = 48.96 cu. yds

STEEL SCHEDULE

Mark	Size	Quan	Length	Type	B	C	Total Length	Mark	Size	Quan	Length	Type	B	C	Total Length
B1	#6	12	9-6	1			114-0	R30	#3	20	8-0	21	2-9	5-3	160-0
B2	#6	10	11-6	1			115-0								
B3	#7	30	10-0	21	3-5	6-7	380-0								
B4	#6	10	11-6	1			115-0								
B5	#6	12	9-6	1			114-0								
B6	#6	2	4-0	1			8-0								
B7	#6	6	7-6	21	1-0	6-6	45-0								
B8	#6	19	7-6	21	1-0	6-6	182-6								
B9	#5	14	8-6	1			119-0								
B10	#6	3	3-6	1			17-6								
B11	#6	3	2-9	1			8-3	T1	05	18	6-0	1			108-0
B12	#6	2	2-9	1			5-6	T2	05	6	8-0	1			68-0
B13	#6	10	6-9	21	0-10	5-11	67-6	T3	05	6	9-5	1			13-0
B14	#6	18	9-3	21	3-4	5-11	166-6	T4	05	6	3-6	1			16-0
								T5	05	6	2-3	1			9-0
								T6	05	4	9-0	19	2-0	7-0	36-0
								T7	05	12	8-3	1			99-0
								T8	05	2	3-3	1			6-6
								T9	05	2	5-5	1			11-6
								T10	05	2	10-3	1			21-6
								T11	05	2	13-3	1			26-6
								T12	05	14	6-3	1			87-6
								T13	05	6	8-0	1			48-0
R1	#6	22	10-9	1			236-6	T14	05	4	6-0	1			26-0
R2	#5	16	8-6	1			136-0	T15	05	4	4-9	1			19-0
R3	#6	8	3-6	1			28-0	T16	05	4	3-6	1			16-0
R4	#6	28	8-6	1			238-0	T17	05	6	2-3	1			9-0
R5	#6	32	9-3	21	3-4	5-11	296-0	T18	05	4	9-0	19	2-0	7-0	36-0
R6	#6	18	8-6	1			119-0	T19	05	24	8-0	21	2-9	5-3	192-0
R7	#6	10	3-6	1			35-0	T20	05	2	3-3	1			6-6
R8	#6	26	4-0	1			104-0	T21	05	2	5-5	1			11-6
R9	#5	36	8-9	21	3-12	5-7-9	315-0	T22	05	2	8-3	1			16-6
R10	#5	4	8-3	21	2-0	5-4-3	33-0	T23	05	2	10-3	1			21-6
R11	#5	22	6-9	1			148-6	T24	05	2	13-3	1			26-6
R12	#6	14	8-3	1			115-6	T25	05	6	13-3	1			55-0
R13	#5	10	3-6	1			35-0	T26	05	4	13-3	1			55-0
R14	#5	26	4-6	1			117-0	T27	04	16	8-3	1			115-6
R15	#5	20	3-8	1			73-4	T28	06	2	4-9	1			9-6
R16	#5	36	8-3	21	2-0	5-4-3	297-0	T29	04	7	13-3	1			36-3
R17	#5	4	8-0	21	2-9	5-3	32-0	T30	04	4	5-3	1			21-0
R18	#5	20	11-9	1			235-0	T31	05	24	6-3	21	1-6	5-3	162-0
R19	#5	14	8-3	1			115-6	T32	05	2	6-6	21	1-6	5-0	13-0
R20	#5	8	3-3	1			26-0	T33	05	2	2-6	21	1-6	1-0	5-0
R21	#5	20	11-9	1			235-0	T34	06	7	13-3	1			36-3
R22	#5	40	8-0	21	2-9	5-3	320-0	T35	06	6	5-3	1			21-0
R23	#5	10	8-3	1			82-6								
R24	#5	8	3-3	1			26-0								
R25	#5	28	8-0	21	2-9	5-3	224-0								
R26	#5	20	6-9	1			135-0								
R27	#5	9	8-3	1			66-0								
R28	#5	8	3-3	1			26-0								
R29	#5	20	6-9	1			135-0								

BAR TYPES

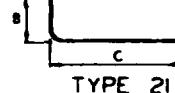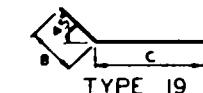

AS BUILT

10/31/74
CC-1-73

BLOCKED IN DIMENSIONS ARE NOT TO SCALE

0 2 4 6
Scale in Feet

CLARKS CREEK WATERSHED PROJECT

SITE 1

**SOUTH CENTRAL RC BD PROJECT
CHENANGO COUNTY, NEW YORK
RISER STRUCTURAL DETAILS**

**U. S. DEPARTMENT OF AGRICULTURE
SOIL CONSERVATION SERVICE**

Assigned	J. POLULECH	Date	1/72
From	D. BURDICK	Date	1/72
Spec.		Date	
Perf.		Date	
Review		Date	
Approve		Date	
Printed		Date	
Entered		Date	
File		Date	
NY-2357 -P			


TP #9, S of Hwy., 5/17/71, NY, 1363.4

0.0 - 1.0 Topsoil
 1.0 - 15.0 Gravel, silty
 Max. size 30", varied lithology;
 Approx. 20 + 6", 20 3-6", 95% matrix (which is approx.
 40% gravel, 40% sand, 20% non-plastic fines);
 Brown; moist-wet; slight permeability; dense; homogeneous;
 glacial till; (GM)
 NOTE: Light seepage just below topsoil.

TP #101, Borrow, 5/17/71, NY, 1367.3

0.0 - 1.0 Topsoil
 1.0 - 15.0 Gravel, silty
 Max. size 30", shale flags and sandstone boulders;
 Approx. 20 + 6", 20 3-6", 95% matrix (which is approx.
 40% gravel, 20% sand, 40% non-plastic fines);
 Brown; moist; slight permeability; dense; homogeneous;
 glacial till; (GM)
 NOTE: Seepage just below topsoil; approx. 10 ft.
 ground surface in borrow area is covered with
 sandstone boulders.

TP #102, Borrow, 5/18/71, NY, 1347.1

0.0 - 1.0 Topsoil
 1.0 - 14.0 Gravel, silty
 Max. size 30", shale flags and sandstone boulders;
 Approx. 20 + 6", 20 3-6", 95% matrix (which is approx.
 40% gravel, 20% sand, 40% non-plastic fines);
 Brown; moist; slight permeability; dense; homogeneous;
 glacial till; (GM)
 NOTE: Moderate seepage @ 9.0 ft.; bank caves occasionally.

TP #103, Borrow, 5/18/71, NY, 1344.8

0.0 - 1.0 Topsoil
 1.0 - 15.0 Gravel, silty
 Max. size 30", varied w/shale flags and sandstone
 boulders;
 Approx. 20 + 6", 20 3-6", 95% matrix (which is approx.
 40% gravel, 20% sand, 40% non-plastic fines);
 Brown; moist; slight permeability; dense; homogeneous;
 glacial till; (GM)
 NOTE: TP #104 was not dug.

TP #105, Borrow, 5/18/71, NY, 1342.3

0.0 - 1.0 Topsoil
 1.0 - 15.5 Gravel, silty
 Max. size 30", varied lithology;
 Approx. 20 + 6", 20 3-6", 95% matrix (which is approx.
 40% gravel, 20% sand, 40% non-plastic fines);
 Brown; moist; slight permeability; dense; homogeneous;
 glacial till; (GM)
 D.S. 105.1 @ 10.0 ft. SH
 NOTE: Seepage just below topsoil

TP #106, Borrow, 5/18/71, NY, 1352.5

0.0 - 1.0 Topsoil
 1.0 - 14.5 Gravel, silty
 Max. size 30", shale flags and sandstone boulders;
 Approx. 20 + 6", 20 3-6", 95% matrix (which is approx.
 40% gravel, 20% sand, 35% non-plastic fines);
 Brown; moist; slight permeability; dense; homogeneous;
 glacial till; (GM)
 D.S. 107.1 @ 10.0 ft. SH

TP #107, Borrow, 5/18/71, NY, 1352.1

0.0 - 1.0 Topsoil
 1.0 - 15.0 Gravel, silty
 Max. size 20", shale flags and sandstone boulders;
 Approx. 20 + 6", 20 3-6", 95% matrix (which is approx.
 40% gravel, 20% sand, 40% non-plastic fines);
 Brown; moist; slight permeability; dense; homogeneous;
 glacial till; (GM)
 D.S. 107.1 @ 10.0 ft. SH
 NOTE: Seepage @ 5.0 ft.; refusal on boulders
 @ 15.0 ft.

TP #701, Hwy. Spwy., 5/22/71, NY, 1351.7

0.0 - 1.0 Topsoil
 1.0 - 12.0 Sand, silty
 Max. size 10", varied lithology w/sandstone boulders
 and shale flags;
 Approx. 10 + 6", 20 3-6", 97% matrix (which is approx.
 25% gravel, 35% sand, 40% non-plastic fines);
 Brown; moist; slight permeability; dense; homogeneous;
 glacial till; (GM)
 D.S. 701.1 @ 8.0 ft.
 NOTE: Refusal on boulders @ 12.0 ft.

TP #702, Hwy. Spwy., 5/22/71, NY, 1350.8

0.0 - 1.0 Topsoil
 1.0 - 14.0 Sand, silty
 Max. size 10", varied lithology w/sandstone boulders and
 shale flags;
 Approx. 10 + 6", 20 3-6", 97% matrix (which is approx.
 25% gravel, 35% sand, 40% non-plastic fines);
 Brown; moist; slight permeability; dense; homogeneous;
 glacial till; (GM)

NOTE: Refusal on boulders @ 14.0 ft.

TP #703, Prim. Spwy., 5/18/71, NY, 1323.5

0.0 - 1.0 Topsoil
 1.0 - 13.0 Gravel, silty
 Max. size 30", shale flags and sandstone boulders;
 Approx. 20 + 6", 20 3-6", 95% matrix (which is approx.
 35% gravel, 35% sand, 35% non-plastic fines);
 Brown; moist-wet; slight permeability; dense; homogeneous;
 glacial till; (GM)
 NOTE: Heavy seepage through pocket in till @ 7.5 ft.; pit
 abandoned @ 13.0 ft. due to water and caving banks.

TP #702, Prim. Spwy., 5/19/71, NY, 1313.0

0.0 - 1.0 Topsoil
 1.0 - 13.0 Gravel, silty
 Max. size 30", varied lithology;
 Approx. 20 + 6", 20 3-6", 95% matrix (which is approx.
 40% gravel, 35% sand, 35% non-plastic fines);
 Brown; moist-wet; slight permeability; dense; homogeneous;
 glacial till; (GM)
 NOTE: Seepage from creek and just below topsoil material
 very sticky, but tight; refusal @ 13.0 ft. on
 boulders or bedrock; unable to determine which one
 due to water in pit.

TP #401, Outlet Channel, 5/19/71, NY, 1311.2

0.0 - 1.0 Topsoil
 1.0 - 7.0 Gravel, silty
 Max. size 30", varied lithology;
 Approx. 20 + 6", 20 3-6", 95% matrix (which is approx.
 40% gravel, 35% sand, 35% non-plastic fines);
 Brown; moist-wet; slight permeability; dense; homogeneous;
 glacial till; (GM)
 NOTE: Seepage just below topsoil.

TP #402, Outlet Channel, 5/19/71, NY, 1309.3

0.0 - 1.0 Topsoil
 1.0 - 5.0 Gravel, silty
 Max. size 30", varied lithology w/shale flags and sandstone
 boulders;
 Approx. 20 + 6", 20 3-6", 95% matrix (which is approx.
 40% gravel, 35% sand, 35% non-plastic fines);
 Brown; moist-wet; slight permeability; dense; homogeneous;
 glacial till; (GM)
 NOTE: Seepage from creek.

TP #501, Drain, 5/17/71, NY, 1333.3

0.0 - 1.0 Topsoil
 1.0 - 12.0 Gravel, silty
 Max. size 20", varied lithology;
 Approx. 10 + 6", 20 3-6", 97% matrix (which is approx.
 35% gravel, 35% sand, 35% non-plastic fines);
 Brown; moist; slight permeability; dense; homogeneous;
 glacial till; (GM)

TP #502, Drain, 5/17/71, NY, 1325.6

0.0 - 1.0 Topsoil
 1.0 - 13.0 Gravel, silty
 Max. size 20", varied lithology;
 Approx. 10 + 6", 20 3-6", 95% matrix (which is approx.
 35% gravel, 35% sand, 35% non-plastic fines);
 Brown; moist; slight permeability; dense; homogeneous;
 glacial till; (GM)
 D.S. 502.1 @ 8.0 ft. SH

AS BUILT

C.C.-T-73 0/31/71

CLARKS CREEK WATERSHED PROJECT

SITE I

**SOUTH CENTRAL RCBD PROJECT
 CHENANGO COUNTY, NEW YORK
 LOGS OF TEST HOLES**

**U.S. DEPARTMENT OF AGRICULTURE
 SOIL CONSERVATION SERVICE**

Log No. 547 STATE CONS ENGINEER

1 T. 100' 21' 23' NY-2357-P

70-6161, Drawn, 5/18/71, MM, 1326.9


1.0 - 14.0 Gravel, silty
 Max. size 10", variegated lithology, w/white flags and
 sandstone boulders;
 Approx. 10 cu. yds.; 25% gravel, 50% matrix (which is approx.
 33% gravel, 33% sand, 33% non-plastic fines);
 Some: moist; slight permeability; dense; homogeneous;
 glacial till; (20)

NOTE: Heavy sewage & 8.0 ft.; Banks cut continuously

TP 0304, strain, 3/18/71, NO. 1329.3

0.0 - 1.0 Topsoil

1.0 - 14.0 Gravel, silty
Size, size 2^d; varied lithology, w/shale frags and sandstone
fragments; matrix; approx. 10-40%, 20-30% sand, 30-40% matrix (which is approx.
30% gravel, 30% sand, 30% non-plastic fine);
Source: water; slight permeability; dense; homogeneous;
glacial till; (30)

NOTE: Seepage just below topsoil; moderate seepage
at 9.5 ft.


DRILL HOLE LOGS

BU 051, C of Buu, 6/7 - 6/8/71, HN, 1342.0

8.8 Toposat

22		
23		
23		
23		
23		
100/.2		
23	Sand-silty w/gravel	
125/.7	Aprons. 200 gravel, 45% sand, 35% non-plastic fines;	
23	Brown; moist; slight permeability; loose-very dense; homogeneous;	
110/.5	glacial till; (30)	
23		
100/.5		
23		
75/.3		
23		
150/.1		
30.2		

NOTE: Casing refusal @ 14.0 ft.; hole staying open;
WL 9.8 ft., 4/8/71

BM #52, C of Dam, 6/8/71 - 6/9/71, HM, 3332.7


24		
25		
26		
27	0.65yp	-
100/.5	0.65yp	Sand-silty w/gravel Approx. 25% gravel, 45% sand, 30% non-plastic fines; Brown; moist; slight permeability; medium-very dense; homogeneous; glacial till; (RM)
150/.5		
150/R		
150/.4		
150/R		
150/.2		
25.2		

NOTE: Casing refusal @ 18.0 ft.; hole abandoned @ 25.2 ft. due to filling in from unknown source; casing has settled so seepage below casing may be the cause.
M.L. 2-9-66 6/26/71

DM #351, Print. Spwy., 6/3 - 6/10/71, M. 1321.2


	0.0	
9		
36		
34		
75		
83	0.074	Sand, silty w gravel Approx. 25% gravel, 40% sand, 35% non-plastic fines; Brown; moist; slight permeability; loose-very dense; Homogeneous; glacial till; (5%)
110		
88		
50/, 0		
88		
70		
100/.7		
88		
100/.2		
88		
100/.5		
88		
150/.6		
25.6		

NOTE: NL 0 1.0 ft., 6/10/71; base of cliff (rock face) from 13.0 - 14.0 ft.

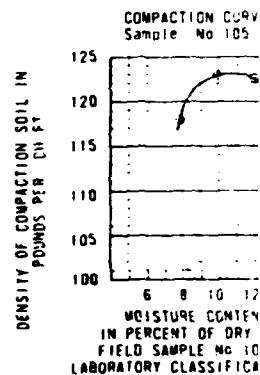

0.0	
14	1.0 Tuyetts
30	
19	
28	
75	
80	
110	
100/.6	
BB	Sand-silty w/gravel
100/.4	Approx. 25% gravel, 40% sand, 35% non-plastic fines
BB	brown; moist; slight permeability; medium-very dense;
100/.4	homogeneous; glacial till; (SM)
BB	
100/.5	
BB	
100/.8	
BB	
100/.1	
BB	
100/.5	
BB	
100/.3	
BB	
46.0	
BBM	

NOTE: WL 0 2.0 ft., 6/14/73; unable to sample below 35.3 ft. due to hole continually filling in with mat'l. from above. drilled hole to 46.0 ft. to verify no change in mat'l.

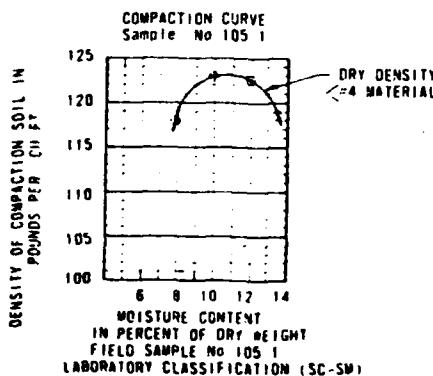

plastic fines;
slim-very dense;

at 25.2 ft. due
to mat section

flow) free

OFFICIAL LEGENDTEST HOLE NUMBERING SYSTEM

	Test Pit (TP)	Drill Hole (DH)
Centerline of Dam	1-40	51-90
Reservoir Area	101-140	151-190
Emergency Spillway	201-240	251-290
Principal Spillway	301-340	351-390
Outlet Channel	401-440	451-490
Drain Line	501-540	551-590
Other	601-640	651-690

UNIFIED SOIL CLASSIFICATION SYSTEM (USCS) SYMBOLS

GP	Well graded gravel; gravel-sand mixture
GP	Poorly graded gravel
GM	Silty gravel; gravel-sand-silt mixtures
GC	Clayey gravel; gravel-sand-clay mixtures
SM	Well graded sand; sand-gravel mixtures
SP	Poorly graded sand
SM	Silty sand; sand-silt mixtures
SC	Clayey sand; sand-clay mixtures
CL	Silt; silty, very fine sand; sandy or clayey silts
CL	Clay of low to medium plasticity; silty, sandy, or gravelly clays
CH	Organic silts and organic silty clays of low plasticity
ML	Elastic silts; micaceous or diatomaceous silts
CH	Clays of high plasticity, fat clays
CH	Organic silts or clays of medium to high plasticity
PL	Fest, mud

(a) Unified Classification by Visual-Manual Procedure (ASTM D2488-66T)
in the field.

(b) Unified Classification based on laboratory analysis of
representative samples (ASTM D2487-66T).

BACHELOR PIT AND DRILL HOLE LOG TERMS AND ABBREVIATIONS

Sample types - DS - Disturbed sample (loose bagged, mixed)

- US - Undisturbed sample (sealed block or tube type)

Matrix - All material less than 3"

Atterberg limits - (ASTM D24-59)

- LL - Liquid Limit

- PL - Plastic Limit

- PI - Plasticity Index

SLDR - Boulder	- Soep in test hole
COL - Cobble	SH - Blind hole - no sample
A - Angular	WOM - Weight of Hammer
SA - Subangular	Ref - Refusal
SR - Subrounded	MX - Rock core 2 1/8" diameter
R - Rounded	BB - Roller bit - no sample
so - Sandstone	AUG - Auger - no sample
sh - Shale	DBS - Dry barrel sample
silt - Siltstone	STS - Split tube sample
ls - Limestone	Rec - Recovery - % of rock or STS re-covered)
sd - Sedimentary	k - Permeability rate (ft/day)
WL - Water Level	EOH - End of hole

I - Blows per foot - Standard Penetration Test (ASTM D1586)

WD - Rock Quality Designation in % = length of core pieces > 4 / length of core run

KEY TO BACHELOR PIT LOGS

TP Number, Location, Date, Logged by, Elevation

Depth	Typical
	Maximum size - Lithology Approx. 40", 15-6", Matrix (which is approx. 1 gravel, 1 sand, 1 plastic fines)
	Odor, color, moisture, permeability; density or consistency, structure, origin; (field USCS)
	Sample number and type: lab USCS

NOTE:

KEY TO DRILL HOLE LOGS

DH Number, Location, Date, Logged by, Elevation

N	Description of Geologic Horizon
0.0	Depth
	Typical name; gradation; Est. 1 gravel, 1 sand, 1 fines, plasticity; odor, color, moisture; permeability; density or consistency, structure; origin; (field USCS)

6.0 Depth

NOTE:

CLARKS CREEK WATERSHED PROJECT SITE 1SOUTH CENTRAL RCBD PROJECTCHENANGO COUNTY, NEW YORKLOGS OF TEST HOLESU. S. DEPARTMENT OF AGRICULTURE
SOIL CONSERVATION SERVICE

as built	10/31/74	5-4-74	STATE CONS ENGINEER
typed	Walter	22	NY-2357-P
Initial Date		22	

END

DATE
FILMED

11-80

DTIC